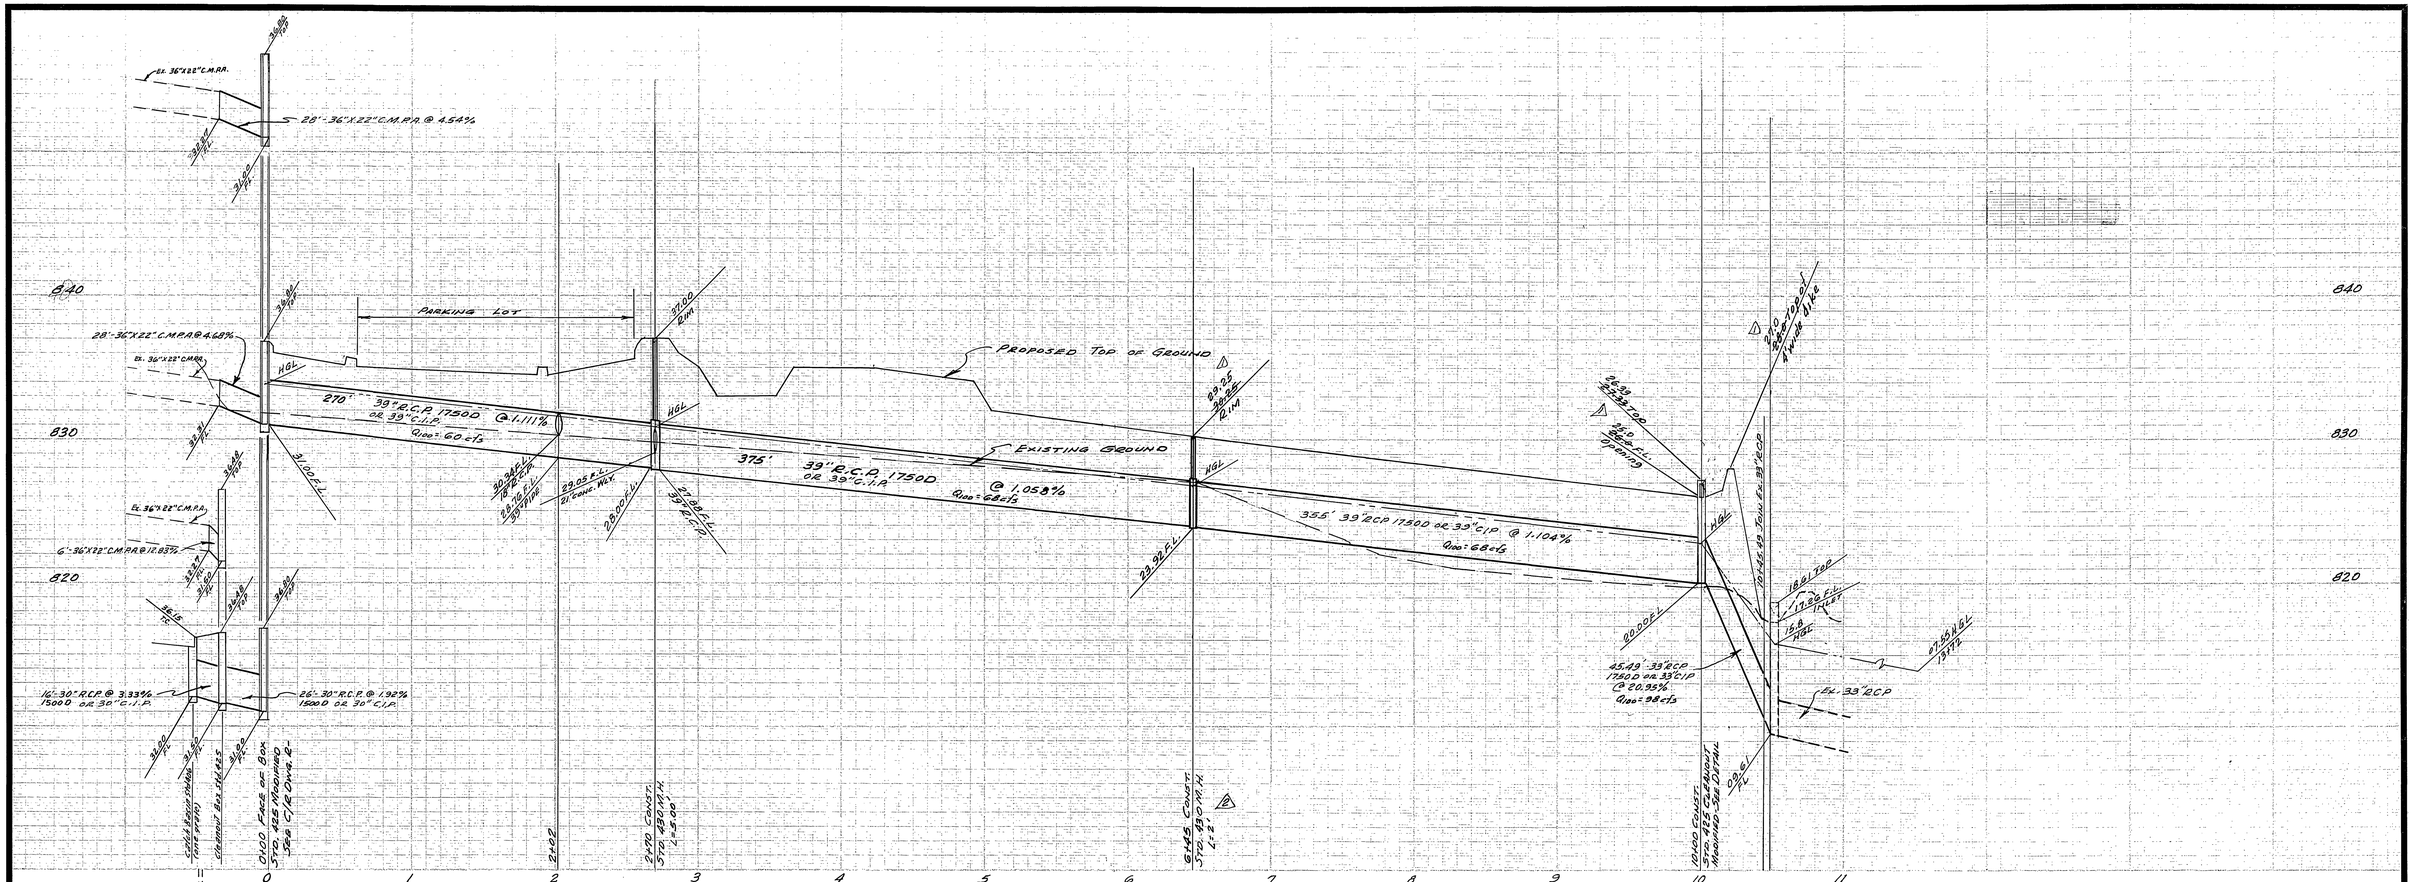

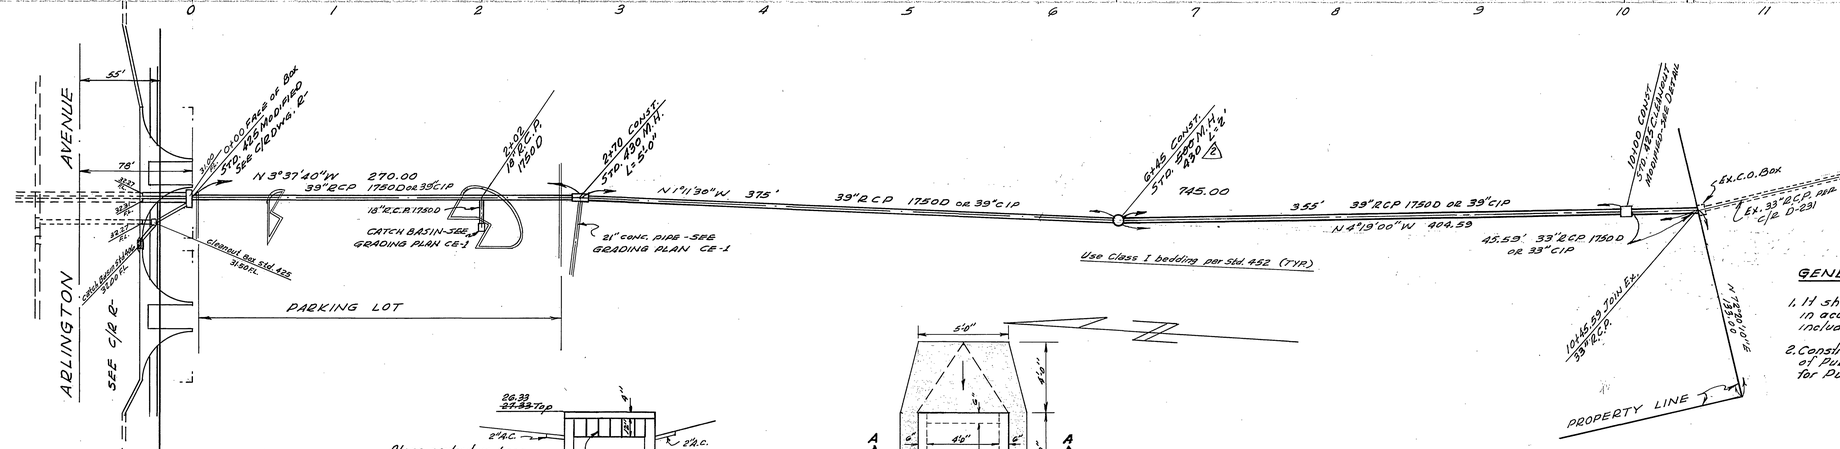

BENCH MARK

PK NAIL IN CENTER OF N.W. CURB RETURN @ WESTERN AND ARLINGTON. ELEV. 838.04. C/L F.B. 704/35

GENERAL NOTES

1. It shall be the responsibility of the contractor to clear the right of way in accordance with the provisions of law as it affects each utility including irrigation lines and appurtenances and at no cost to the City.
2. Construction shall be in accordance with the City of Riverside Department of Public Works Standard Drawings, and the Standard Specifications for Public Works Construction, 1976 Edition.

Loma Vista

ALBERT A. WEBB ASSOCIATES
CIVIL ENGINEERS
RIVERSIDE, CALIFORNIA
APPROVED BY Ernest N. Webb DATE 1/27/77
R.E. No. 3876
W.O. 77-11 FOR: ALVORD UNIFIED SCHOOL DISTRICT F.B. 220 1022

MARK	REVISIONS	APPR.	DATE
2	STD. 500 M.H. CHANGED TO STD. 430 ENW	ENW	4/18/77
1	REVISED GRADE OVER LINE ENW	ENW	4/5/77

DESIGNED BY RBC DRAWN BY RBC CHECKED BY

CITY OF RIVERSIDE, CALIFORNIA
DEPARTMENT OF PUBLIC WORKS

	BY	DATE
APPROVED BY OFFICE ENGINEER	[illegible]	3/21
PARK DEPARTMENT		
TRAFFIC DIVISION	[illegible]	2-4-77
ASSISTANT CITY ENG.	[illegible]	3-24

APPROVED BY [signature] DIRECTOR OF PUBLIC WORKS
DATE 3-24-77

~~ALVORD~~ INTERMEDIATE SCHOOL
STORM DRAIN

INDEXED ZA
PROJECT NO. D-307
SHEET 1 OF 1
FILE NO. 77-11-D
HORIZ. SCALE: 1" = 50' VERT. SCALE: 1" = 5'