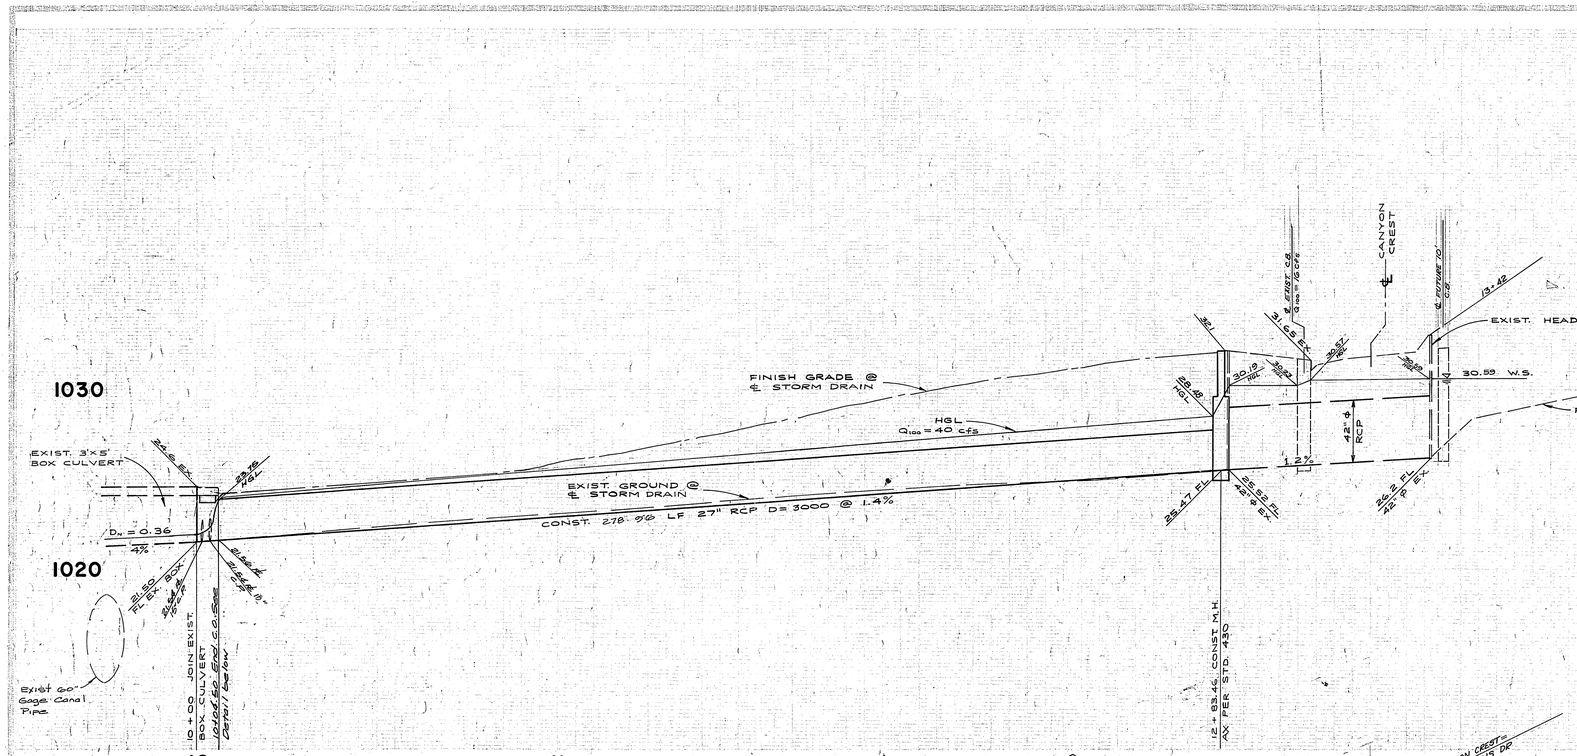

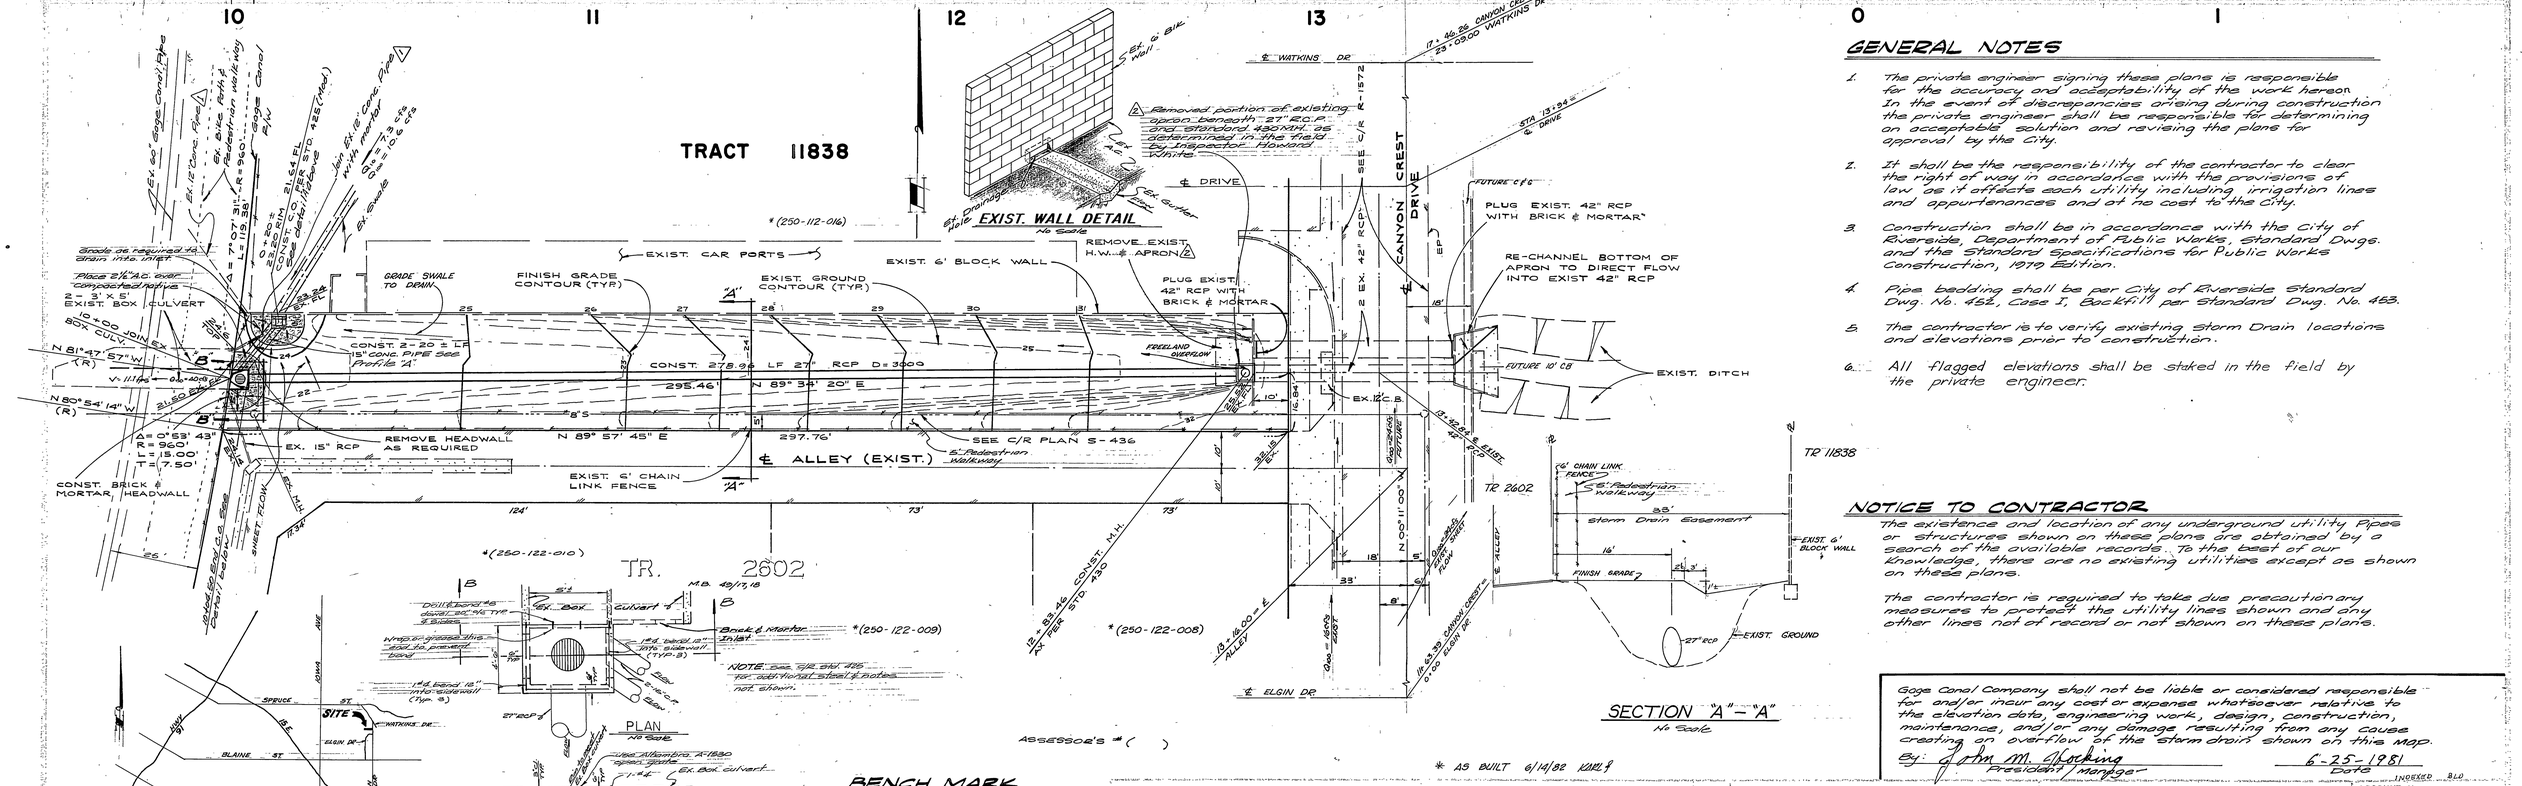

GENERAL NOTES

1. The private engineer signing these plans is responsible for the accuracy and acceptability of the work hereon. In the event of discrepancies arising during construction the private engineer shall be responsible for determining an acceptable solution and revising the plans for approval by the City.
2. It shall be the responsibility of the contractor to clear the right of way in accordance with the provisions of law as it effects each utility including irrigation lines and appurtenances and at no cost to the City.
3. Construction shall be in accordance with the City of Riverside, Department of Public Works, Standard Dwgs. and the Standard Specifications for Public Works Construction, 1979 Edition.
4. Pipe bedding shall be per City of Riverside Standard Dwg. No. 452, Case I, Backfill per Standard Dwg. No. 463.
5. The contractor is to verify existing storm drain locations and elevations prior to construction.
6. All flagged elevations shall be staked in the field by the private engineer.

NOTICE TO CONTRACTOR

The existence and location of any underground utility Pipes or structures shown on these plans are obtained by a search of the available records. To the best of our knowledge, there are no existing utilities except as shown on these plans.

The contractor is required to take due precautionary measures to protect the utility lines shown and any other lines not of record or not shown on these plans.

Gage Canal Company shall not be liable or considered responsible for and/or incur any cost or expense whatsoever relative to the elevation data, engineering work, design, construction, maintenance, and/or any damage resulting from any cause creating an overflow of the storm drain shown on this map.

By: John M. Hocking — President / Manager — 6-25-1981 Date

BENCH MARK

U.S.G.S. - G1144 - Standard Brass Disc. in the headwall of conc. at Highland Grammar School 118' East of East rail of A.T. & S.F. Elevation: 1077.842

* AS BUILT 6/14/82 KAREY

ALBERT A. WEBB ASSOCIATES
CIVIL ENGINEERS
RIVERSIDE, CALIFORNIA
APPROVED BY Ernest N. Wells DATE 9/15/80
R.E. No. 28776
W.O. 77393 PCN Lawrence & Mulhern J.N. 1023
DESIGNED RLT DRAWN KVB CHECKED P.A.

Revised Note Re: Apron Removal, Added sht. 1" Conc. Pipe at ℄ Elgin & ℄ Alley — 9/8/81 — 6/4/82 — KAREY

CITY OF RIVERSIDE, CALIFORNIA
DEPARTMENT OF PUBLIC WORKS
APPROVED BY PRINCIPAL ENGINEER, PARK & RECREATION DIRECTOR, TRAFFIC DIVISION, CHIEF CITY ENGINEER
DATE 7/9/81 APPROVED BY William D. Gardner DIRECTOR OF PUBLIC WORKS
DATE July 2, 1981

STORM DRAIN PLAN & PROFILE
TRACT No. 11838
EASEMENT
Between Gage Canal & Canyon Crest Dr.
SCALE Horiz: 1"=20' Vert: 1"=4'

ACCOUNT No.
DRAWING NUMBER D-396
SHEET 1 OF 1
77-303-D