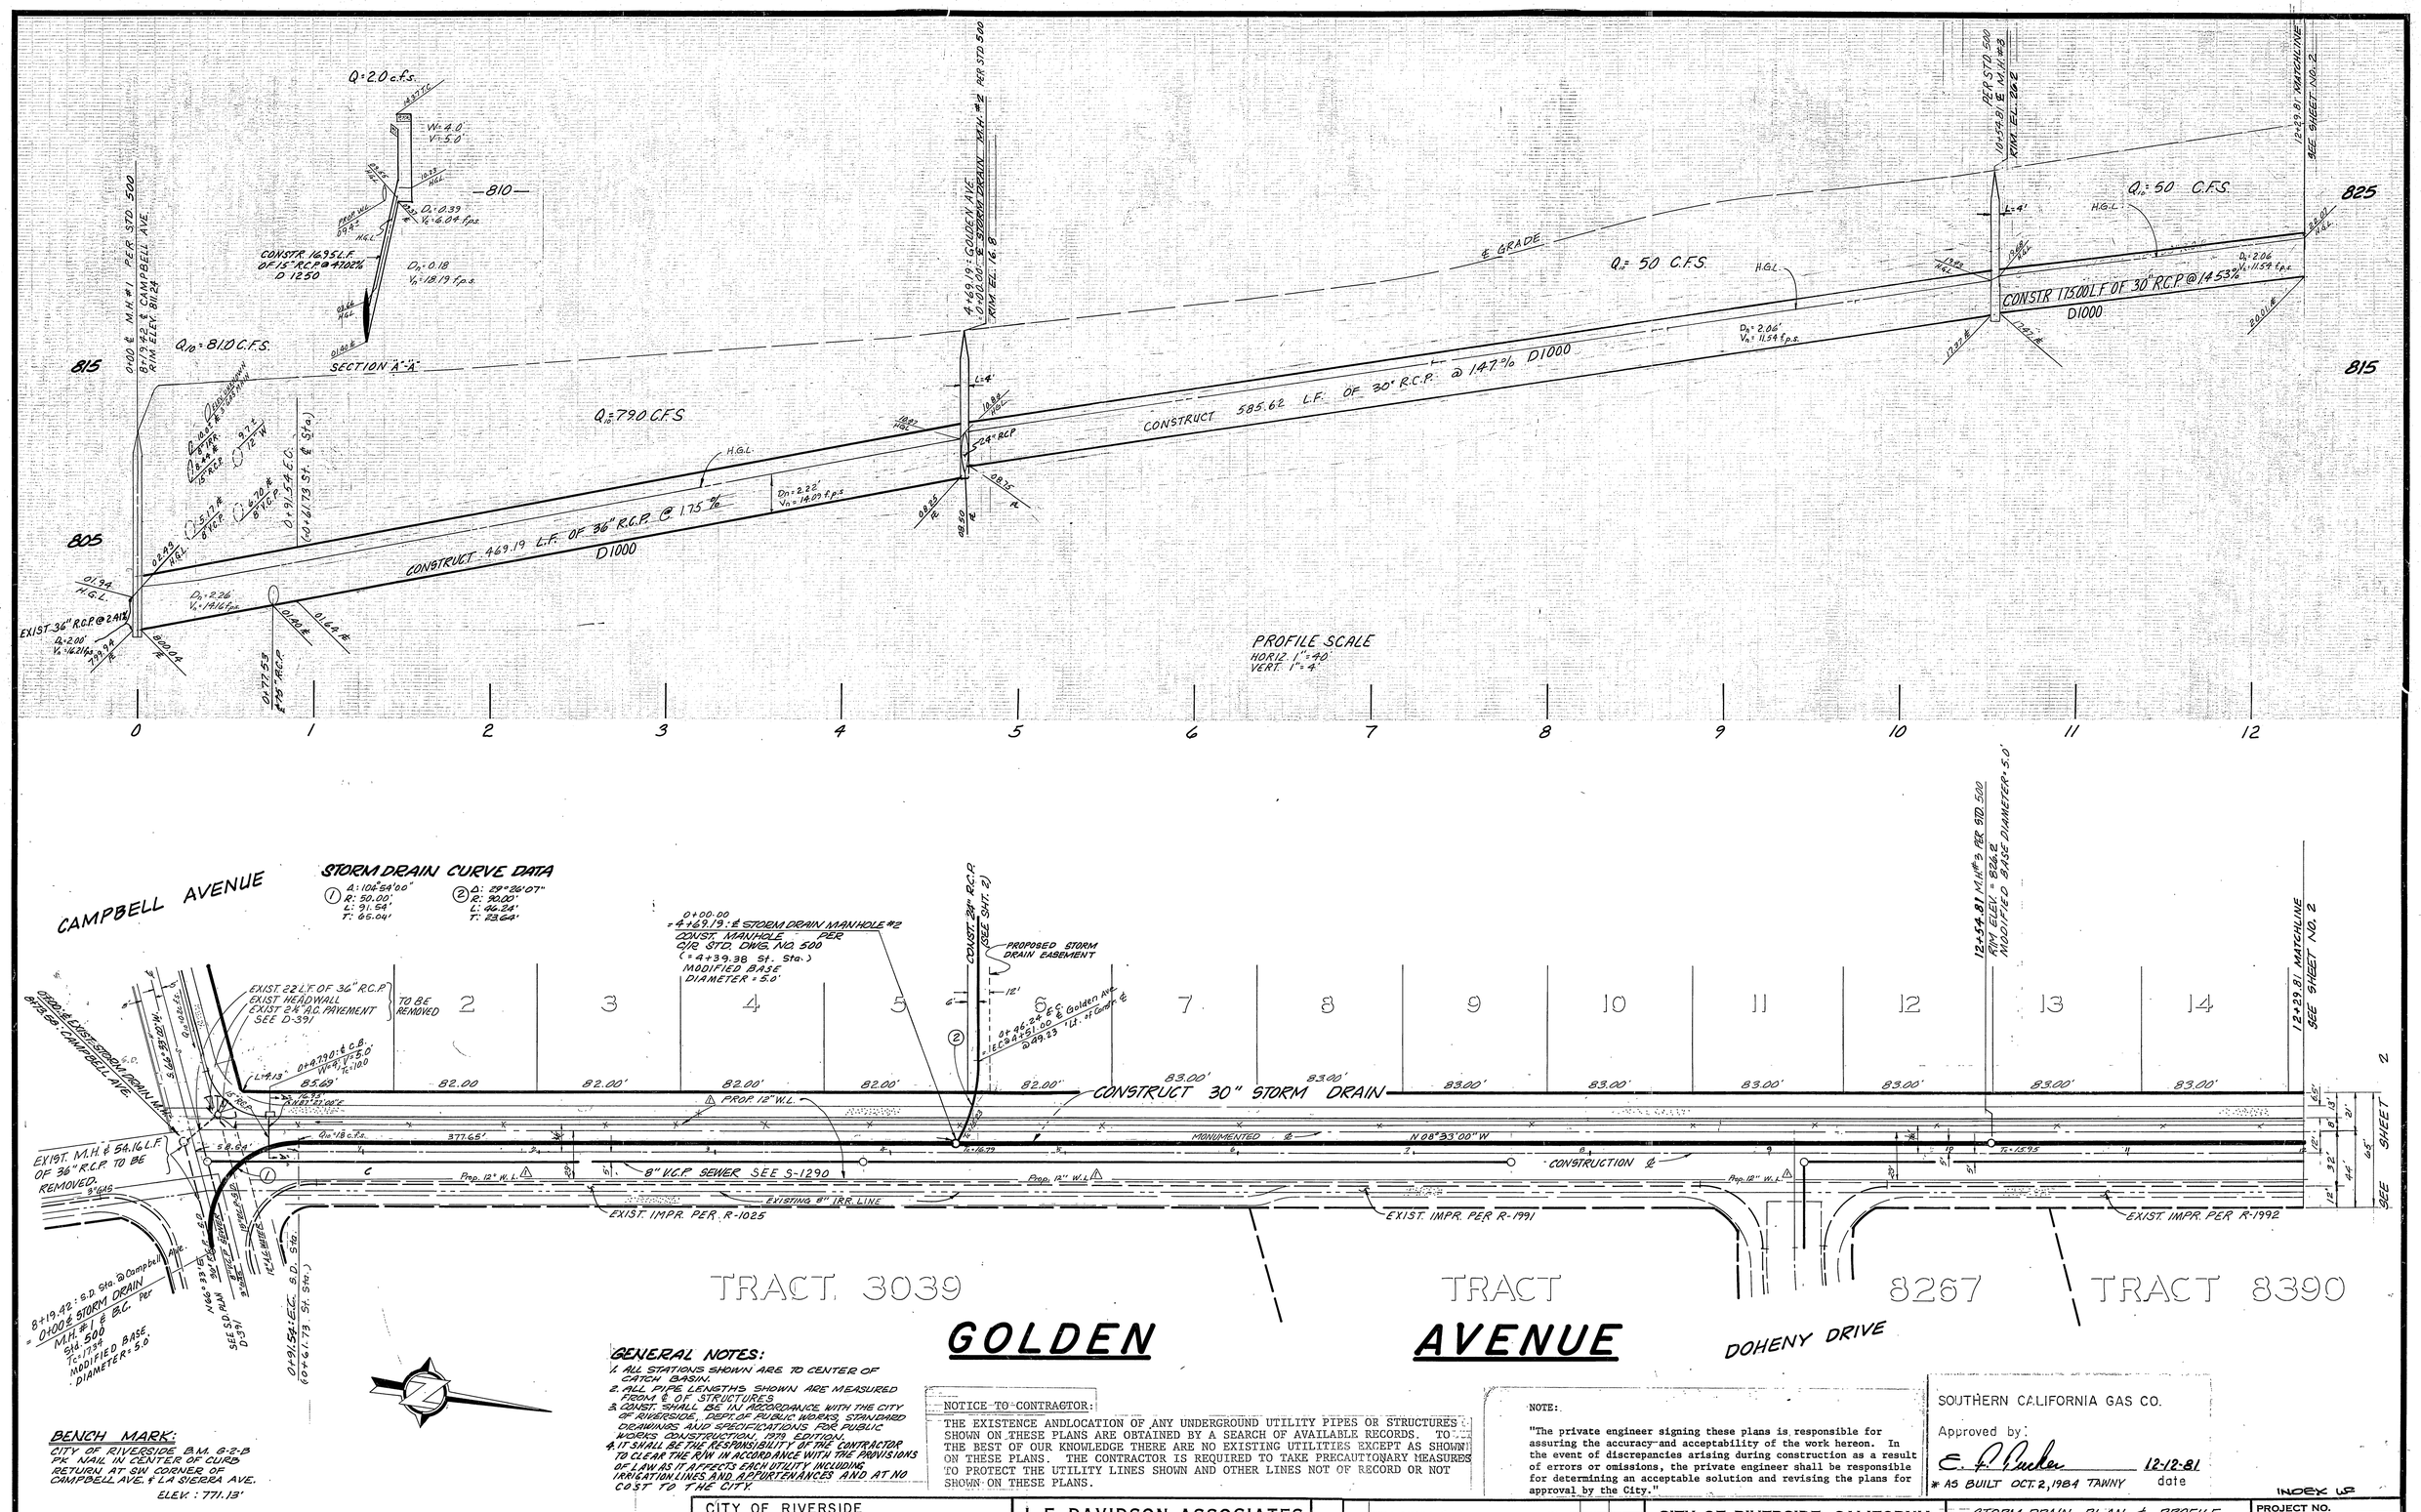

BENCH MARK:
CITY OF RIVERSIDE B.M. 6-2-B
PK NAIL IN CENTER OF CURB RETURN AT SW CORNER OF CAMPBELL AVE. & LA SIERRA AVE.
ELEV.: 771.13'

GENERAL NOTES:
1. ALL STATIONS SHOWN ARE TO CENTER OF CATCH BASIN.
2. ALL PIPE LENGTHS SHOWN ARE MEASURED FROM ℄ OF STRUCTURES
3. CONST. SHALL BE IN ACCORDANCE WITH THE CITY OF RIVERSIDE, DEPT. OF PUBLIC WORKS, STANDARD ORDINANCE AND SPECIFICATIONS FOR PUBLIC WORKS CONSTRUCTION, 1979 EDITION.
4. IT SHALL BE THE RESPONSIBILITY OF THE CONTRACTOR TO CLEAR THE R/W IN ACCORDANCE WITH THE PROVISIONS OF LAW AS IT AFFECTS EACH UTILITY INCLUDING IRRIGATION LINES AND APPURTENANCES AND AT NO COST TO THE CITY.

NOTICE TO CONTRACTOR:
THE EXISTENCE AND LOCATION OF ANY UNDERGROUND UTILITY PIPES OR STRUCTURES SHOWN ON THESE PLANS ARE OBTAINED BY A SEARCH OF AVAILABLE RECORDS. TO THE BEST OF OUR KNOWLEDGE THERE ARE NO EXISTING UTILITIES EXCEPT AS SHOWN ON THESE PLANS. THE CONTRACTOR IS REQUIRED TO TAKE PRECAUTIONARY MEASURES TO PROTECT THE UTILITY LINES SHOWN AND OTHER LINES NOT OF RECORD OR NOT SHOWN ON THESE PLANS.

NOTE:
"The private engineer signing these plans is responsible for assuring the accuracy and acceptability of the work hereon. In the event of discrepancies arising during construction as a result of errors or omissions, the private engineer shall be responsible for determining an acceptable solution and revising the plans for approval by the City."

SOUTHERN CALIFORNIA GAS CO.
Approved by: E. F. Carter 12-12-81
date
* AS BUILT OCT. 2, 1984 TAWNY
INDEX UP

Contractor agrees that he shall assume sole and complete responsibility for job site conditions during the course of construction of this Project, including safety of all persons and property; that this requirement shall apply continuously and not be limited to normal working hours; and that the Contractor shall defend, indemnify and hold the Owner and the Engineer harmless from any and all liability, real or alleged, in connection with the performance of work on this Project, excepting for liability arising from the sole negligence of the Owner or the Engineer.

CITY OF RIVERSIDE
DOMESTIC SYSTEM & IRRIGATION SYSTEM
Fred Lantz 4/12/82
WATER SYSTEMS MANAGER DATE

J. F. DAVIDSON ASSOCIATES
CIVIL ENGINEERS - SURVEYORS - PLANNERS
RIVERSIDE, CALIFORNIA
APPROVED BY John W. Carty DATE 7/7/77
R.E. No. 17550
W.O. 83-1894 FOR: FOMONA 1st FED. F.B.

MARK	REVISIONS	APPR.	DATE
1	Revised 12" W.L. to 29'E. of Mon. ℄		11-2-83

DESIGNED BY LRS DRAWN BY PG CHECKED BY LRS

CITY OF RIVERSIDE, CALIFORNIA
DEPARTMENT OF PUBLIC WORKS

APPROVED BY	BY	DATE
PRINCIPAL ENGINEER		
PARK DEPARTMENT		
TRAFFIC DIVISION		
CHIEF P. W. ENGR.		

APPROVED BY
DIRECTOR OF PUBLIC WORKS
DATE 7/1/83

STORM DRAIN PLAN & PROFILE
TRACT 8796-1
GOLDEN AVENUE
HORIZ. SCALE: 1" = 40' VERT. SCALE: 1" = 4'

PROJECT NO. D-408
SHEET 1 OF 2
FILE NO. 5568-3

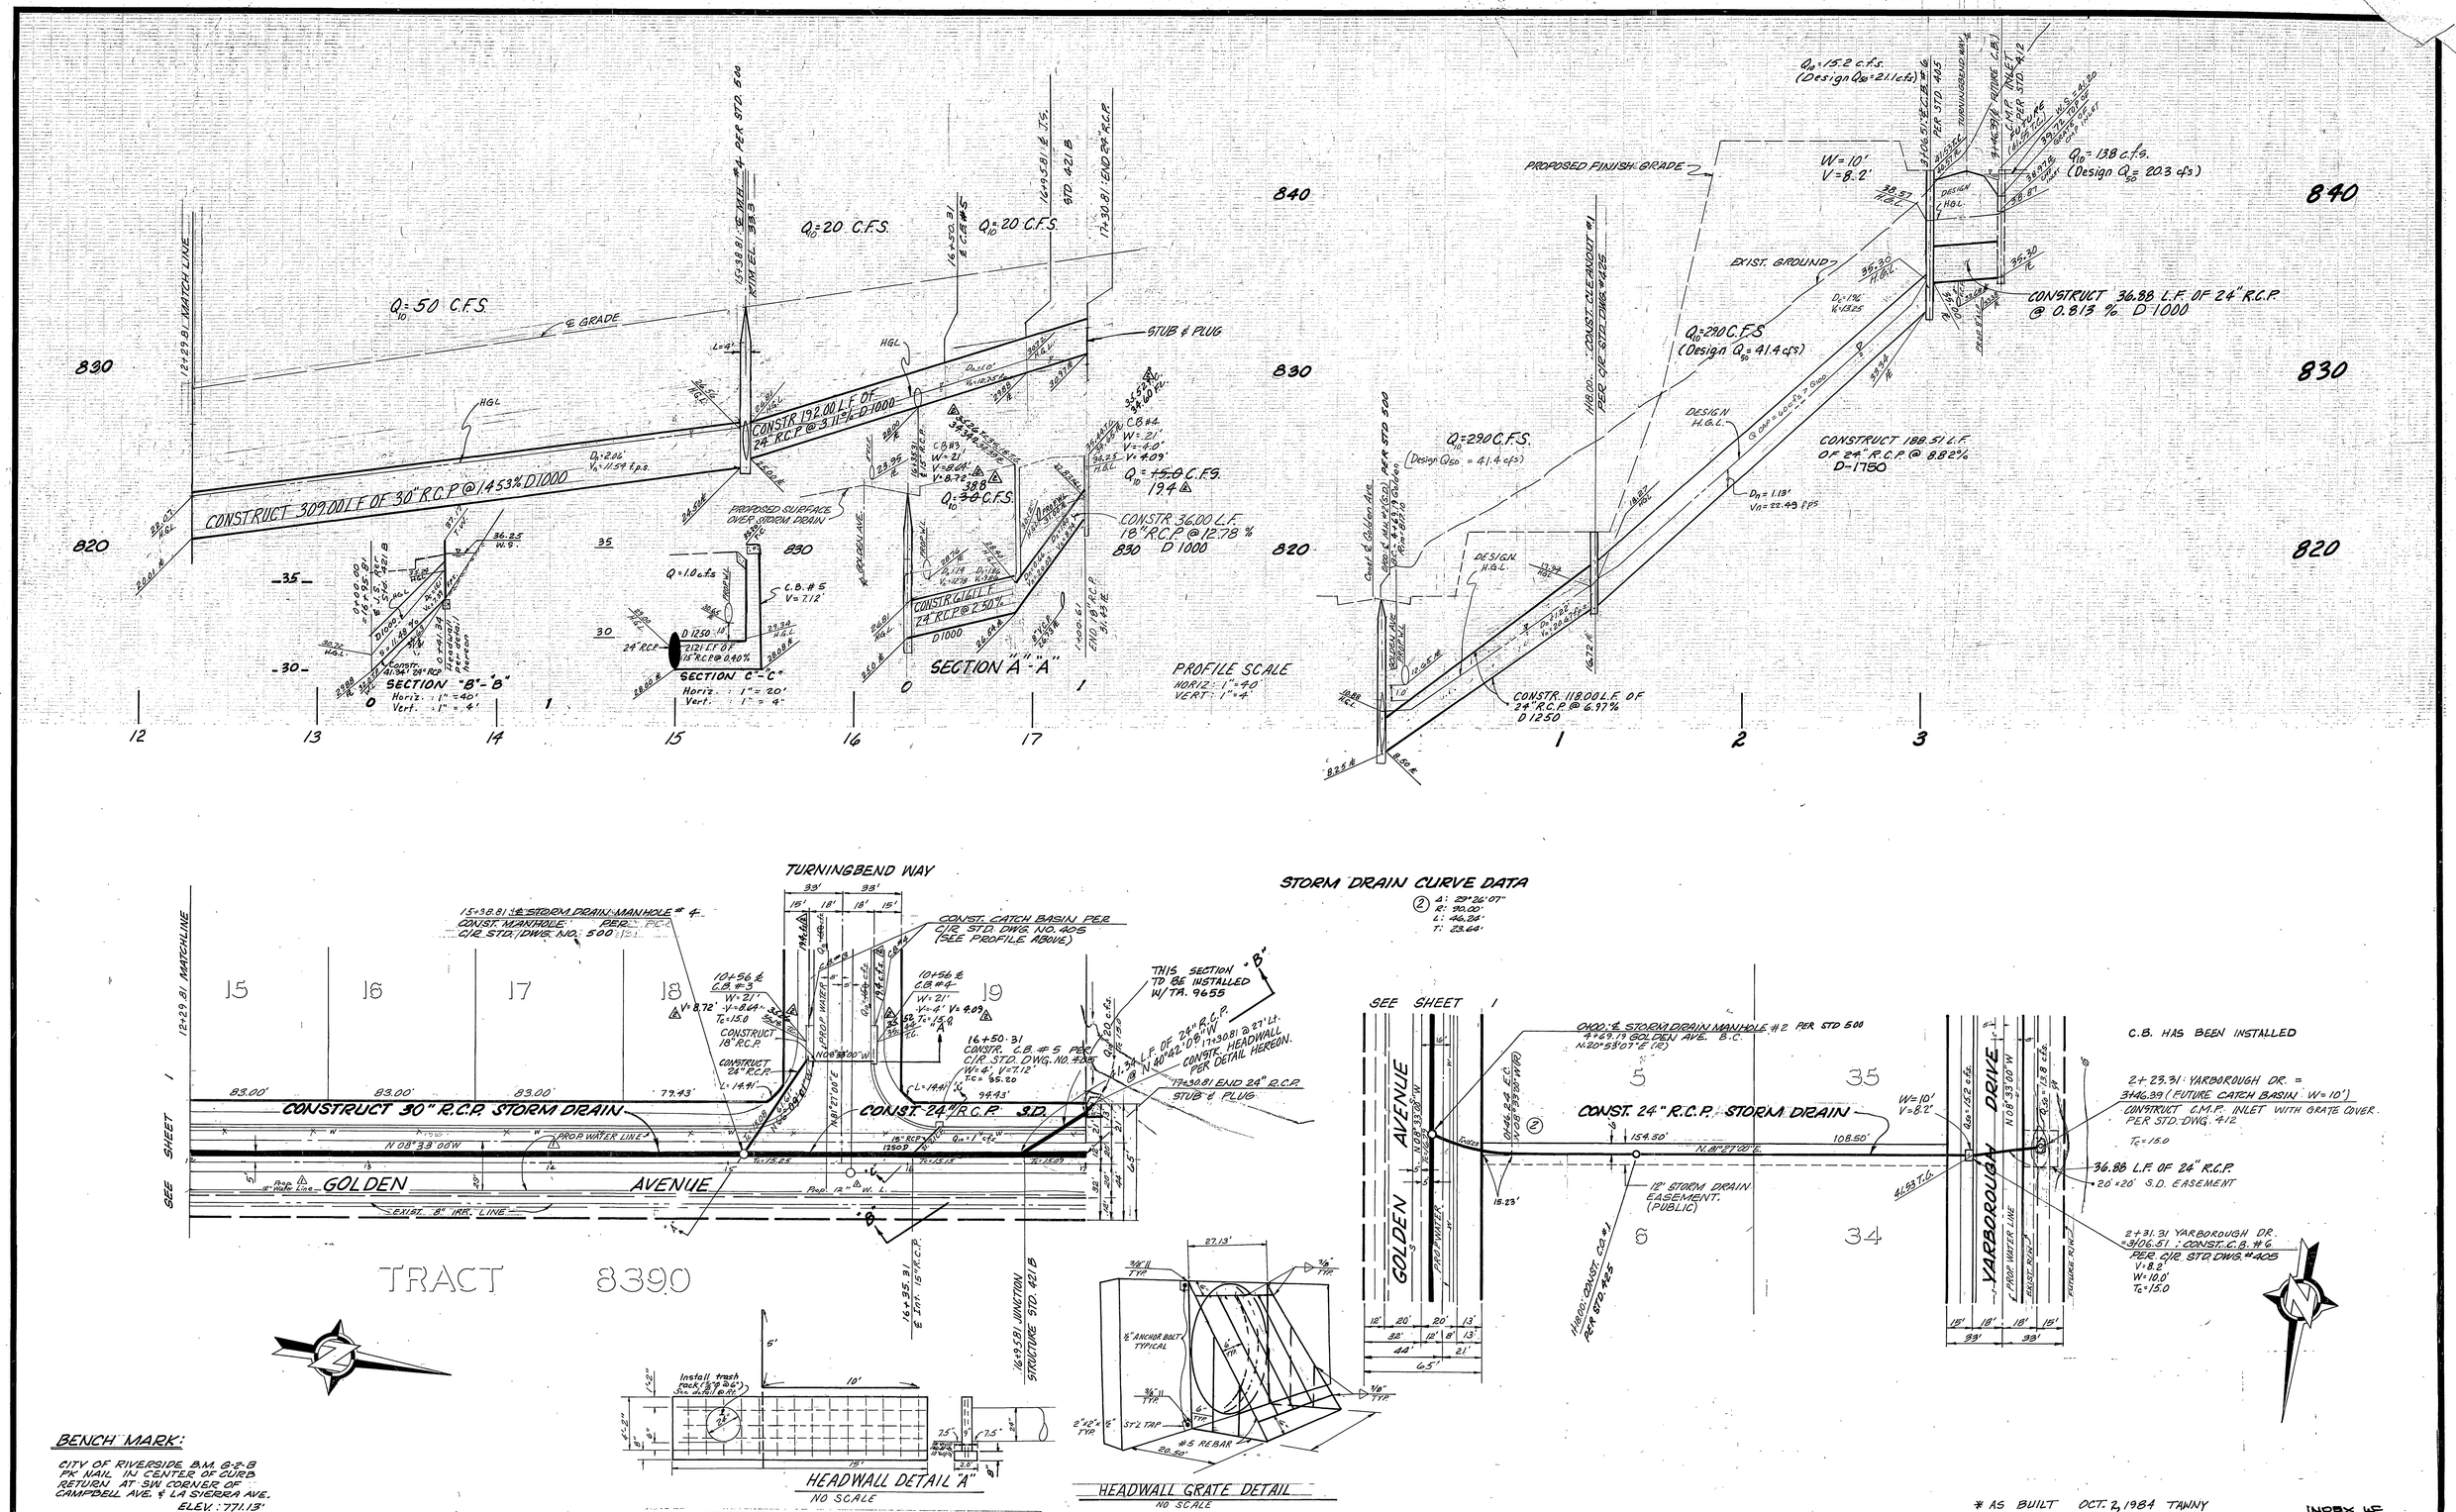

BENCH MARK:

CITY OF RIVERSIDE B.M. G-2-B
PK NAIL IN CENTER OF CURB
RETUGIA AT S.W. CORNER OF
CAMPBELL AVE. & LA SIERRA AVE.
ELEV.: 771.13'

Contractor agrees that he shall assume sole and complete responsibility for job site conditions during the course of construction of this Project, including safety of all persons and property; that this requirement shall apply continuously and not be limited to normal working hours; and that the Contractor shall defend, indemnify and hold the Owner and the Engineer harmless from any and all liability, real or alleged, in connection with the performance of work on this Project, excepting for liability arising from the sole negligence of the Owner or the Engineer.

CITY OF RIVERSIDE
DOMESTIC SYSTEM & IRRIGATION SYSTEM

Fred Lantz
WATER SYSTEMS MANAGER — DATE 4/12/82

J. F. DAVIDSON ASSOCIATES
CIVIL ENGINEERS - SURVEYORS - PLANNERS
RIVERSIDE, CALIFORNIA

APPROVED BY _____ DATE 9/19/77
R.E. No. 17550
W.O. 83-7894 FOR: POMONA 1st FED. F.B.

MARK	REVISIONS	APPR.	DATE
2	REVISED T.C.'s & V's ON C.B. # 3 & #4		11-10-83
1	Revised 12" W.L. to 29' E. of mon. &		11-2-82

DESIGNED BY LRS DRAWN BY WLE CHECKED BY LRS

CITY OF RIVERSIDE, CALIFORNIA
DEPARTMENT OF PUBLIC WORKS

APPROVED BY	BY	DATE
PRINCIPAL ENGINEER		
PARK DEPARTMENT		
TRAFFIC DIVISION		
CHIEF P. W. ENGR.		

APPROVED BY _____ DIRECTOR OF PUBLIC WORKS
DATE 7/1/83

STORM DRAIN PLAN & PROFILE
TRACT 8796-1
GOLDEN AVENUE
EASEMENT

HORIZ. SCALE: 1" = 40' VERT. SCALE: 1" = 4'

* AS BUILT OCT. 2, 1984 TANNY

INDEX 45

PROJECT NO. D-408
SHEET 2 OF 2
FILE NO. 8868