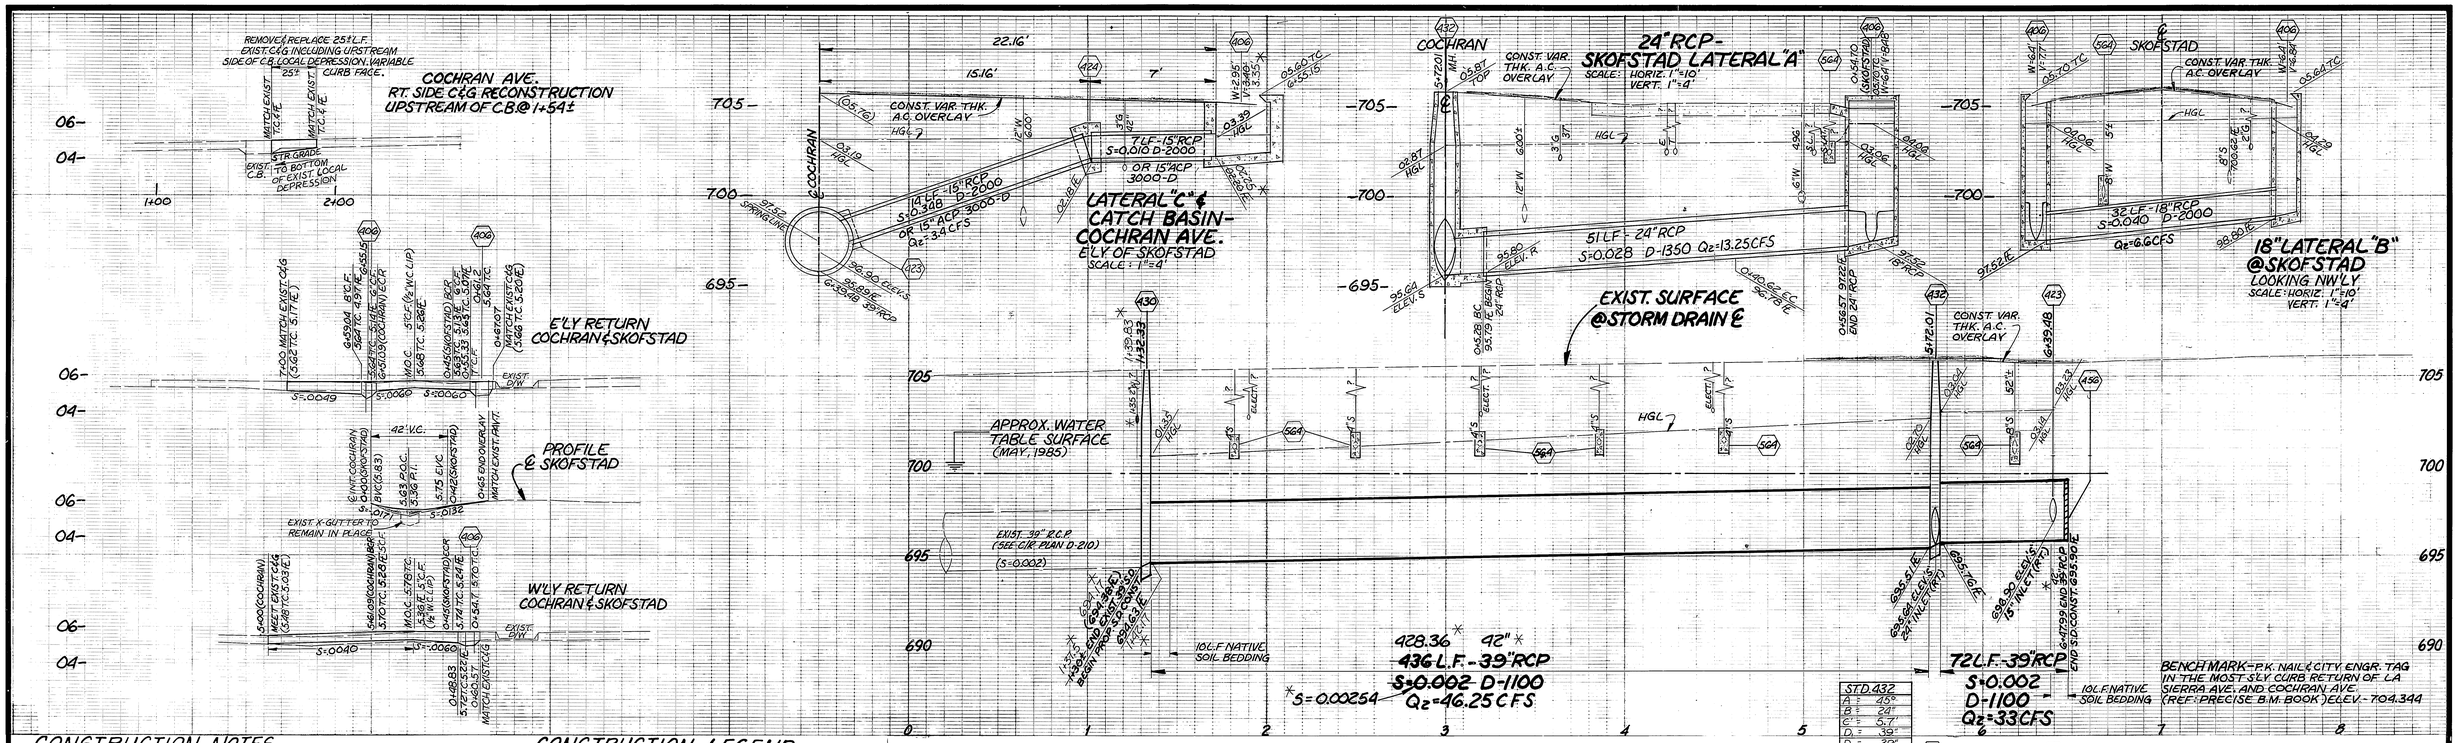

CONSTRUCTION NOTES

1. CONSTRUCTION SHALL BE IN ACCORDANCE WITH STANDARD SPECIFICATIONS FOR PUBLIC WORKS CONSTRUCTION, 1985 EDITION AND THE CITY OF RIVERSIDE STANDARD DRAWINGS.
2. ⬢ NUMBERS ABOVE 100 IN A HEXAGON ON THE PLAN REFER TO THE RESPECTIVE STANDARD DRAWING AND SHALL BE CONSTRUCTED ACCORDINGLY, UNLESS MODIFICATIONS ARE NOTED ON THIS PLAN. ANY NUMBER SHOWN BELOW THE STANDARD DRAWING NUMBER INDICATES THE SPECIFIC ALTERNATE TO BE CONSTRUCTED.
3. EXISTING UTILITIES SHOWN ON THIS PLAN ARE PLOTTED FROM UTILITY RECORDS. THE CONTRACTOR IS REQUIRED TO TAKE DUE PRECAUTIONARY MEASURES TO LOCATE & PROTECT ALL UTILITIES WHETHER OR NOT SHOWN ON THIS PLAN. IF THE COVER OF A UTILITY IS KNOWN IT IS SHOWN IN THE PROFILE. UTILITIES SHOWN IN THE PROFILE AS <> INDICATES THAT THE COVER IS UNKNOWN, BUT THE UTILITY IS NOT EXPECTED TO CONFLICT WITH THE PROPOSED IMPROVEMENTS.
4. ALL ELEVATIONS SHOWN ON THE PLAN SHALL BE STAKED IN THE FIELD.
5. EXIST. 39" RCP AT STA. 1+30± SHALL BE EXPOSED AND ELEV. VERIFIED BY CITY SURVEYORS PRIOR TO THE ISSUANCE OF GRADE SHEETS.
6. PERMANENT TRENCH RESURFACING SHALL BE 4½" A.C. OVER 11" C.A.B.
7. A.C. OVERLAY AND FINAL LAYER OF TRENCH RESURFACING AND FULL DEPTH SECTION FROM STA. 5+00 TO 6+59.04 ARE TO BE ACCOMPLISHED IN THE SAME OPERATION SUCH THAT NO SEAMS ARE CREATED.
8. THE GROUNDWATER TABLE SHOWN WAS PROVIDED TO THE CITY OF RIVERSIDE BY WESTERN MUNICIPAL WATER DISTRICT FROM WELL MEASUREMENTS TAKEN IN MAY, 1985. IT IS THE RESPONSIBILITY OF THE CONTRACTOR TO INVESTIGATE THE PRESENT GROUNDWATER TABLE PRIOR TO SUBMITTING A BID. (SEE CONST. NOTE 9) PER. SECTION 306-1.2.1 OF THE SPECIAL PROVISIONS.
9. A BORING BY THE CITY OF RIVERSIDE, LOCATED APPROX. 400' E'LY OF LA SIERRA AVE. IN THE S'LY PARKWAY OF COCHRAN AVE., IS AVAILABLE FOR THE CONTRACTOR TO CHECK THE WATER TABLE PRIOR TO SUBMITTING A BID. A SOIL-TYPE PROFILE FROM THE BORING IS AVAILABLE TO THE CONTRACTORS AT THE PUBLIC WORKS DEPT., ON THE 3RD FLOOR OF CITY HALL AT 3900 MAIN ST., RIVERSIDE, CA.

CONSTRUCTION LEGEND

VARIABLE THICKNESS A.C. OVERLAY (0.05' MIN.)

6" FULL DEPTH A.C.

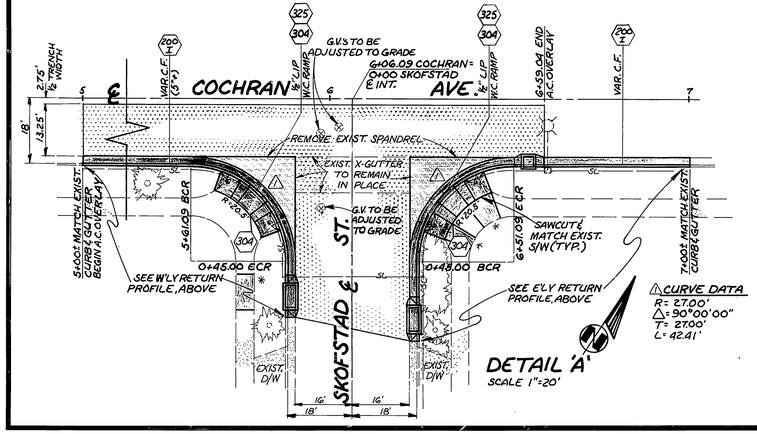

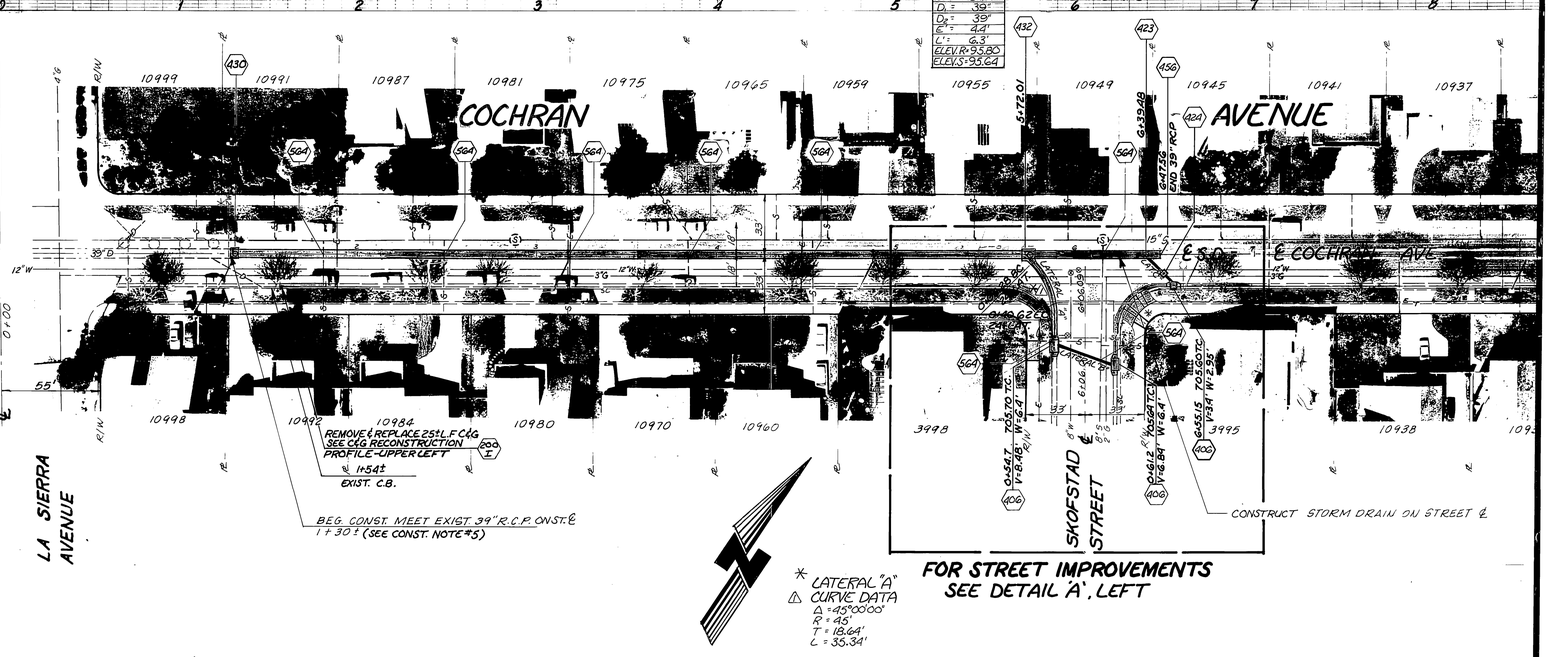

* As built 10-86 TE
* AS BUILT 10-22-86 RVZ

INDEX WF

CITY OF RIVERSIDE
PUBLIC WORKS DEPARTMENT

	DRAWN BY	DATE	BY
PRINCIPAL ENGINEER		DATE 8-16-85	
PAVING DEPARTMENT			
RW AFR DIVISION			
CHIEF ENGINEER			

APPROVED BY
PUBLIC WORKS DIRECTOR
DATE 8-16-85

MARK REVISIONS APPR. DATE

DESIGNED BY SK DRAWN RVZ CHECKED BY RAM

COCHRAN AVENUE STORM DRAIN

ACCOUNT NO. 09-573-493

D-460

SHEET 1 OF 1

HORIZ. SCALE: 1"= 40' VERT. SCALE: 1"= 4'