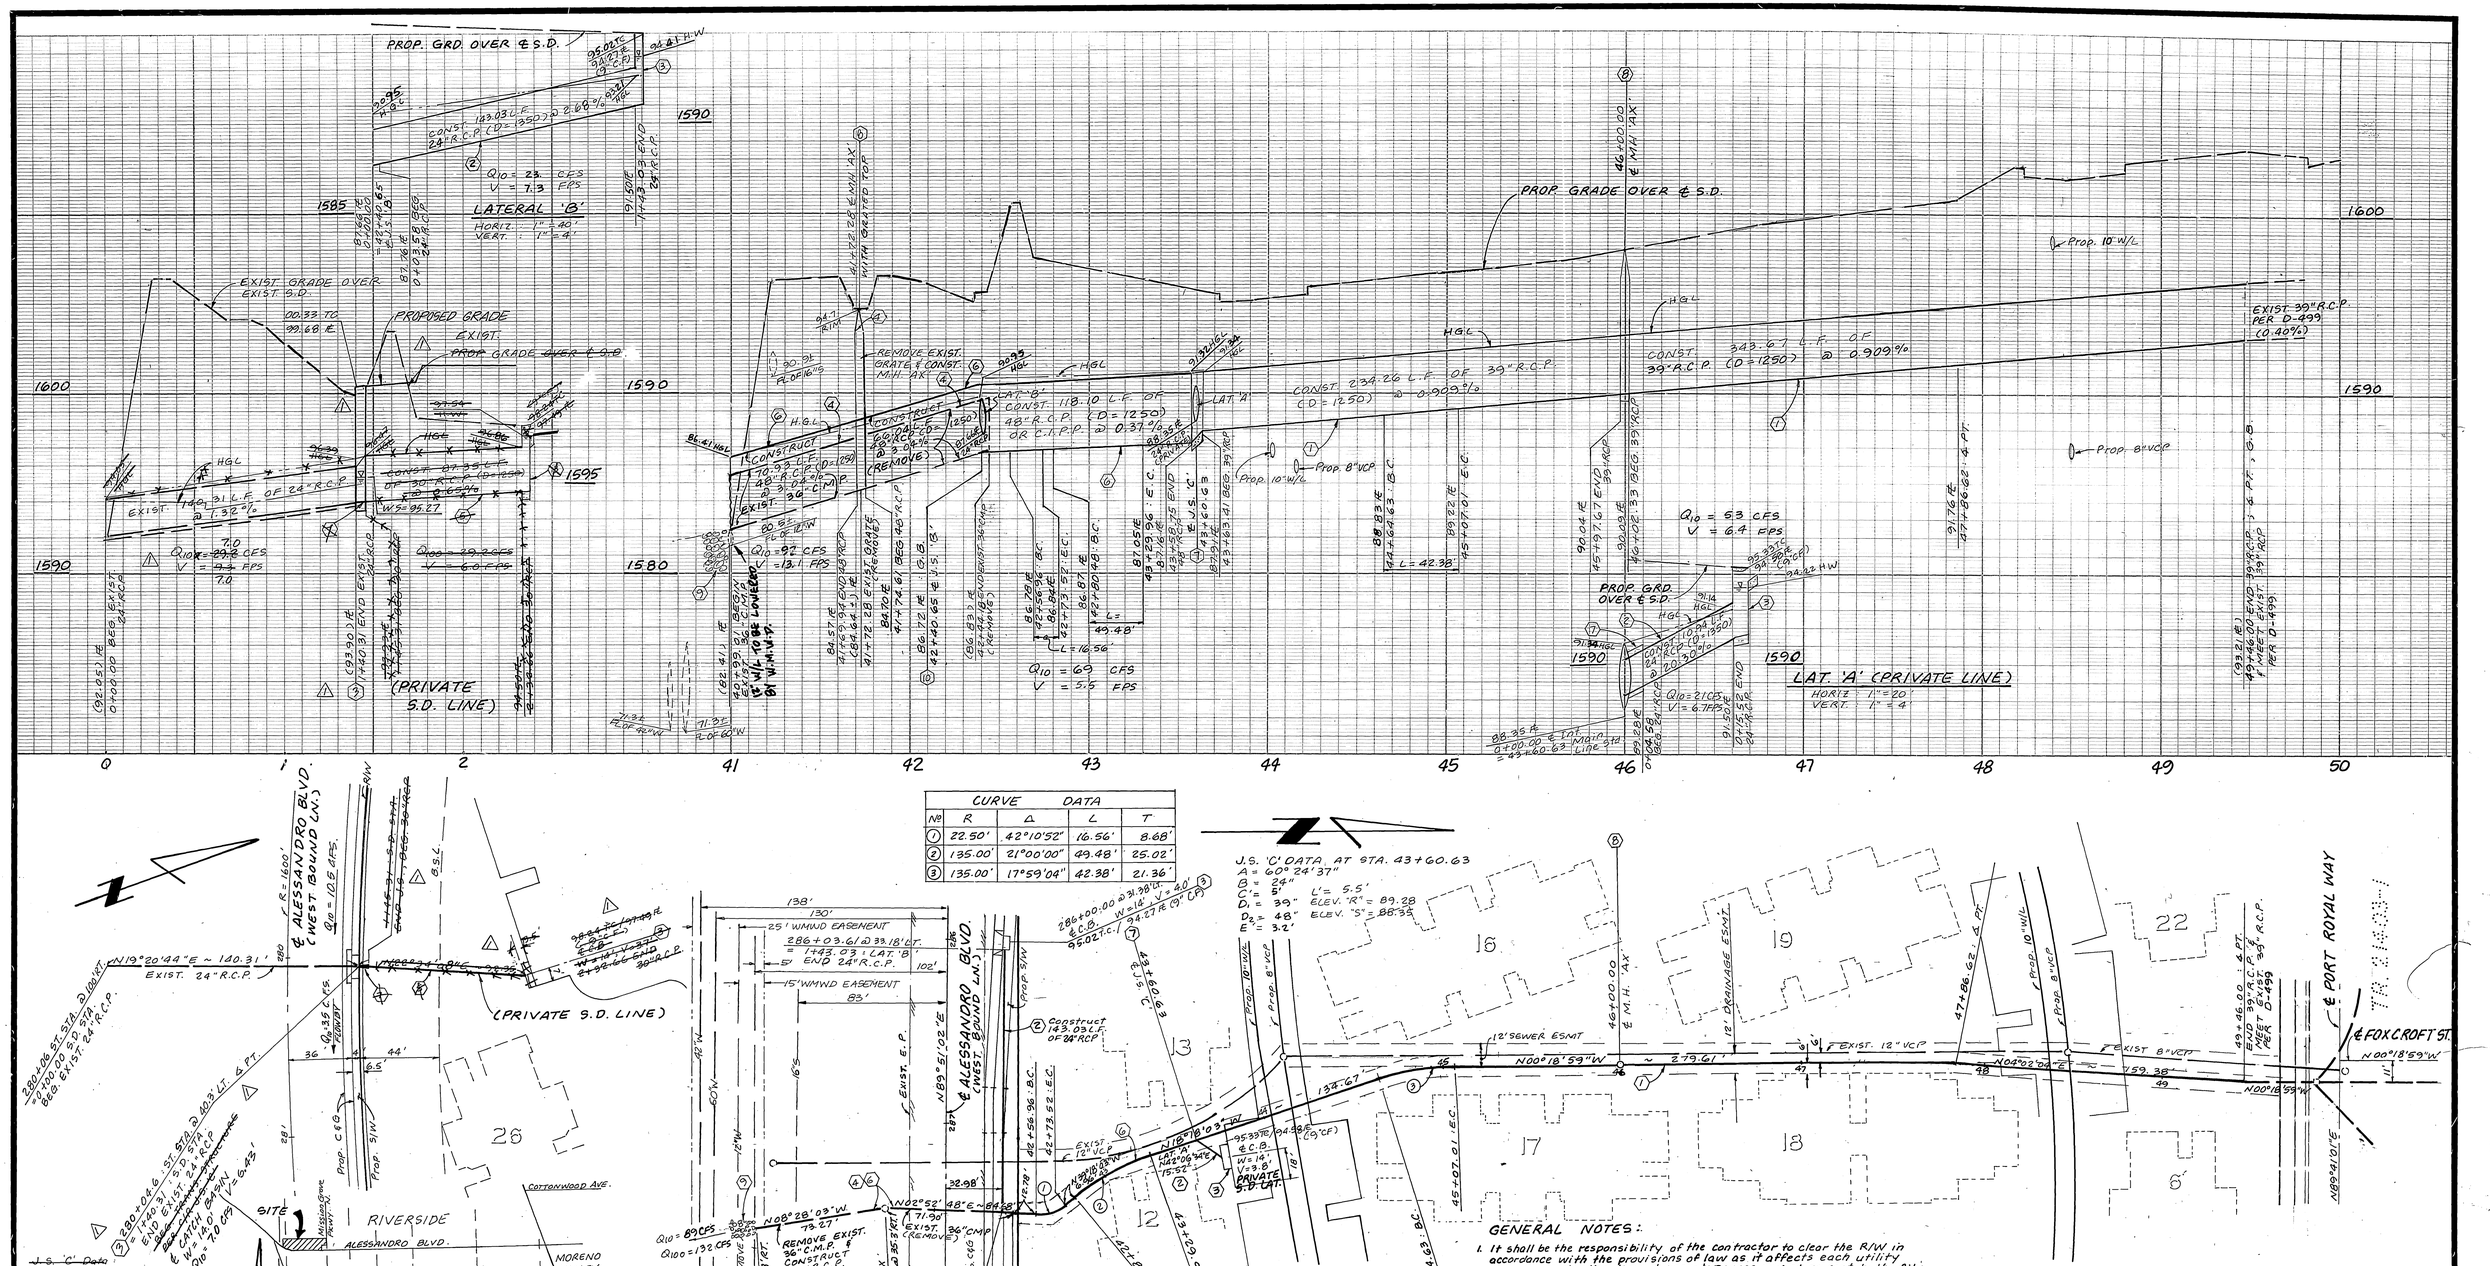

INDEXED 6-14-88 JH

Underground Service Alert
CALL BEFORE YOU DIG
Call: TOLL FREE
1-800
422-4133
TWO WORKING DAYS BEFORE YOU DIG

PRIVATE ENGINEERING NOTE

CONSTRUCTION CONTRACTOR AGREES THAT IN ACCORDANCE WITH GENERALLY ACCEPTED CONSTRUCTION PRACTICES, CONSTRUCTION CONTRACTOR WILL BE REQUIRED TO ASSUME SOLE AND COMPLETE RESPONSIBILITY FOR JOB SITE CONDITIONS DURING THE COURSE OF CONSTRUCTION OF THE PROJECT, INCLUDING SAFETY OF ALL PERSONS AND PROPERTY; THAT THIS REQUIREMENT SHALL BE MADE TO APPLY CONTINUOUSLY AND NOT BE LIMITED TO NORMAL WORKING HOURS, AND CONSTRUCTION CONTRACTOR FURTHER AGREES TO DEFEND, INDEMNIFY AND HOLD DESIGN PROFESSIONAL HARMLESS FROM ANY AND ALL LIABILITY, REAL OR ALLEGED, IN CONNECTION WITH THE PERFORMANCE OF WORK ON THIS PROJECT, EXCEPTING LIABILITY ARISING FROM THE SOLE NEGLIGENCE OF DESIGN PROFESSIONAL.

REGISTERED PROFESSIONAL ENGINEER JOHN W. CANTY No. 17550 Exp. 6/30/89 CIVIL STATE OF CALIFORNIA

PREPARED UNDER THE DIRECTION OF: John W. Canty
REGISTERED CIVIL ENGINEER NO. 17550
EXPIRATION DATE 6-30-89 DATE 5/26/87
REVIEWED BY WESTERN MUNICIPAL WATER DISTRICT
CHIEF ENGINEER RCE 17304 4.5.88 DATE

J.F. DAVIDSON ASSOCIATES, INC.
CIVIL ENGINEERS • SURVEYORS • PLANNERS
P.O. BOX 493, RIVERSIDE, CA 92502 (714) 686-0844
11200 SO. MT. VERNON AVE. #D, COLTON, CA 92324 (714) 825-1082
73-080 EL PASEO, #103, PALM DESERT, CA 92260 (619) 346-5691
JFD ASSOCIATES

SCALE 1" = 40'
DATE MAY, 1987
BENCH MARK: CITY OF RIVERSIDE BM # FB-E PK NAIL & CITY TAG IN TOP OF LARGE ROCK 70'SLY OF ALESSANDRO BLVD. & 0.60 MILE S'ELY OF VIA VISTA DR. NEAR PP # 77S 963H ELEV. 1502.195'

MARK	REVISIONS	APPR	DATE
1	REVISED STORM DRAIN PER TR 27653	JJC	12/1/87

DESIGNED BY LRS DRAWN BY LRS CHECKED BY LRS

CITY OF RIVERSIDE, CALIFORNIA
DEPARTMENT OF PUBLIC WORKS

	BY	DATE
APPROVED BY		
PRINCIPAL ENGINEER		
PARK DEPARTMENT		
TRAFFIC DIVISION		
CHIEF P. W. ENGR.		

APPROVED BY: Barry Bard
DIRECTOR OF PUBLIC WORKS
DATE 5/16/88

TRACT NO. 21434
STORM DRAIN PLAN
FROM ALESSANDRO BLVD.
TO PORT ROYAL WAY

HORIZ. SCALE: 1" = 40' VERT. SCALE: 1" = 4'

PROJECT NO. D-539
SHEET 1 OF 1
FILE NO. 86-9190

FRED