GENERAL NOTES

1 IT SHALL BE THE RESPONSIBILITY OF THE CONTRACTOR TO CLEAR THE RIGHT-OF-WAY IN ACCORDANCE WITH THE SPECIAL PROVISIONS OF LAW AS IT AFFECTS EACH UTILITY INCLUDING IRRIGATION LINES AND APPURTENANCES AND AT NO COST TO THE CITY.

2 CONSTRUCTION SHALL BE IN ACCORDANCE WITH THE CITY OF RIVERSIDE DEPARTMENT OF PUBLIC WORKS, STANDARD DRAWINGS, ITS SUPPLEMENTAL NOTES AND THE STANDARD SPECIFICATIONS FOR PUBLIC WORKS CONSTRUCTION, CURRENT EDITION.

3 THE PRIVATE ENGINEER SIGNING THESE PLANS IS RESPONSIBLE FOR ASSURING THE ACCURACY AND ACCEPTABILITY OF THE WORK HEREON. IN THE EVENT OF DISCREPANCIES ARISING DURING CONSTRUCTION, THE PRIVATE ENGINEER SHALL BE RESPONSIBLE FOR DETERMINING AN ACCEPTABLE SOLUTION AND REVISING THE PLANS FOR APPROVAL BY THE CITY.

4 THE DEVELOPER SHALL BE RESPONSIBLE FOR PRESERVING OR REESTABLISHING AND REFERENCING SURVEY MONUMENTS DESTROYED, DISTURBED OR BURIED AS A RESULT OF CONSTRUCTION SHOWN HEREON.

5 ALL FLAGGED ELEVATIONS IN THE PLAN VIEW SHALL BE STAKED IN THE FIELD BY THE PRIVATE ENGINEER.

6 ANY TRAFFIC CONTROL STRIPING OBLITERATED AND/OR BADLY WORN DURING CONSTRUCTION SHALL BE RESTORED BY THE CONTRACTOR WITHIN FIVE DAYS AFTER NOTIFICATION FROM THE CITY INSPECTORS.

7 THE CONTRACTOR SHALL CALL IN A LOCATION REQUEST TO UNDERGROUND SERVICE ALERT (USA), PHONE # 1-800-227-2600, TWO WORKING DAYS BEFORE DIGGING. NO CONSTRUCTION PERMIT WILL BE ISSUED BY THE PUBLIC WORKS DEPARTMENT INVOLVING EXCAVATION FOR UNDERGROUND FACILITIES UNLESS THE APPLICANT HAS BEEN PROVIDED AN INQUIRY IDENTIFICATION NUMBER BY U.S.A.

8 PIPE BEDDING TO BE CASE I PER CITY OF RIVERSIDE STD. NO. 452.

9 NO PERSON SHALL PERFORM ANY CONSTRUCTION ACTIVITY OR INSTALL ANY OBJECTS WITHIN THE PUBLIC RIGHTS-OF-WAY OR EASEMENTS OF THE CITY OF RIVERSIDE WITHOUT A VALID CONSTRUCTION PERMIT OR, A STREET OPENING PERMIT OR AN ENCROACHMENT PERMIT ISSUED BY THE CITY'S PUBLIC WORKS DEPARTMENT.

10 DEVELOPER AND/OR CONTRACTOR TO GIVE RCFC 5-DAYS WRITTEN NOTICE PRIOR TO STARTING WORK ON STORM DRAIN (OR DOING ANY WORK WITHIN EASEMENTS). RCFC ENCROACHMENT PERMIT NO.1-0-0060-2460.

11 THE CONTRACTOR SHALL COORDINATE TRENCHING FOR CABLE TELEVISION WITH OTHER TRENCHING WITHIN THE SUBDIVISION.

NOTICE TO CONTRACTOR

ACCORDING TO INFORMATION PROVIDED BY UNDERGROUND SERVICE ALERT (U.S.A.) DATED FEBRUARY 18 1999 . THE FOLLOWING ORGANIZATIONS ARE U.S.A. MEMBERS WITHIN THE PROJECT AREA:

CHARTER COMMUNICATIONS
PACIFIC BELL MOBILE SERVICE
QUESTAR LINE 90 COMPANY
SANTA ANA WATERSHED PROJECT AUTH.
MEDIA ONE
PACIFIC BELL
CITY OF RIVERSIDE
THE GAS COMPANY

THE EXISTENCE AND LOCATIONS OF ALL UNDERGROUND UTILITIES (UTILITY PIPES, STRUCTURES, ETC.) SHOWN ON THESE PLANS (MAIN LINES ONLY - NO SERVICE LATERALS) WERE ASCERTAINED BY A REVIEW OF RECORDS PROVIDED BY THESE MEMBER AGENCIES AND ARE APPROXIMATE. NEITHER THE OWNER NOR THE ENGINEER ASSUMES ANY RESPONSIBILITY FOR UTILITIES NOT SHOWN OR NOT IN THE LOCATION SHOWN.

THE CONTRACTOR IS REQUIRED TO TAKE DUE PRECAUTIONARY MEASURES TO PROTECT ALL UTILITIES SHOWN ON THESE PLANS AND/OR ANY OTHER UNDERGROUND UTILITIES NOT OF RECORD OR NOT SHOWN ON THESE PLANS.

CONSTRUCTION NOTES

① ——— CONSTRUCT 18" RCP (D-2000)
② ——— CONSTRUCT 24" RCP (D-1500)
③ ——— CONSTRUCT CATCH BASIN PER CITY OF RIVERSIDE STD. DWG. NO 405, W & V AS NOTED
④ ——— CONSTRUCT JUNCTION STRUCTURE NO. 6 PER DETAIL ON SHEET #1
⑤ ——— CONSTRUCT MANHOLE "EZ" PER CITY OF RIVERSIDE STD. DWG. NO. 431
⑥ ——— CONSTRUCT CONCRETE COLLAR PER CITY OF RIVERSIDE STD. DWG. NO.424
⑦ ——— CONSTRUCT TIMBER BULKHEAD PER CITY OF RIVERSIDE STD. DWG. NO. 456

INDEX MAP
SCALE: 1" = 200'

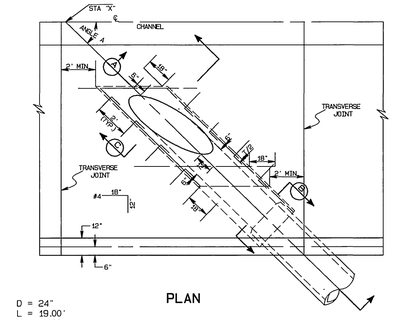

PLAN

D = 24"
L = 19.00'
C = 10.88'
EL_R = 689.34
EL_S = 686.02
ANGLE A = 60±
STA = 0+00.00 LINE A
= 62+22.92 LA SIERRA CHANNEL

TABLE
FOR DIMENSIONS AND BAR SIZES

D (IN)	T (IN)	"A" BARS
18	9	
21	9	NO LONGITUDINAL OR "A" BARS
24	9	
27	9	
30	9	
33	7	
36	7	# 4 @ 6"
39	7	
42	8	
45	8	
48	8	
51	9	
54	9	
57	10	
60	10	# 5 @ 6"
63	10	
66	11	
69	11	
72	11	
78	12	
84	13	

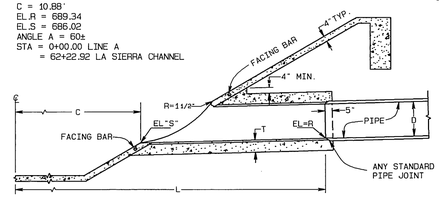

1. VALUES FOR D,L,C, EL. R, EL. S, ANGLE A AND STA. "X" ARE TO BE SHOWN ON PROJECT DRAWINGS.
2. REINFORCING BARS SHALL BE PLACED 1 1/2" CLEAR FROM FACE OF CONCRETE.
3. CONCRETE SHALL BE CLASS "A".
4. PLACE # 4-12"X18" BARS WITH SHORT LEG HORIZONTAL IN VERTICAL J.S. WALL ROTATE LONGER LEG INTO CENTER OF SLOPE PAVING
5. REINFORCEMENT SHALL BE PROVIDED IN ALL PORTIONS OF THE JUCTION STRUCTURE AS INDICATED ON DRAWINGS REGARDLESS OF BAR LENGTH MODIFICATION REQUIRED TO ACHIEVE PROPER CLEARANCES

SECTION A

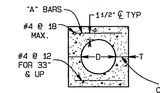

SECTION B

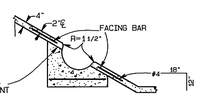

SECTION C

JUNCTION STRUCTURE NO. 6
STANDARD DRAWING RCFCD J5231

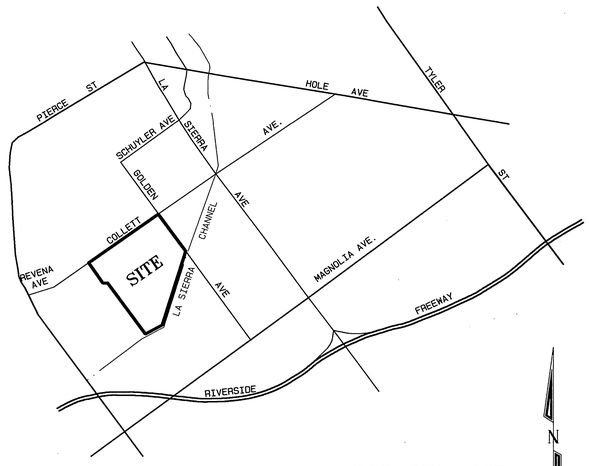

VICINITY MAP
NOT TO SCALE

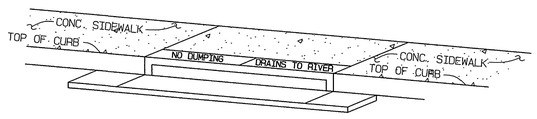

CATCH BASIN STENCILING DETAIL

CATCH BASIN STENCILING DETAIL
NOT TO SCALE

Ⓐ STENCILS TO HAVE 2" LETTERS AS FOLLOWS:
NO DUMPING
DRAINS TO RIVER
Ⓑ PLACE BOTH STENCILS CENTERED WITHIN THE CATCHBASIN OPENING AND WITHIN THE TOP OF THE CURB.
Ⓒ SPRAY BOTH STENCILS WITH WHITE PAINT.
Ⓓ REMOVE STENCILS WHEN PAINT IS DRY.

City of Riverside
Water Department
(FOR SHEETS 1-5)
Richard L. Durbin 1-12-01
approved by date

City of Riverside
Public Utilities Department
Overhead and Underground
John L Sevy 1-3-01
approved by date

BENCH MARK:

CITY OF RIVERSIDE BENCH MARK NO E2-H3
P.K. NAIL AND TAG IN THE CENTER OF THE MOST NORTHERLY CURB RETURN OF COLLETT AVENUE AND GOLDEN AVENUE

ELEVATION: 697.978

REGISTERED PROFESSIONAL ENGINEER
MOHAMMAD FAGHIH
NO. C39530
EXP. 12-31-01
CIVIL
STATE OF CALIFORNIA

CITY BUSINESS TAX CERTIFICATE NO. 005751 EXP. 12-31-01

UNDERGROUND SERVICE ALERT
CALL: TOLL FREE
1·800
227·2600
TWO WORKING DAYS BEFORE YOU DIG

ALBERT A. WEBB ASSOCIATES
CIVIL ENGINEERS
3788 McCRAY STREET RIVERSIDE, CA 92506
(909) 686-1070

APPROVED BY [illegible] DATE 12/8/00
R.C.E. NO. C39530

W.O. 99-0206 FOR: GRIFFIN INDUSTRIES F.B. 1997

MARK	REVISIONS	APPR.	DATE

DESIGNED BY: LM CHECKED BY: MF CHECKED BY ____

CITY OF RIVERSIDE, CALIFORNIA
PUBLIC WORKS DEPARTMENT

APPROVED BY	BY	DATE
PRINCIPAL ENGINEER		12/11/01
PARK DEPARTMENT		
TRAFFIC DEPARTMENT		
STREET SERVICES		12/11/01
DEP. P.W. DIRECTOR		12/11/01

APPROVED BY
DIRECTOR OF PUBLIC WORKS
DATE 1-31-2001

*AS-BUILT PER PLAN 9-30-05 GH

STORM DRAIN PLAN & PROFILE

TRACT NO. 29089-6
INDEX SHEET

SCALE: AS SHOWN

ACCOUNT NO. 990206
DRAWING NUMBER
D-687
SHEET 1 OF 5

99-0206

INDEXED 2-08-2001 GH

G:\1999\99-0206\99020605.pro

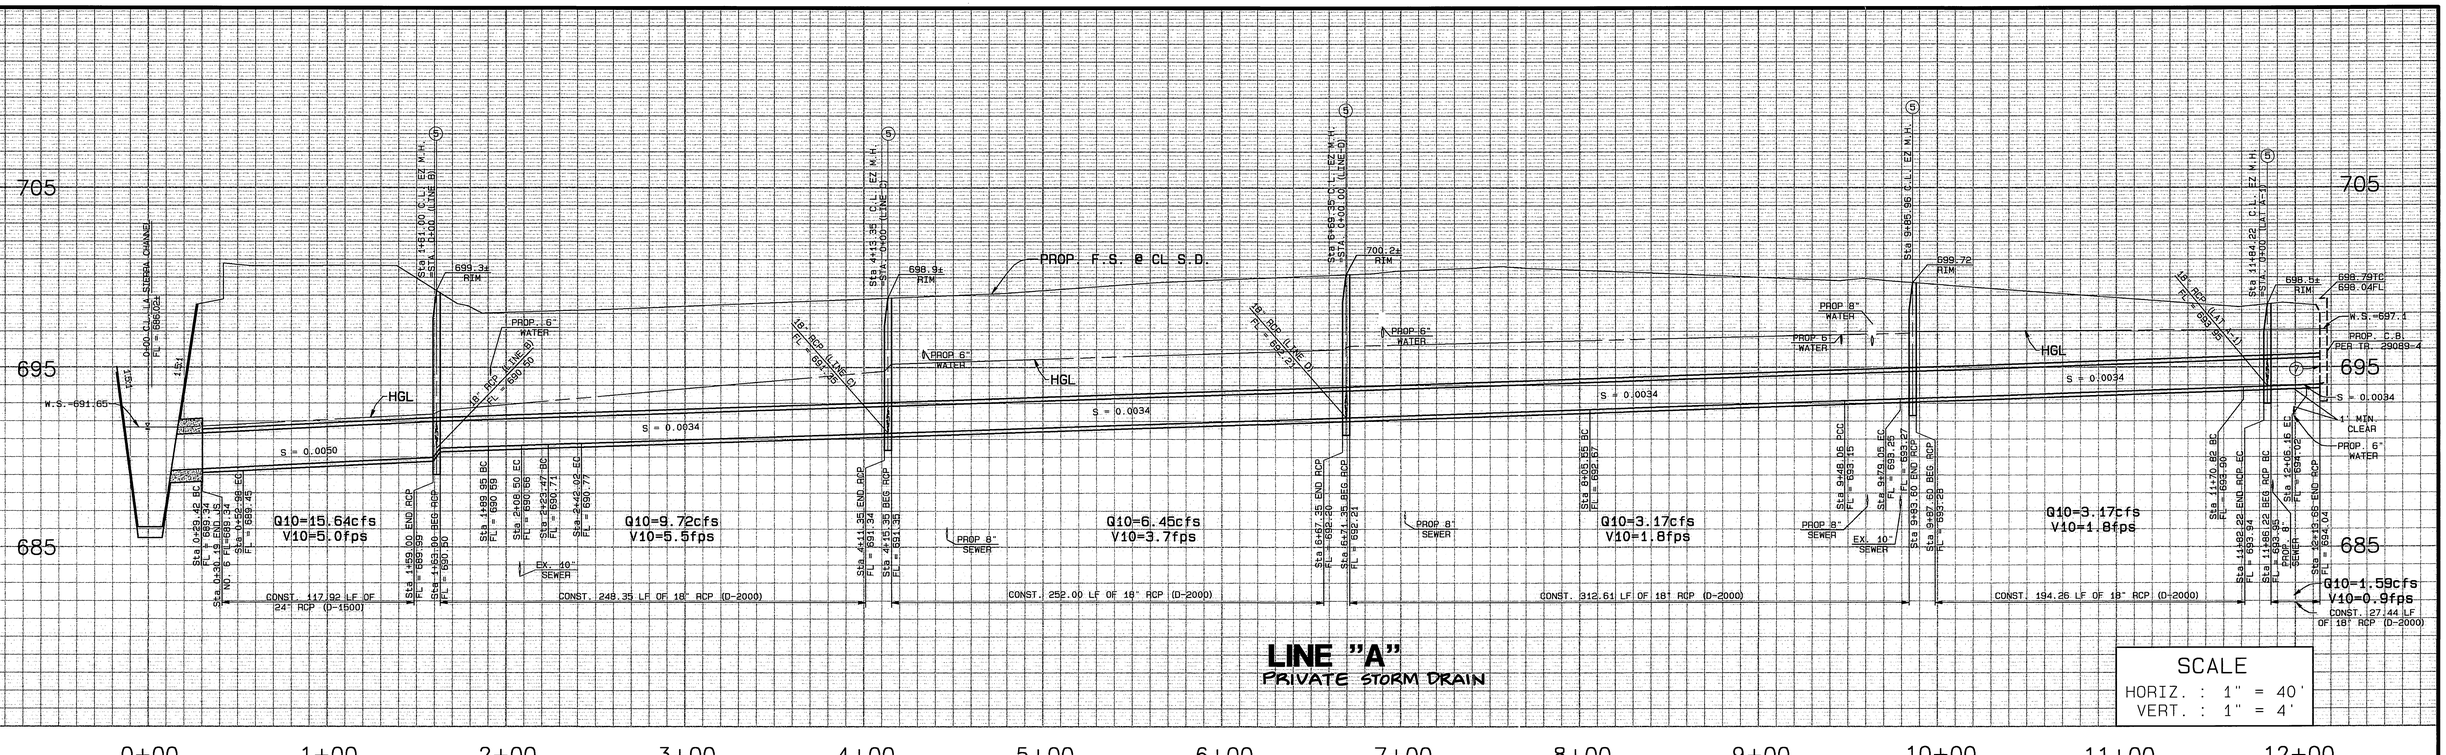

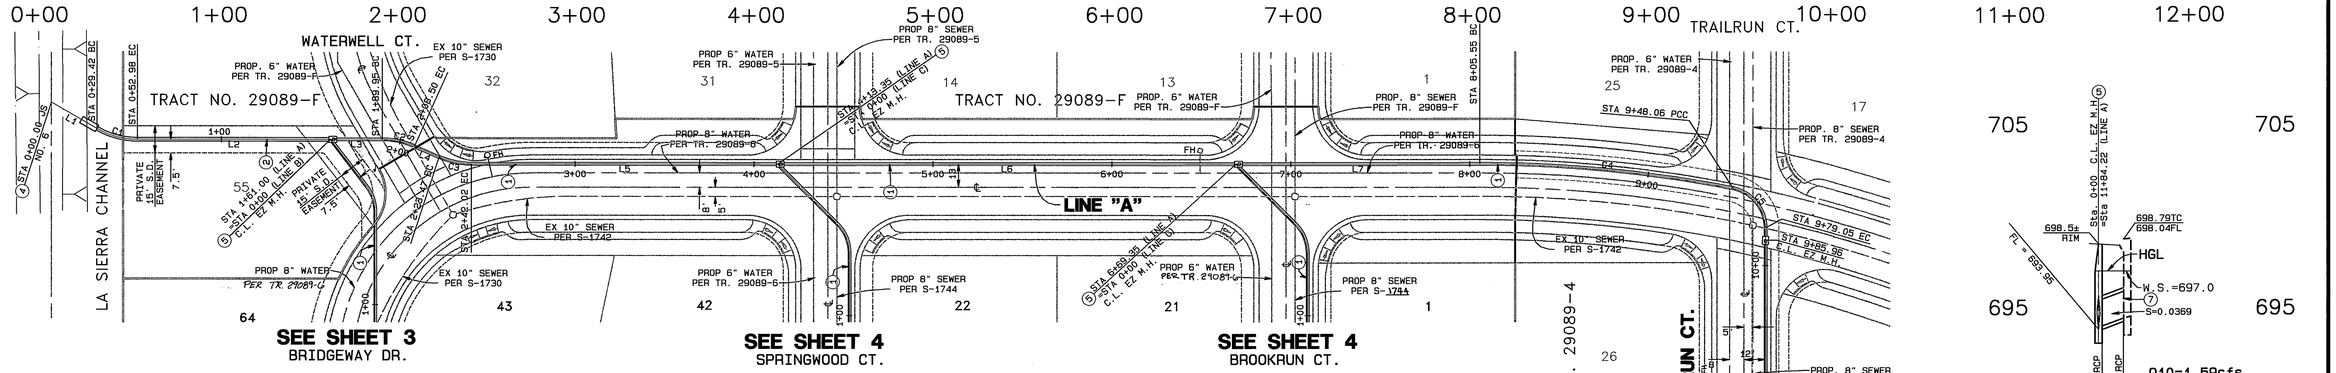

RIVERGLEN DRIVE
LINE "A" AND LATERAL "A-1"

CURVE DATA

CURVE	DELTA	RADIUS	LENGTH	TANGENT
C1	30°00'00"	45.00'	23.56'	12.06'
C2	23°36'38"	45.00'	18.54'	9.41'
C3	23°36'36"	45.00'	18.54'	9.41'
C4	11°03'50"	738.00'	142.51'	71.48'
C5	78°56'08"	22.50'	31.00'	18.53'
C6	34°07'52"	22.50'	13.40'	6.91'
C7	55°52'08"	22.50'	21.94'	11.93'

LINE DATA

LINE	BEARING	DISTANCE
L1	N37°39'27"W	29.42'
L2	N67°39'27"W	108.02'
L3	N67°39'27"W	28.95'
L4	N44°02'49"W	14.98'
L5	N67°39'25"W	171.34'
L6	N67°39'25"W	256.00'
L7	N67°39'25"W	136.19'
L8	N22°20'33"E	184.86'
L9	N67°39'27"W	7.50'
L10	N22°39'27"W	13.97'

CONSTRUCTION NOTES

1. CONSTRUCT 18" RCP (D-2000)
2. CONSTRUCT 24" RCP (D-1500)
3. CONSTRUCT CATCH BASIN PER CITY OF RIVERSIDE STD. DWG. NO 405, W & V AS NOTED
4. CONSTRUCT JUNCTION STRUCTURE NO. 6 PER DETAIL ON SHEET #1
5. CONSTRUCT MANHOLE "EZ" PER CITY OF RIVERSIDE STD. DWG. NO. 431
6. CONSTRUCT CONCRETE COLLAR PER CITY OF RIVERSIDE STD. DWG. NO.424
7. CONSTRUCT TIMBER BULKHEAD PER CITY OF RIVERSIDE STD. DWG. NO. 456

UNDERGROUND SERVICE ALERT
CALL: TOLL FREE
1·800
227·2600
TWO WORKING DAYS BEFORE YOU DIG

BENCH MARK:

CITY OF RIVERSIDE BENCH MARK NO E2-H3
P.K. NAIL AND TAG IN THE CENTER OF THE MOST NORTHERLY CURB RETURN OF COLLETT AVENUE AND GOLDEN AVENUE

ELEVATION: 697.978

REGISTERED PROFESSIONAL ENGINEER
MOHAMMAD FAGHIH
NO. C39530
EXP. 12-31-01
CIVIL
STATE OF CALIFORNIA

CITY BUSINESS TAX CERTIFICATE NO. 005751 EXP. 12-31-01

ALBERT A. WEBB ASSOCIATES
CIVIL ENGINEERS
3788 McCRAY STREET RIVERSIDE, CA 92506
(909) 686-1070

APPROVED BY MOF → Fagl DATE 12/8/00
R.C.E. NO. C39530

W.O. 99-0206 FOR: GRIFFIN INDUSTRIES F.B. 1997

MARK	REVISIONS	APPR.	DATE

DESIGNED BY: ___ CHECKED BY: ___ CHECKED BY ___

CITY OF RIVERSIDE, CALIFORNIA
PUBLIC WORKS DEPARTMENT

APPROVED BY	BY	DATE
PRINCIPAL ENGINEER		
PARK DEPARTMENT	—	—
TRAFFIC DEPARTMENT	—	—
STREET SERVICES		11/21
DEP. P.W. DIRECTOR		1/24/01

APPROVED BY
R. M. Scott
DIRECTOR OF PUBLIC WORKS
DATE 1-31-2001

STORM DRAIN PLAN & PROFILE

TRACT NO. 29089-6
LINE "A" AND LATERAL "A-1"
PRIVATE STORM DRAINS
(ALSO, TR. 29089-4)

SCALE: HORIZ. = 1"=40' VERT.= 1"=4'

ACCOUNT NO. 990206
DRAWING NUMBER
D-687
SHEET 2 OF 5
99-0206

GRAPHIC SCALE 1"=40'
0 40 80 120

#AS-BUILT PER PLANS 9-30-25 GH

INDEXED 2-08-2001 GH

D:\1999\99-0206\D687.dgn

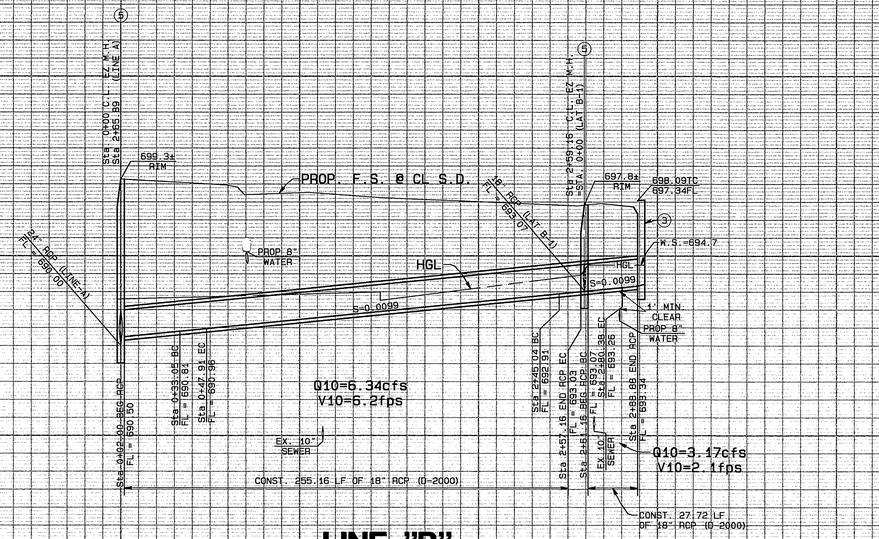

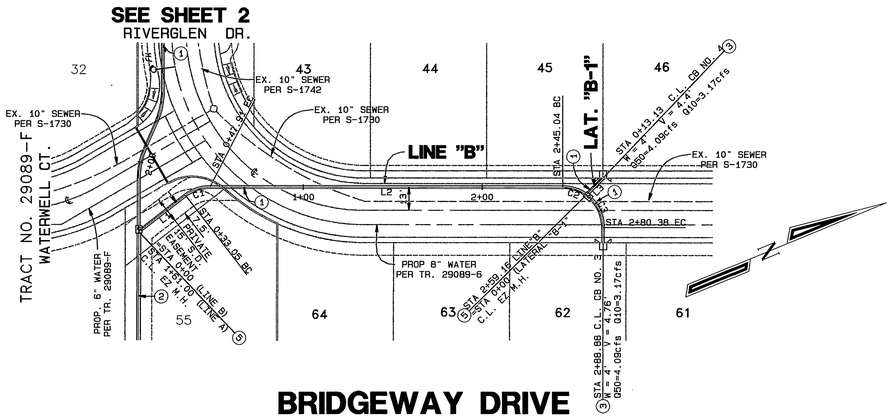

BRIDGEWAY DRIVE
LINE "B" AND LATERAL "B-1"

CONSTRUCTION NOTES

1. CONSTRUCT 18" RCP (D-2000)
2. CONSTRUCT 24" RCP (D-1500)
3. CONSTRUCT CATCH BASIN PER CITY OF RIVERSIDE STD. DWG. NO 405. W & V AS NOTED
4. CONSTRUCT JUNCTION STRUCTURE NO. 6 PER DETAIL ON SHEET #1
5. CONSTRUCT MANHOLE "EZ" PER CITY OF RIVERSIDE STD. DWG. NO. 431
6. CONSTRUCT CONCRETE COLLAR PER CITY OF RIVERSIDE STD. DWG. NO. 424
7. CONSTRUCT TIMBER BULKHEAD PER CITY OF RIVERSIDE STD. DWG. NO. 456

CURVE DATA

CURVE	DELTA	RADIUS	LENGTH	TANGENT
C1	37°50'14"	22.50'	14.86'	7.71'
C2	35°57'34"	22.50'	14.12'	7.30'
C3	54°02'26"	22.50'	21.22'	11.47'

LINE DATA

LINE	BEARING	DISTANCE
L1	N15°29'41"W	33.05
L2	N22°20'33"E	197.13
L3	N22°39'27"W	13.13

GRAPHIC SCALE 1"=40'
0 40 80 120
* AS-BUILT PER PLANS 9-30-05 GH

UNDERGROUND SERVICE ALERT
CALL: TOLL FREE 1·800 227·2600
TWO WORKING DAYS BEFORE YOU DIG

BENCH MARK:

CITY OF RIVERSIDE BENCH MARK NO E2-H3
P.K. NAIL AND TAG IN THE CENTER OF THE MOST NORTHERLY CURB RETURN OF COLLETT AVENUE AND GOLDEN AVENUE

ELEVATION: 697.978

REGISTERED PROFESSIONAL ENGINEER MOHAMMAD FAGHIH NO. C39530 EXP. 12-31-01 CIVIL STATE OF CALIFORNIA

CITY BUSINESS TAX CERTIFICATE NO. 005751 EXP. 12-31-01

ALBERT A. WEBB ASSOCIATES
CIVIL ENGINEERS
3788 McCRAY STREET RIVERSIDE, CA 92506
(909) 686-1070

APPROVED BY [signature] DATE 12/8/00
R.C.E. NO. C39530

W.O. 99-0206 FOR: GRIFFIN INDUSTRIES F.B. 1997

MARK	REVISIONS	APPR.	DATE

DESIGNED BY: [ ] CHECKED BY: [ ] CHECKED BY [ ]

CITY OF RIVERSIDE, CALIFORNIA
PUBLIC WORKS DEPARTMENT

APPROVED BY	BY	DATE
PRINCIPAL ENGINEER		
PARK DEPARTMENT		
TRAFFIC DEPARTMENT		
STREET SERVICES		
DEP. P.W. DIRECTOR		

APPROVED BY [signature]
DIRECTOR OF PUBLIC WORKS
DATE 1-31-2001

STORM DRAIN PLAN & PROFILE

TRACT NO. 29089-6
LINE "B" AND LATERAL "B-1"
PRIVATE STORM DRAIN

SCALE: HORIZ. = 1"=40' VERT.= 1"=4'

ACCOUNT NO. 990206
DRAWING NUMBER **D-687**
SHEET 3 OF 5
99-0206

INDEXED 2-08-2001 GH

D:\GISDATA\29089\6\29089-6_B&B1.dgn

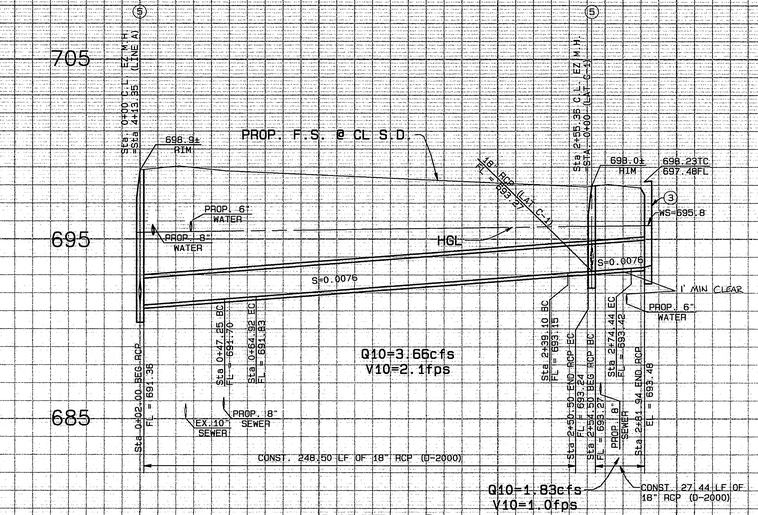

LINE "C"
PRIVATE STORM DRAIN

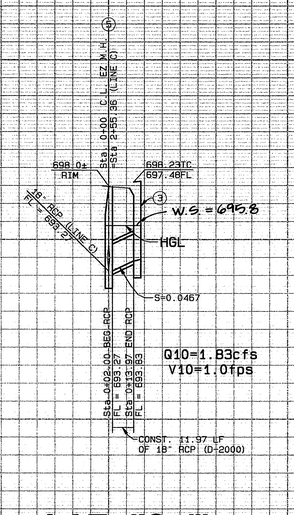

LAT. "C-1"
PRIVATE STORM DRAIN

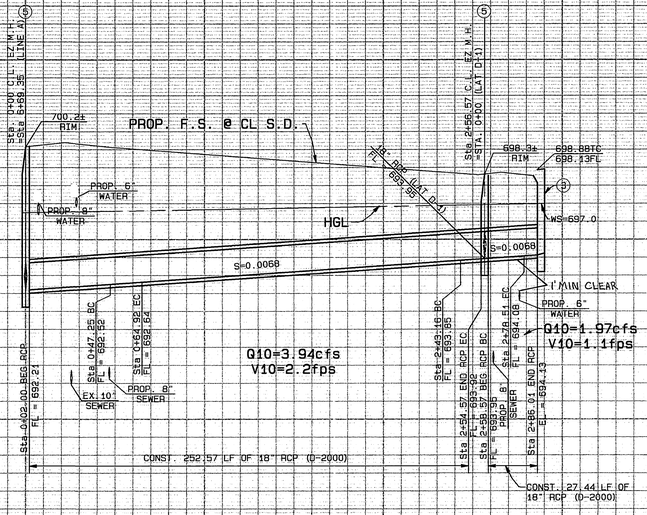

LINE "D"
PRIVATE STORM DRAIN

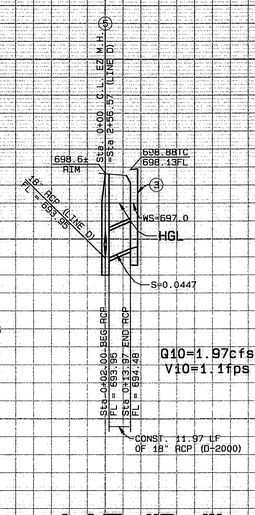

LAT. "D-1"
PRIVATE STORM DRAIN

SCALE
HORIZ. : 1" = 40'
VERT. : 1" = 4'

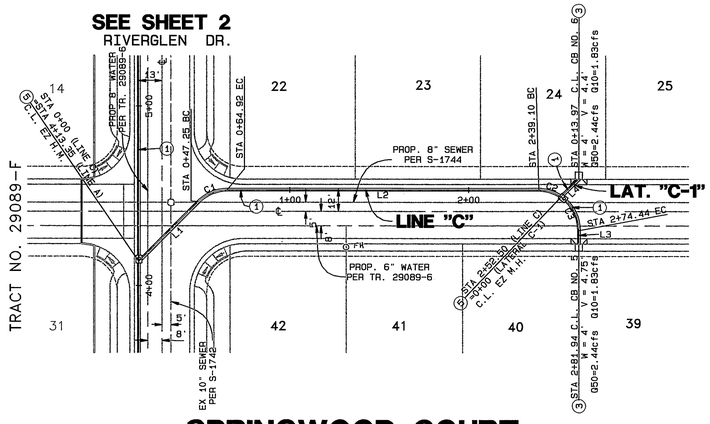

SPRINGWOOD COURT
LINE "C" AND LATERAL "C-1"

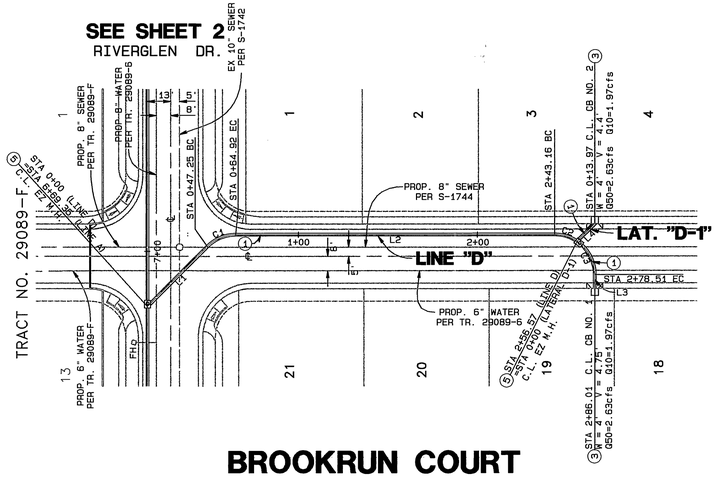

BROOKRUN COURT
LINE "D" AND LATERAL "D-1"

CONSTRUCTION NOTES

1. CONSTRUCT 18" RCP (D-2000)
2. CONSTRUCT 24" RCP (D-1500)
3. CONSTRUCT CATCH BASIN PER CITY OF RIVERSIDE STD. DWG. NO 405, W & V AS NOTED
4. CONSTRUCT JUNCTION STRUCTURE NO. 6 PER DETAIL ON SHEET #1
5. CONSTRUCT MANHOLE "EZ" PER CITY OF RIVERSIDE STD. DWG. NO. 431
6. CONSTRUCT CONCRETE COLLAR PER CITY OF RIVERSIDE STD. DWG. NO.424
7. CONSTRUCT TIMBER BULKHEAD PER CITY OF RIVERSIDE STD. DWG. NO. 456

CURVE DATA

CURVE	DELTA	RADIUS	LENGTH	TANGENT
C1	44°59'58"	22.50'	17.67'	9.32'
C2	34°07'52"	22.50'	13.40'	6.91'
C3	55°52'08"	22.50'	21.94'	11.93'

LINE DATA

LINE	BEARING	DISTANCE
L1	N22°39'25"W	47.25'
L2	N22°20'33"E	174.18'
L3	N67°39'27"W	7.50'
L4	N22°39'27"W	13.97'

CURVE DATA

LINE	DELTA	RADIUS	LENGTH	TANGENT
C1	44°59'58"	22.50'	17.67'	9.32'
C2	34°07'52"	22.50'	13.40'	6.91'
C3	55°52'08"	22.50'	21.94'	11.93'

LINE DATA

LINE	BEARING	DISTANCE
L1	N22°39'25"W	47.25'
L2	N22°20'33"E	178.24'
L3	N67°39'27"W	7.50'
L4	N22°39'27"W	13.97'

GRAPHIC SCALE 1"=40'
0 40 80 120

*AS-BUILT PER PLANS 9-30-05 GH

G:\1999\99-0206\990206SD.pro

UNDERGROUND SERVICE ALERT
CALL: TOLL FREE
1·800
227·2600
TWO WORKING DAYS BEFORE YOU DIG

BENCH MARK:
CITY OF RIVERSIDE BENCH MARK NO E2-H3
P.K. NAIL AND TAG IN THE CENTER OF THE MOST NORTHERLY CURB RETURN OF COLLETT AVENUE AND GOLDEN AVENUE

ELEVATION: 697.978

REGISTERED PROFESSIONAL ENGINEER
MOHAMMAD FAGHIH
NO. C39530
EXP. 12-31-01
CIVIL
STATE OF CALIFORNIA

CITY BUSINESS TAX CERTIFICATE NO. 005751 EXP. 12-31-01

ALBERT A. WEBB ASSOCIATES
CIVIL ENGINEERS
3788 McCRAY STREET RIVERSIDE, CA 92506
(909) 686-1070

APPROVED BY [signature] DATE 12/18/00
R.C.E. NO. C39530

W.O. 99-0206 FOR: GRIFFIN INDUSTRIES F.B. 1997

MARK	REVISIONS	APPR.	DATE

DESIGNED BY: [ ] CHECKED BY: [ ] CHECKED BY [ ]

CITY OF RIVERSIDE, CALIFORNIA
PUBLIC WORKS DEPARTMENT

APPROVED BY	BY	DATE
PRINCIPAL ENGINEER		
PARK DEPARTMENT		
TRAFFIC DEPARTMENT		
STREET SERVICES		
DEP. P.W. DIRECTOR		

APPROVED BY [signature]
DIRECTOR OF PUBLIC WORKS
DATE 1-31-2001

STORM DRAIN PLAN & PROFILE

TRACT NO. 29089-6
LINE "C" AND LATERAL "C-1"
LINE "D" AND LATERAL "D-1"
PRIVATE STORM DRAINS

SCALE: HORIZ. = 1"=40' VERT. = 1"=4'

ACCOUNT NO. 990206

DRAWING NUMBER
D-687

SHEET 4 OF 5

99-0206

INDEXED 2-08-2001 GH

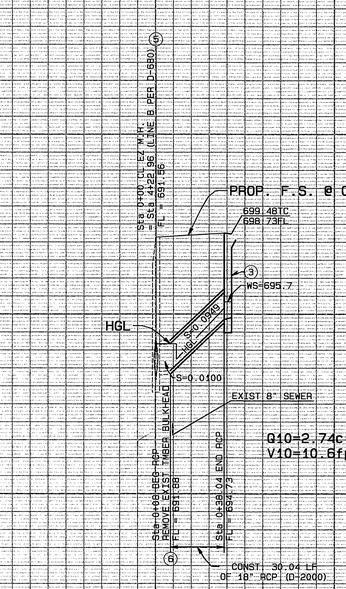

LATERAL "B-2"
PRIVATE STORM DRAIN

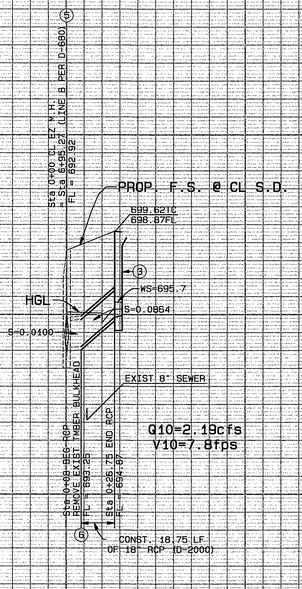

LATERAL "B-4"
PRIVATE STORM DRAIN

SCALE
HORIZ. : 1" = 40'
VERT. : 1" = 4'

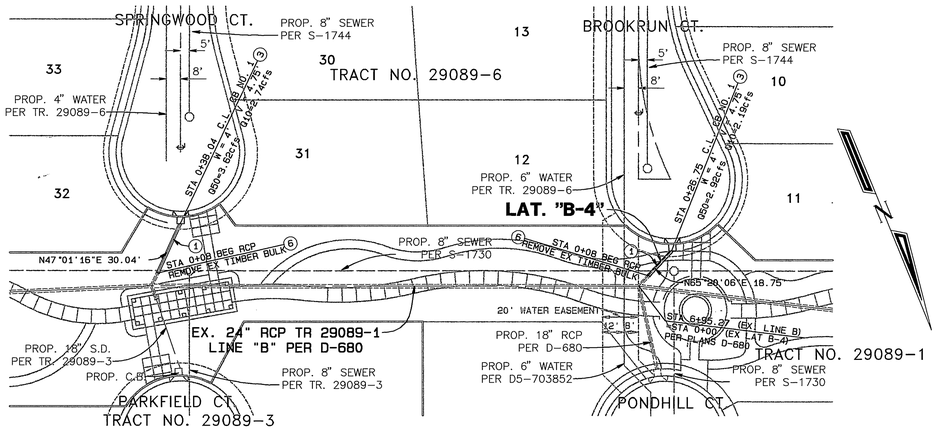

LATERAL "B-2" AND LATERAL "B-4"

CONSTRUCTION NOTES

1. CONSTRUCT 18" RCP (D-2000)
2. CONSTRUCT 24" RCP (D-1500)
3. CONSTRUCT CATCH BASIN PER CITY OF RIVERSIDE STD. DWG. NO 405, W & V AS NOTED
4. CONSTRUCT JUNCTION STRUCTURE NO. 6 PER DETAIL ON SHEET #1
5. CONSTRUCT MANHOLE "EZ" PER CITY OF RIVERSIDE STD. DWG. NO. 431
6. CONSTRUCT CONCRETE COLLAR PER CITY OF RIVERSIDE STD. DWG. NO.424
7. CONSTRUCT TIMBER BULKHEAD PER CITY OF RIVERSIDE STD. DWG. NO. 456

GRAPHIC SCALE 1"=40'
0 40 80 120

*AS-BUILT PER PLANS 9-30-05 LH

UNDERGROUND SERVICE ALERT
CALL: TOLL FREE
1-800
227-2600
TWO WORKING DAYS BEFORE YOU DIG

BENCH MARK:
CITY OF RIVERSIDE BENCH MARK NO E2-H3
P.K. NAIL AND TAG IN THE CENTER OF THE MOST NORTHERLY CURB RETURN OF COLLETT AVENUE AND GOLDEN AVENUE

ELEVATION: 697.978

REGISTERED PROFESSIONAL ENGINEER
MOHAMMAD FAGHIH
NO. C39530
EXP. 12-31-01
CIVIL
STATE OF CALIFORNIA

CITY BUSINESS TAX CERTIFICATE NO. 005751 EXP. 12-31-00

ALBERT A. WEBB ASSOCIATES
CIVIL ENGINEERS
3788 McCRAY STREET RIVERSIDE, CA 92506
(909) 686-1070

APPROVED BY [signature] DATE 12/8/00
R.C.E. NO. C39530

W.O. 99-0206 FOR: GRIFFIN INDUSTRIES F.B. 1997

MARK	REVISIONS	APPR.	DATE

DESIGNED BY: [ ] CHECKED BY: [ ] CHECKED BY [ ]

CITY OF RIVERSIDE, CALIFORNIA
PUBLIC WORKS DEPARTMENT

APPROVED BY	BY	DATE
PRINCIPAL ENGINEER		11/14/01
PARK DEPARTMENT		
TRAFFIC DEPARTMENT		
STREET SERVICES		12/11/01
DEP. P.W. DIRECTOR		11/26/01

APPROVED BY
R. McGrath
DIRECTOR OF PUBLIC WORKS
DATE 1-31-2001

STORM DRAIN PLAN & PROFILE

TRACT NO. 29089-6
LATERAL "B-2" AND LATERAL "B-4"
PRIVATE STORM DRAIN

SCALE: HORIZ. = 1"=40' VERT.= 1"=4'

ACCOUNT NO. 990206
DRAWING NUMBER
D-687
SHEET 5 OF 5
99-0206

INDEXED 2-08-2001 LH

G:\99\9902061\9902-691\99691.dgn