PLATE 1 - PLAN - PROFILE - O. P. R. & R. E. STANDARD
KEUFFEL & ESSER CO., NEW YORK.
K & E CO., No. 347-IR ALBANENE 198L MADE IN U.S.A. 34529

PROFILE
SURVEYED
PLOTTED
GRADES CHECKED
B. M.'S NOTED
STRUCTURE NO.ATIONS CHKD.
NOTE BOOK
NO.
BY
DATE

930
925
920
915
910
905
900

CONST BRICK AND MORTAR ELBOW AT END OF STUB
7.5% GRADE
CONST STEEL MANHOLE "A" RADIAL COVER TYPE 2
EXISTING GROUND & STORM DRAIN
PROPOSED TOP OF CURB ELEVATION
SEWER FLOW LINES EAST MANHOLE INLET 1534 AT PROP LINE 1534 AT STORM DRAIN 1537
6" SEWER
42" WATER
1.00%
CONST. 33"ø R.C.P. (1500-D) STA. 2+34.67 TO 7+60.78
EXIST 6" SEWER
EXIST 42" WATER
EXIST 20" WATER
EXIST 12" GAS
EXIST 8" SEWER
EXIST 12" WATER

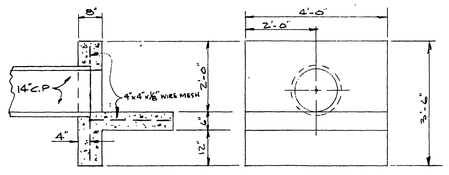

① CUT-OFF WALL
SCALE ½"=1'-0"

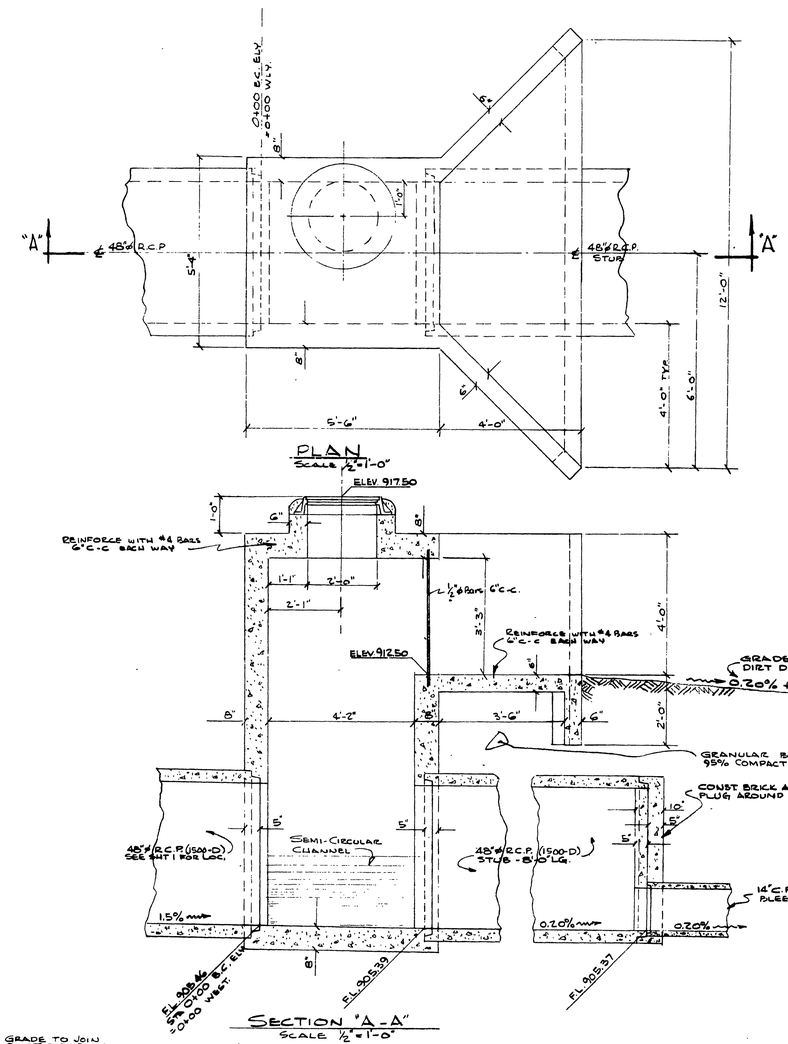

SPECIAL MANHOLE "A"

NOTE: DESIGN AND CONSTRUCTION OF THIS SPECIAL MANHOLE IS TO BE BASED ON CITY OF RIVERSIDE STD. DWG. No. 420, MANHOLE AX, WITH ONLY VARIATION BEING THE ADDITION OF THE UPPER OUTLET AND WING WALLS.

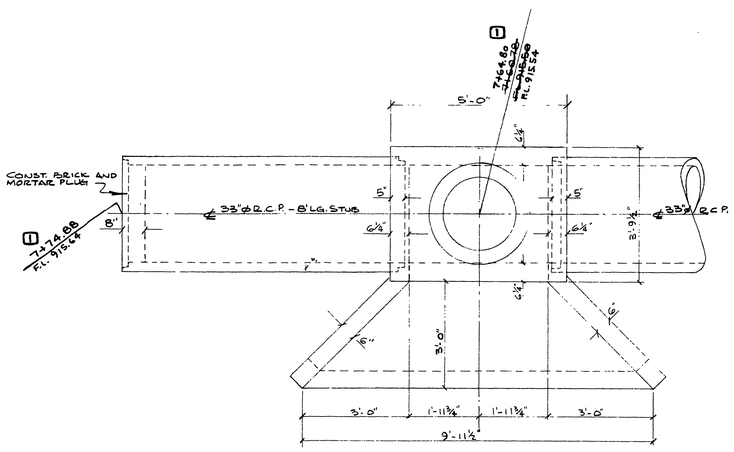

PLAN
Scale ½"=1'-0"

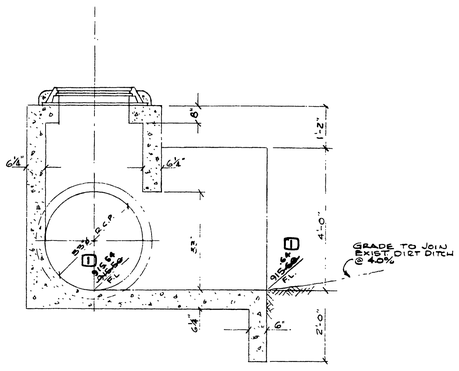

SECTION "A-A"
Scale ½"=1'-0"

SPECIAL MANHOLE "B"

NOTE: DESIGN AND CONSTRUCTION OF THIS SPECIAL MANHOLE IS TO BE BASED ON CITY OF RIVERSIDE STD. DWG. NO 420, MANHOLE AX, WITH ONLY VARIATION BEING ADDITION OF WING WALLS.

ALBERT A. WEBB ASSOCIATES
CIVIL ENGINEERS · RIVERSIDE, CALIFORNIA
APPROVED [signature] DATE 9-1-61
R.E. 9876

REVISION		
MARK	DATE	DESCRIPTION
①	11/12/61	Revised as shown at Mark ① W.O. 12/13/61
①	12/27/61	Added Cut-off Wall - Galt

CITY OF RIVERSIDE, CALIFORNIA
DEPARTMENT OF PUBLIC WORKS

COLUMBIA AVE. STORM DRAIN
DETAIL SHEET

DATE MAR 1961	SCALE As Noted	APPROVED BY [signature] DIRECTOR OF PUBLIC WORKS	NO. D-71
DRAWN dwr	W.O. 61-31		
CHECKED [signature]	F.B. 338 - 42B	DATE 9-18-61	SHEET 2 OF 2

DWG 61-31D
2 each