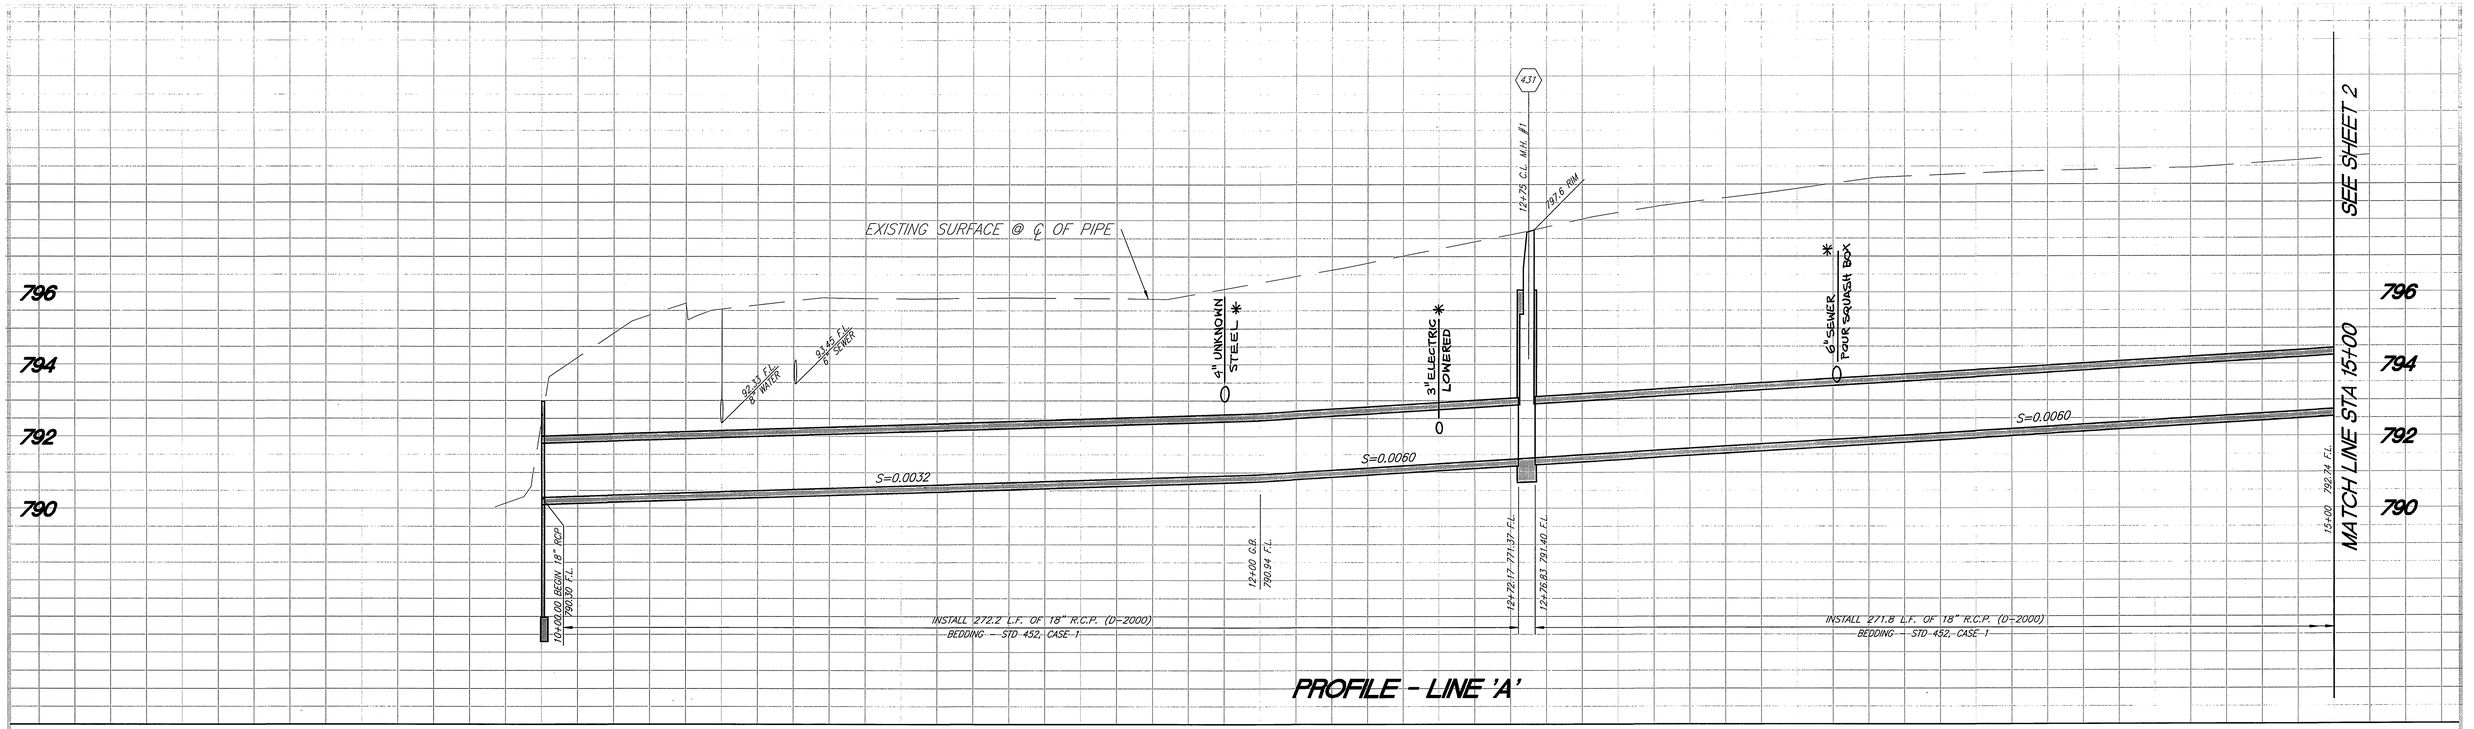

PROFILE - LINE 'A'

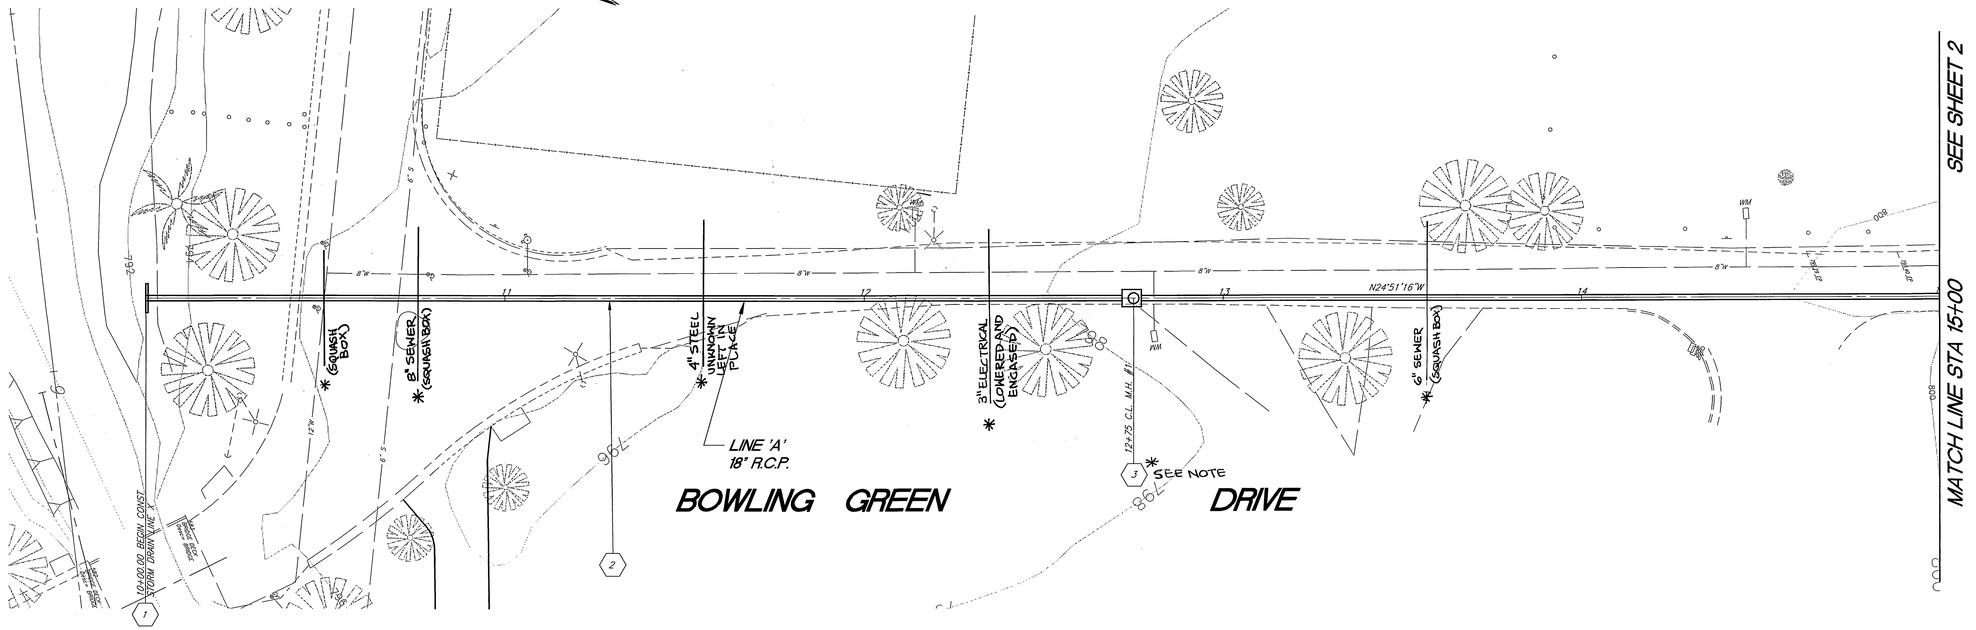

SPECIFIC CONSTRUCTION NOTES

1. CONSTRUCT SINGLE HEADWALL PER CALTRANS STD DWG. D89 FOOTING TO BE DEEPENED TO 4' FROM FLOWLINE OF OUTLET
2. CONSTRUCT 18" R.C.P., D-2000
3. CONSTRUCT MANHOLE PER STD. DWG. ~~430~~ * 431.
4. CONSTRUCT CATCH BASIN PER STD. DWG. 406.
5. CONSTRUCT CATCH BASIN PER STD. DWG. 405.

BENCHMARK: 17-S3

P.K. NAIL AND CITY ENGINEER TAG IN THE BACK OF A CATCH BASIN ALONG THE WESTERLY CURB OF ORANGE ST AT THE SOUTHWEST CORNER OF ORANGE ST AND THIRD ST.

ELEVATION: 852.637

ENGINEER IN RESPONSIBLE CHARGE

PHILIP L. HANNAWI
R.C.E. No. 44747 expires 3/31/06
DATE 3/21/03

REGISTERED PROFESSIONAL ENGINEER PHILIP L. HANNAWI No. 44747 Exp. 3-31-2006 CIVIL STATE OF CALIFORNIA

MARK	REVISIONS	APPR.	DATE

DESIGNED BY KARL DRAWN BY CURT CHECKED BY

CITY OF RIVERSIDE, CALIFORNIA
PUBLIC WORKS DEPARTMENT

APPROVED BY	BY	DATE
PRINCIPAL ENGINEER		
STREET SERVICES		
SURVEYOR		
PARKS DEPARTMENT		

APPROVED BY Tim Byrd
CITY ENGINEER
DATE 3/24/03

MARKET STREET IMPROVEMENTS

BOWLING GREEN STORM DRAIN

FROM REDWOOD DR ELY TO SPRINGBROOK CHANNEL

ACCT. NO.: 9217200601-440446xx

D-723

SHEET 1 OF 2

HORIZ. SCALE: 1" = 20' VERT. SCALE: 1" = 2'

* AS-BUILT 11-08-05 FH

INDEXED 8-05-04 FH

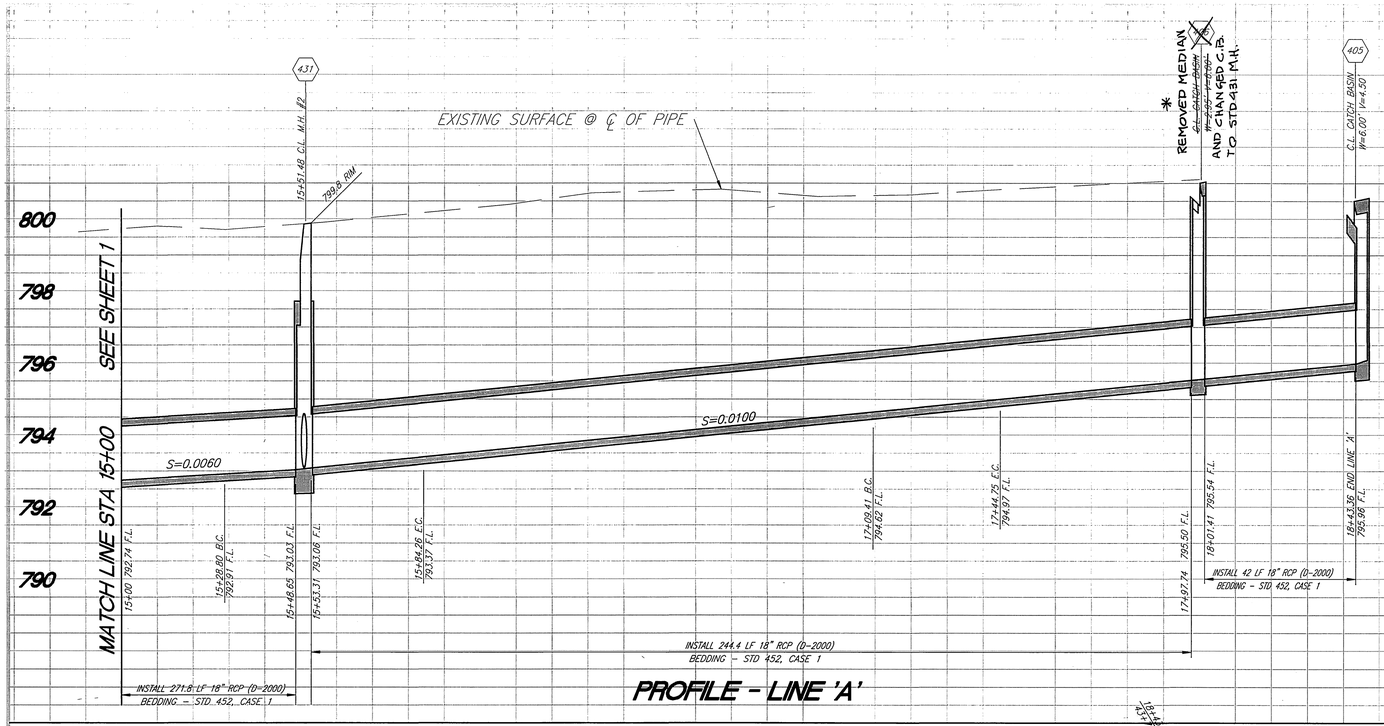

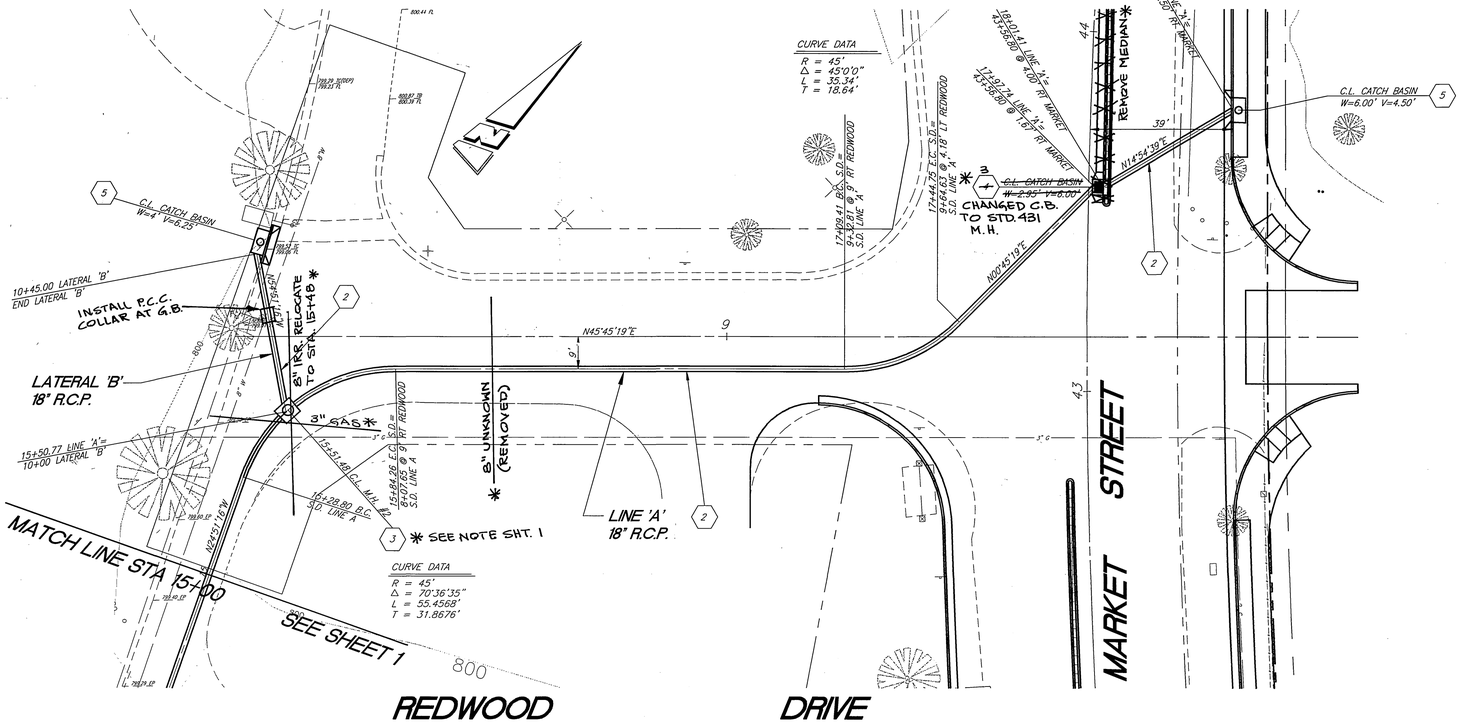

SPECIFIC CONSTRUCTION NOTES

1. CONSTRUCT SINGLE HEADWALL PER CALTRANS STD DWG. D89 FOOTING TO BE DEEPENED TO 4' FROM FLOWLINE OF OUTLET
2. CONSTRUCT 18" R.C.P., D-2000

BENCHMARK: 17-S3
P.K. NAIL AND CITY ENGINEER TAG IN THE BACK OF A CATCH BASIN ALONG THE WESTERLY CURB OF ORANGE ST AT THE SOUTHWEST CORNER OF ORANGE ST AND THIRD St.

ELEVATION: 852.637

ENGINEER IN RESPONSIBLE CHARGE
PHILIP L. HANNAWI
R.C.E. No. 44747 expires 3/31/06
DATE 3/21/03

REGISTERED PROFESSIONAL ENGINEER
PHILIP L. HANNAWI
No. 44747
Exp. 3-31-2006
CIVIL
STATE OF CALIFORNIA

MARK	REVISIONS	APPR.	DATE

DESIGNED BY KARL DRAWN BY CURT CHECKED BY

CITY OF RIVERSIDE, CALIFORNIA
PUBLIC WORKS DEPARTMENT

APPROVED BY	BY	DATE
PRINCIPAL ENGINEER		
STREET SERVICES		
SURVEYOR		

APPROVED BY
CITY ENGINEER
DATE 3/21/03

MARKET STREET IMPROVEMENTS
BOWLING GREEN STORM DRAIN
FROM REDWOOD DR EL / TO SPRINGBROOK CHANNEL

HORIZ. SCALE: 1" = 20' VERT. SCALE: 1" = 2'

ACCT. NO.: 9217200601-44046xx

D-723

SHEET 2 OF 2

* AS-BUILT 11-08-05 GH

INDEXED 8-05-09 GH