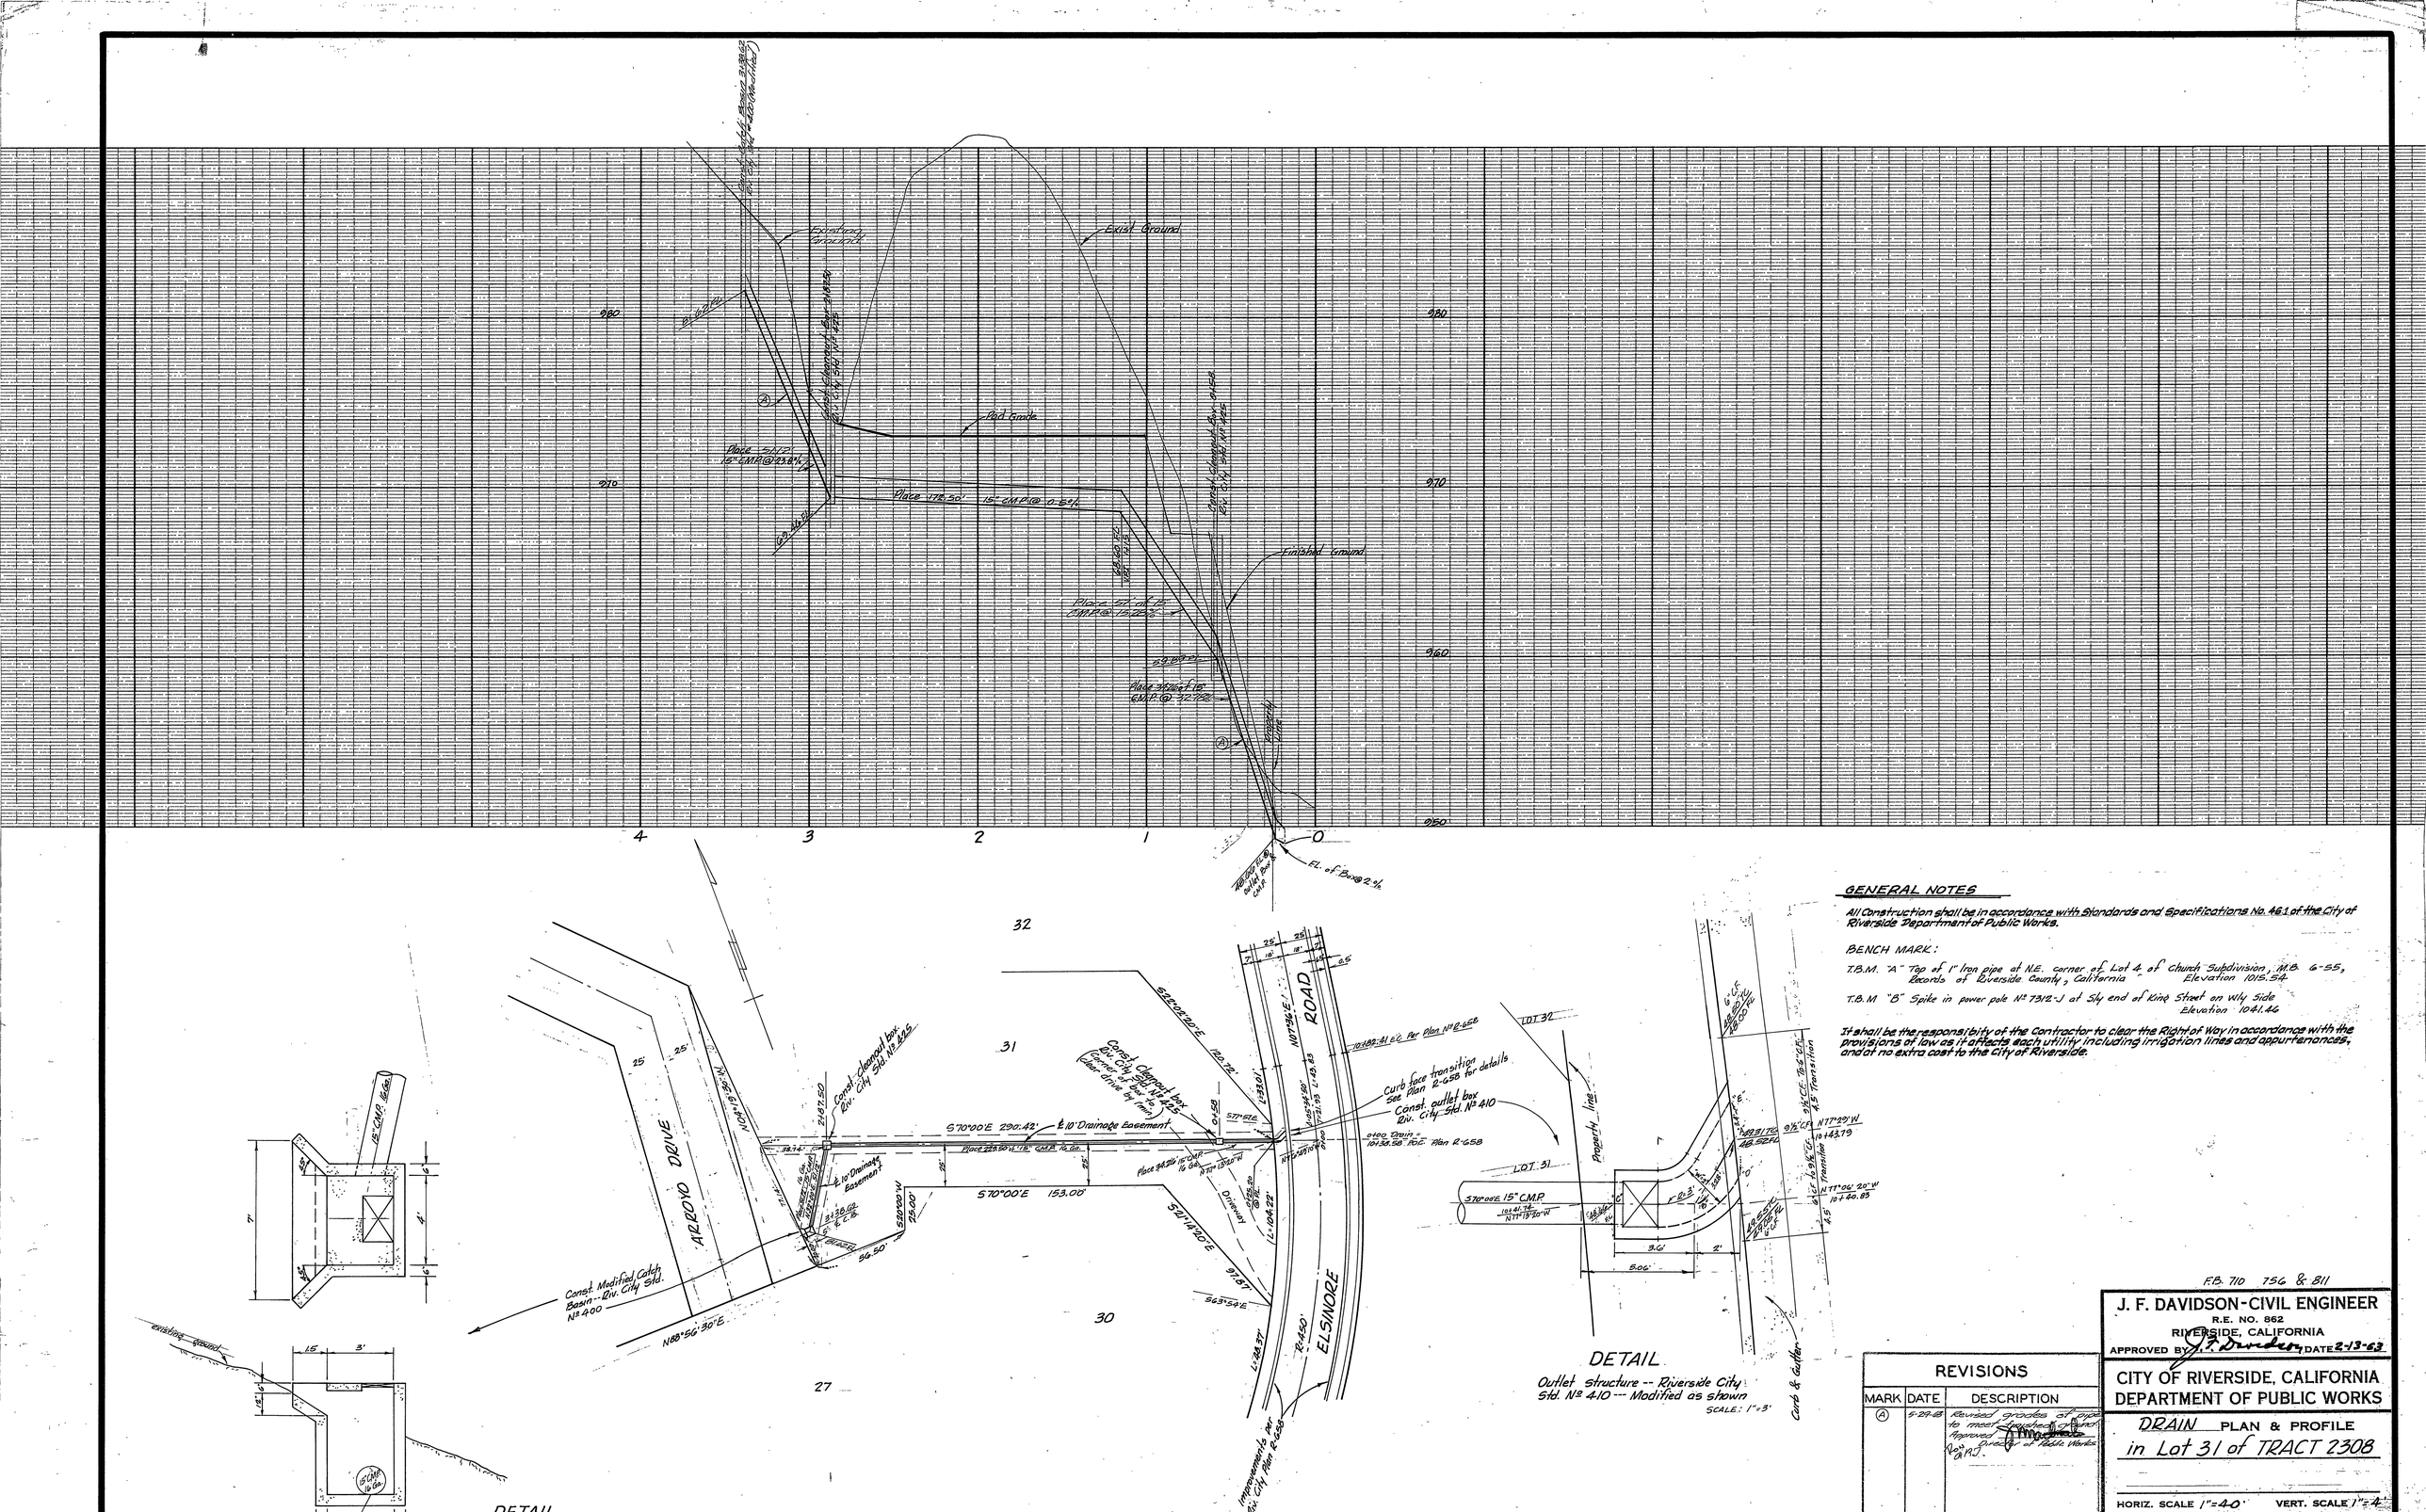

GENERAL NOTES

All Construction shall be in accordance with Standards and Specifications No. 461 of the City of Riverside Department of Public Works.

BENCH MARK:

T.B.M. "A" Top of 1" Iron pipe at N.E. corner of Lot 4 of Church Subdivision, M.B. 6-55, Records of Riverside County, California — Elevation 1015.54

T.B.M "B" Spike in power pole No 73/2-J at Sly end of King Street on Wly Side — Elevation 1041.46

It shall be the responsibility of the Contractor to clear the Right of Way in accordance with the provisions of law as it affects each utility including irrigation lines and appurtenances, and at no extra cost to the City of Riverside.

F.B. 710 756 & 811

J. F. DAVIDSON-CIVIL ENGINEER
R.E. NO. 862
RIVERSIDE, CALIFORNIA
APPROVED BY J. F. Davidson DATE 2-13-63

CITY OF RIVERSIDE, CALIFORNIA
DEPARTMENT OF PUBLIC WORKS

DRAIN PLAN & PROFILE
in Lot 31 of TRACT 2308

HORIZ. SCALE 1"=40' VERT. SCALE 1"=4'

REVISIONS		
MARK	DATE	DESCRIPTION
(A)	5-29-68	Revised grades of pipe to meet Engineer Approval Director of Public Works by D.R.J.

DESIGNED BY
DRAWN BY
CHECKED BY
RECOMMENDED BY A.R. Thrash ASSISTANT CITY ENGINEER

APPROVED BY
Director of Public Works
DATE 3-25-63

NO. D-92
SHEET 1 OF 1

2179