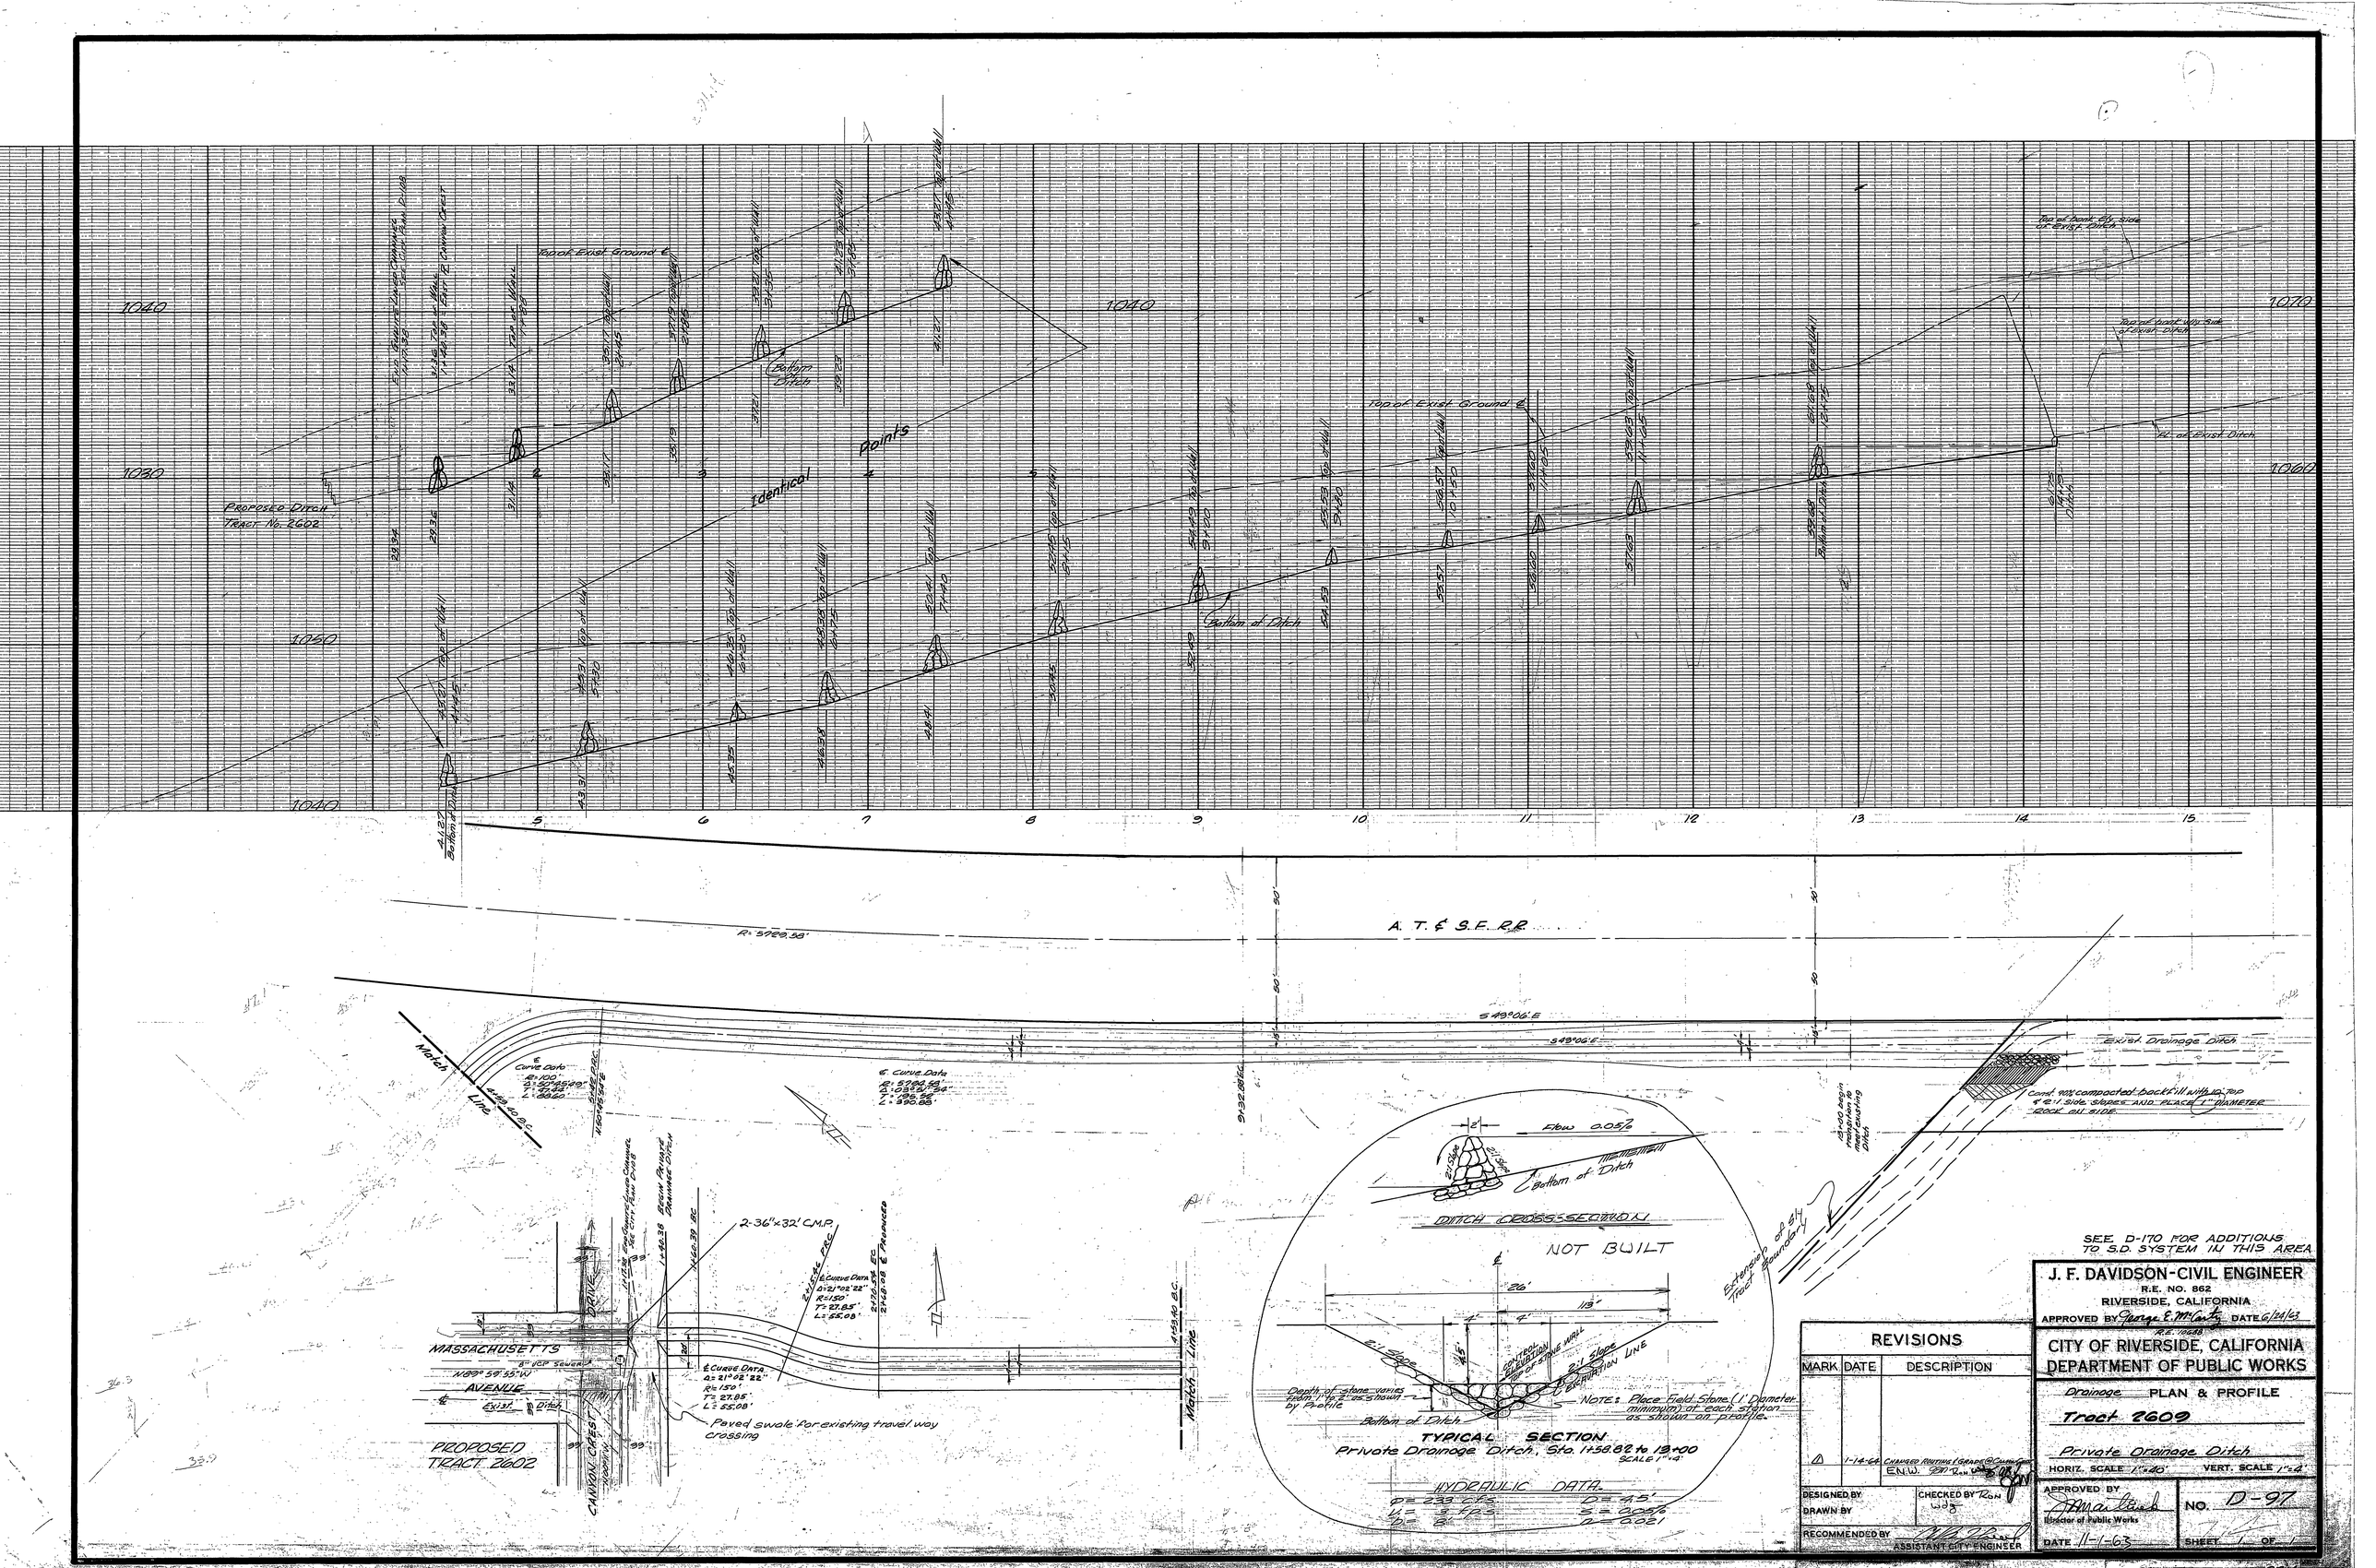

REVISIONS		
MARK	DATE	DESCRIPTION
△	1-14-64	CHANGED ROUTING & GRADE @ CANYON CREST DR. E.N.W. RON

J. F. DAVIDSON - CIVIL ENGINEER
R.E. NO. 862
RIVERSIDE, CALIFORNIA
APPROVED BY George E. McCarty DATE 6/24/63
R.E. 10648

CITY OF RIVERSIDE, CALIFORNIA
DEPARTMENT OF PUBLIC WORKS

Drainage PLAN & PROFILE
Tract 2609
Private Drainage Ditch
HORIZ. SCALE 1"=40' VERT. SCALE 1"=4'

DESIGNED BY
DRAWN BY
CHECKED BY RON
RECOMMENDED BY
ASSISTANT CITY ENGINEER

APPROVED BY
Director of Public Works
DATE 11-1-63

NO. D-97
SHEET 1 OF 1