
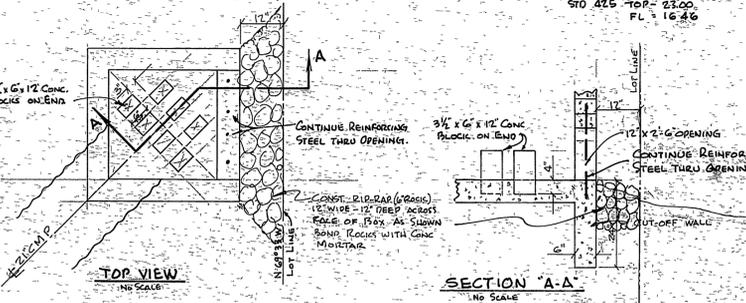


SCALE
HORIZ. 1" = 50'
VERT. 1" = 5'

BENCH MARK
R R SPIKE IN PALM @ S.W. CORNER
CORNWALL AVE AND HOWE AVE
ELEV. 1053.74

PROFILE	
DATE	BY
APPROVED	CHECKED
DATE	BY
NOTE BOOK	BY
NO.	DATE

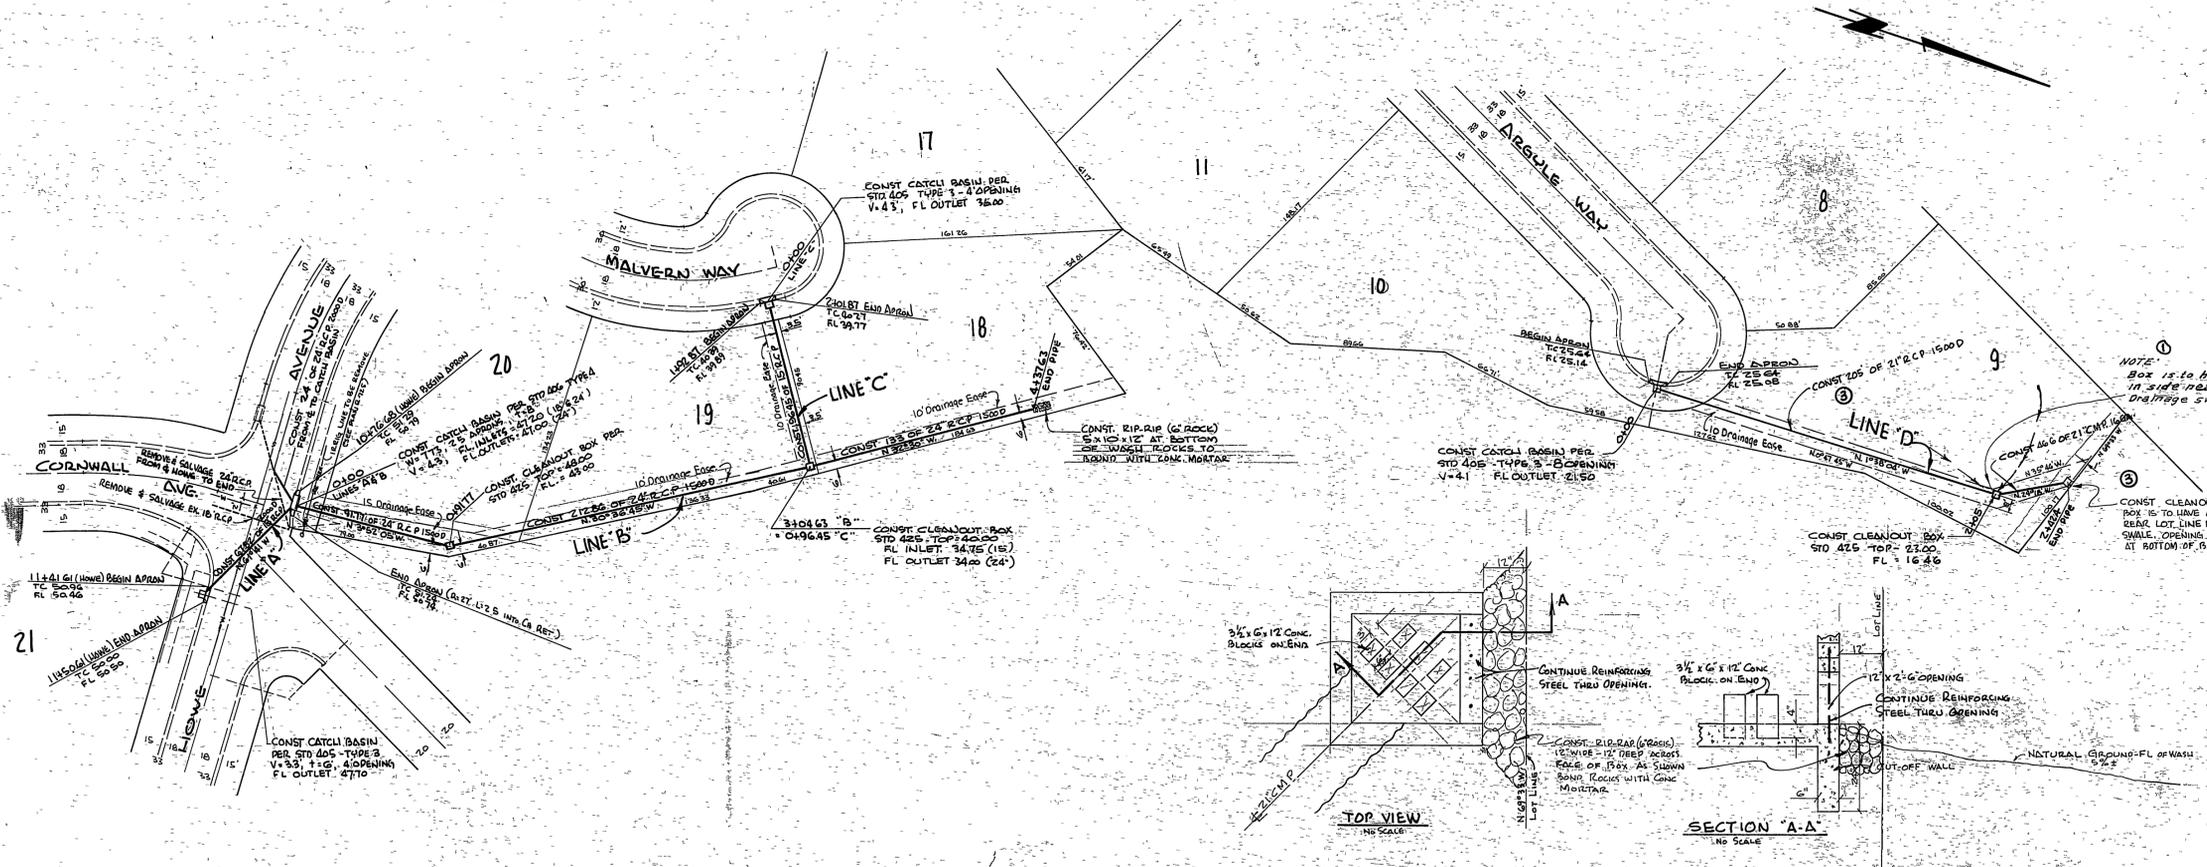

NOTE:
Box 15 to have 8"x16" opening
in side near top. Pick up
Drainage swales from Lot 9

REVISION	
MARK	DESCRIPTION
①	10/1/63 Added Note re opening in Box at way off
②	10/2/63 Lowered 21" R.C.P. to provide more cover over pipe at Box 15
③	11/1/63 Relocated 21" pipes in plan & profile and added box 15

ALBERT A. WEBB ASSOCIATES
CIVIL ENGINEERS - RIVERSIDE, CALIFORNIA
APPROVED *Edward Webb* DATE 7/1/63
R. 9876

CITY OF RIVERSIDE, CALIFORNIA
DEPARTMENT OF PUBLIC WORKS

STORM DRAIN
PLAN AND PROFILE
FOR
TRACT NO 2623

DATE APRIL 1963 SCALE 1" = 50'
DRAWN J.W. NO. 63-32
CHECKED J.W. F.B. 433

APPROVED BY *J. W. Webb* NO. D-99
DIRECTOR OF PUBLIC WORKS
DATE 8-2-63 SHEET 1 OF 1

PLAN	
DATE	BY
APPROVED	CHECKED
DATE	BY
NOTE BOOK	BY
NO.	DATE