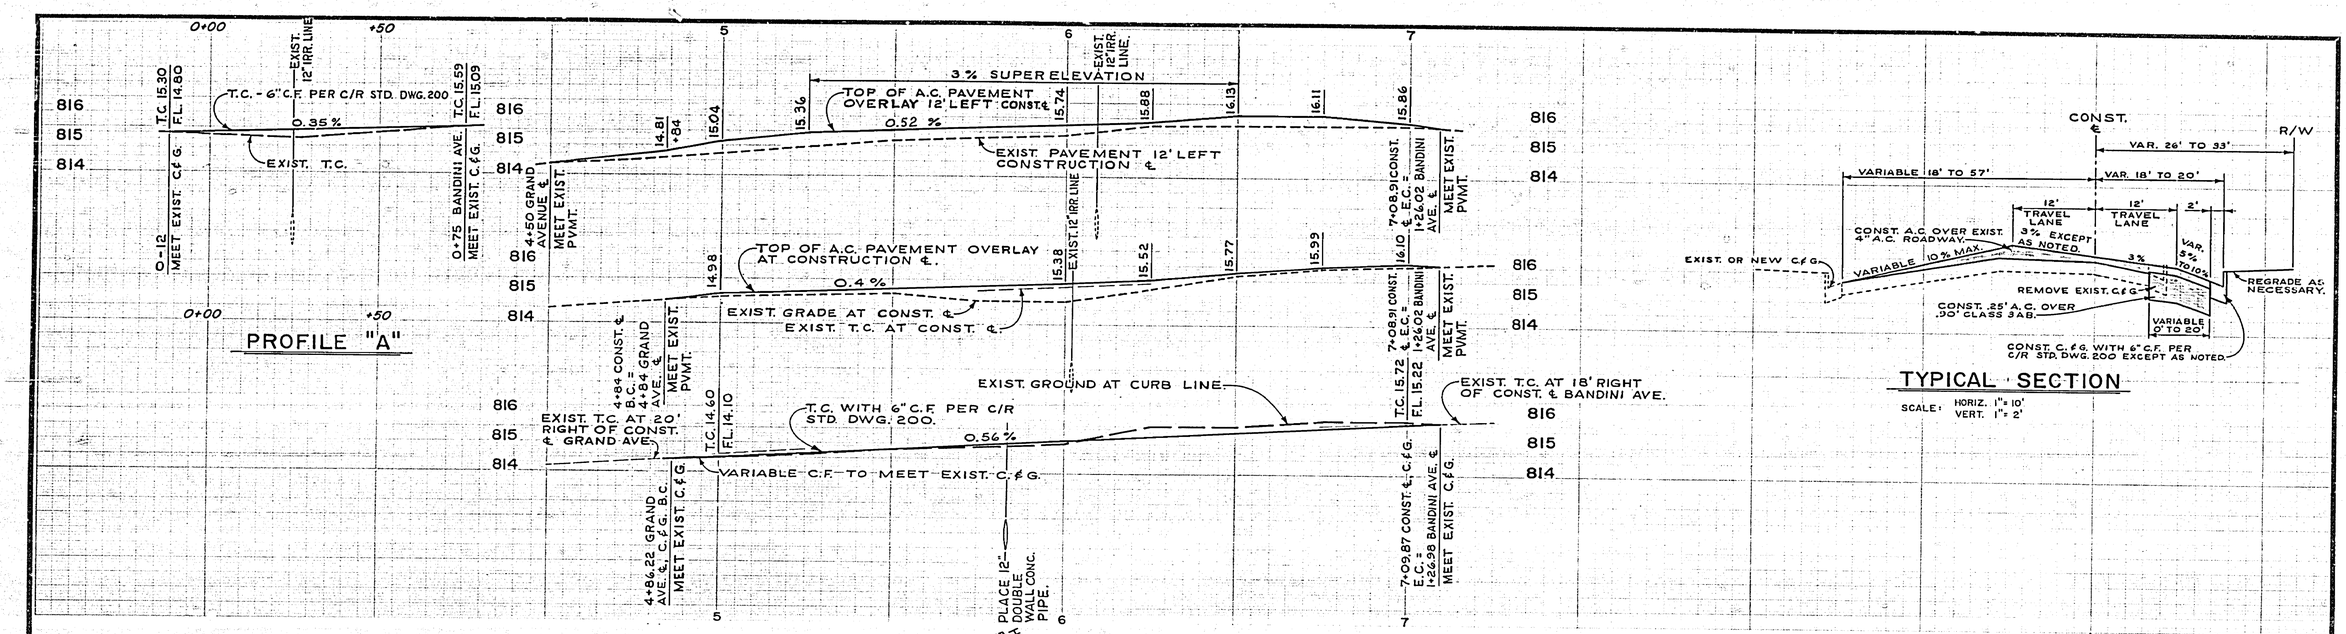

F.B. 712 /16-22, 55-58, L-1 / 44-46,

B.M. ELEV. 815.20 PK NAIL IN W. C.B. RETURN OF GRAND AVE & BRIGHTON DRIVE.

CURVE DATA

CONSTRUCTION ℄
R = 200'
Δ = 64°25'55"
T = 126.02'
L = 224.91'

CURB RETURN
R = 180'
Δ = 64°25'55"
T = 113.42'
L = 202.42'

LEGEND

- A.C. OVERLAY
- 0.25' A.C. OVER 0.90' CL. 3 A.B.
- (1) REMOVE TREE
- (2) REMOVE EXIST. C.&G.

NOTE

R = 19
T.I. = 6

MARK	REVISIONS	APPR.	DATE
*	AS BUILT	DWH	2-13-68

DESIGNED BY BTG DRAWN BY MHB CHECKED BY DCH

CITY OF RIVERSIDE, CALIFORNIA
DEPARTMENT OF PUBLIC WORKS

APPROVED BY	BY	DATE
OFFICE ENGINEER	GWC	12/27
PARK DEPARTMENT		
TRAFFIC DIVISION	CCE	12/27
ASSISTANT CITY ENG.	WB	12-22

APPROVED IN
DIRECTOR OF PUBLIC WORKS
DATE 12-22-66

INTERSECTION GRAND AVE. AT BANDINI AVE.

PLAN, PROFILES, SECTION

HORIZ. SCALE: 1" - 20' VERT. SCALE: 1" - 2'

PROJECT NO. 3090

R-1094

SHEET 1 OF 1

S.S. PROJECT NO. 271