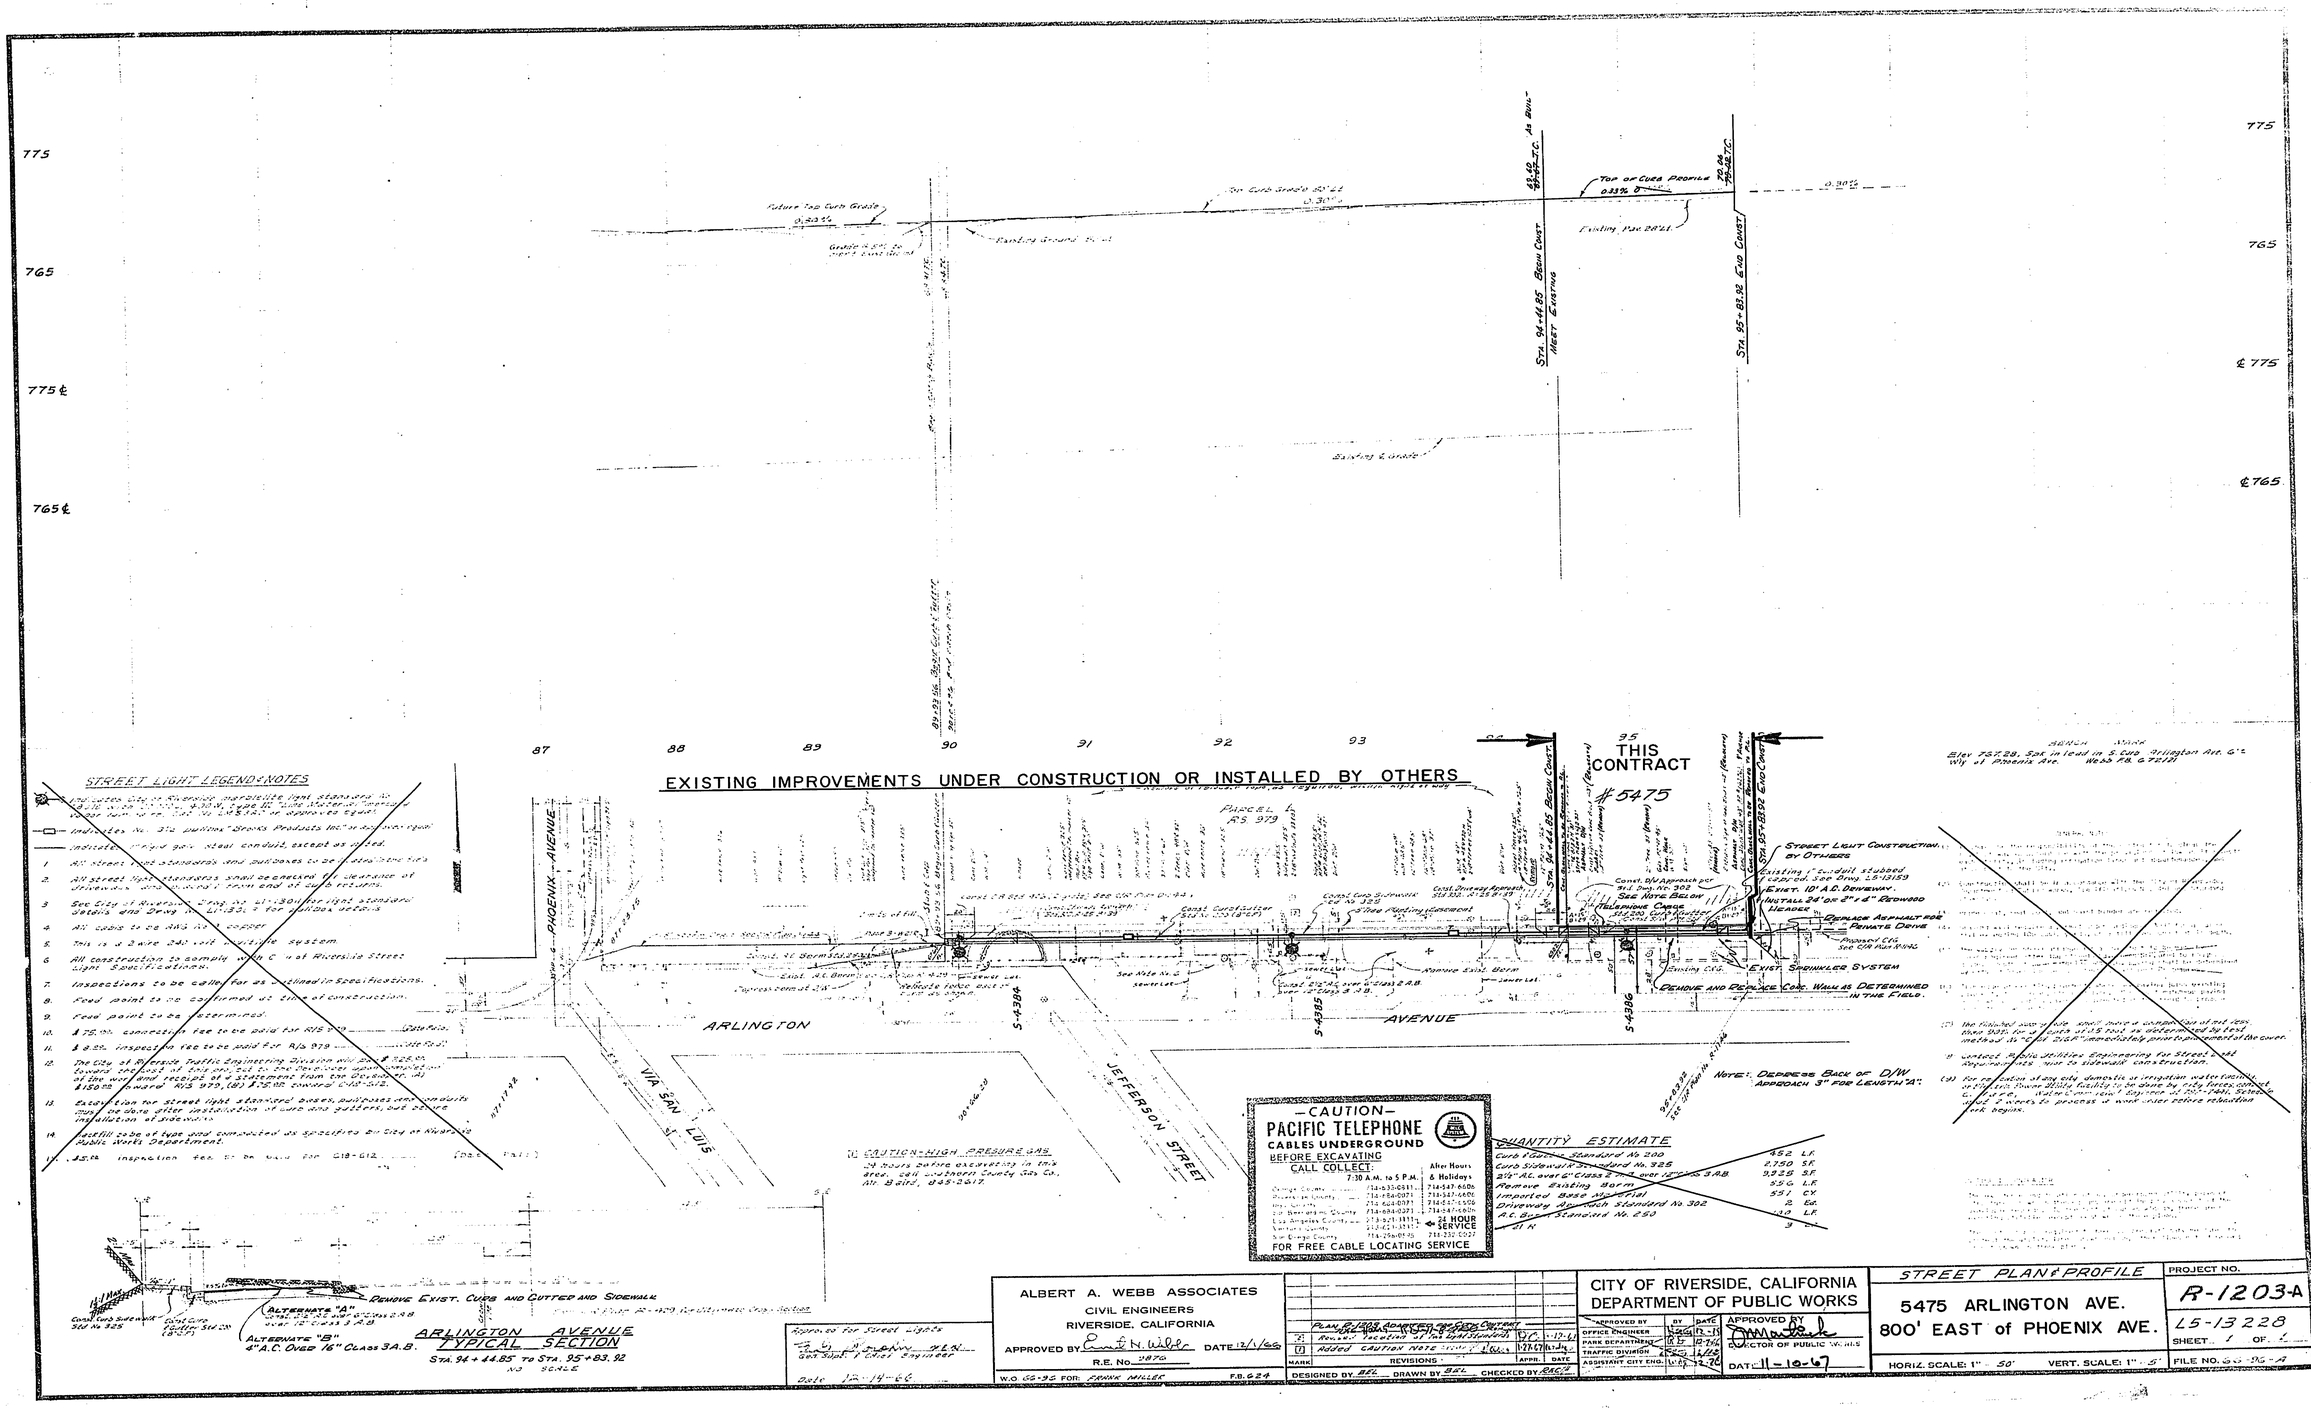
775
765
775℄
765℄
Future Top Curb Grade
0.33%
Top Curb Grade 50'±L
0.30%
Existing Ground
Top of Curb Profile
0.33%
Existing P.V.C. 28'±L
0.30%
Sta. 94+44.85 Begin Const
Sta. 95+83.92 End Const
Existing ℄ Grade
℄ 775
℄ 765
87
88
89
90
91
92
93
94
95
THIS CONTRACT
#5475
EXISTING IMPROVEMENTS UNDER CONSTRUCTION OR INSTALLED BY OTHERS
STREET LIGHT LEGEND & NOTES
PHOENIX AVENUE
ARLINGTON
AVENUE
VIA SAN LUIS
JEFFERSON STREET
PARCEL AS 979
S-4396
S-4385
S-4386
Street Light Construction By Others
Exist. 101 A.C. Driveway
Install 24" or 2"+2" Redwood Header
Replace Asphalt For Private Drive
Exist. Sprinkler System
Dehone and Replace Conc. Walk As Determined In The Field.
Note: Depress Back of D/W Approach 3" For Length 24'.
Bench Mark
Elev 757.28, Spk in lead in S. Curb Arlington Ave. 6'± W'ly of Phoenix Ave.
Webb Rb. G-72-28
CAUTION-HIGH PRESSURE GAS
24 hours before excavating in this area, call Southern California Gas Co. Mr. Baird, 685-2617.
-CAUTION-
PACIFIC TELEPHONE
CABLES UNDERGROUND
BEFORE EXCAVATING
CALL COLLECT:
7:30 A.M. to 5 P.M. | After Hours & Holidays
Orange County (714) 533-0511 | 714-547-6606
Riverside County (714) 684-0071 | 714-547-6606
San Bernardino County (714) 684-0071 | 714-547-6606
Los Angeles County (213) 621-1111 | 714-547-6606
Ventura County (213) 621-1111 | 714-547-6606
San Diego County (714) 296-0181 | 714-547-6606
24 HOUR SERVICE
213-232-0037
FOR FREE CABLE LOCATING SERVICE
QUANTITY ESTIMATE
Curb & Gutter Standard No. 200 — 462 L.F.
Curb Sidewalk Standard No. 325 — 2,750 S.F.
2½" A.C. over 6" Class 2 A.B. over 12" Class 3 A.B. — 9,325 S.F.
Remove Existing Berm — 85.6 L.F.
Imported Base Material — 351 C.Y.
Driveway Approach Standard No. 302 — 2 Ea.
A.C. Berm Standard No. 250 — 40 L.F.
Alternate "A"
Alternate "B"
4" A.C. over 16" Class 3 A.B.
Remove Exist. Curb and Cutted and Sidewalk
ARLINGTON AVENUE TYPICAL SECTION
Sta. 94+44.85 to Sta. 95+83.92
NO SCALE
Approved for Street Work
Date 12-14-66
ALBERT A. WEBB ASSOCIATES
CIVIL ENGINEERS
RIVERSIDE, CALIFORNIA
APPROVED BY
DATE 12/1/66
R.E. No. 1870
W.O. 66-95 FOR: FRANK HALLER
F.B. 624
MARK
REVISIONS
DATE
APPR.
DESIGNED BY BEL
DRAWN BY BEL
CHECKED BY BEL
CITY OF RIVERSIDE, CALIFORNIA
DEPARTMENT OF PUBLIC WORKS
APPROVED BY
OFFICE ENGINEER
PARK DEPARTMENT
TRAFFIC DIVISION
ASSISTANT CITY ENG.
DIRECTOR OF PUBLIC WORKS
DATE 11-10-67
STREET PLAN & PROFILE
5475 ARLINGTON AVE.
800' EAST of PHOENIX AVE.
HORIZ. SCALE: 1" = 50'
VERT. SCALE: 1" = 5'
PROJECT NO.
R-1203-A
L5-13228
SHEET 1 OF 1
FILE NO.