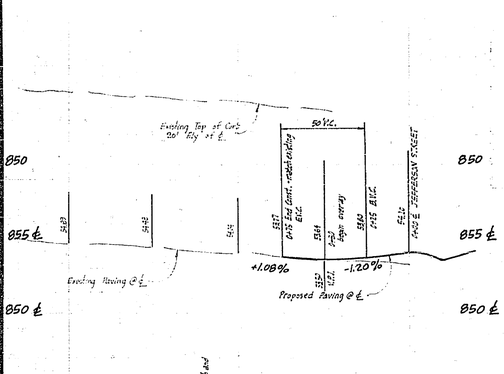

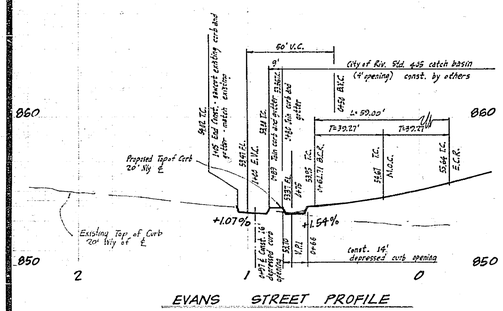

—CAUTION—
PACIFIC TELEPHONE
CABLES UNDERGROUND
BEFORE EXCAVATING
CALL COLLECT:

	7:30 A.M. to 5 P.M.	After Hours & Holidays
Orange County	714-633-CALL	714-547-6606
Riverside County	714-684-0071	714-547-6606
Inyo County	714-684-0071	714-547-6606
San Bernardino County	714-684-0071	714-547-6606
Los Angeles County	213-621-3111	24 HOUR SERVICE
Ventura County	213-621-3111	
San Diego County	714-298-0595	714-232-0027

FOR FREE CABLE LOCATING SERVICE

General Notes:

1. It shall be the responsibility of the contractor to clear the right of way in accordance with the provisions of law as it affects each utility including irrigation lines and appurtenances and at no cost to the City.
2. Construction shall be in accordance with the City of Riverside Dept. of Public Works Specifications No. 461 and Standard Drgs.
3. Prime Coat, Seal Coat and Paint Binder are required.
4. Grading will require a permit under ordinance 3093 for a cut or fill exceeding 100 cu yds. or a fill over one foot in depth.
5. The City shall arrange for a soil test of the subgrade level by a soils engineer. Thickness of pavement and thickness and type of aggregate base shall be determined by the soils engineer and submitted to the City of Riverside for approval prior to construction.
6. Trim edge of existing paving, where new paving join existing paving, to a clean straight line. Construct match-up paving as shown and overlay paving as directed in the field to produce a smooth crown section. Overlay 15' back approximately.
7. For relocation of any City domestic or irrigation water facility, or Electric Power Utility to be done by City forces, contact Charles Hares, Water Commercial Engr. at 787-7442. Schedule about 2 weeks to process a work order, before relocation work begins.

Bench Mark:

City B.M.: Pk nail in Northeast curb return of EVANS STREET and JEFFERSON STREET. City F.B. 1/146
ELEVATION 853.21 FEET

NOTE: PRIOR TO CURB, THE CONTRACTOR SHALL NOTIFY THE ENGINEER IN ORDER THAT HE MIGHT RELOCATE THE BENCH MARK.

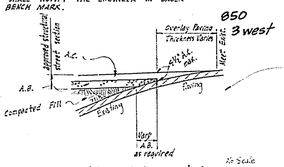

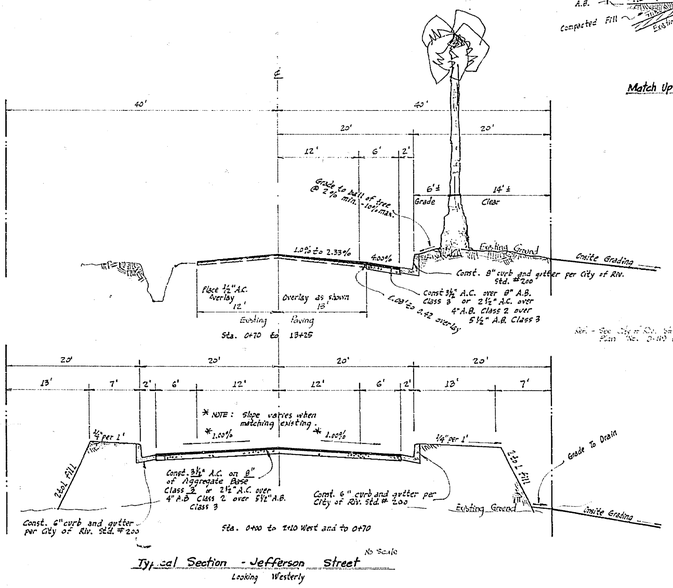

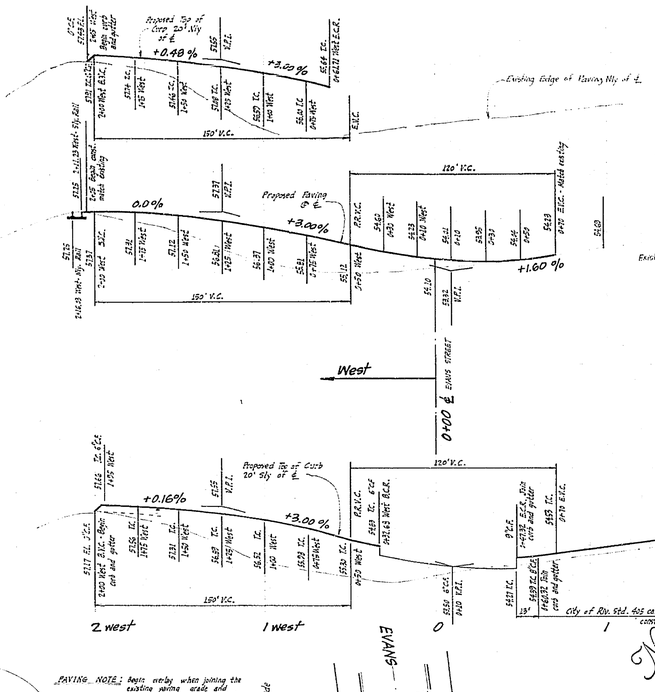

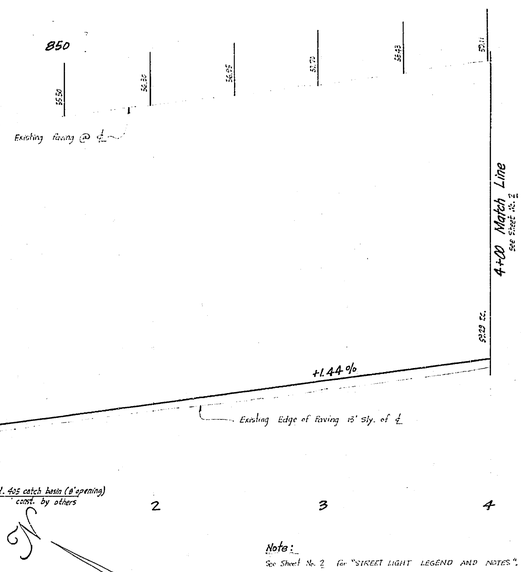

Note:
See Sheet No. 2 for "STREET LIGHT LEGEND AND NOTES".

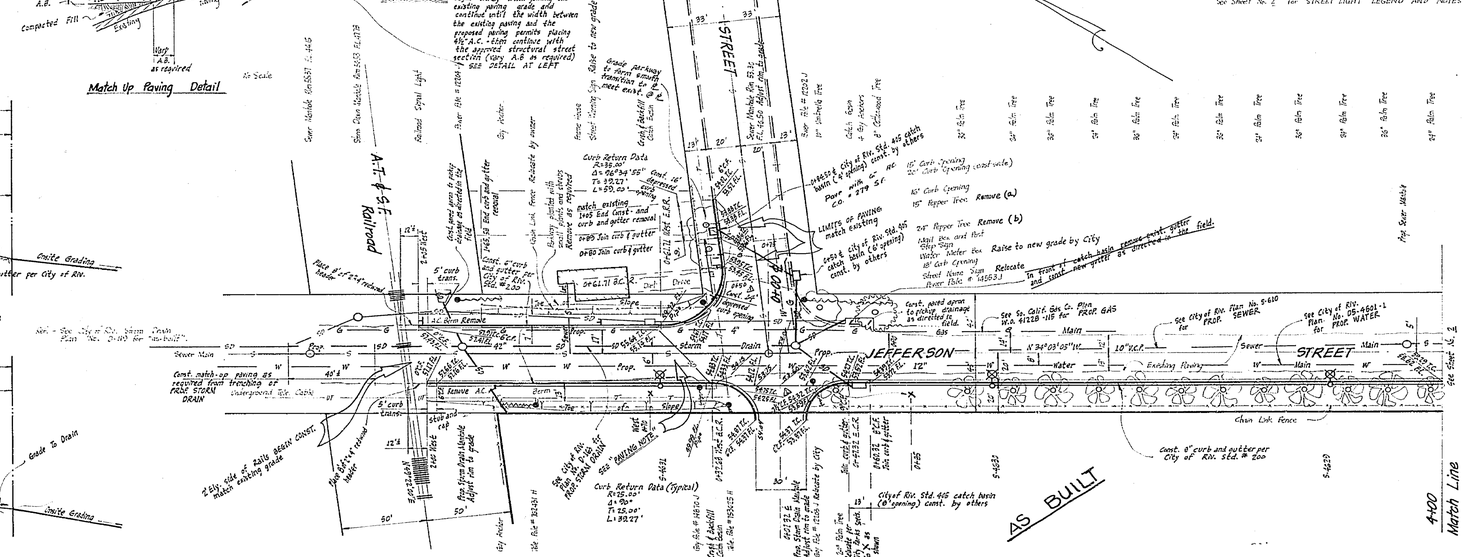

Approved for Street Lights
By: [signature] 1-2-68
General Supt. & Chief Engr. Date

J. F. DAVIDSON ASSOCIATES
Civil Engineers · Surveyors · Planners
Riverside, California
Approved By: George E. McEuen Date: 3-22-68
R.C.E. No. 10688
W.O. 1851 FOR: City of Riverside F.B. 864/34-67

MARK	REVISIONS	APPR.	DATE
1	corrected width of drive wly of Sta 0+80 Evans to N corrected N.O.C. elev. at intersection of Evans	Jack	6-12-68

DESIGNED BY Jack DRAWN BY Jack CHECKED BY [illegible]

CITY OF RIVERSIDE, CALIFORNIA
DEPARTMENT OF PUBLIC WORKS

	BY	DATE
APPROVED BY OFFICE ENGINEER	[illegible]	4-10
PARK DEPARTMENT	[illegible]	4-9
TRAFFIC DIVISION	[illegible]	4-9
ASSISTANT CITY ENG.	[illegible]	4-11
	[illegible]	4-10

APPROVED BY [signature] DIRECTOR OF PUBLIC WORKS
DATE 4-11-68

NP 2-678
Street Plan and Profile
JEFFERSON STREET ~ EVANS ST.
(From A.T. & S.F. Railroad R/W to Lincoln Street) (@ intersection of Jefferson Street)
HORIZ. SCALE: 1" - 40' VERT. SCALE: 1" - 4'

PROJECT NO. L5-13307
R-1260
SHEET 1 OF 2
FILE NO. 3351

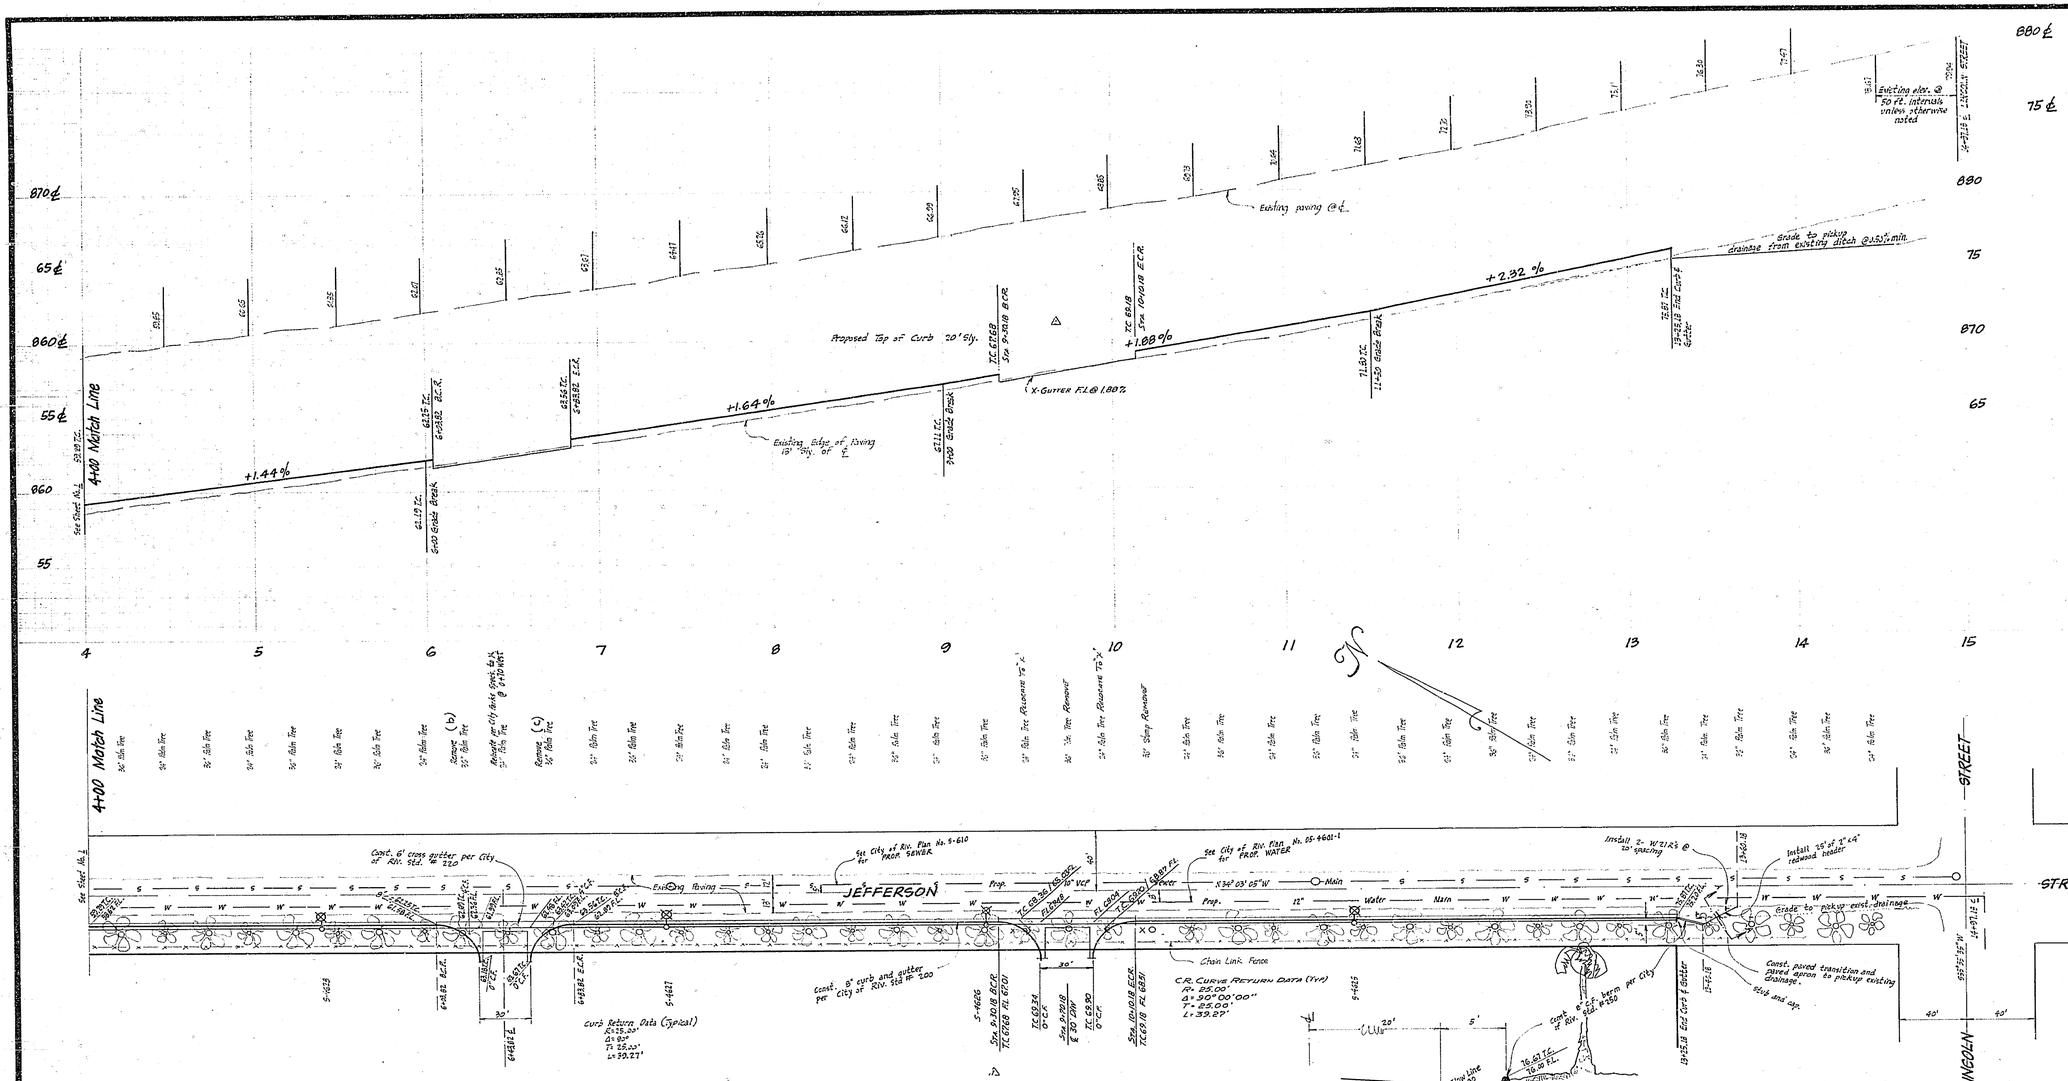

Street Light Legend :

- Indicates City of Riverside marbleite light standard No. 45D3 with "100OL, 175W, type II except as noted "Line Material" mercury vapor luminaire, Cat. No. LM 43A2 or appr. equal.
- Indicates No. 8½ pullbox "Brooks Products Inc." or "Quickset No. E-17" or approved equal.
- Indicates 1" rigid galv. steel conduit, except as noted.

Street Light Notes :

1. All street light standards and pullboxes to be field located by contractor, according to plans, and approved by utilities personnel.
2. All street light standards shall be checked for clearance of driveways, fire hydrants, and radius returns.
3. Excavation for street light standard bases, pullboxes, and conduits must be done after installation of curbs and gutters, but before installation of sidewalks.
4. Contractor shall obtain a street trenching permit from City of Riverside Public Works Dept. prior to any excavation in improved or undeveloped street right of way.
5. Backfill to be of type and compacted as specified by City of Riverside Public Works Dept. Specifications No. 401.
6. All construction to comply with the latest revision of the City of Riverside Public Utilities Dept. Street Light Specifications No. 119.
7. Inspections to be called for as outlined in Specifications No. 119.
8. This is a two wire 240 volt multiple system.
9. All cable to be as specified in Specifications No. 119.
10. Feed point to be determined at time of construction
11. Street patrol to be determined.
12. See City of Riverside Std. Dwg. No. L1-18038 for Light Standard Details, Dwg. No. L1-18608 for pullbox Details, and Dwg No. L1-18701 for Riser Details.

Approved for Street Lights
By: [signature] "General Supt. & Chief Engr."
4-8-68 Date

J. F. DAVIDSON ASSOCIATES
Civil Engineers · Surveyors · Planners
Riverside, California
Approved By: George E. McCall Date: 3-22-68
R.C.E. No. 10688
W.O. 1861 FOR: City of Riverside F.B. 860/34-67

MARK	REVISIONS	APPR.	DATE
1	Added New 12th Crossover @ [illegible]	[illegible]	10/1/69

DESIGNED BY Jack DRAWN BY Jack CHECKED BY [illegible]

CITY OF RIVERSIDE, CALIFORNIA
DEPARTMENT OF PUBLIC WORKS

	BY	DATE
APPROVED BY OFFICE ENGINEER	[illegible]	4-10
PARK DEPARTMENT	[illegible]	4-10
TRAFFIC DIVISION	[illegible]	4-10
ASSISTANT CITY ENG.	[illegible]	4-11
	[illegible]	4-11

APPROVED BY [signature]
DIRECTOR OF PUBLIC WORKS
DATE 4-11-68

NP 2 - 6TH

Street Plan and Profile
JEFFERSON STREET
(from A.T. & S.F. Railroad R/W to Lincoln Street)

HORIZ. SCALE: 1" = 40' VERT. SCALE: 1" = 4'

PROJECT NO. 15-13307
R-1260
SHEET 2 OF 2
FILE NO. 3351