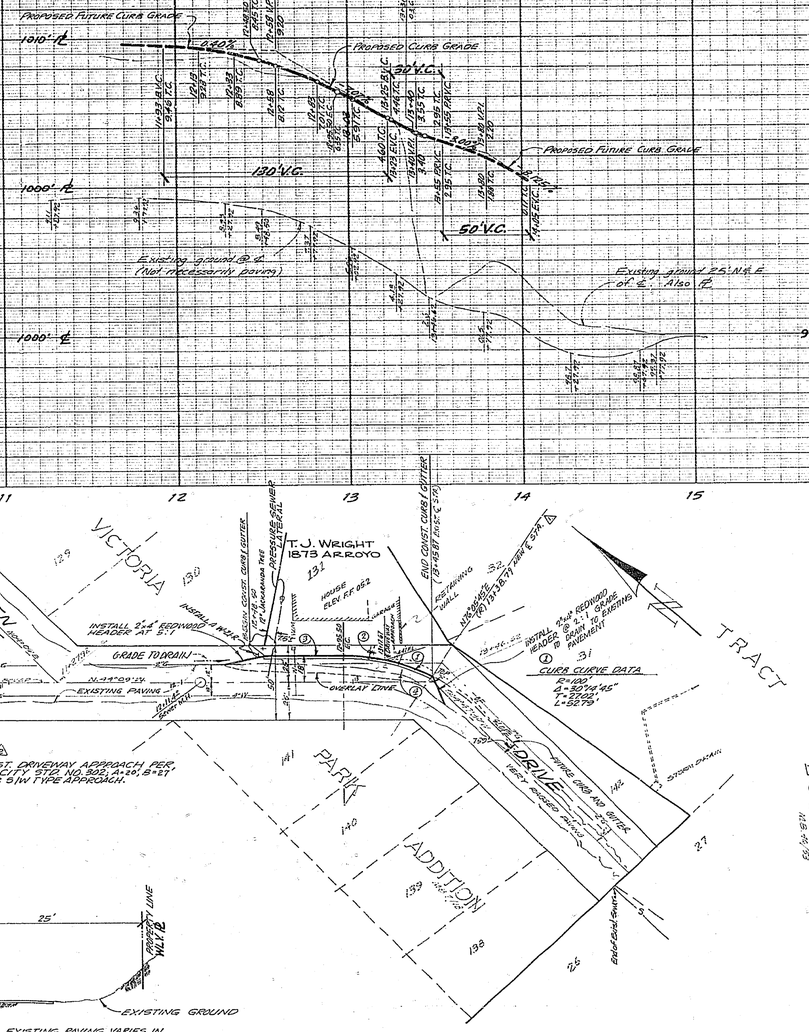

CROSS SECTION

SCALE HOR: 1"=10' VERT: 1"=5'
STA. 12+77

GENERAL NOTES

1. IT SHALL BE THE RESPONSIBILITY OF THE CONTRACTOR TO CLEAR THE RIGHT OF WAY IN ACCORDANCE WITH THE PROVISIONS OF LAW AS IT AFFECTS EACH UTILITY INCLUDING IRRIGATION LINES AND APPERTENANCES AND AT NO COST TO THE CITY.
2. CONSTRUCTION SHALL BE IN ACCORDANCE WITH THE CITY OF RIVERSIDE, DEPARTMENT OF PUBLIC WORKS, SPECIFICATIONS NO. 461 AND STANDARD DRAWINGS.
3. PRIME COAT, SEAL COAT, AND PAINT BINDER ARE REQUIRED.
4. GRADING WILL REQUIRE A PERMIT UNDER ORDINANCE 3093 FOR A CUT OR FILL EXCEEDING 100 CUBIC YARDS OR A FILL OVER ONE FOOT IN DEPTH.
5. THE DEVELOPER SHALL ARRANGE FOR A SOIL TEST AT THE SUBGRADE LEVEL BY A SOILS ENGINEER. THICKNESS OF PAVEMENT AND THICKNESS AND TYPE OF AGGREGATE BASE SHALL BE DETERMINED BY THE SOILS ENGINEER AND SUBMITTED TO THE CITY OF RIVERSIDE FOR APPROVAL PRIOR TO CONSTRUCTION.
6. TRIMEDGE OF EXISTING PAVING WHERE NEW PAVING JOINS EXISTING PAVEMENT TO A CLEAN STRAIGHT LINE. CONSTRUCT MATCH-UP PAVING AS SHOWN AND AND OVERLAY PAVING AS DIRECTED IN THE FIELD TO PRODUCE A SMOOTH CROWN SECTION.
7. THE AMOUNT OF ASPHALT OVERLAY ON EXISTING PAVEMENT HAS BEEN ESTIMATED BY THE ENGINEER TO BE APPROXIMATELY 6 TONS.

BENCH MARKS

CITY B.M. - "X" TOP FIRE HYDRANT SOUTH SIDE ARROYO DRIVE 200'± WESTERLY OF KING STREET. F.B. 951-37
ELEVATION 1006.42

T.B.M. - NORTHWEST RIM SEWER MANHOLE STA. 12+14.4± ℄ ARROYO DRIVE
ELEVATION 1009.14

2308

J.F. DAVIDSON ASSOCIATES
CIVIL ENGINEERS - SURVEYORS - PLANNERS
RIVERSIDE, CALIFORNIA
APPROVED BY Robert S. Kipp DATE 10-4-67
R.E. NO. 11199
W.O. 1628 FOR: T.J. WRIGHT F.B. 996/14

MARK	REVISIONS	APPR.	DATE
1	Insert 4'x4' dia. 90° at 7+76	DWG	2-16-68
2	Indicate 8 sta. (c) at 12+50.29 P.O.T.	DWG	6-11-68

DESIGNED BY R.L.S. DRAWN BY WHR CHECKED BY DV

CITY OF RIVERSIDE, CALIFORNIA
DEPARTMENT OF PUBLIC WORKS

	BY	DATE
APPROVED BY OFFICE ENGINEER	[illegible]	12-12-67
PARK DEPT.		
TRAFFIC DIVISION	[illegible]	12-11-67
ASSISTANT CITY ENGR.	[illegible]	12-11-67

APPROVED BY [signature]
DIRECTOR OF PUBLIC WORKS
DATE 12-11-67

STREET PLAN & PROFILE
ARROYO DR.
NORTH SIDE - 175' E'LY OF QUEEN ST.
LOCATION 1873 ARROYO DRIVE
BUILDING PERMIT

HORIZ. SCALE: 1"=40' VERT. SCALE: 1"=4'

PROJECT NO. R-1280
SHEET 1 OF 1 SHEET
FILE NO. 3347