—CAUTION—
PACIFIC TELEPHONE
CABLES UNDERGROUND
BEFORE EXCAVATING
CALL COLLECT

	7:30 A.M. to 5 P.M.	After Hours & Holidays
Orange County	714-633-0811	714-547-6606
Riverside County	714-684-0071	714-547-6606
Inyo County	714-684-0071	714-547-6606
San Bernardino County	714-684-0071	714-547-6606
Los Angeles County	213-621-3111	24 HOUR SERVICE
Ventura County	213-621-3111	
San Diego County	714-298-0595	714-232-0027

FOR FREE CABLE LOCATING SERVICE

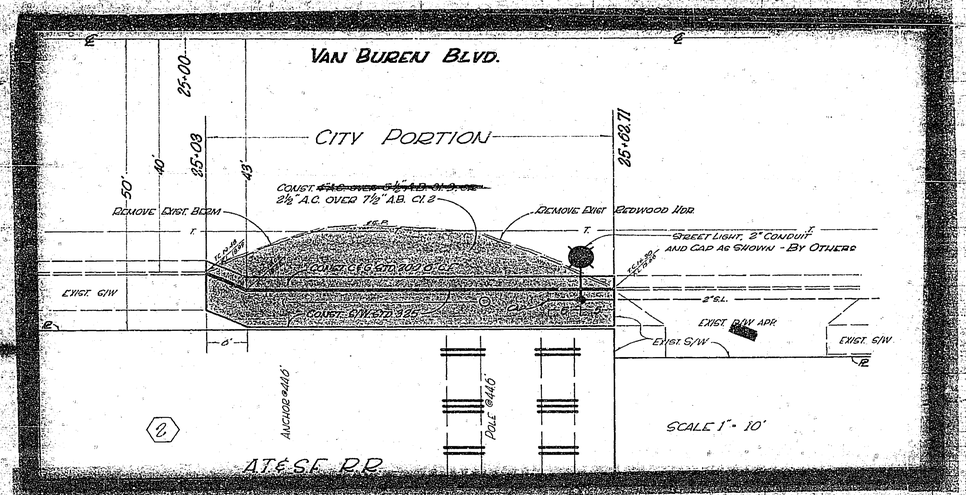

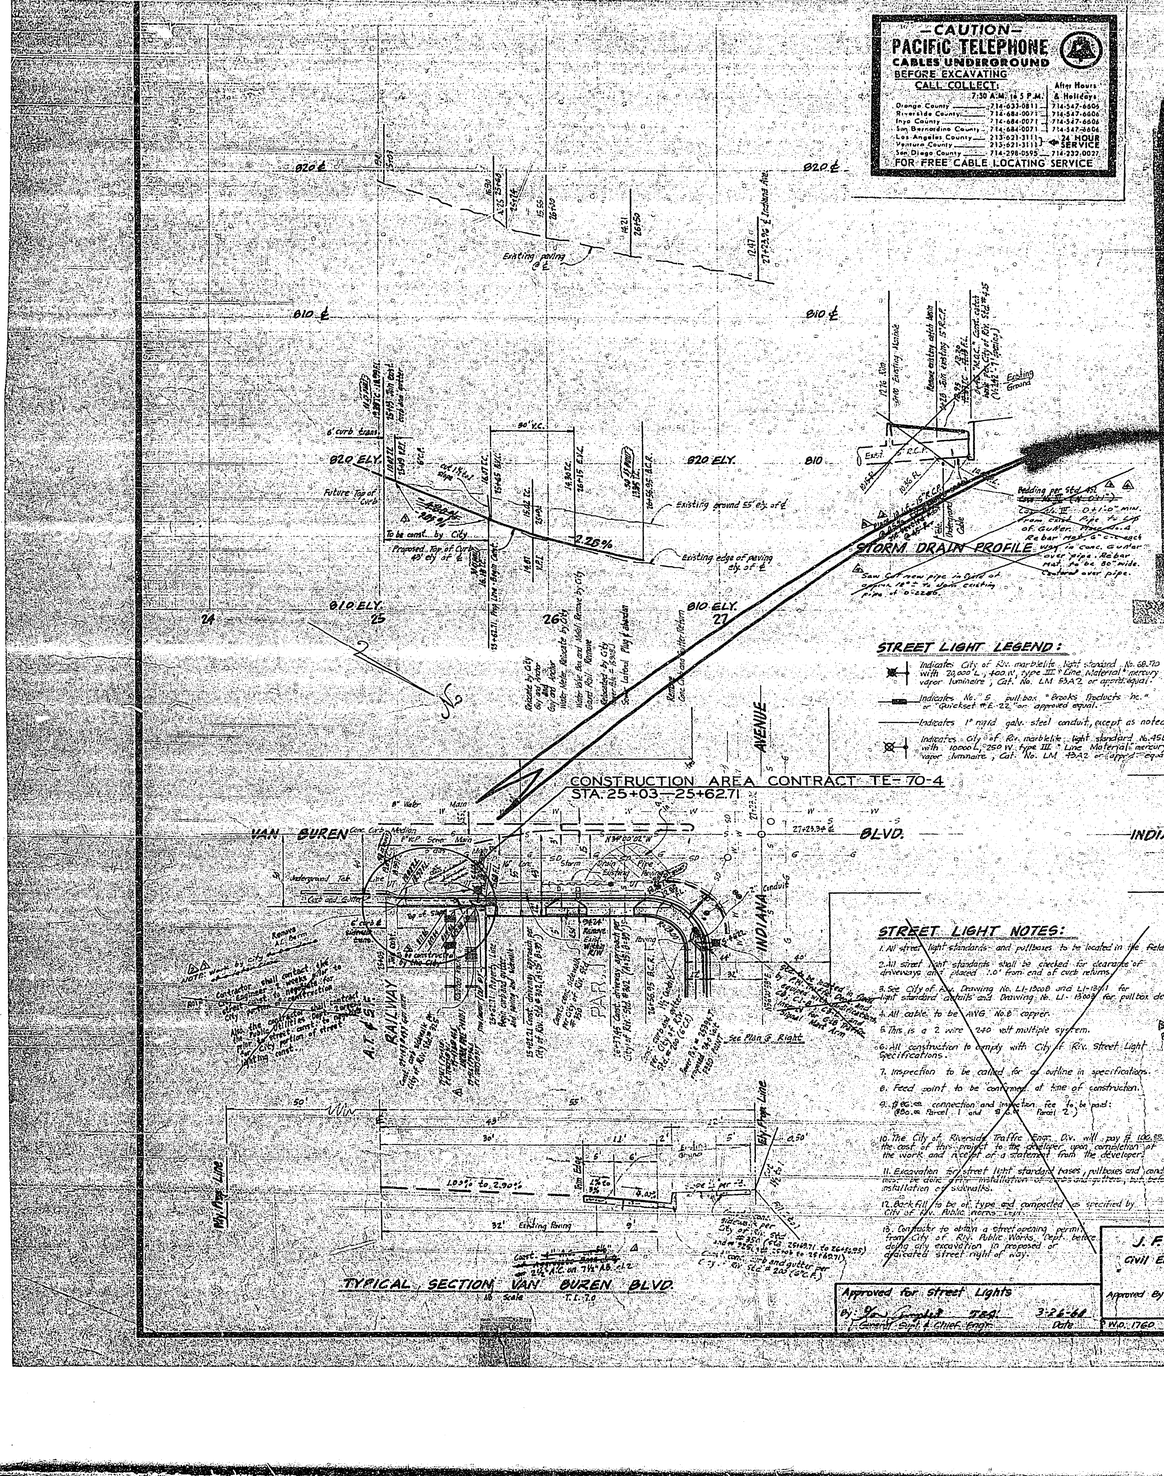

STREET LIGHT LEGEND:

- Indicates City of Riv. marbelite light standard No. 68-710 with 28.00' L., 400 W. type III Line Material mercury vapor luminaire, Cat. No. LM 69A2 or approved equal.
- Indicates No. 6 pullbox "Brooks Products Inc." or "Quickset M.E.-22" or approved equal.
- Indicates 1" rigid galv. steel conduit, except as noted.
- Indicates City of Riv. marbelite light standard No. 4501 with 30.00' L., 250 W. type III Line Material mercury vapor luminaire, Cat. No. LM 49A2 or approved equal.

STREET LIGHT NOTES:

1. All street light standards and pullboxes to be located in the field.
2. All street light standards shall be checked for clearance of driveways and placed 1.0' from end of curb returns.
3. See City of Riv. Drawing No. LI-1068 and LI-1069 for street light standard details and Drawing No. LI-1069 for pullbox details.
4. All cable to be #6 AWG copper.
5. This is a 2 wire 240 volt multiple system.
6. All construction to comply with City of Riv. Street Light Specifications.
7. Inspection to be called for as outline in specifications.
8. Feed point to be confirmed at time of construction.
9. Service connection and inspection fee to be paid: (Van Buren Blvd.) Parcel 1 and (Indiana Ave.) Parcel 2.
10. The City of Riverside Traffic Engr. Div. will pay $ 100.00 toward the cost of this project to the developer upon completion of the work and receipt of a statement from the developer.
11. Excavation for street light standard bases, pullboxes and conduits must be done by installation contractor, not by electrician or subcontractor.
12. Backfill to be of type and compacted as specified by City of Riv. Public Works Dept.
13. Contractor to obtain a street opening permit from City of Riv. Public Works Dept. before doing any excavation in proposed or dedicated street right of way.

NOTE: Trees have been recently removed within the R/W of Indiana Ave. If Palms have not been felled or cut prior the contractor shall do so.

BENCH MARK:

Spike in elm tree on Arizona St. 15 ft. By of Van Buren Blvd. - City F.B. 471/4 Elevation 609.16 ft.

GENERAL NOTES:

1. It shall be the responsibility of the contractor to clear the right of way in accordance with the provisions of law as it affects each utility including irrigation lines and appurtenances and at no cost to the City.
2. Construction shall be in accordance with the Standard Specifications for Public Works Construction, 1967 Edition, and any addenda thereto.
3. Prime Coat, Seal Coat and Paint Binder are required.
4. Grading will require a permit under ordinance 3095 for a cut or fill exceeding 100 cu. yds. or a fill over one foot in depth.
5. The developer shall submit to the City for its approval a soils engineering report of pavement design based on the soil characteristics of the subgrade and materials to be used. Such report shall be submitted to the City of Riverside for approval prior to construction.
6. Trim edge of existing paving, where new paving joins existing pavement. Re-construct, ditch-up paving as shown and overlay paving as directed in the field to produce a smooth crown section.
7. For reduction of any City standard, complete with family, street name, width, Curb to curb, R-O-W, Easter, Northing, Bearing, Distance, Curve Data, etc. on all parcels, submit to Public Works Department for approval.

Approved for Street Lights
By: [signature] Traffic Engr.
Date: 3-26-68
Current City Engr. & Chief Engr.

J. F. DAVIDSON ASSOCIATES
Civil Engineers Surveyors Planners
Riverside, California
Approved By: [signature] Date: 2/10/68
R.C.E. No. 17669
W.O. 1760 FOR: Phil Pooke, Jr. R.B. 905/30

MARK	REVISIONS	APPR.	DATE
A	Addn A.C. and A.B. Refinements		7-11-67
B	Above City Position, Details		1-23-68

DESIGNED BY Jack DRAWN BY Jack CHECKED BY [illegible]

CITY OF RIVERSIDE, CALIFORNIA
DEPARTMENT OF PUBLIC WORKS

	BY	DATE
APPROVED BY, OFFICE ENGINEER	[illegible]	5-15-68
PARK DEPARTMENT		
TRAFFIC DIVISION		
ASSISTANT CITY ENG.		
DATE: 5-15-68		

APPROVED BY [signature] DIRECTOR OF PUBLIC WORKS

R.I.S. 1014

Street Plan and Profile
INDIANA AVE. — VAN BUREN BLVD.
(Cen. Line of Van Buren Blvd.) (400' South of E. Indiana Ave.)
EAST SIDE

HORIZ. SCALE: 1" = 40' VERT. SCALE: 1" = 4'

ACC. NO. 30-579-545-07
L.S. 15904
CONTRACT TE-70-4
R-1282-A
SHEET OF
FILE NO. 3850