CROSS SECTIONS

Scale: 1" Inch = 5 = feet

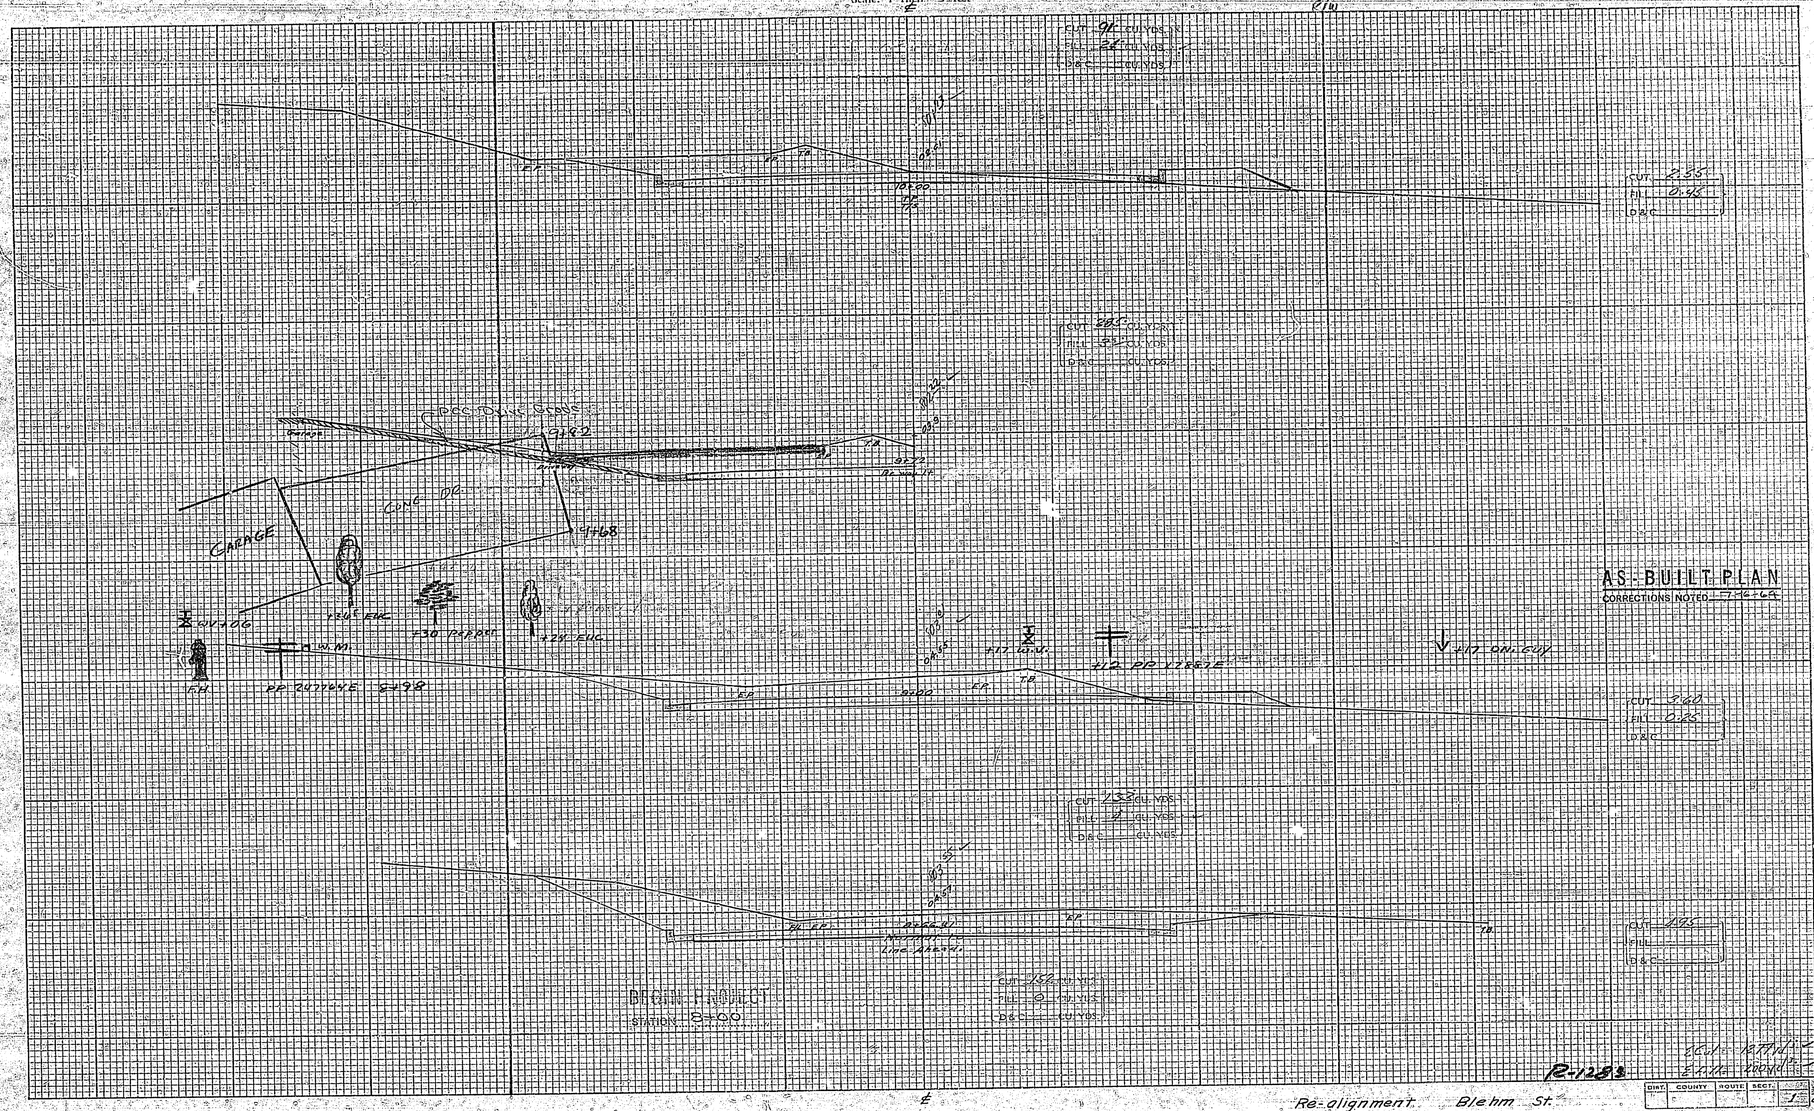

CROSS SECTIONS

Scale: 1 Inch = 5 feet

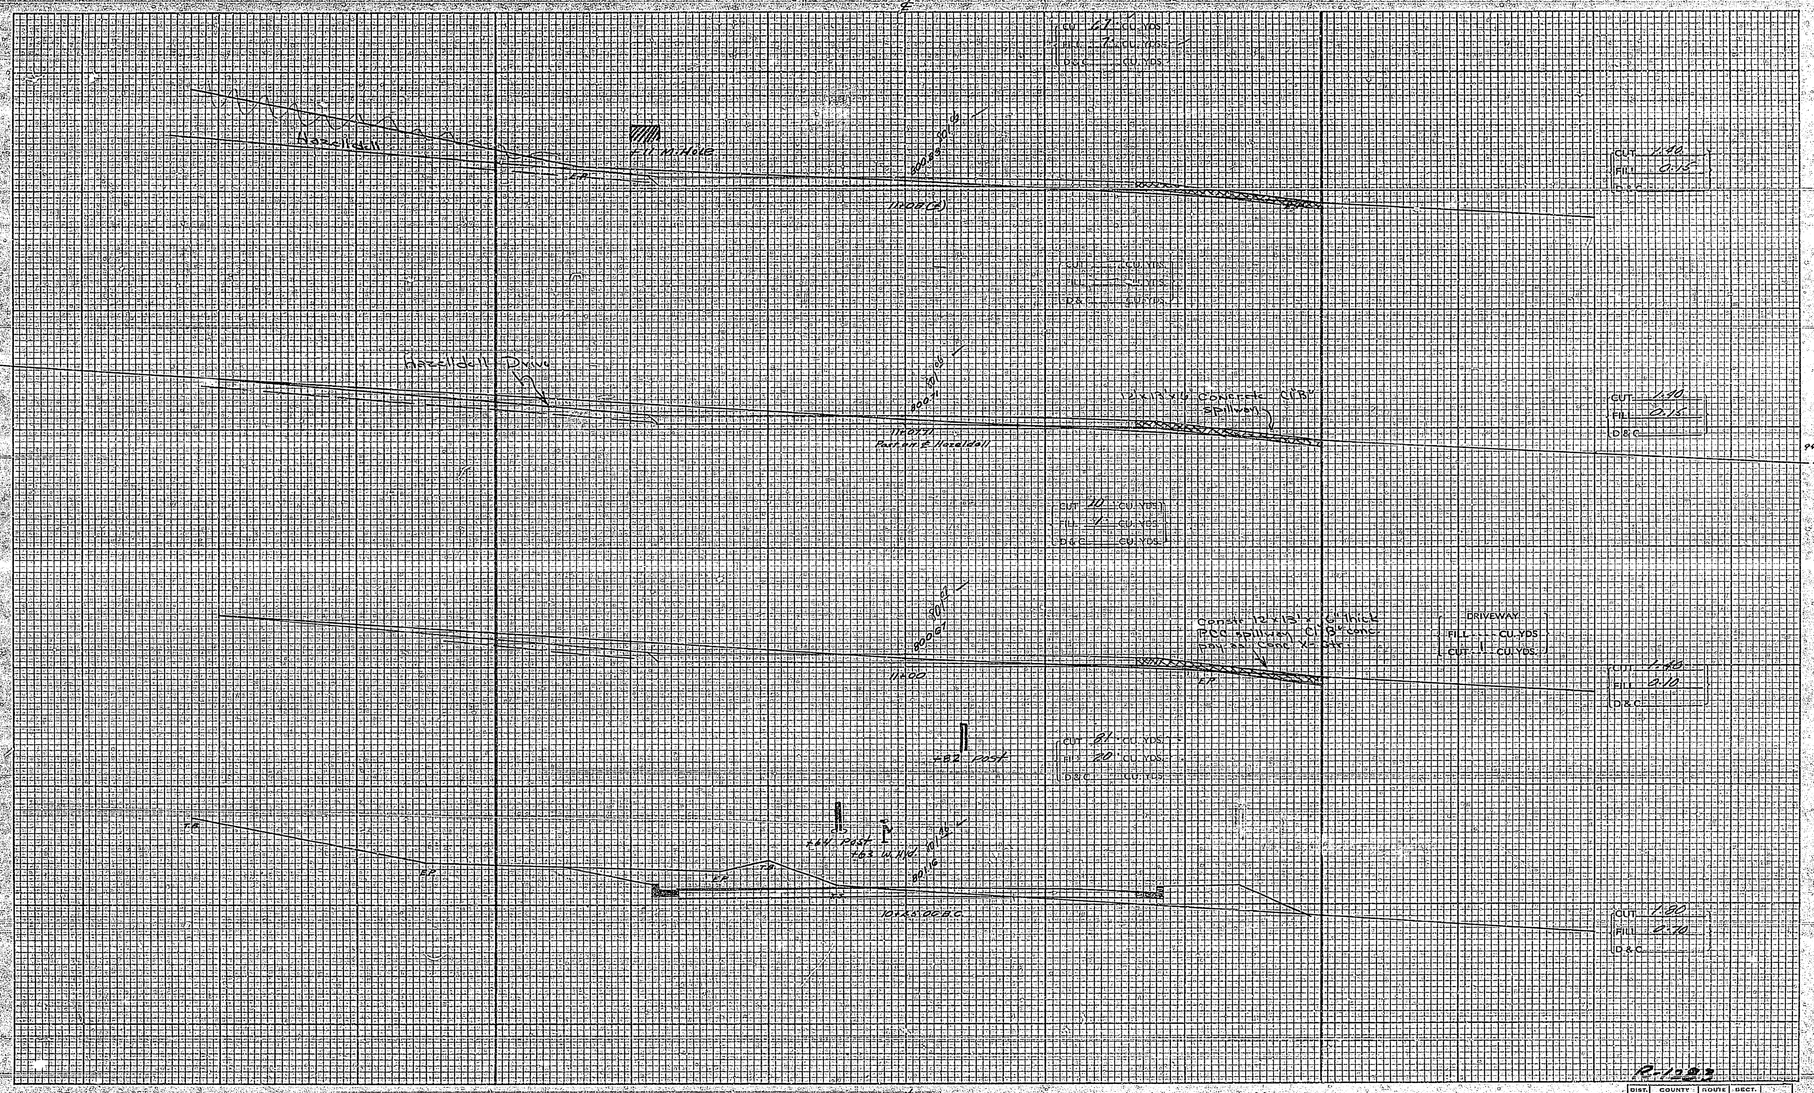

CROSS SECTIONS

Scale: 1 Inch = 5 Feet

TEMPLET — Plotted By: Lewis Date: 2-1-62 — Designed By: Brumley Date: — — Drawn By: Date: — — Checked By: Date: — — Issued By: Date: —

GROUND — Plotted By: PEM Date: 2-14-62 — Checked By: Date: — — Issued By: Date: —

Points By: — Field Book No. 3376, 914 — Reviewed By: —

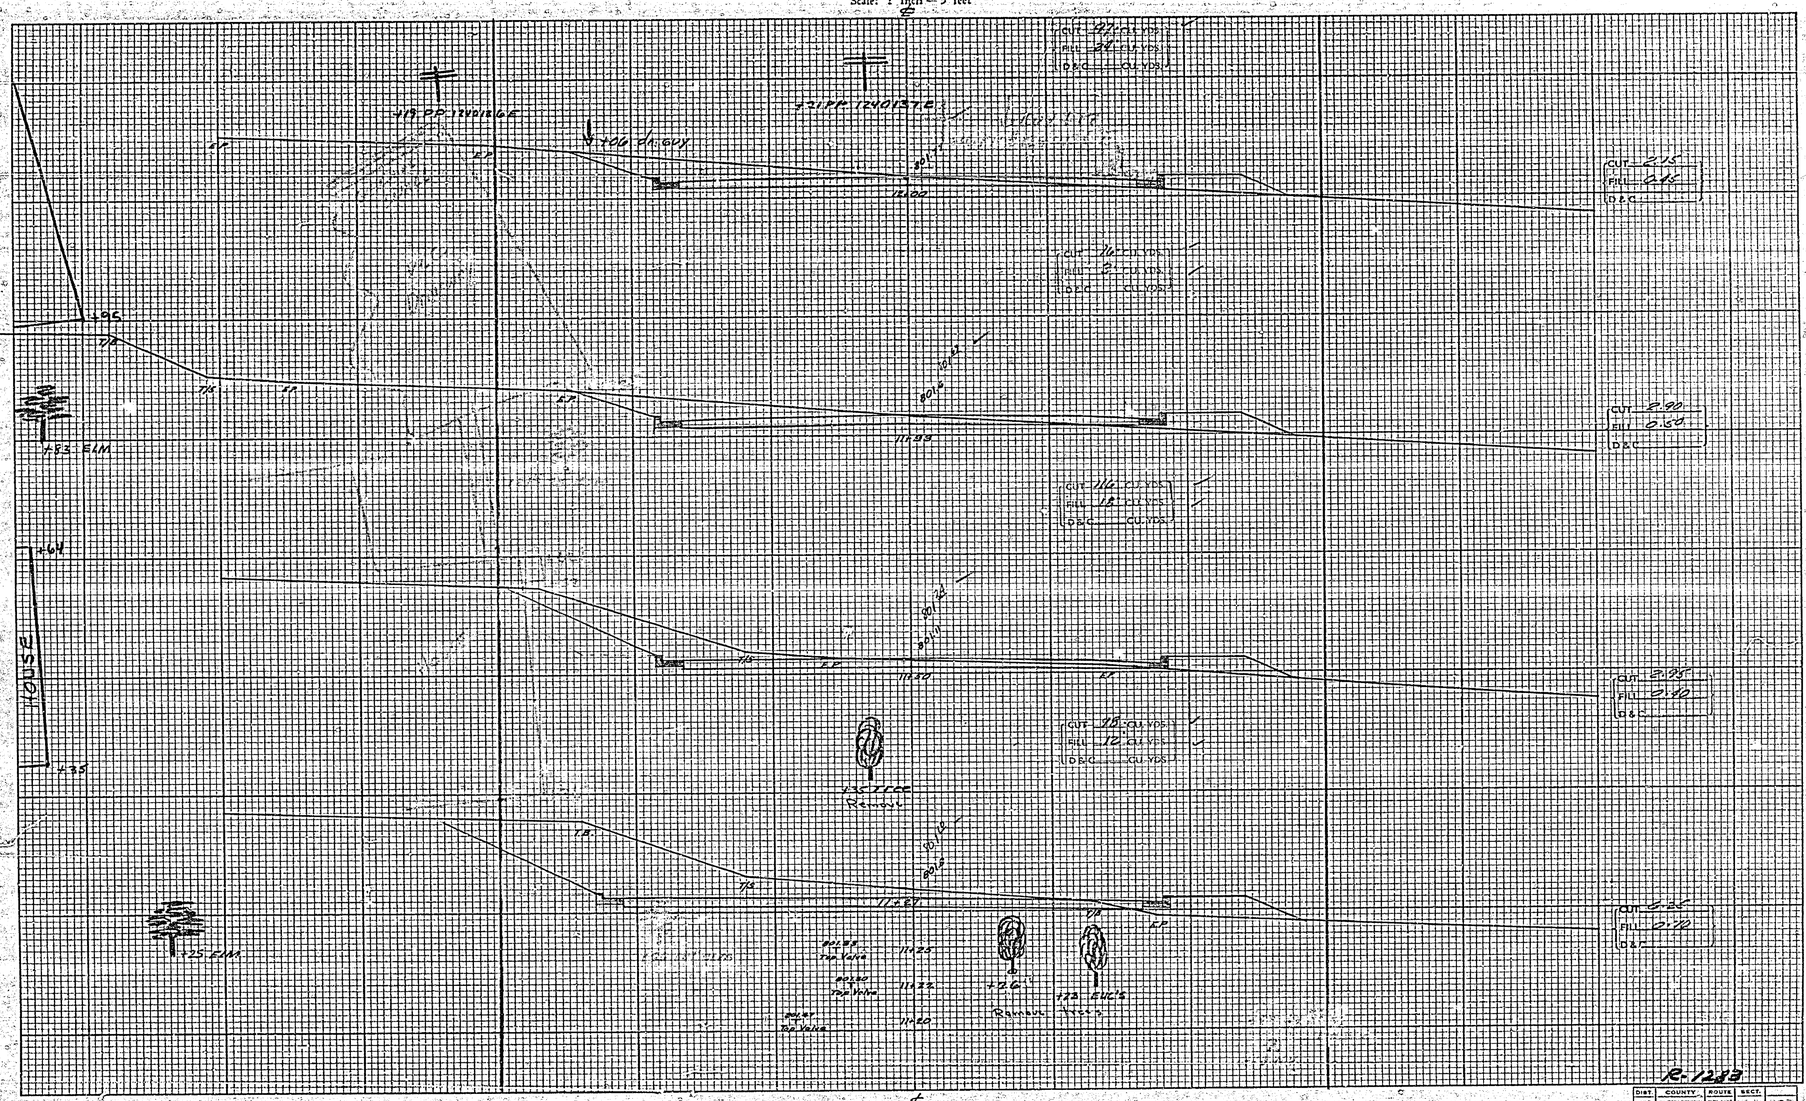

℄

Re-alignment Blehm St.

DIST.	COUNTY	ROUTE	SECT.	
				3

of 5

R-1283

CROSS SECTIONS

Scale: 1 inch = 5 feet

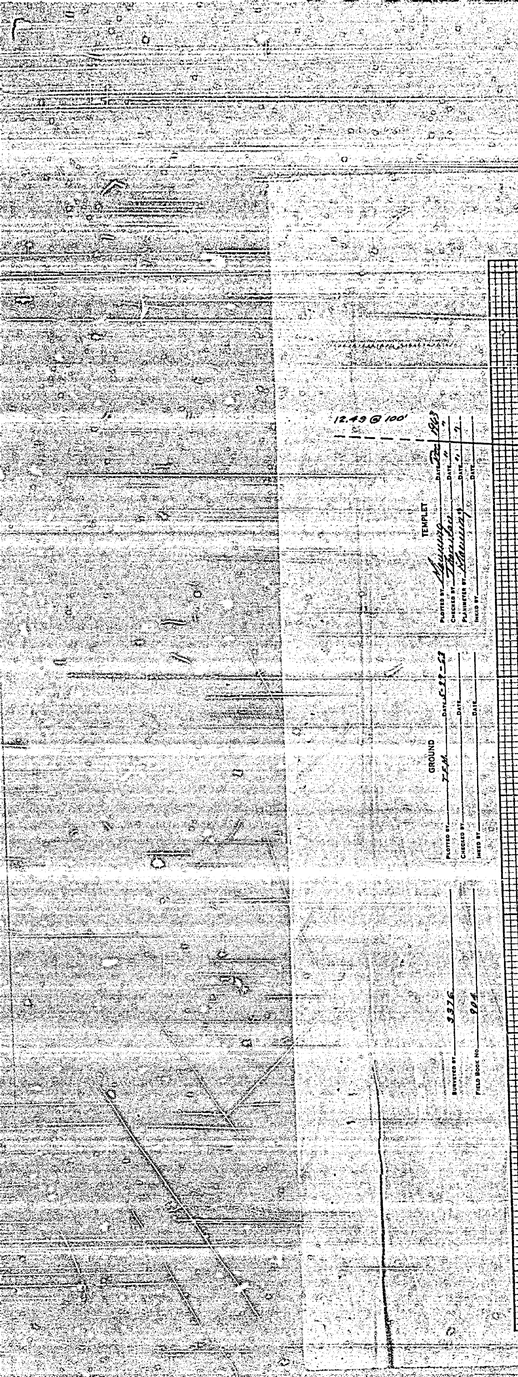

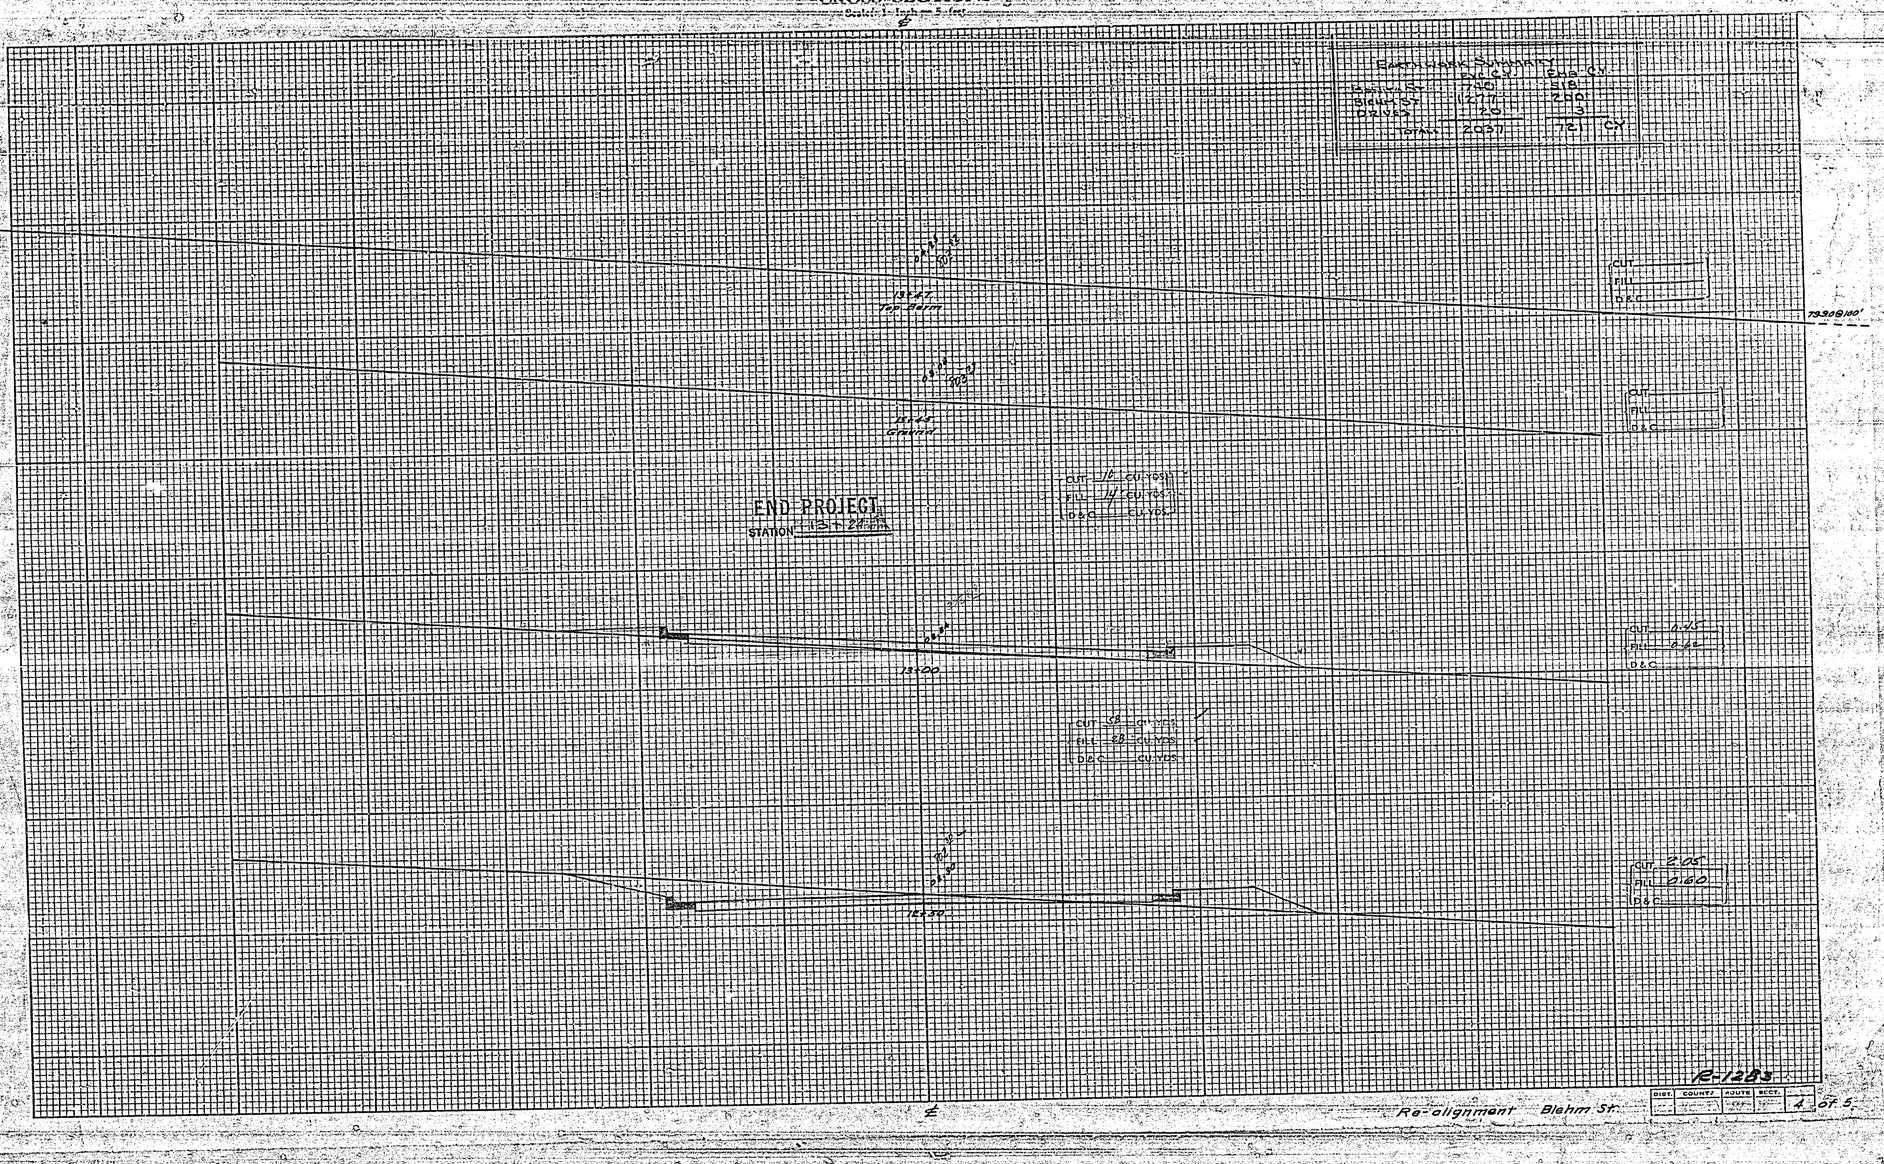

Re-alignment Blehm St.

DIST.	COUNTY	ROUTE	SECT.	
				4 OF 5

R-1283

TEMPLET

PLOTTED BY: Spencer DATE: 12-7-67
CHECKED BY: Thomas DATE:
ISSUED BY: DATE:

GROUND
PLOTTED BY: Spencer DATE:
CHECKED BY: DATE:
ISSUED BY: DATE:

SURVEYED BY: 3376
FIELD BOOK NO.: 904

CROSS SECTIONS

Scale: 1 Inch = 5 feet

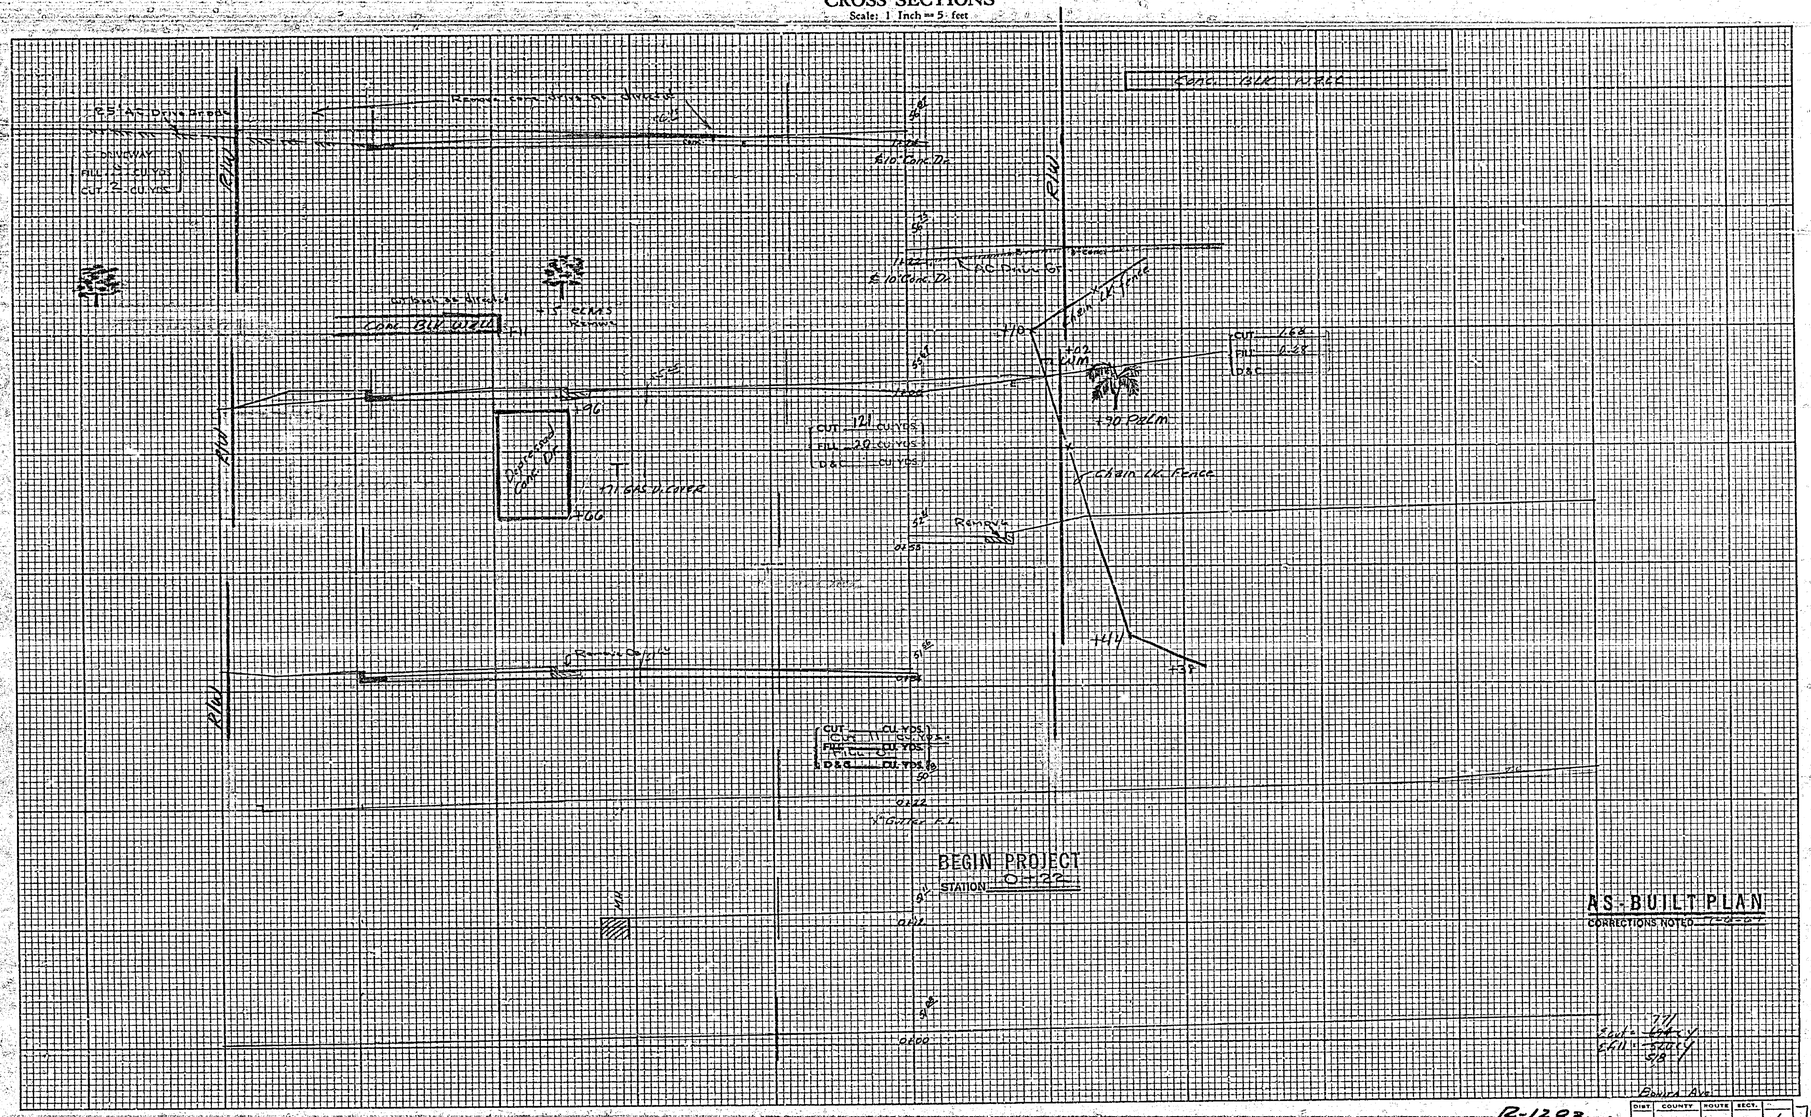
Remove

CROSS SECTIONS

Scale: 1 Inch = 5 feet

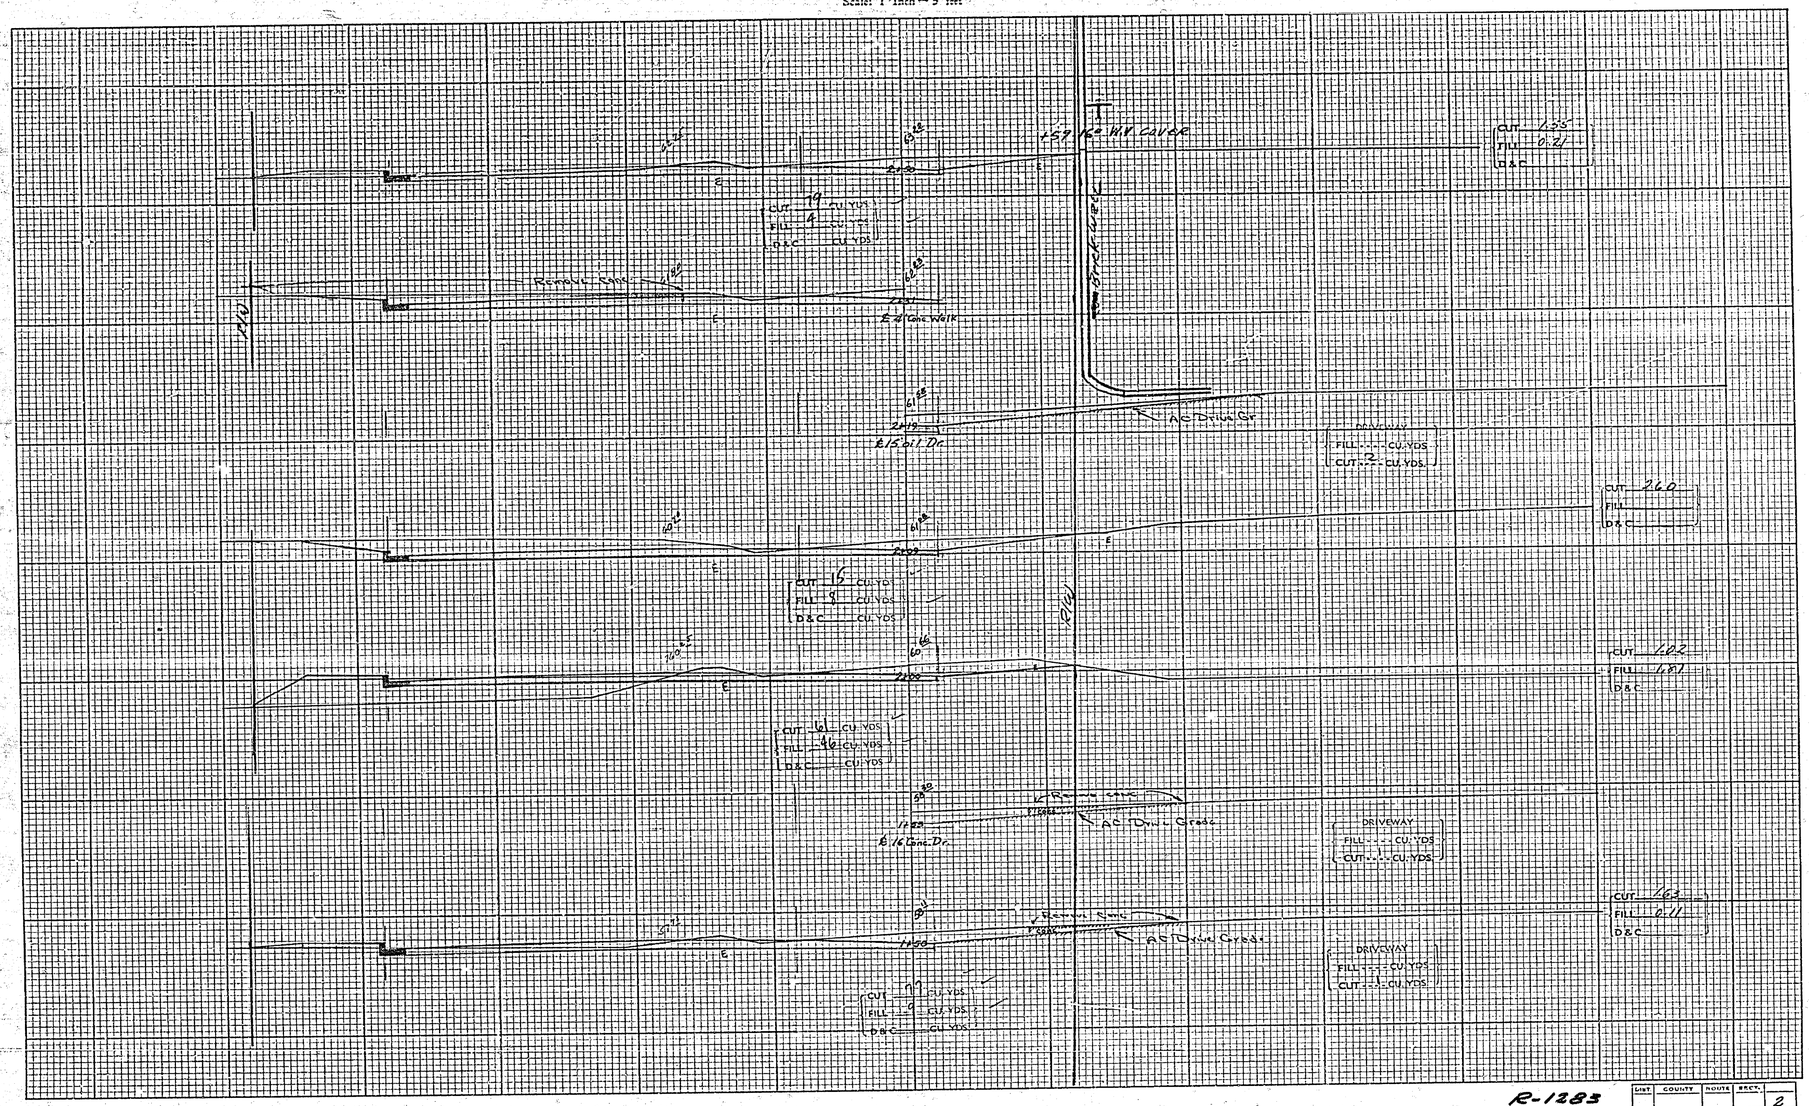

TEMPLET
PLOTTED BY ____ DATE ____
CHECKED BY ____ DATE ____
PLANIMETER BY ____ DATE ____
ISSUED BY ____ DATE ____

GROUND
PLOTTED BY Manning DATE ____
CHECKED BY ____ DATE ____
ISSUED BY ____ DATE ____

SURVEYED BY 3376
FIELD BOOK NO. 904

R-1283

DIST	COUNTY	ROUTE	SHEET	
				2

CROSS SECTIONS

Scale: 1 Inch = 5 feet

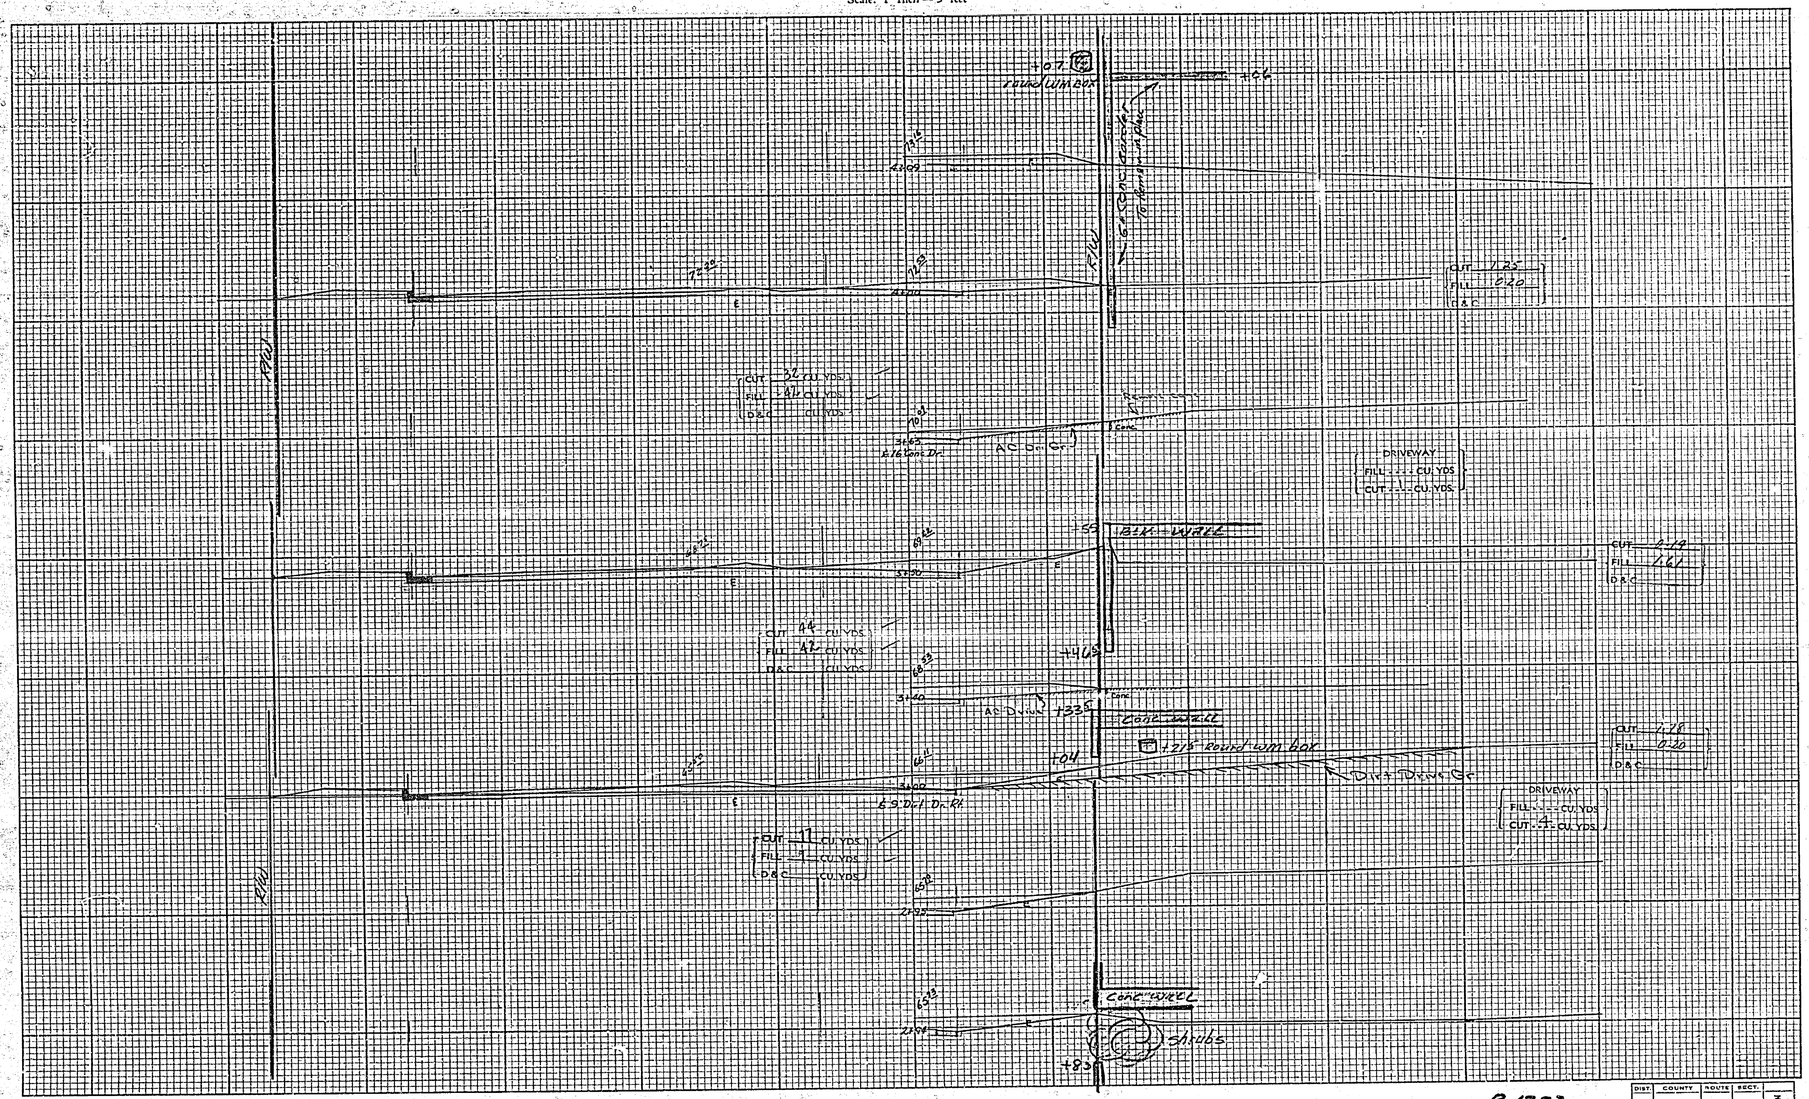

R-1283

DIST.	COUNTY	ROUTE	SECT.	
				3

TEMPLET

PLOTTED BY DATE
CHECKED BY DATE
PLANIMETER BY DATE
INKED BY DATE

GROUND

PLOTTED BY DATE
CHECKED BY DATE
INKED BY DATE

SURVEYED BY
FIELD BOOK NO.

CROSS SECTIONS

Scale: 1 Inch = 5 feet

TEMPLET

PLOTTED BY: ____ DATE: ____
CHECKED BY: ____ DATE: ____
ISSUED BY: ____ DATE: ____

GROUND

PLOTTED BY: ____ DATE: ____
CHECKED BY: ____ DATE: ____
FIELD BOOK NO. ____ ISSUED BY: ____ DATE: ____

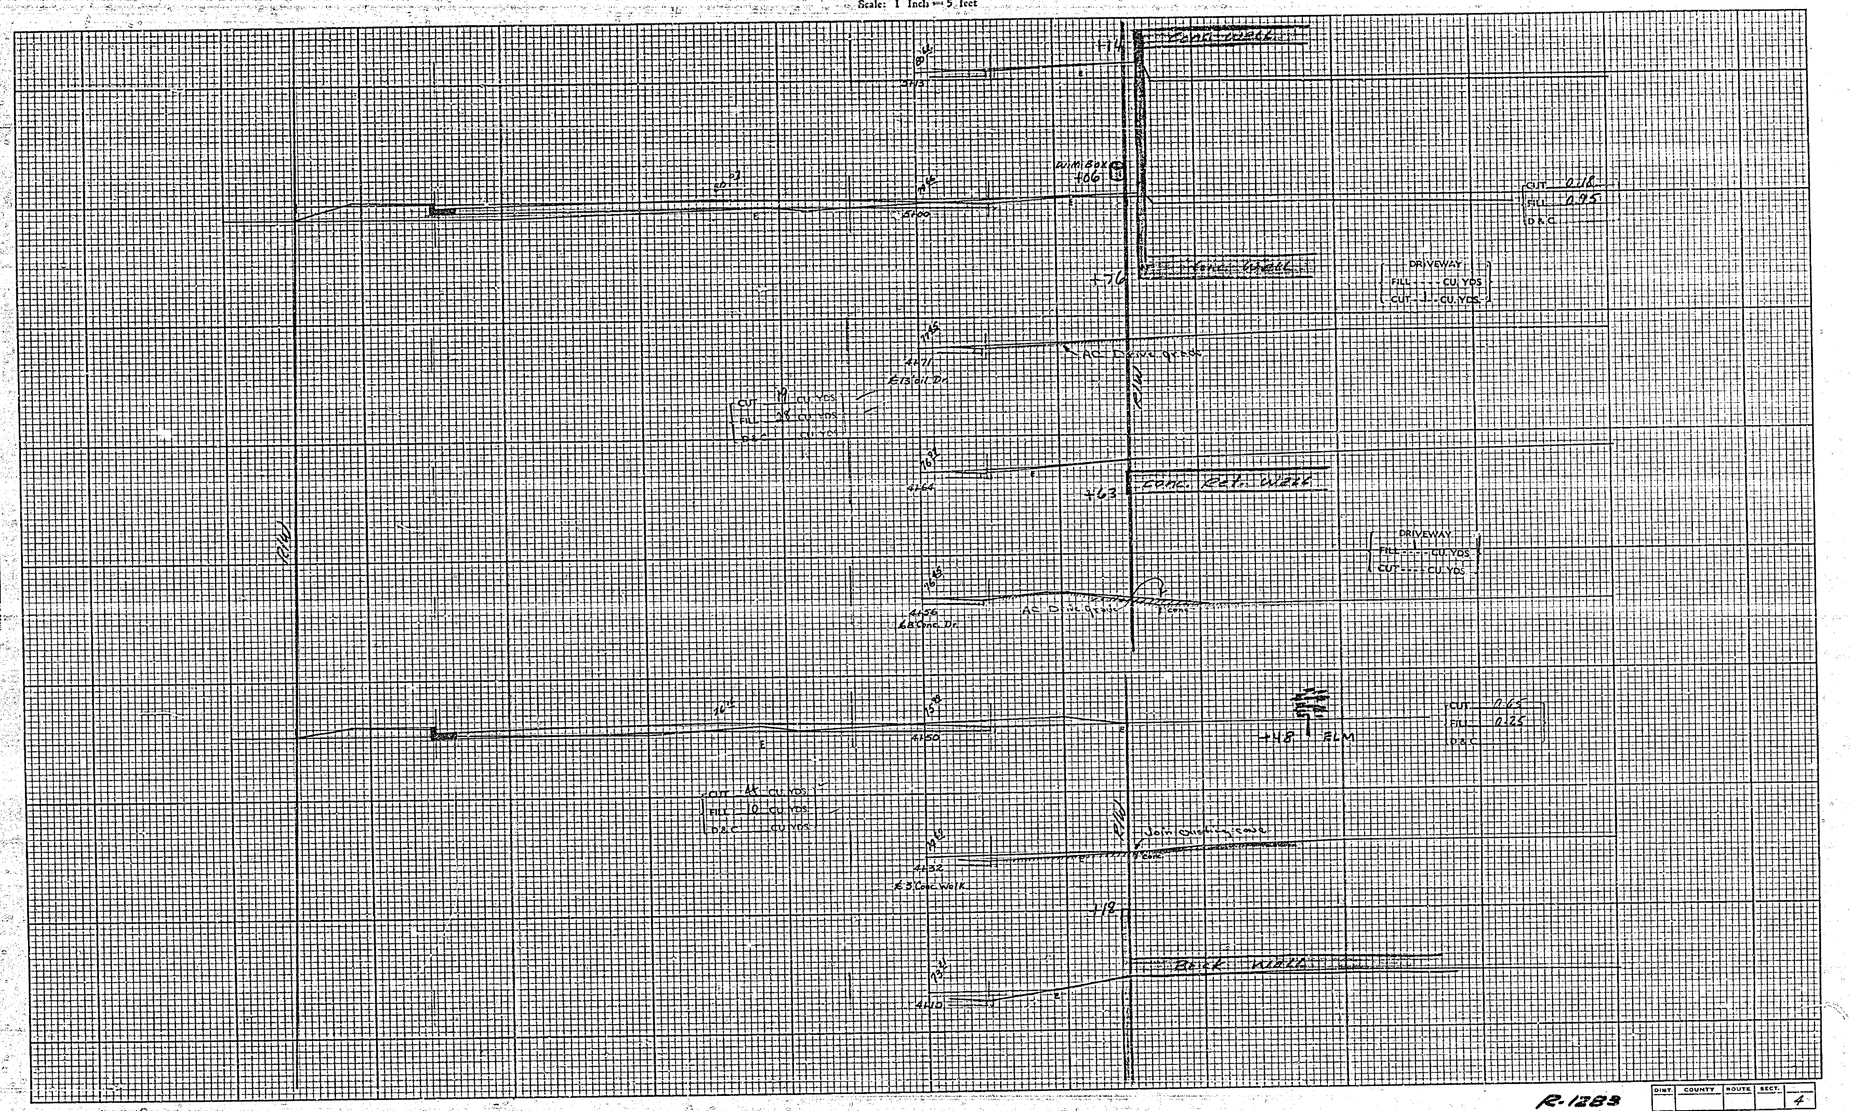

R-1283

DIST.	COUNTY	ROUTE	SECT.	
				4

CROSS SECTIONS

Scale: 1 Inch = 5 feet.

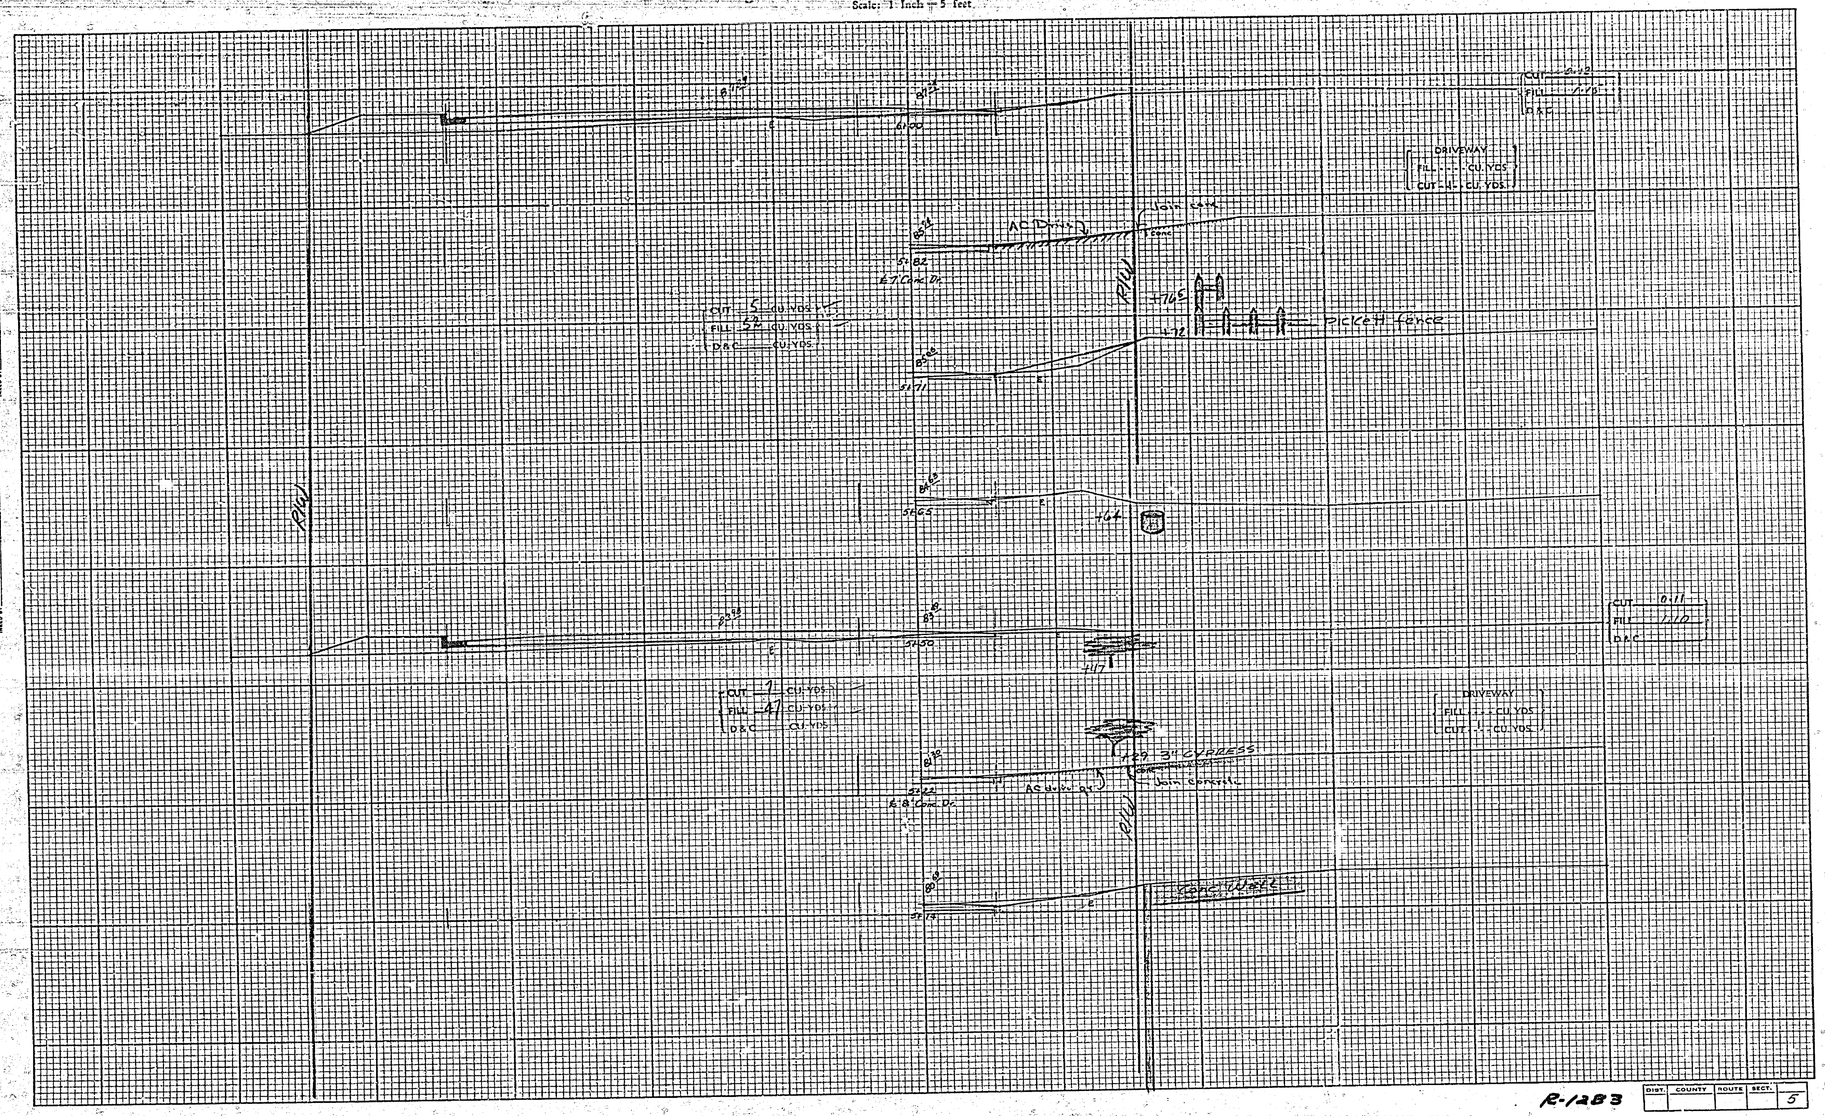

DIST.	COUNTY	ROUTE	SECT.	
				5

R-1283

TEMPLET
PLOTTED BY: DATE:
CHECKED BY: DATE:
PLANIMETER BY: DATE:
INKED BY: DATE:

GROUND
PLOTTED BY: DATE:
CHECKED BY: DATE:
INKED BY: DATE:

SURVEYED BY:
FIELD BOOK NO.:

CROSS SECTIONS

Scale: 1 Inch = 5 feet

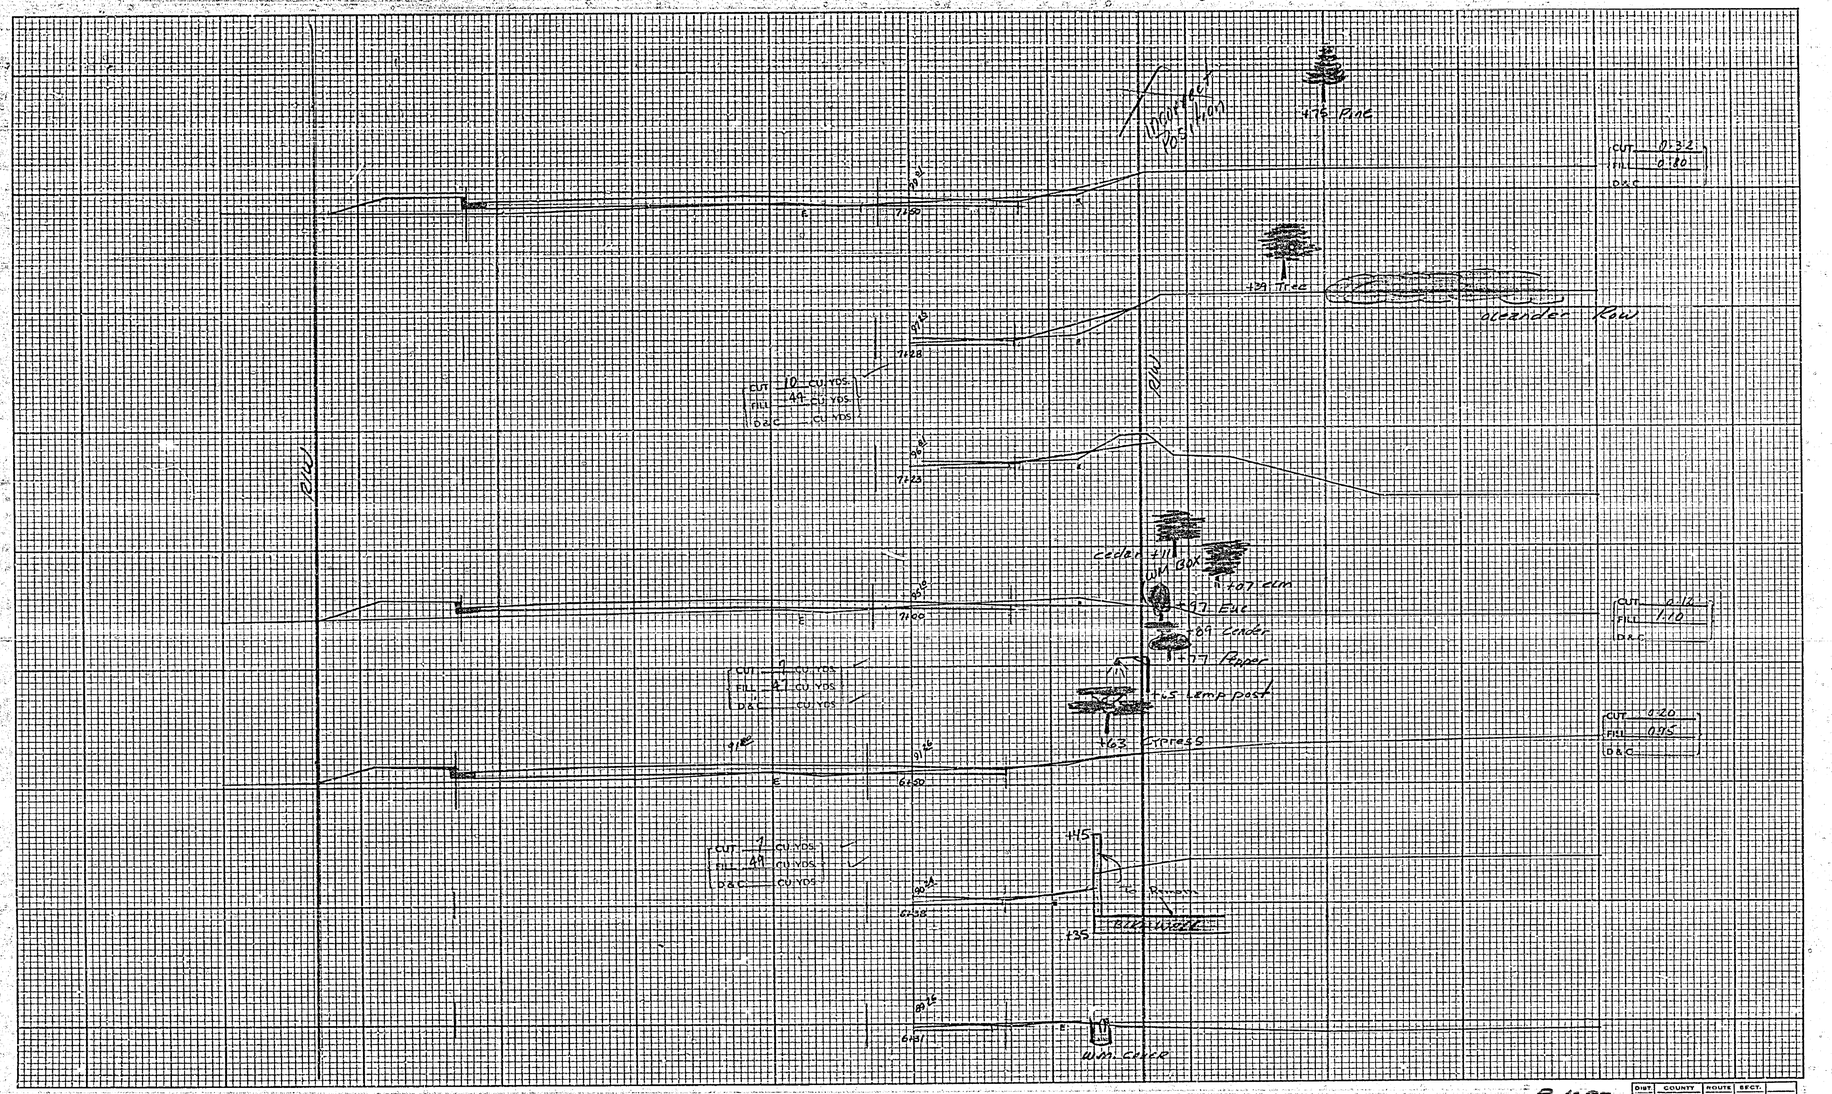

R-1283

DIST.	COUNTY	ROUTE	SECT.	
				6

GROUND

PLOTTED BY ____ DATE ____
CHECKED BY ____ DATE ____
PLANIMETER BY ____ DATE ____
ISSUED BY ____ DATE ____

TEMPLET

PLOTTED BY ____ DATE ____
CHECKED BY ____ DATE ____
PLANIMETER BY ____ DATE ____
ISSUED BY ____ DATE ____

SURVEYED BY ____
FIELD BOOK NO. ____

CROSS SECTIONS

Scale: 1 Inch = 5 feet

TEMP-ET

GROUND

Plotted By: Date:
Checked By: Date:
Projection By: Date:
Book #: Page #:

Surveyed By:
Field Book No.

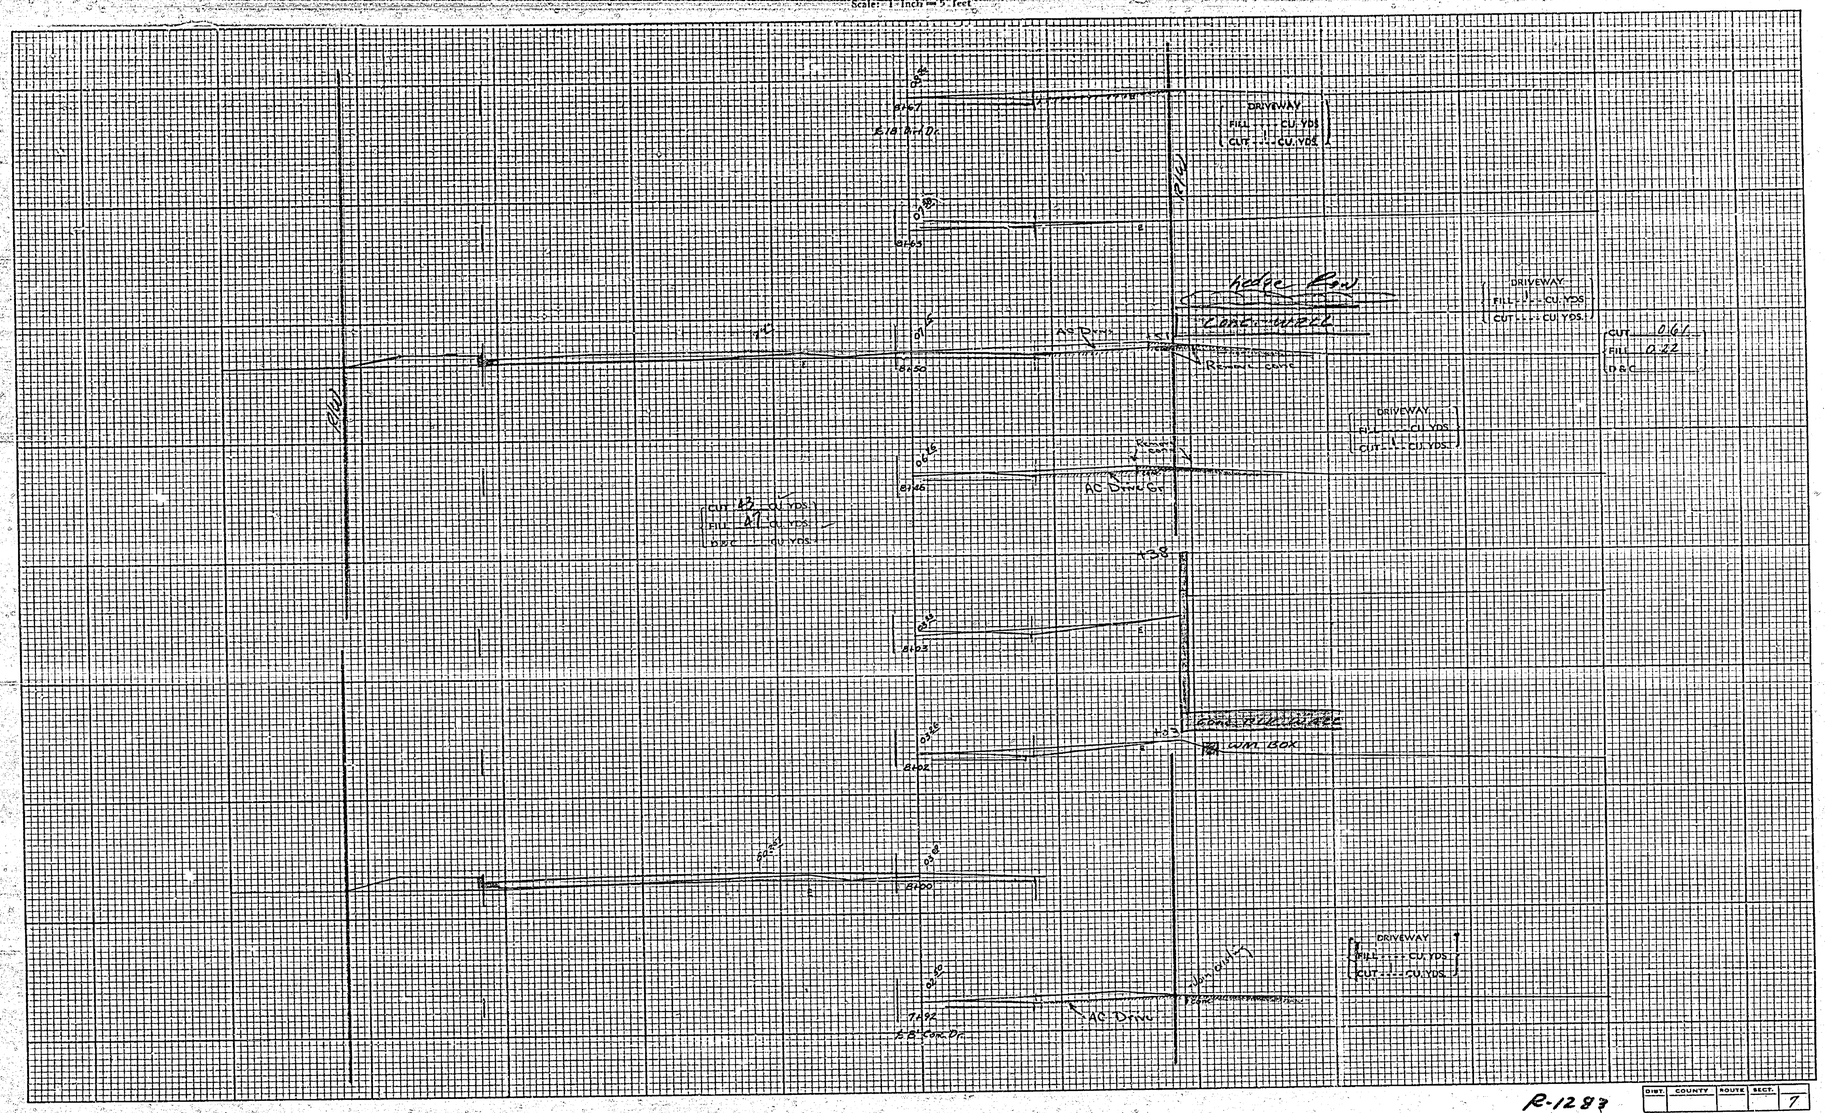

DIST.	COUNTY	ROUTE	SECT.	
				7

R-1287

CROSS SECTIONS

Scale: 1 Inch = 5 feet

END PROJECT
STATION 5+62.77

To 4+62.77
CUT 42 CU YDS
FILL 3 CU YDS
D&C CU YDS

+48 8" W.M. VALVE

+44 PP # 2704376

+41 W.M. BOX

+39 24" Palm

+17

99' Palm +10

Palm +19

Stone WALK

+88 Palm

Rock curb

CUT 175
FILL
D&C

CUT CU YDS
FILL CU YDS
D&C CU YDS

TEMPLET
PLOTTED BY DATE
CHECKED BY DATE
PLANIMETER BY DATE
INDEX BY DATE

GROUND
PLOTTED BY DATE
CHECKED BY DATE
INDEX BY DATE

SURVEY BY
FIELD BOOK NO

R-1283

8

BLEHM STREET

PEPPER DRIVE TO BONITA AVENUE

Survey No. 3376 Field Book No. 904
Road No. 1035 Work Order No.
A.C. Keith County Surveyor and Road Commissioner
Jan 1964

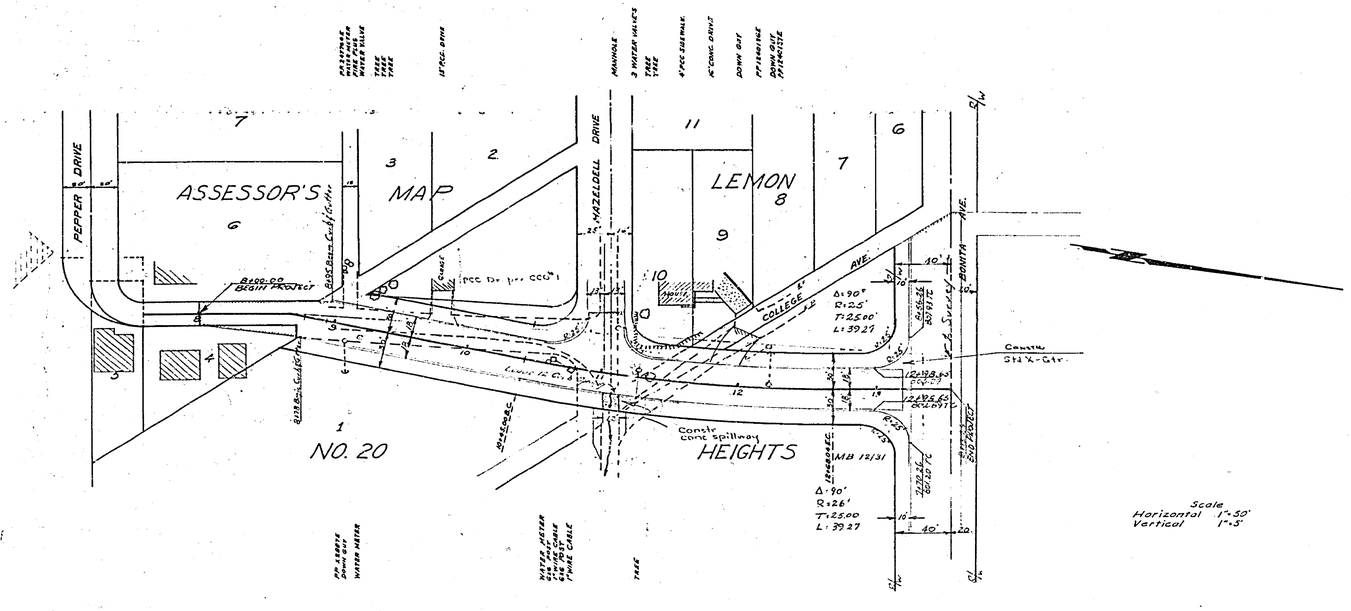

AS-BUILT PLAN
CORRECTIONS NOTED 7-6-64

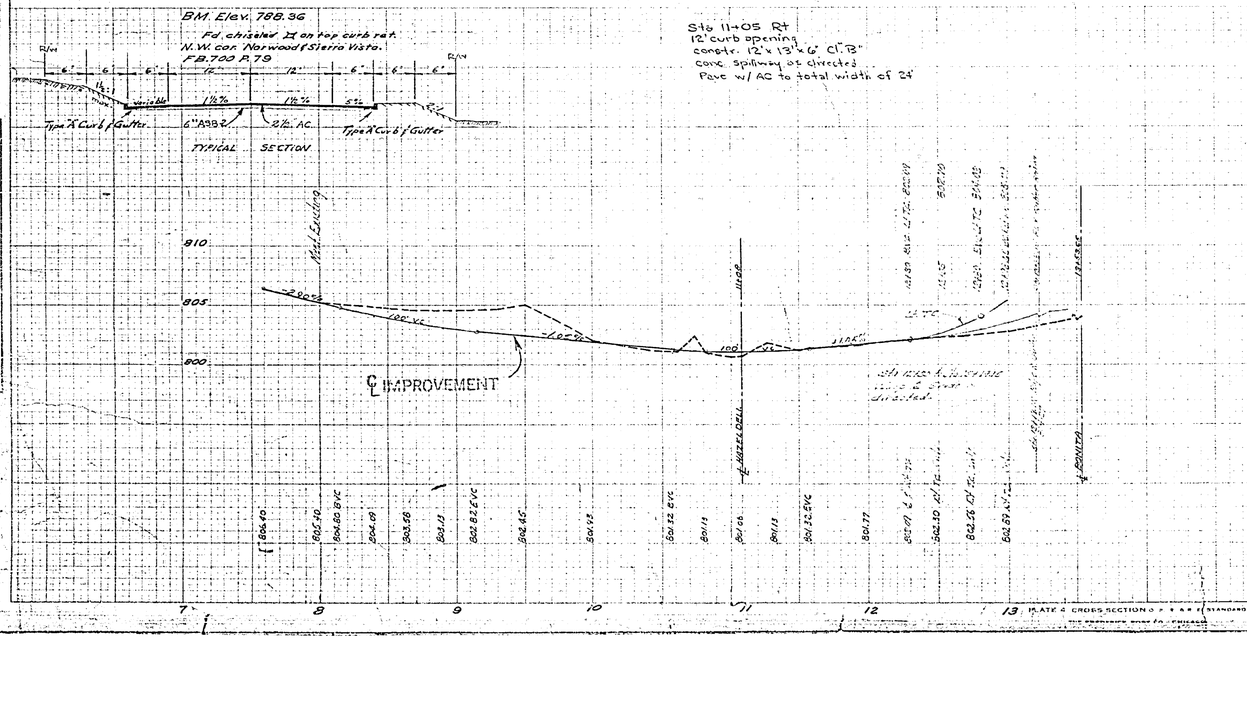

R-1283
1 of 2 764-I

BONITA AVENUE

SIERRA VISTA TO COLLEGE AVENUE

Survey No. 3376 Field Book No. 904
Road No. 10-41 Work Order No.
A.C. Keith County Surveyor and Road Commissioner
Jan. 1964

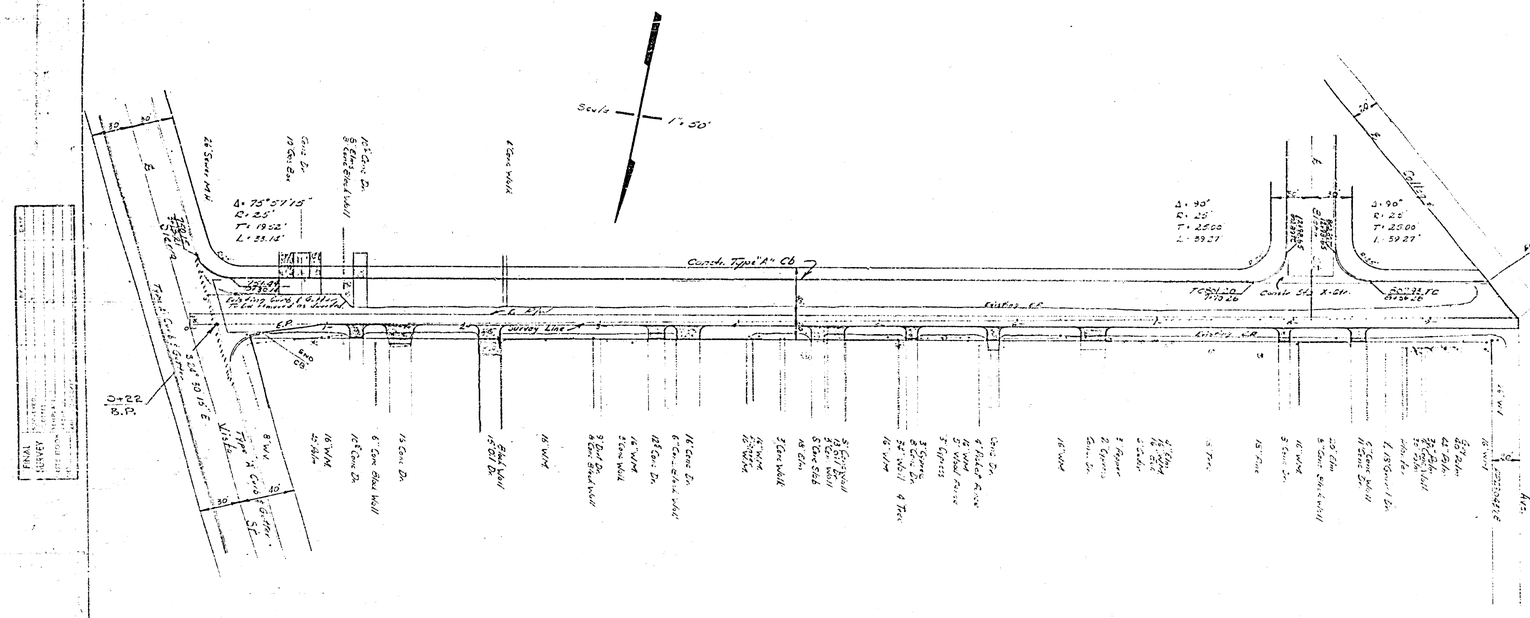

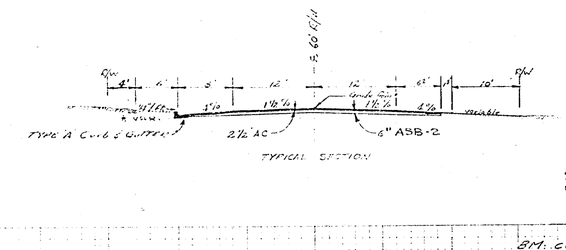

AS-BUILT PLAN
CORRECTIONS NOTED 7-6-64

FOR LOCATIONS OF CONCRETE DRIVES SEE CCO #1

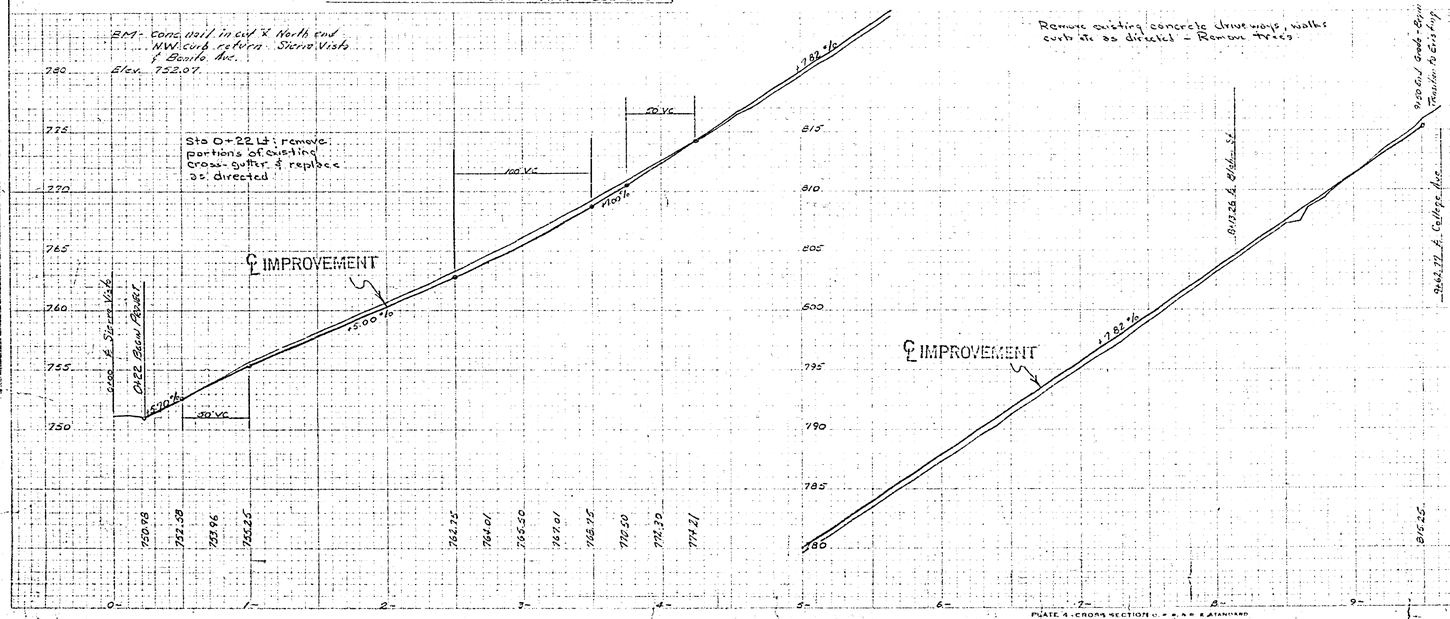

PLATE 4 - CROSS SECTION U. F. & R. & STANDARD

R-1283
2 of 2
7764-I