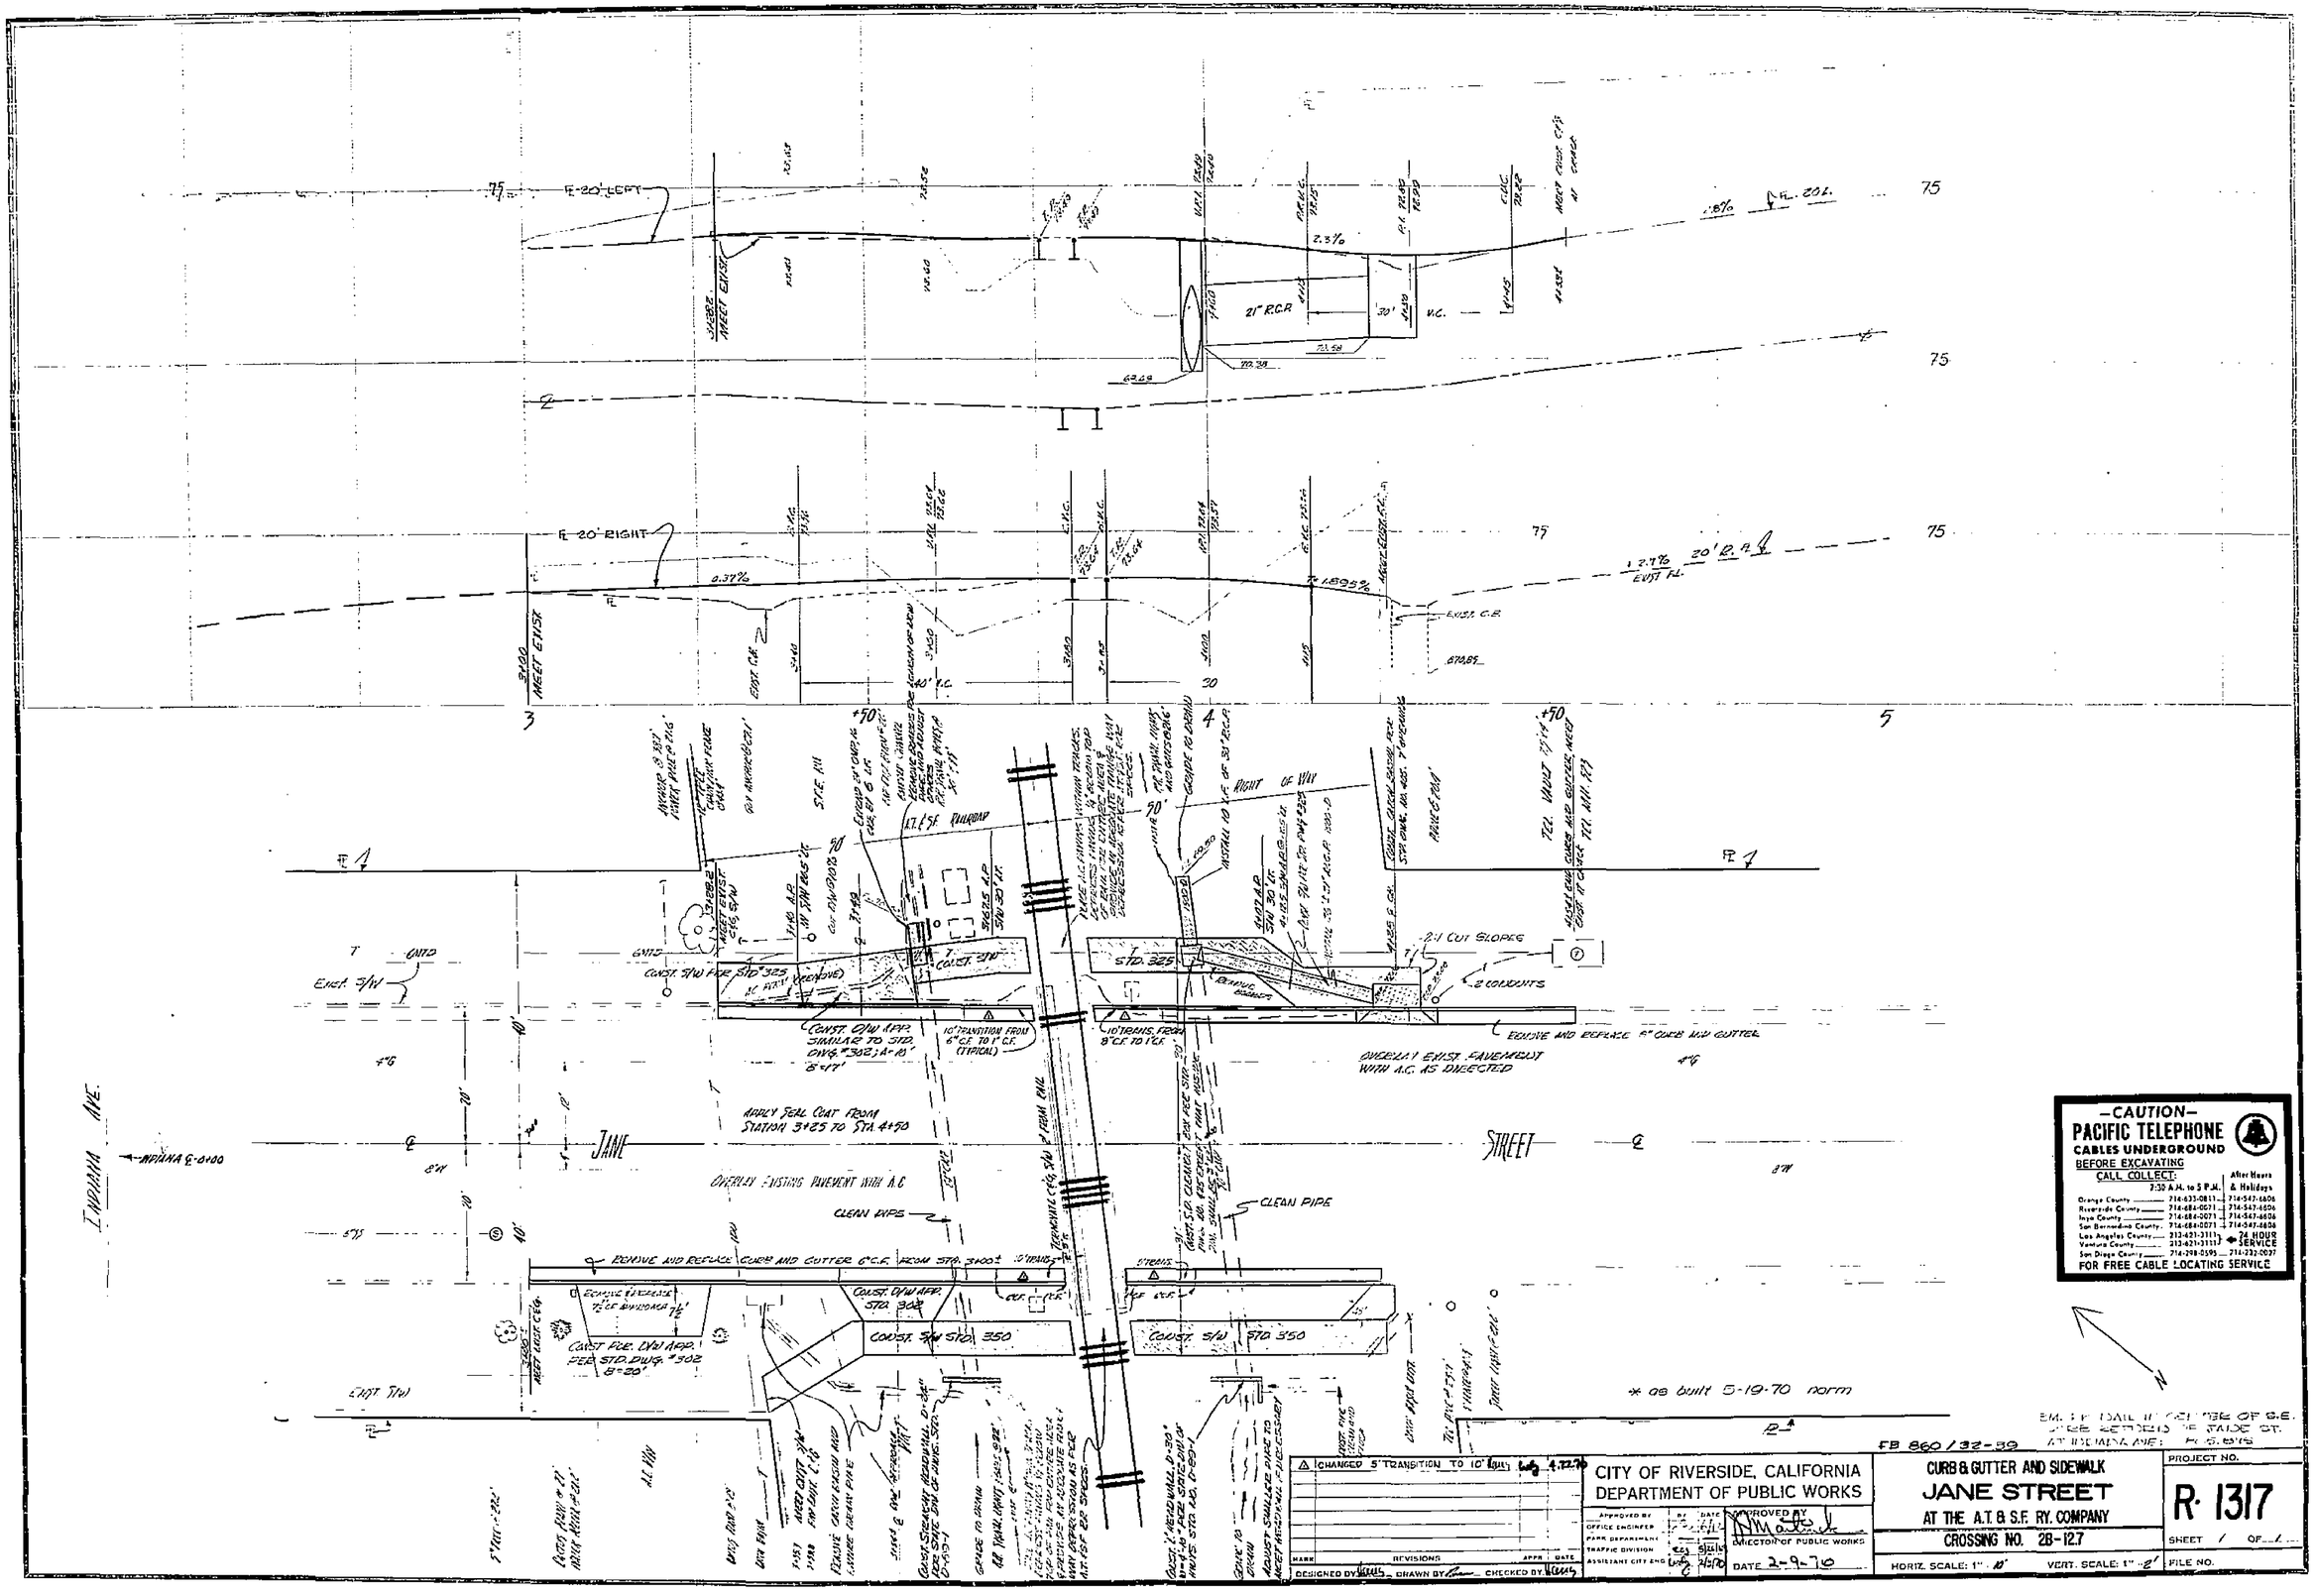

℄ 20' LEFT
℄ 20' RIGHT
21" R.C.P.
30' V.C.
2.3%
1.8%
℄ 20 L.
0.37%
1.895%
2.7%
20' R.P.
EXIST. F.L.
EXIST. C.B.
40' V.C.
3+00 MEET EXIST.
3+28.2 MEET EXIST.
RIGHT OF WAY
A.T.&S.F. RAILROAD
STD. 325
2:1 CUT SLOPES
2 CONDUITS
CONST. S/W
CONST. S/W FOR STD. 325
CONST. D/W APP. SIMILAR TO STD. DWG. #302; A=10' B=17'
10' TRANSITION FROM 6" C.F. TO 1" C.F. (TYPICAL)
10' TRANS. FROM 8" C.F. TO 1" C.F.
REMOVE AND REPLACE 8" CURB AND GUTTER
OVERLAY EXIST. PAVEMENT WITH A.C. AS DIRECTED
APPLY SEAL COAT FROM STATION 3+25 TO STA. 4+50
JANE
STREET
INDIANA AVE.
INDIANA ℄ 0+00
OVERLAY EXISTING PAVEMENT WITH A.C.
CLEAN PIPE
REMOVE AND REPLACE CURB AND GUTTER 6" C.F. FROM STA. 3+00±
CONST. D/W APP. STD. 302
CONST. S/W STD. 350
CONST. S/W STD. 350
CONST. FOR. D/W APP. PER STD. DWG. #302 B=20'
EXIST. S/W
* as built 5-19-70 norm
-CAUTION-
PACIFIC TELEPHONE
CABLES UNDERGROUND
BEFORE EXCAVATING
CALL COLLECT:
7:30 A.M. to 5 P.M.
After Hours & Holidays
Orange County 714-633-0811 714-547-6606
Riverside County 714-684-0071 714-547-6606
Inyo County 714-684-0071 714-547-6606
San Bernardino County 714-684-0071 714-547-6606
Los Angeles County 213-621-3111 24 HOUR SERVICE
Ventura County 213-621-3111
San Diego County 714-298-0595 714-232-0027
FOR FREE CABLE LOCATING SERVICE
FB 860 / 32-39
CHANGED 5' TRANSITION TO 10' Hours 4.22.70
CITY OF RIVERSIDE, CALIFORNIA
DEPARTMENT OF PUBLIC WORKS
APPROVED BY
OFFICE ENGINEER
PARK DEPARTMENT
TRAFFIC DIVISION
ASSISTANT CITY ENG
APPROVED BY
DIRECTOR OF PUBLIC WORKS
DATE 2-9-70
MARK REVISIONS APPR DATE
DESIGNED BY DRAWN BY CHECKED BY
CURB & GUTTER AND SIDEWALK
JANE STREET
AT THE A.T. & S.F. RY. COMPANY
CROSSING NO. 2B-12.7
HORIZ. SCALE: 1" = 10'
VERT. SCALE: 1" = 2'
PROJECT NO.
R-1317
SHEET 1 OF 1
FILE NO.