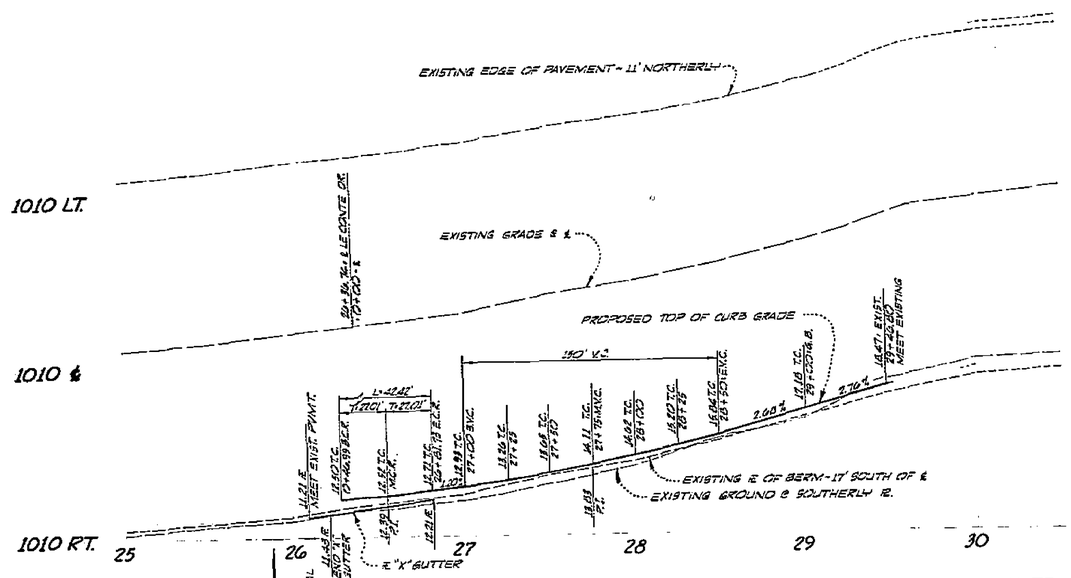

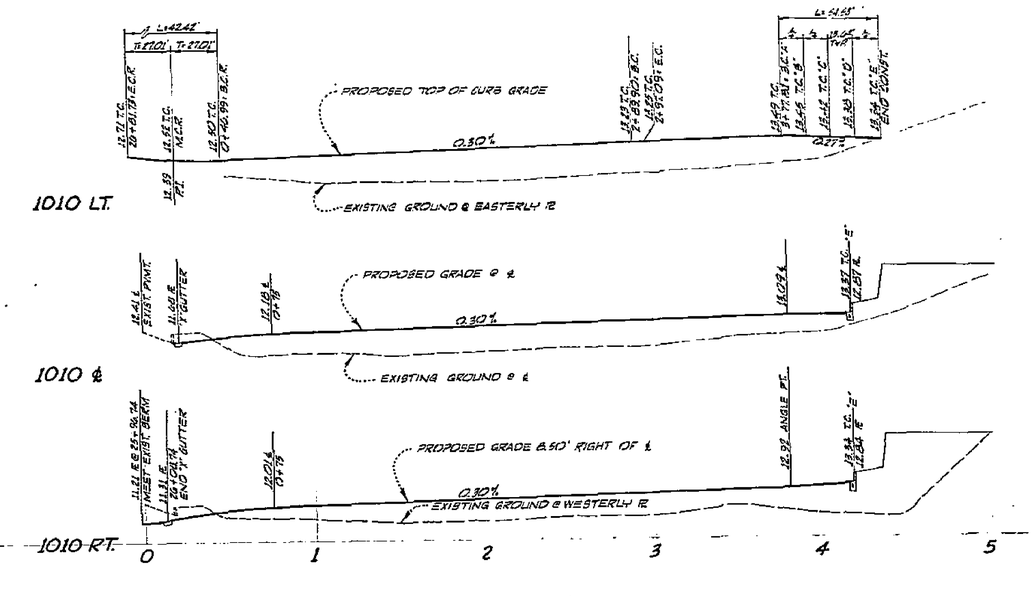

STREET SIGN SCHEDULE	
A	LE CONTE DRIVE VIA CAMPECHE

NOTE:

△ INDICATES ITEMS TO BE RELOCATED BY CONTRACTOR.

▲ INDICATES ITEMS TO BE RELOCATED BY CITY.

PALM TREES TO BE CENTERED BETWEEN BACK OF CURB AND SIDEWALK PER PARKS & REC. DEPT. SPECIFICATIONS.

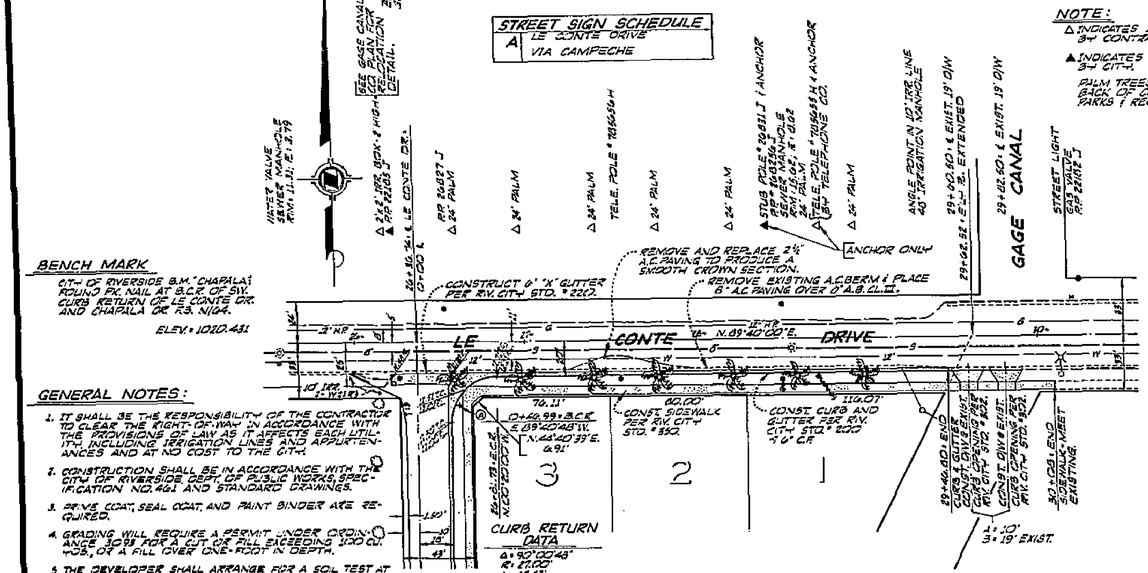

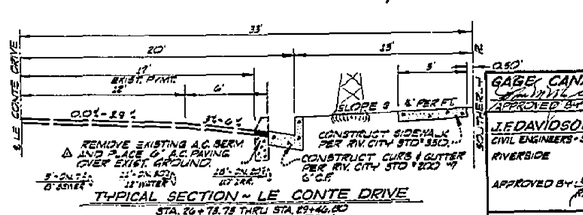

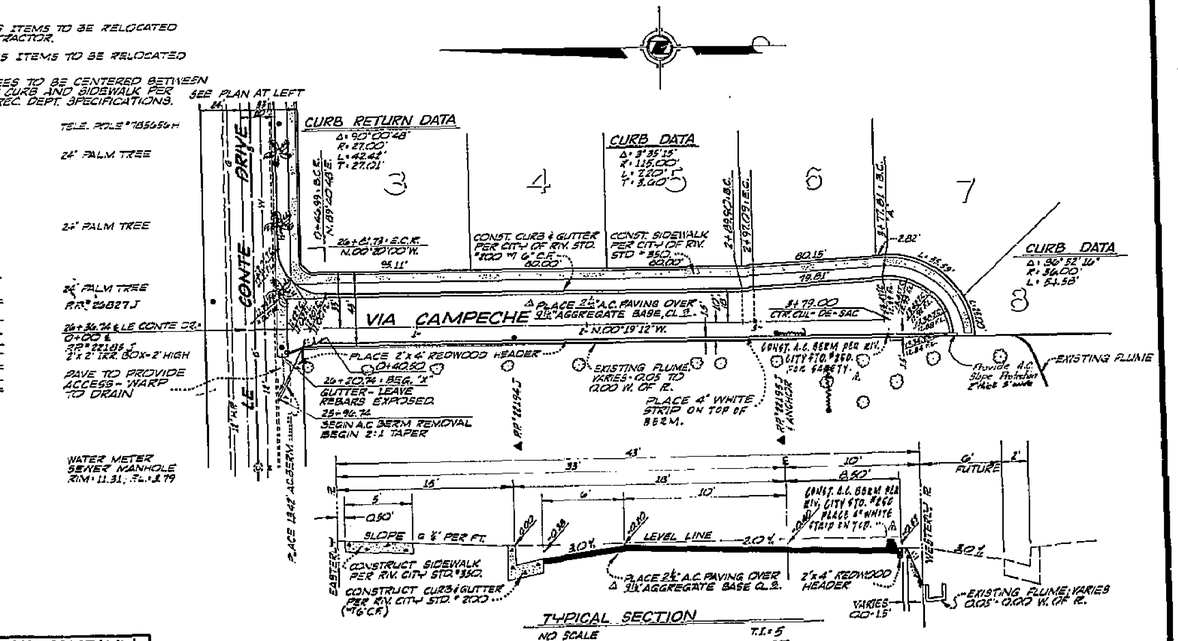

GAGE CANAL COMPANY
1/20/69
APPROVED BY DATE

J.E. DAVIDSON ASSOCIATES
CIVIL ENGINEERS • SURVEYORS • PLANNERS
RIVERSIDE — CALIFORNIA
APPROVED BY: RCE 17550 DATE

W.O. 1009 ROW: CAL FED. F.B. 1000/1-15

MARK	REVISIONS	APPR.	DATE
△	Added curb & base thickness		
△	Added beam per sheet 1-15-70		

DESIGNED BY RDD DRAWN BY RDD CHECKED BY

CITY OF RIVERSIDE, CALIFORNIA
DEPARTMENT OF PUBLIC WORKS

	BY	DATE
APPROVED BY		
OFFICE ENGINEER		
PARK DEPARTMENT		
TRAFFIC DIVISION		
ASSISTANT CITY ENG.		

APPROVED BY
DIRECTOR OF PUBLIC WORKS
DATE 2-10-69

PLAN & PROFILE
TRACT 3843
LE CONTE DRIVE
STA. 25+96.74 ~ STA. 30+00
VIA CAMPECHE
STA. 0+00 ~ STA. 3+79

HORIZ. SCALE: 1" = 40' VERT. SCALE: 1" = 4'

PROJECT NO. R-1331
SHEET 1 OF 1
FILE NO. 2735 J