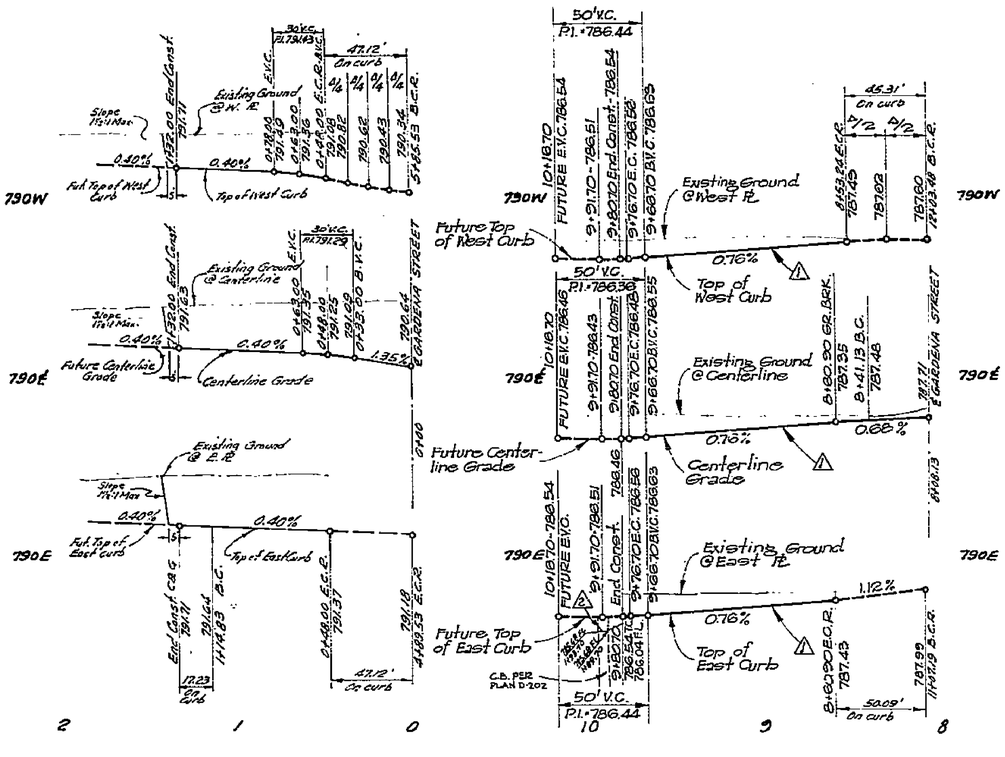

STREET SIGN SCHEDULE

A	GARDENA ST	4900
	MEADOWBROOK LN	6100
B	GARDENA ST	4900
	MEADOWBROOK LN	6200
C	GARDENA ST	4900
	EMERSON ST	4800
D	GARDENA ST	4800
	APPLETON ST	4800

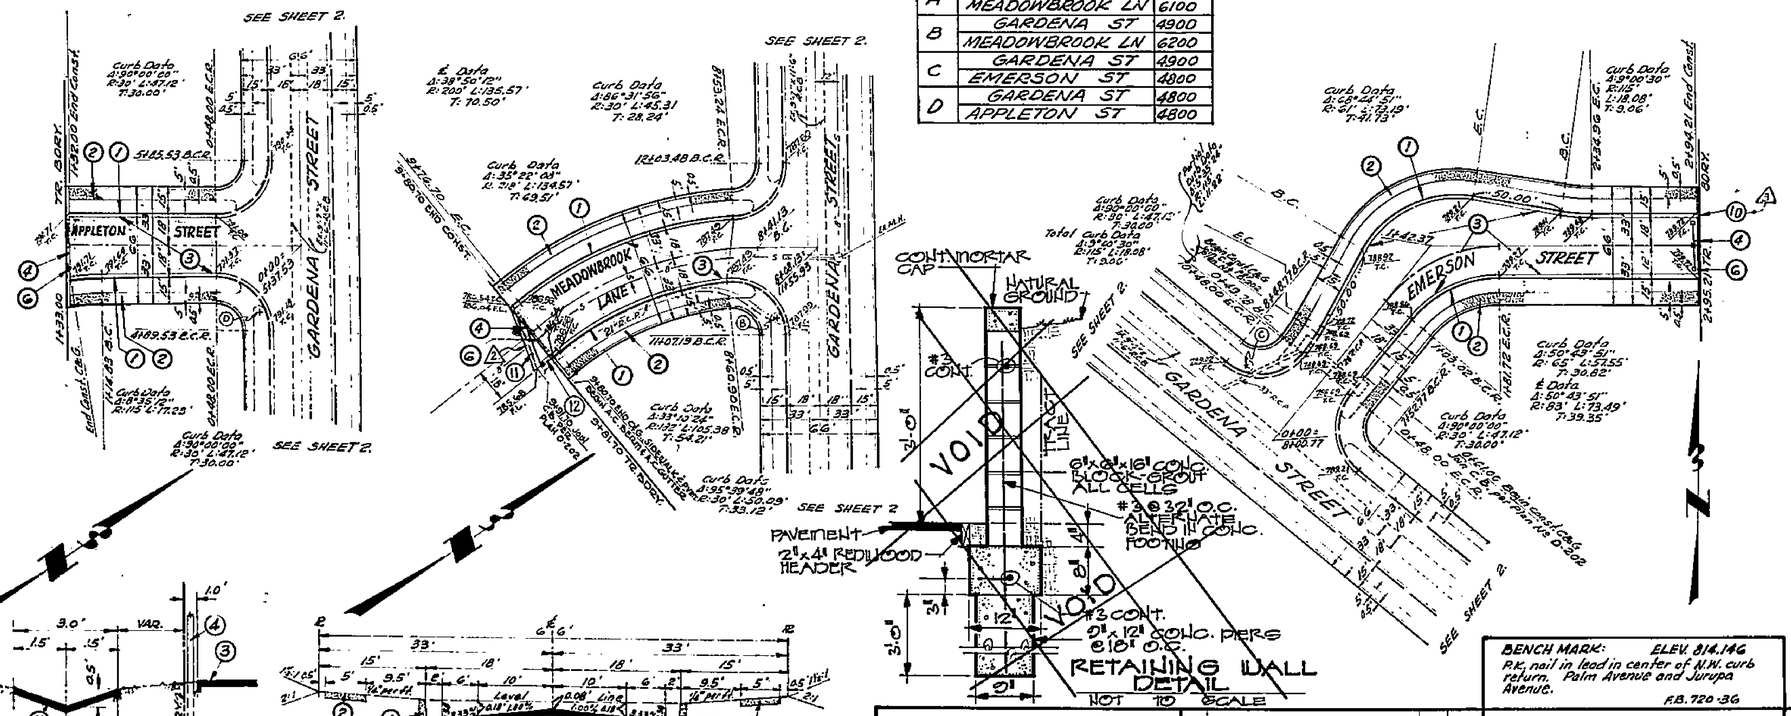

CONSTRUCTION NOTES

1. Construct curb and gutter Std. No. [illegible] "C.G."
2. Construct Sidewalk Std. No. 350 (5')
3. Construct 2-1 [illegible] A.C. with seal coat over 10" C.L. Ab
4. Construct Barricade Std. No. 50
5. Construct Asphalt Berm Std. No. 250 (1') C.F.
6. Construct 2" X 4" Redwood header
7. Pave Drainage Ditch per Details & Section A-A with 2" A.C.
8. Remove existing A.C. Berm
9. Remove temporary A.C. Pavement
10. Construct Conc. Block Retaining Wall Per City Std. No. 108 (3)
11. Construct 2" A.C. Paved "V" Shaped Ditch 4' wide per Sect. B-B
12. Construct A.C. Berm and 2" A.C. Gutter

GENERAL NOTES

1. [illegible]
2. Construction shall conform to [illegible] Standard Specifications for Public Works Construction, [illegible] Edition, and Standard Plans for Public Works Construction, [illegible] Edition.
3. Prior to any excavation, contact Underground Service Alert (USA) at 1-800-422-4133. Three working days notification is required before excavation. Excavation for trench backfill exceeding 150 cubic yards or trenches deeper than five feet shall be performed according to Construction Safety Orders issued by the Division of Industrial Safety. 
4. [illegible]
5. Construction Details [illegible] Standard Plans for Public Works Construction, [illegible] Edition.
6. Contractor shall call "Traffic Division" for above ground [illegible] prior to construction.
7. Driveway approaches [illegible] Standard Plan No. 207 and Drawing No. 372
8. [illegible] Standard Plan No. 403
9. Drainage [illegible] S-783 as directed by [illegible] Public Works Department.

BENCH MARK: ELEV. 814.146
P.K. nail in lead in center of N.W. curb return, Palm Avenue and Jurupa Avenue.
F.B. 720-36

TECHNOLOGICAL ENGINEERING CORP.
4921 DURFEE AVE., PICO RIVERA, CALIF.
699-1043 723-8891
J.A. PATTERSON R.C.E. 10410 DATE 5-14-61

MARK	REVISIONS	APP'D	DATE
A	Revised Const. Note No. 10 & Void Retaining Wall Detail Sht. 2	T.W.P.	3-13-62
	Widen pavement at [illegible]		
A	Added C.B. & Paved Ditch-Meadowbrook Ln.	T.W.P.	7-25-62
A	Revised Grades-Meadowbrook Lane	T.W.P.	7-25-62

DESIGNED BY A.S.L. DRAWN BY A.S.L. CHECKED BY T.W.P.

CITY OF RIVERSIDE, CALIFORNIA
DEPARTMENT OF PUBLIC WORKS

APPROVED BY	BY	DATE
OFFICE ENGINEER		
PARK DEPARTMENT		
TRAFFIC DIVISION		
ASSISTANT CITY ENG.		

APPROVED BY: [illegible]
DIRECTOR OF PUBLIC WORKS
DATE

STREET PLAN AND PROFILE
APPLETON STREET
From Gardena Street to 133.5'±'ly thereof,
MEADOWBROOK LANE
From Gardena Street to 1735' ±'ly thereof,
EMERSON STREET
From Gardena Street to 2952'±'NE'ly thereof,
TRACT NO. 3915

HORIZ. SCALE: 1" = 40' VERT. SCALE: 1" = 4'

PROJECT NO. R-1401
SHEET 1 OF 3
FILE NO.

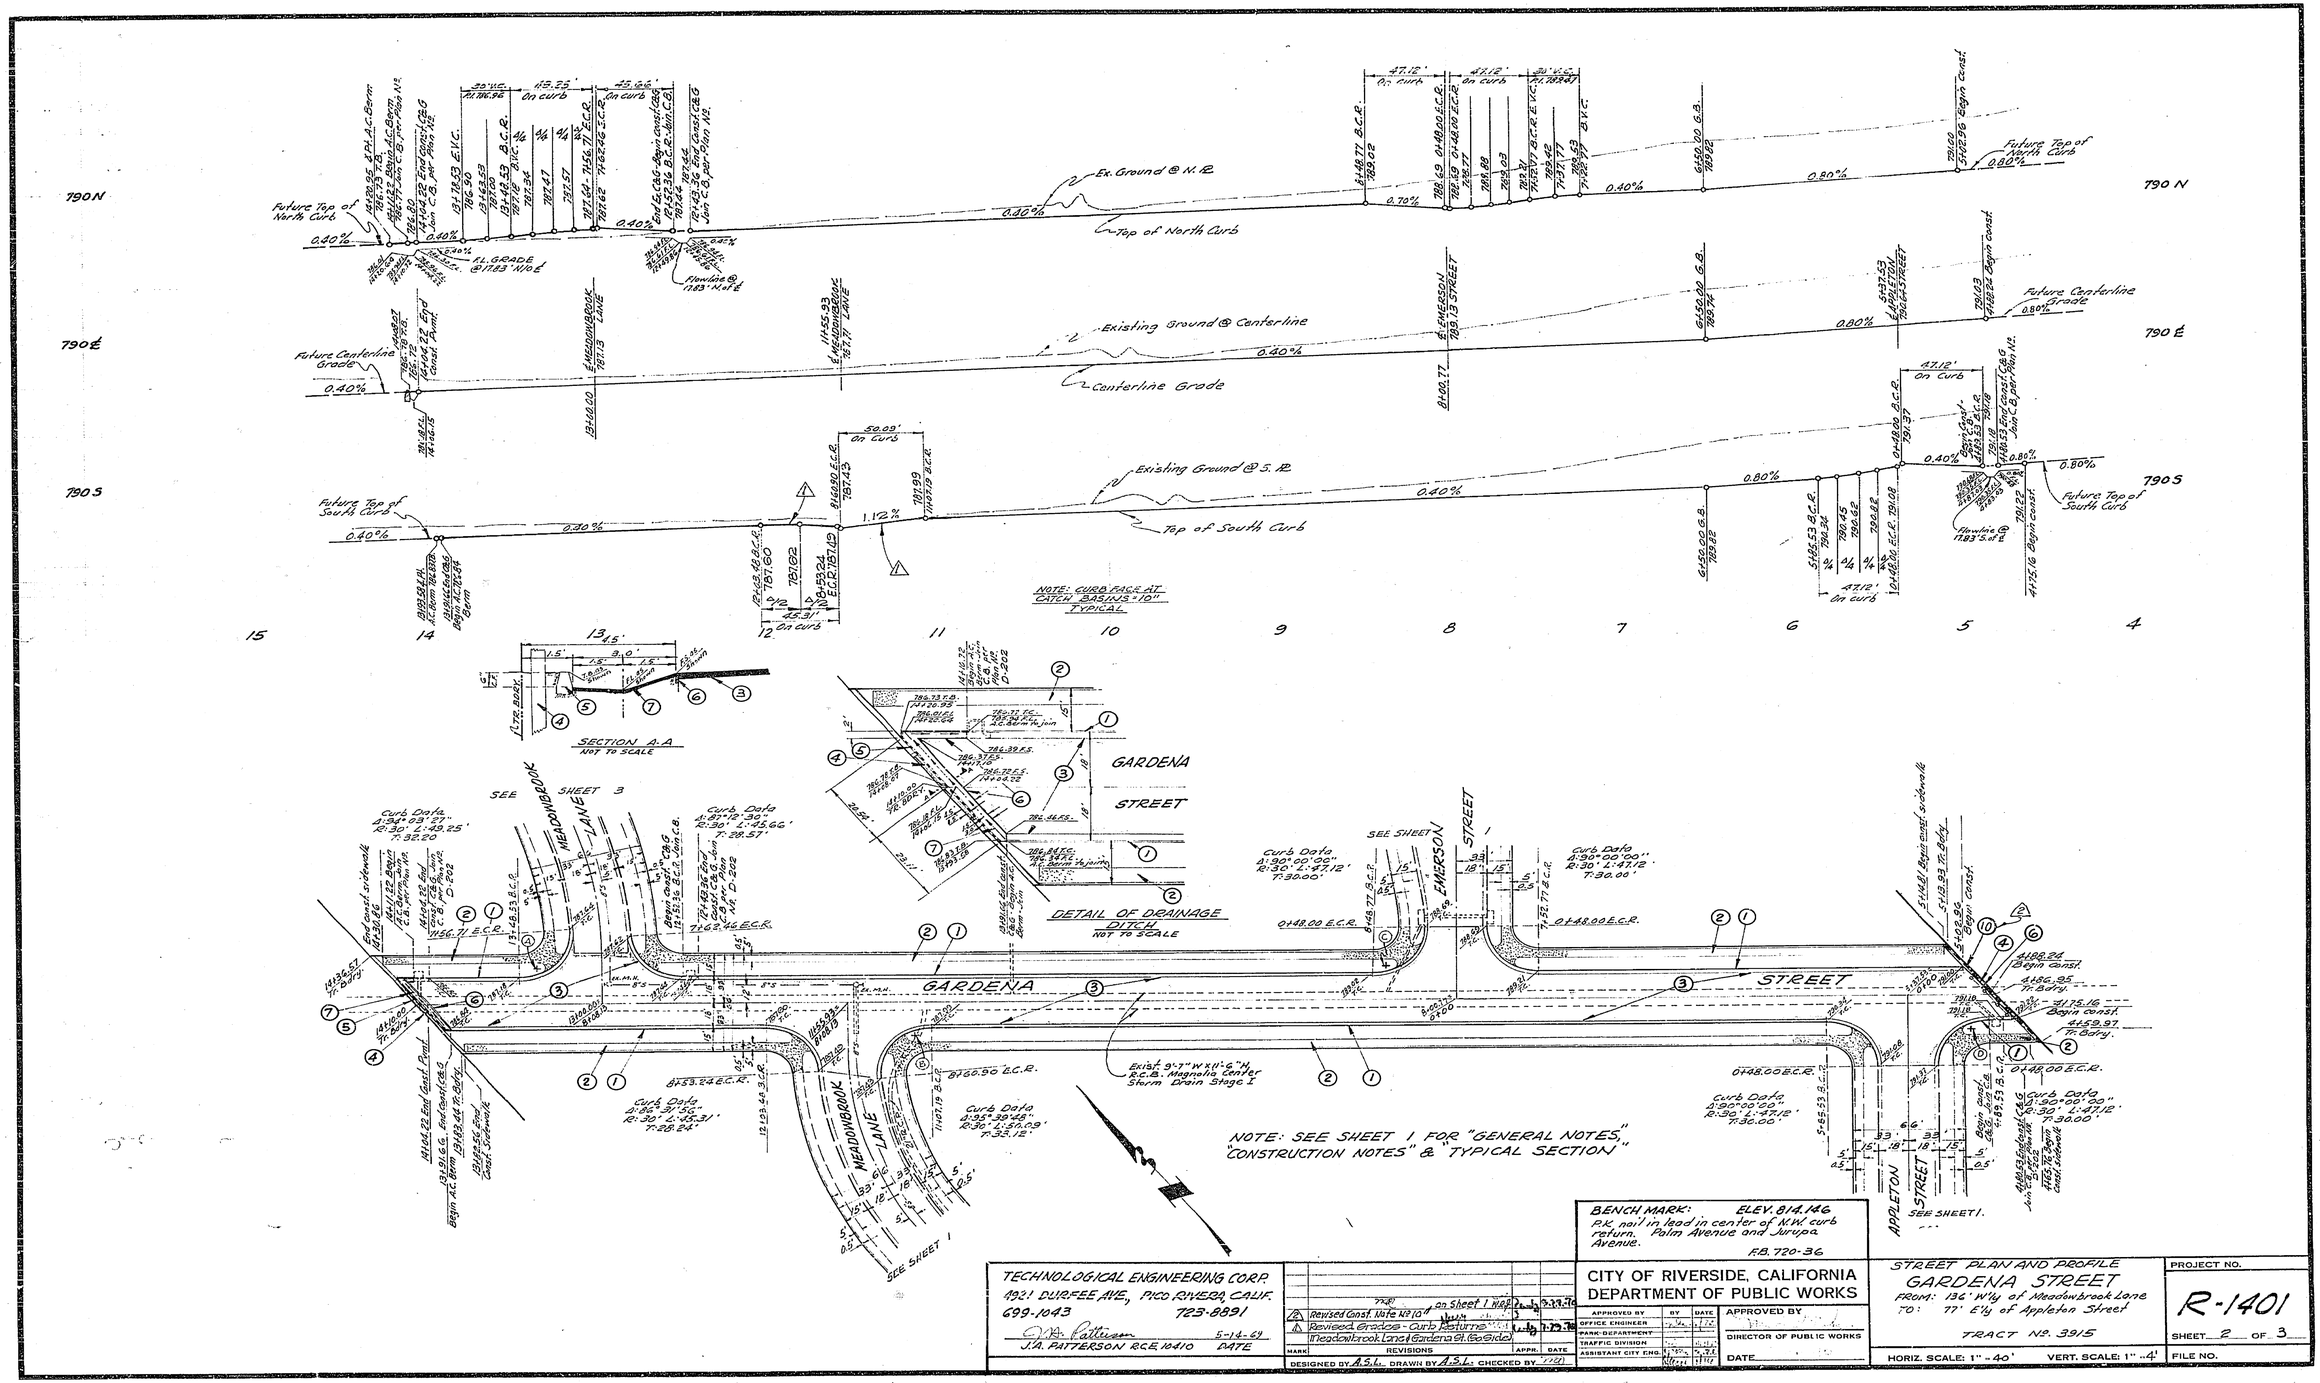

BENCH MARK: ELEV. 814.146
P.K. nail in lead in center of N.W. curb return. Palm Avenue and Jurupa Avenue.
R.B. 720-36

TECHNOLOGICAL ENGINEERING CORP.
4921 DURFEE AVE., PICO RIVERA, CALIF.
699-1043 723-8891
J.A. Patterson 5-14-61
J.A. PATTERSON RCE 10410 DATE

MARK	REVISIONS	APPR.	DATE
1	Revised Grades - Curb Returns at Meadowbrook Lane & Gardena Pl. & Gardena St. & Eastside		7-25-61

DESIGNED BY A.S.L. DRAWN BY A.S.L. CHECKED BY

CITY OF RIVERSIDE, CALIFORNIA
DEPARTMENT OF PUBLIC WORKS

	BY	DATE
APPROVED BY OFFICE ENGINEER		
PARK DEPARTMENT		
TRAFFIC DIVISION		
ASSISTANT CITY ENG.		

APPROVED BY
DIRECTOR OF PUBLIC WORKS
DATE

STREET PLAN AND PROFILE
GARDENA STREET
FROM: 136' W'ly of Meadowbrook Lane
TO: 77' E'ly of Appleton Street
TRACT NO. 3915

HORIZ. SCALE: 1" = 40' VERT. SCALE: 1" = 4'

PROJECT NO. R-1401
SHEET 2 OF 3
FILE NO.

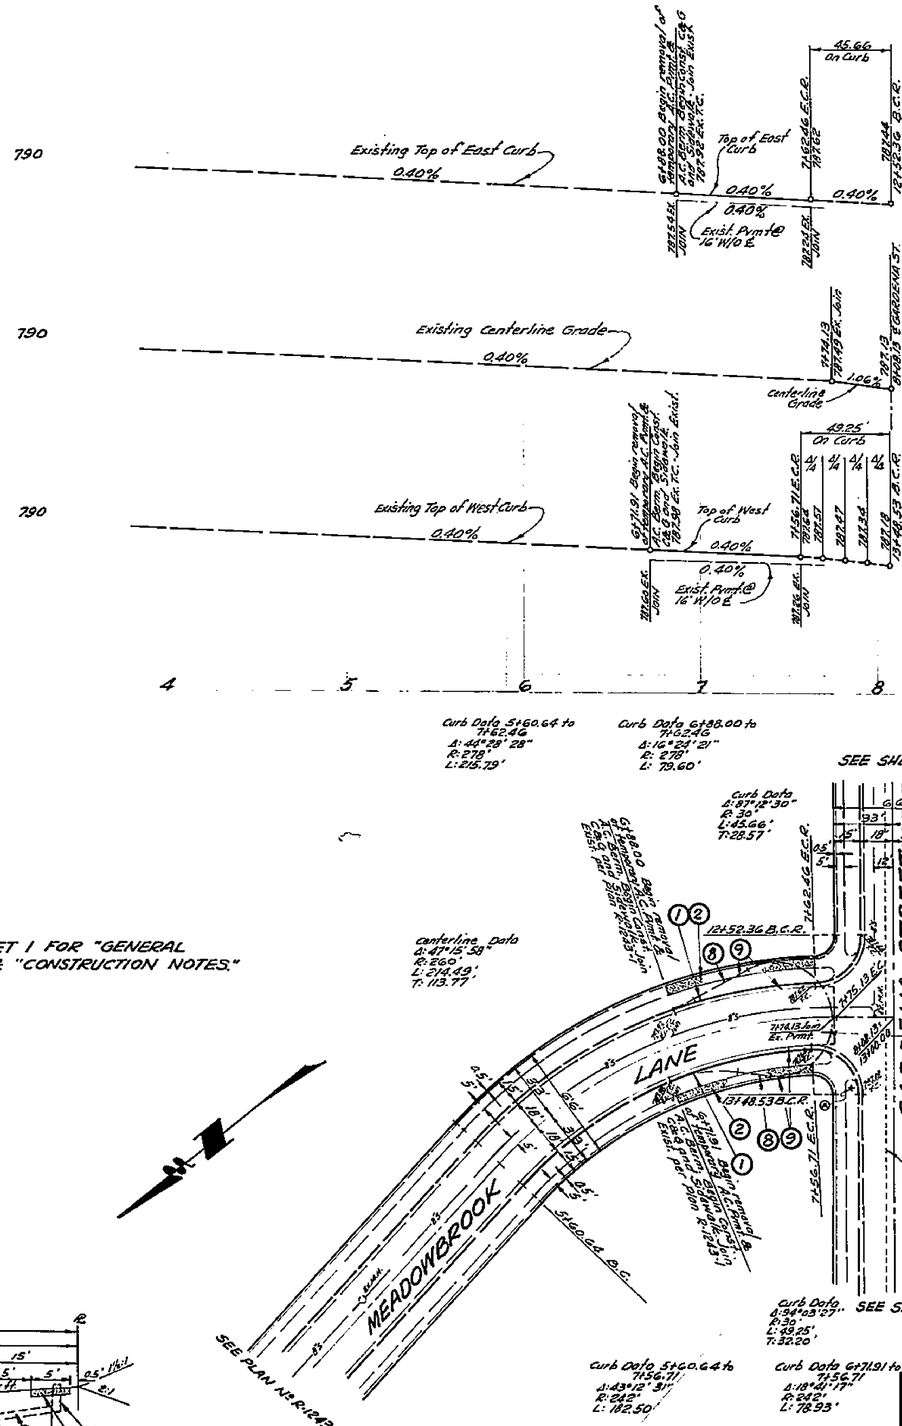

Curb Data St 60.64 to 7+62.46
Δ: 44°29' 28"
R: 278'
L: 215.79'

Curb Data St 98.00 to 7+62.46
Δ: 16°24' 21"
R: 270'
L: 79.60'

SEE SHEET 2

Curb Data
Δ: 87°18' 30"
R: 30'
L: 45.66'
T: 28.57'

NOTE: SEE SHEET 1 FOR "GENERAL NOTES" & "CONSTRUCTION NOTES."

centerline Data
Δ: 41°15.58"
R: 260'
L: 214.49'
T: 113.77'

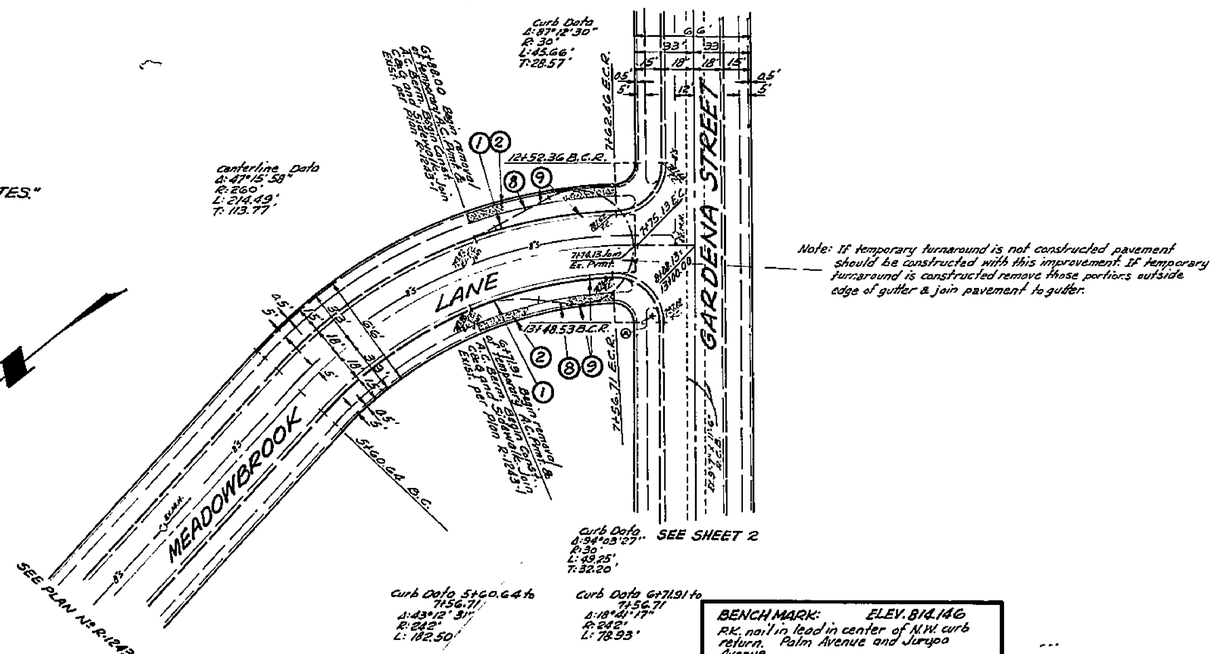

Note: If temporary turnaround is not constructed pavement should be constructed with this improvement. If temporary turnaround is constructed remove those portions outside edge of gutter & join pavement to gutter.

Curb Data St 60.64 to 7+56.71
Δ: 43°12' 31"
R: 242'
L: 182.50'

Curb Data St 71.91 to 7+56.71
Δ: 18°21' 17"
R: 242'
L: 78.93'

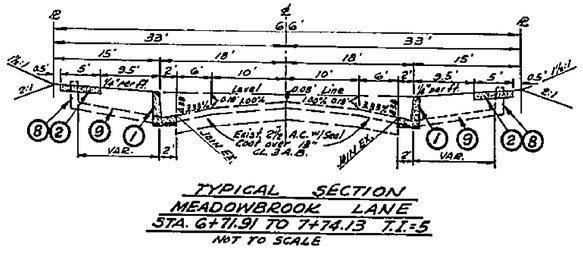

TYPICAL SECTION
MEADOWBROOK LANE
STA. 6+71.91 TO 7+74.13 T.I.=5
NOT TO SCALE

BENCH MARK: ELEV. 814.146
RK. nail in lead in center of N.W. curb return. Palm Avenue and Jurupa Avenue.
F.B. 720-36

TECHNOLOGICAL ENGINEERING CORP.
4921 DURFEE AVE., PICO RIVERA, CALIF.
699-1043 723-8891
J.A. Patterson 6-17-69
J.A. PATTERSON R.C.E. 10410 DATE

MARK	REVISIONS	APPR.	DATE

DESIGNED BY A.S.C. DRAWN BY A.S.C. CHECKED BY J.A.P.

CITY OF RIVERSIDE, CALIFORNIA
DEPARTMENT OF PUBLIC WORKS

APPROVED BY	BY	DATE
OFFICE ENGINEER		
PARK DEPARTMENT		
TRAFFIC DIVISION		
ASSISTANT CITY ENGINEER		

APPROVED BY _____ DIRECTOR OF PUBLIC WORKS
DATE 1-6-70

STREET PLAN AND PROFILE
MEADOWBROOK LANE
FROM: GARDENA STREET
TO: 136'± N'LY OF GARDENA STREET
TRACT No. 3915

HORIZ. SCALE: 1" = 40' VERT. SCALE: 1" = 4'

PROJECT NO. R-1401
SHEET 3 OF 3
FILE NO.