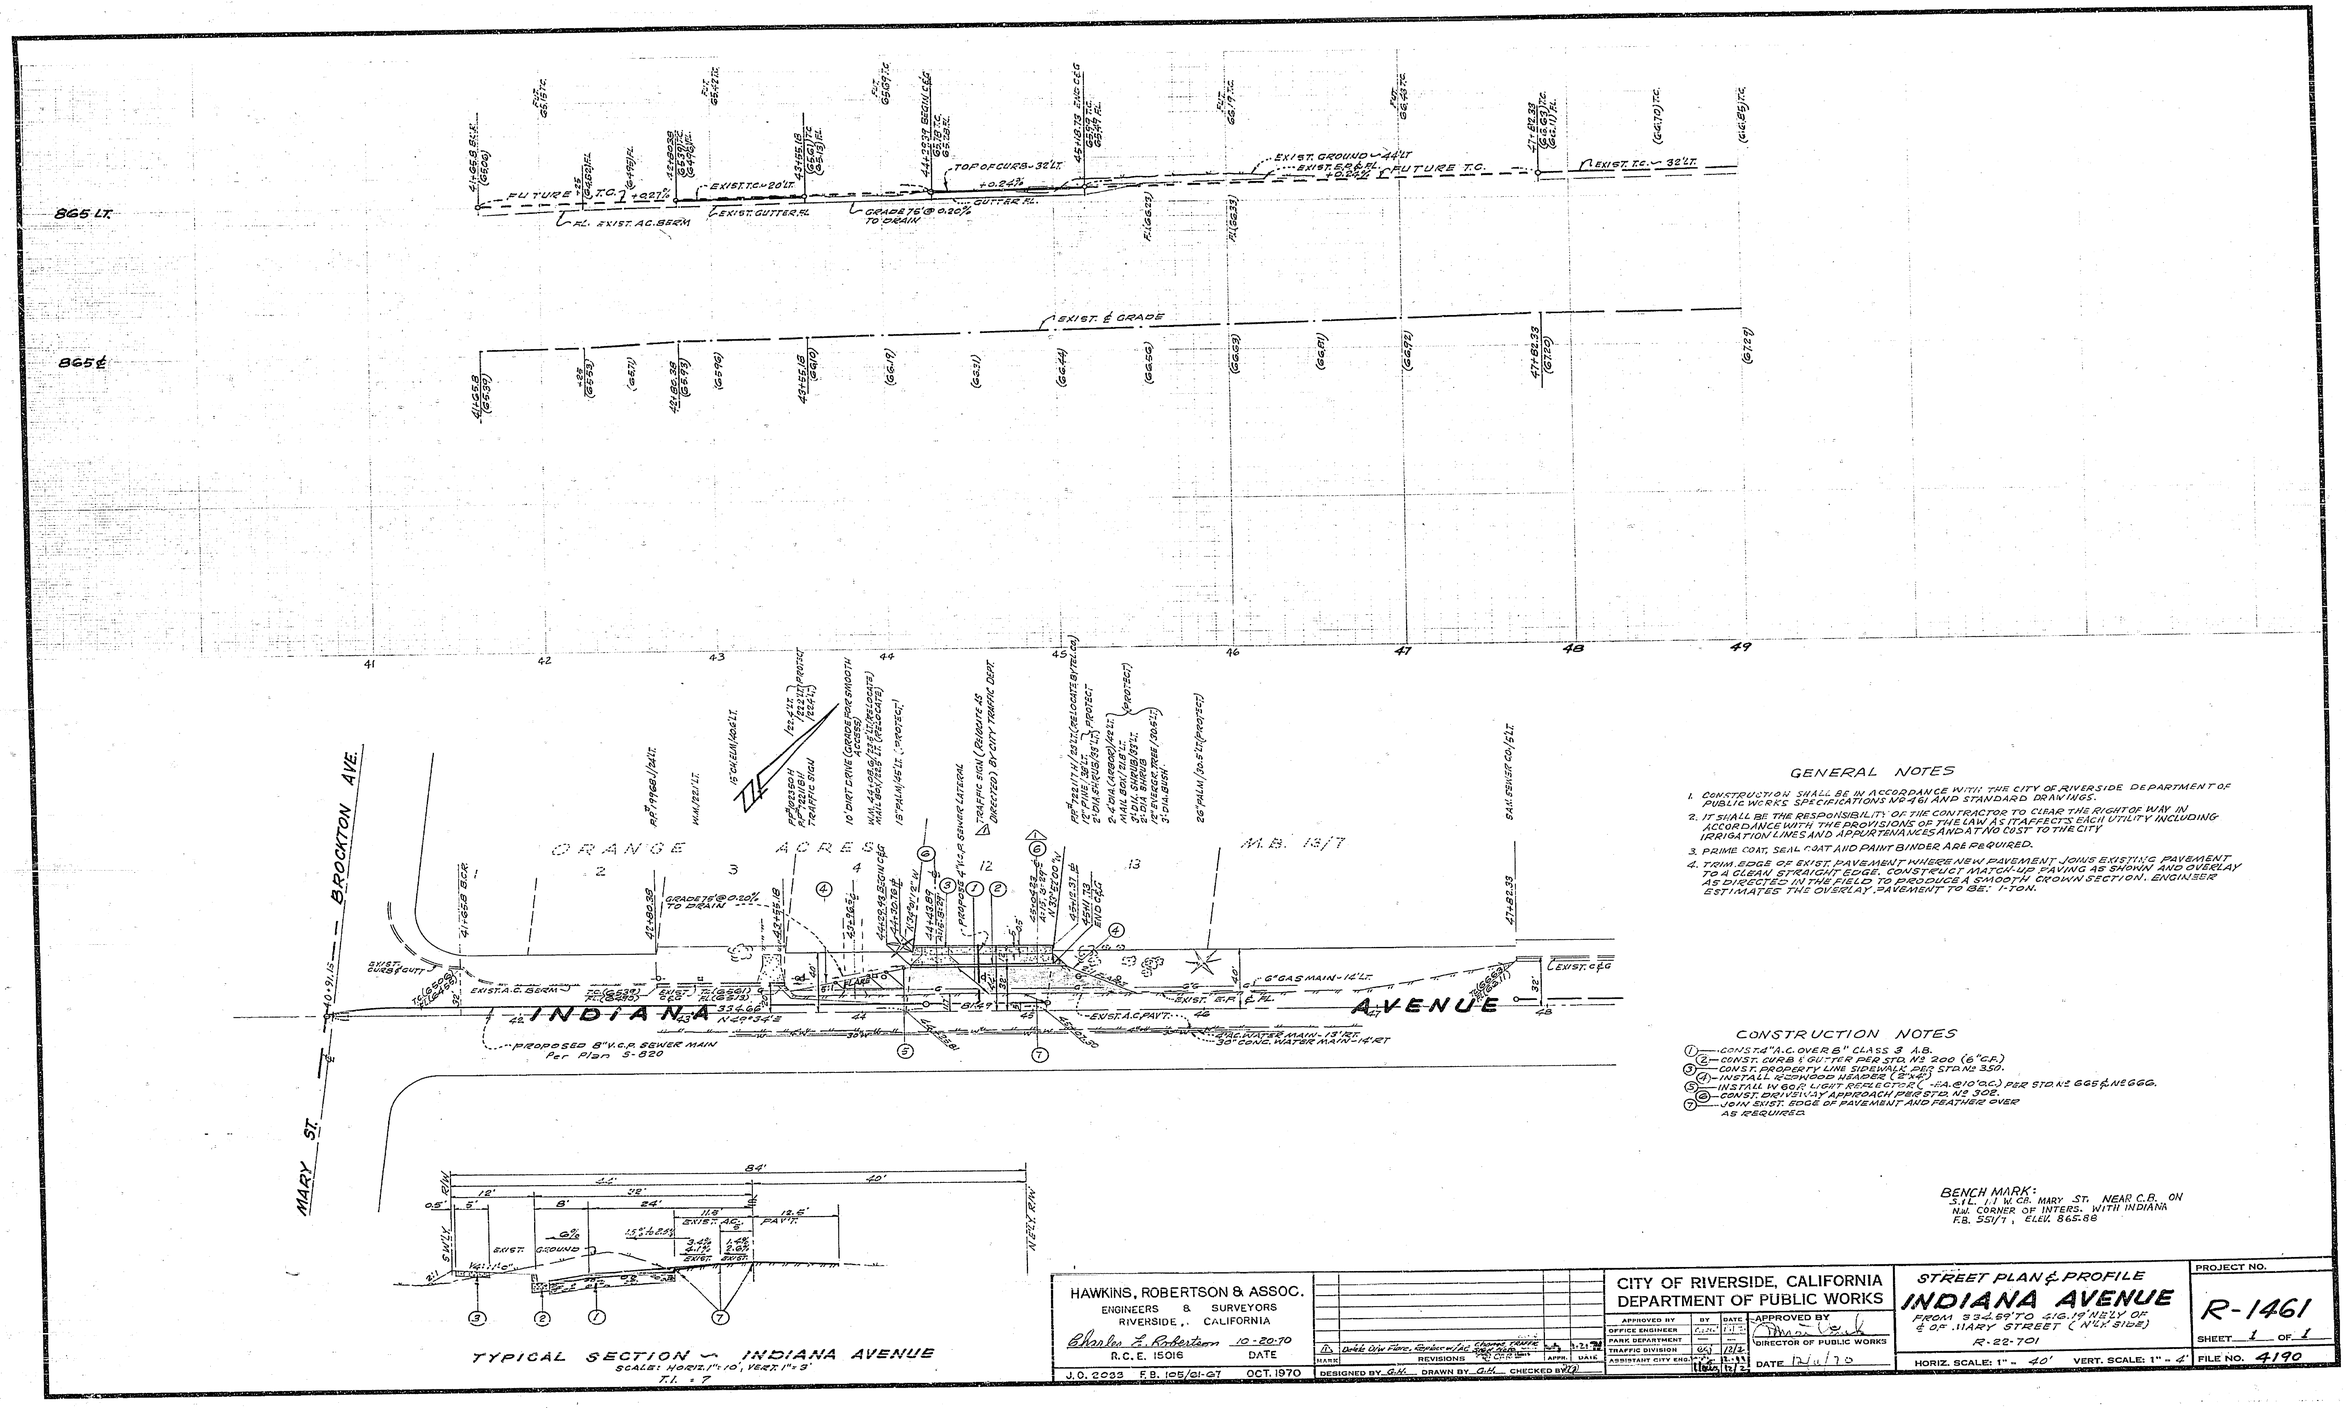

TYPICAL SECTION ~ INDIANA AVENUE
SCALE: HORIZ. 1" = 10', VERT. 1" = 3'
T.I. = 7

GENERAL NOTES

1. CONSTRUCTION SHALL BE IN ACCORDANCE WITH THE CITY OF RIVERSIDE DEPARTMENT OF PUBLIC WORKS SPECIFICATIONS Nº 461 AND STANDARD DRAWINGS.
2. IT SHALL BE THE RESPONSIBILITY OF THE CONTRACTOR TO CLEAR THE RIGHT OF WAY IN ACCORDANCE WITH THE PROVISIONS OF THE LAW AS IT AFFECTS EACH UTILITY INCLUDING IRRIGATION LINES AND APPURTENANCES AND AT NO COST TO THE CITY.
3. PRIME COAT, SEAL COAT AND PAINT BINDER ARE REQUIRED.
4. TRIM EDGE OF EXIST. PAVEMENT WHERE NEW PAVEMENT JOINS EXISTING PAVEMENT TO A CLEAN, STRAIGHT EDGE. CONSTRUCT MATCH-UP PAVING AS SHOWN AND OVERLAY AS DIRECTED IN THE FIELD TO PRODUCE A SMOOTH CROWN SECTION. ENGINEER ESTIMATES THE OVERLAY PAVEMENT TO BE: 1-TON.

CONSTRUCTION NOTES

1. CONST. 4" A.C. OVER 8" CLASS 3 A.B.
2. CONST. CURB & GUTTER PER STD. Nº 200 (6" C.F.)
3. CONST. PROPERTY LINE SIDEWALK PER STD. Nº 350.
4. INSTALL REDWOOD HEADER (2"x6")
5. INSTALL W 60 R. LIGHT REFLECTORS (1 EA. @ 10' O.C.) PER STD. Nº 665 & NE 666.
6. CONST. DRIVEWAY APPROACH PER STD. Nº 302.
7. JOIN EXIST. EDGE OF PAVEMENT AND FEATHER OVER AS REQUIRED.

BENCH MARK:
S.I.L. 11 W. CR. MARY ST. NEAR C.B. ON N.W. CORNER OF INTERS. WITH INDIANA
F.B. 551/7, ELEV. 865.68

HAWKINS, ROBERTSON & ASSOC.
ENGINEERS & SURVEYORS
RIVERSIDE, CALIFORNIA
Charles E. Robertson 10-20-70
R.C.E. 15016 DATE

J.O. 2093 F.B. 105/21-27 OCT. 1970

MARK	REVISIONS	APPR.	DATE
1	Add Cir Fibro Reflector w/ Hi Chapel Traffic Paint Stripe		12-21-70

DESIGNED BY G.H. DRAWN BY G.H. CHECKED BY

CITY OF RIVERSIDE, CALIFORNIA
DEPARTMENT OF PUBLIC WORKS

APPROVED BY	BY	DATE
OFFICE ENGINEER		
PARK DEPARTMENT		
TRAFFIC DIVISION		12/2
ASSISTANT CITY ENG.		12-11

APPROVED BY
DIRECTOR OF PUBLIC WORKS
DATE 12/1/70

STREET PLAN & PROFILE
INDIANA AVENUE
FROM 334.69' TO 216.19' N'ELY OF ℄ OF MARY STREET (N'LY SIDE)
R-22-701

HORIZ. SCALE: 1" = 40' VERT. SCALE: 1" = 4'

PROJECT NO. R-1461
SHEET 1 OF 1
FILE NO. 4190