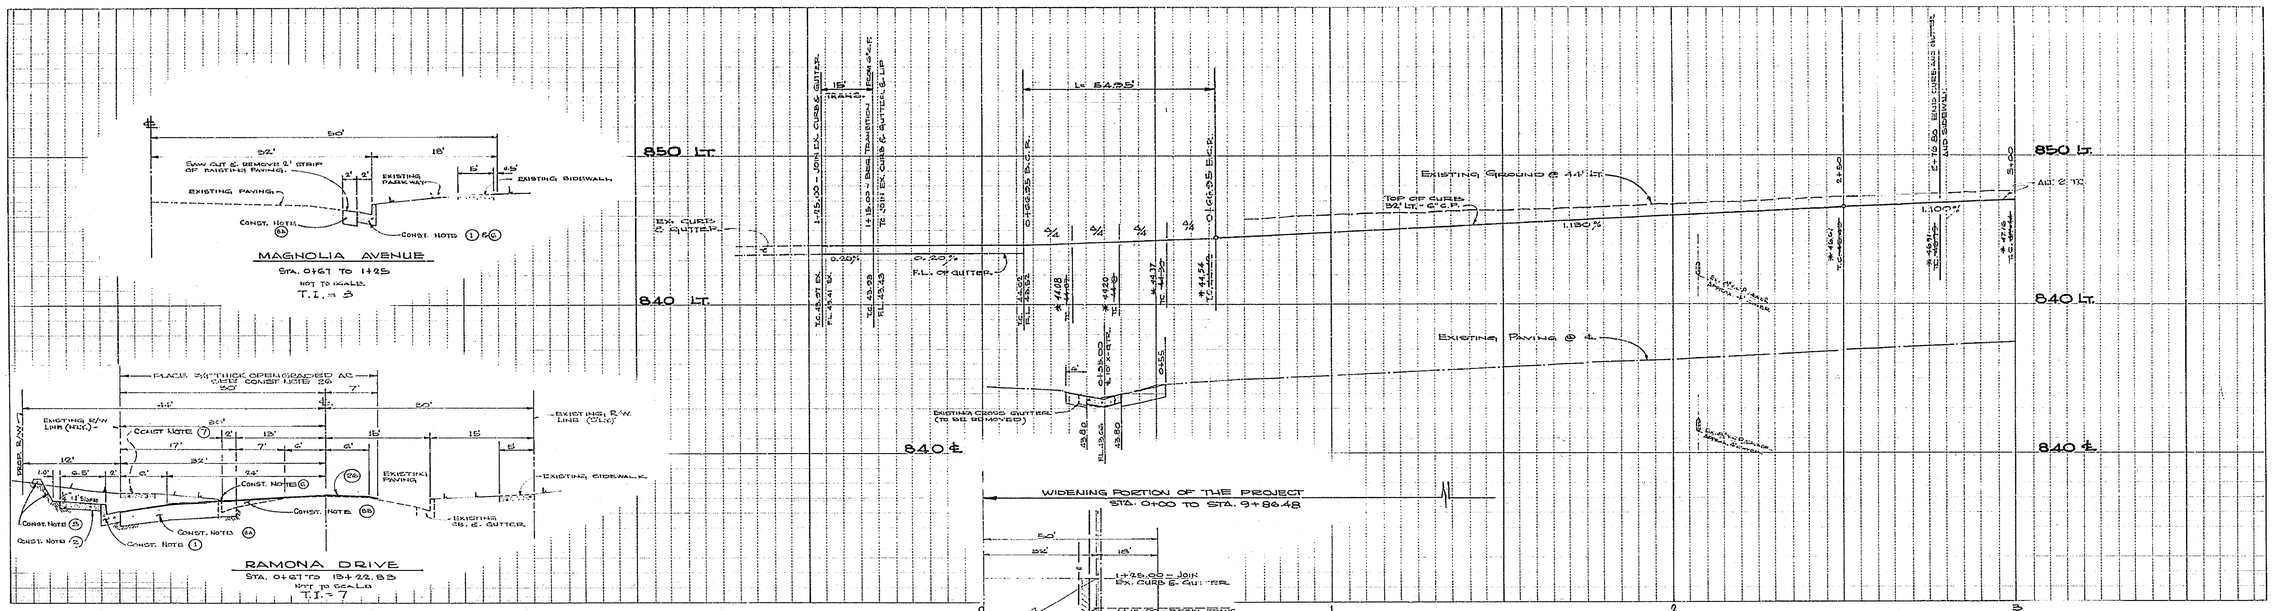
MAGNOLIA AVENUE
STA. 0+67 TO 14+25
NOT TO SCALE
T.I. = 5
RAMONA DRIVE
STA. 0+67 TO 15+22.85
NOT TO SCALE
T.I. = 7
PLACE ¾" THICK OPEN GRADED AC OVER CONST NOTE 22
EXISTING R/W LINE (TYP.)
EXIST'NG. R/W LINE (TYP.)
CONST NOTE 7
EXISTING PAVING
EXISTING SIDEWALK
EXISTING C.I.P. GUTTER
CONST NOTES 25, 22, 1, 6A, 6B, 6C
EXISTING CROSS GUTTER (TO BE REMOVED)
850 Lt.
840 Lt.
840 ±
L= 54.95'
1-15.00 - JOIN EX. CURB & GUTTER
15' TRANS.
1+15.00 - BEGIN TRANSITION / BEGIN 4"-6" TO JOIN EX. CURB & GUTTER, 6" TYP.
0+32.55 B.C.R.
0+46.05 E.C.R.
EX. CURB & GUTTER
P.L. OF GUTTER
EXISTING GROUND @ 4+1 Lt.
TOP OF CURB 52' Lt. - C.I.P.
EXISTING PAVING @ 4
1.192'/'
1.100'/'
AUG. 2 '70
EXIST'G. 12" W.L.
EXIST'G. 8" W.L.
EXIST'G. 8" SEWER
EXIST'G. 6" W.L.
EXIST'G. 8" W.L.
EXIST'G. 12

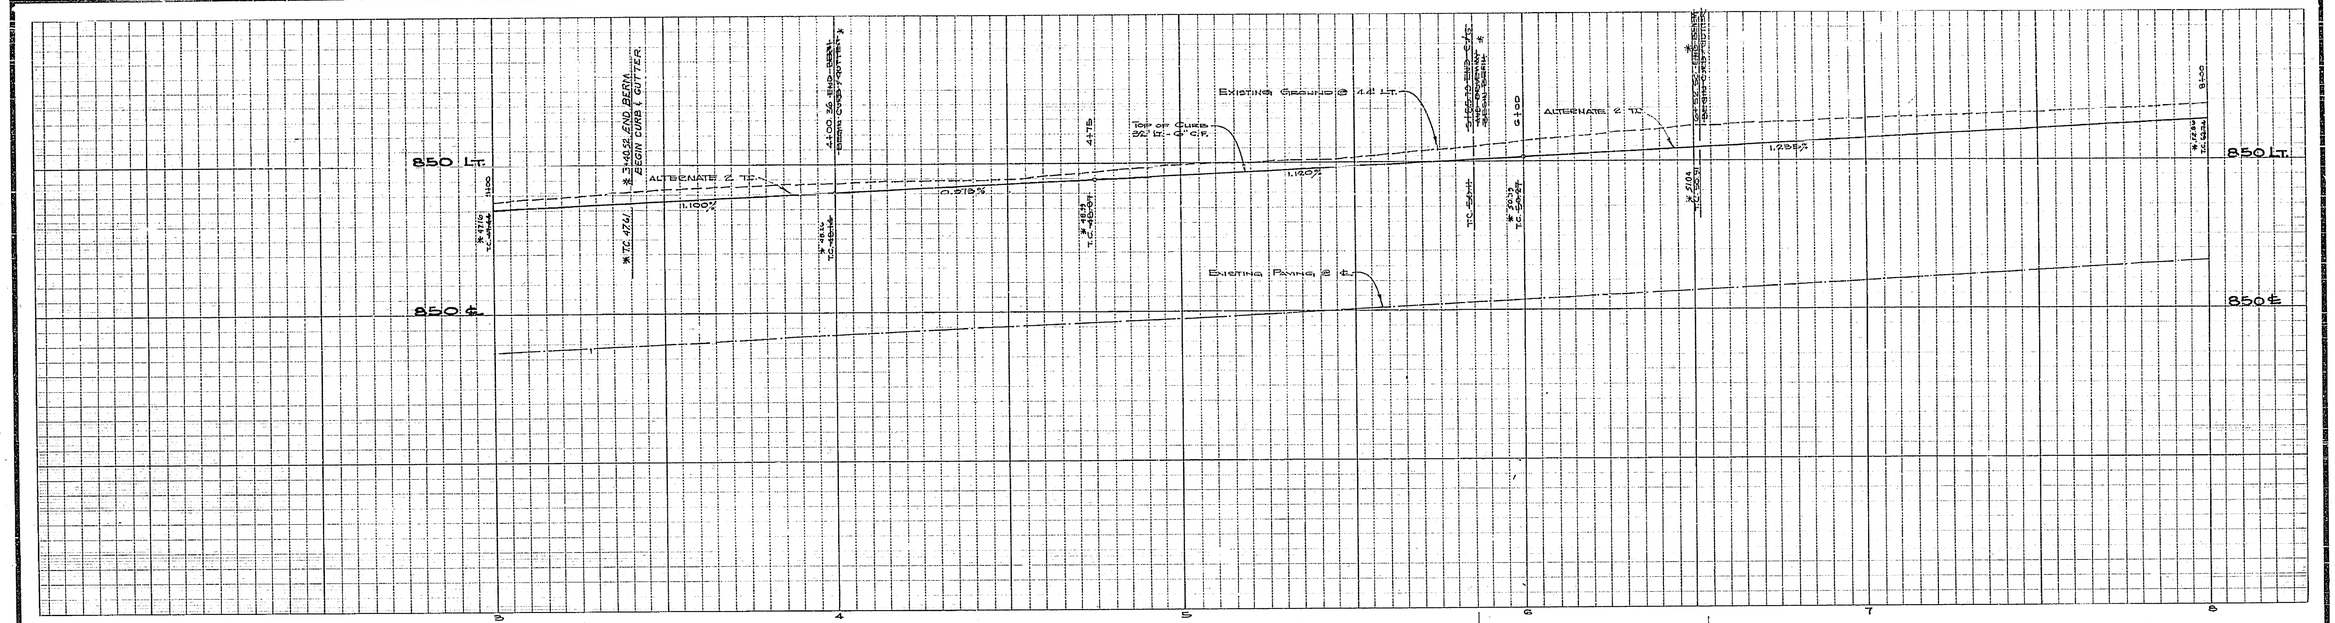

Bench Marks:

I. City of Riverside B.M. Brass disk in west curb Magnolia Ave., opposite north leg curb of south drive Fairfax Ave. City of Riv. F.B.# 521/64 - Elev. 842.793.

II. Nail in conc. under city cap on ℄ intersection of Ramona Drive & Riverside Ave. City of Riv. F.B.# 521/25 - Elev. 855.206.

III. PK nail in conc. porch at rear of cosmetology bldg. @ Olivewood & Cridge St. - Elev. 850.50.

Alternate 1: Construct AC driveway where shown on plan and construct berm per section below.

Alternate 2: Construct per Ramona Drive section sta 7 to 15+22 with a street light at 3+62.

Alternate 1 and Alternate 2 see notes at sta 2+76.50 to 4+00.30.

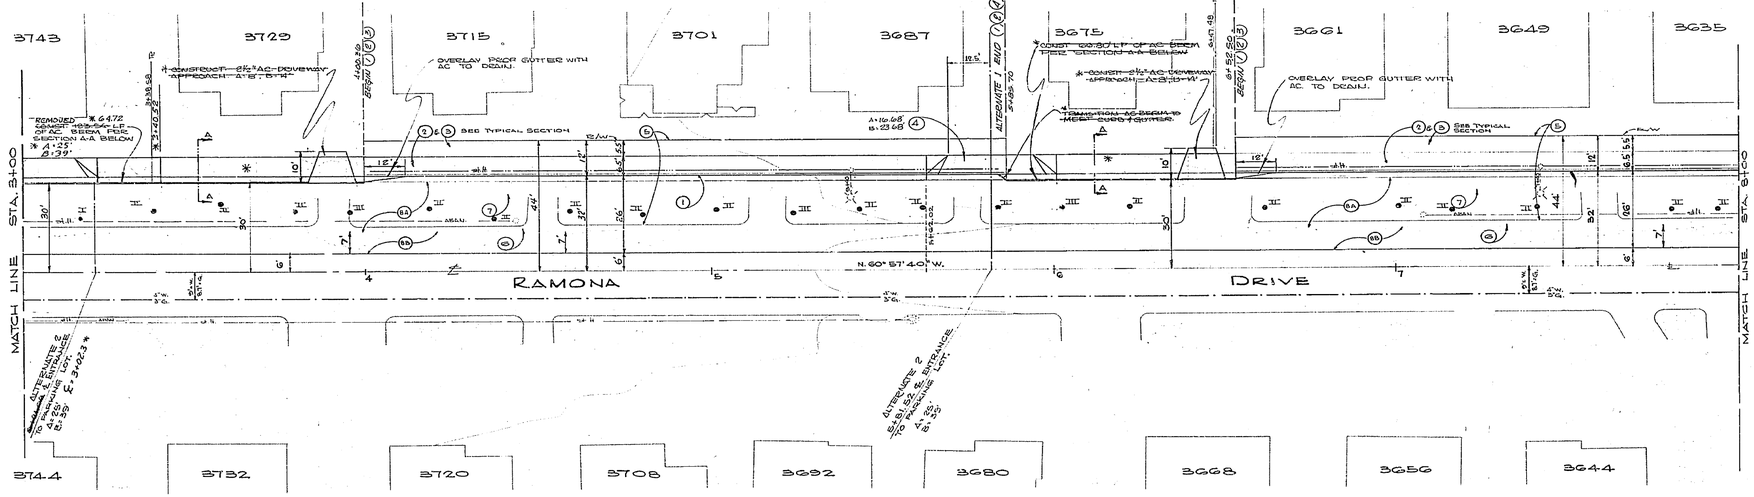

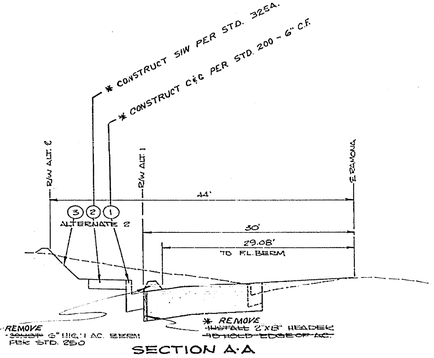

Section A-A

Alternate No. 1 Construction

~~Sta. 2+76.80 to Sta. 4+00.36~~
~~Sta. 2+80.70 to Sta. 4+47.48~~

Not to Scale

* Sta. 2+76.80 to 3+40.52

* As Built 12-30-71 BDM

Albert A. Webb Associates Civil Engineers Riverside, California Approved by ____ Date 12/3/70 R.E. No. 28715 W.O. 70-187 For: Riverside City College F.B. 1016	Revisions	City of Riverside, California Public Works Department Approved by ____ Director of Public Works. Date 1-18-71 Scales: Horizontal 1"=20', Vertical 1"=4'

	By	Date
Approved by		
Principal Engineer	[illegible]	12/7
Park Department	[illegible]	12/7
Traffic Division	[illegible]	12/7
Chief Pub. Wks. Engr.	[illegible]	12/8
R.C.E.	[illegible]	12/22

Designed by DRB Drawn by V.S. Checked by [illegible]

Ramona Drive
Widening and Extension
Magnolia Ave to Olivewood Ave.

Account No. 391
Drawing Number
R-1462
Sheet 2 of 7
70-187

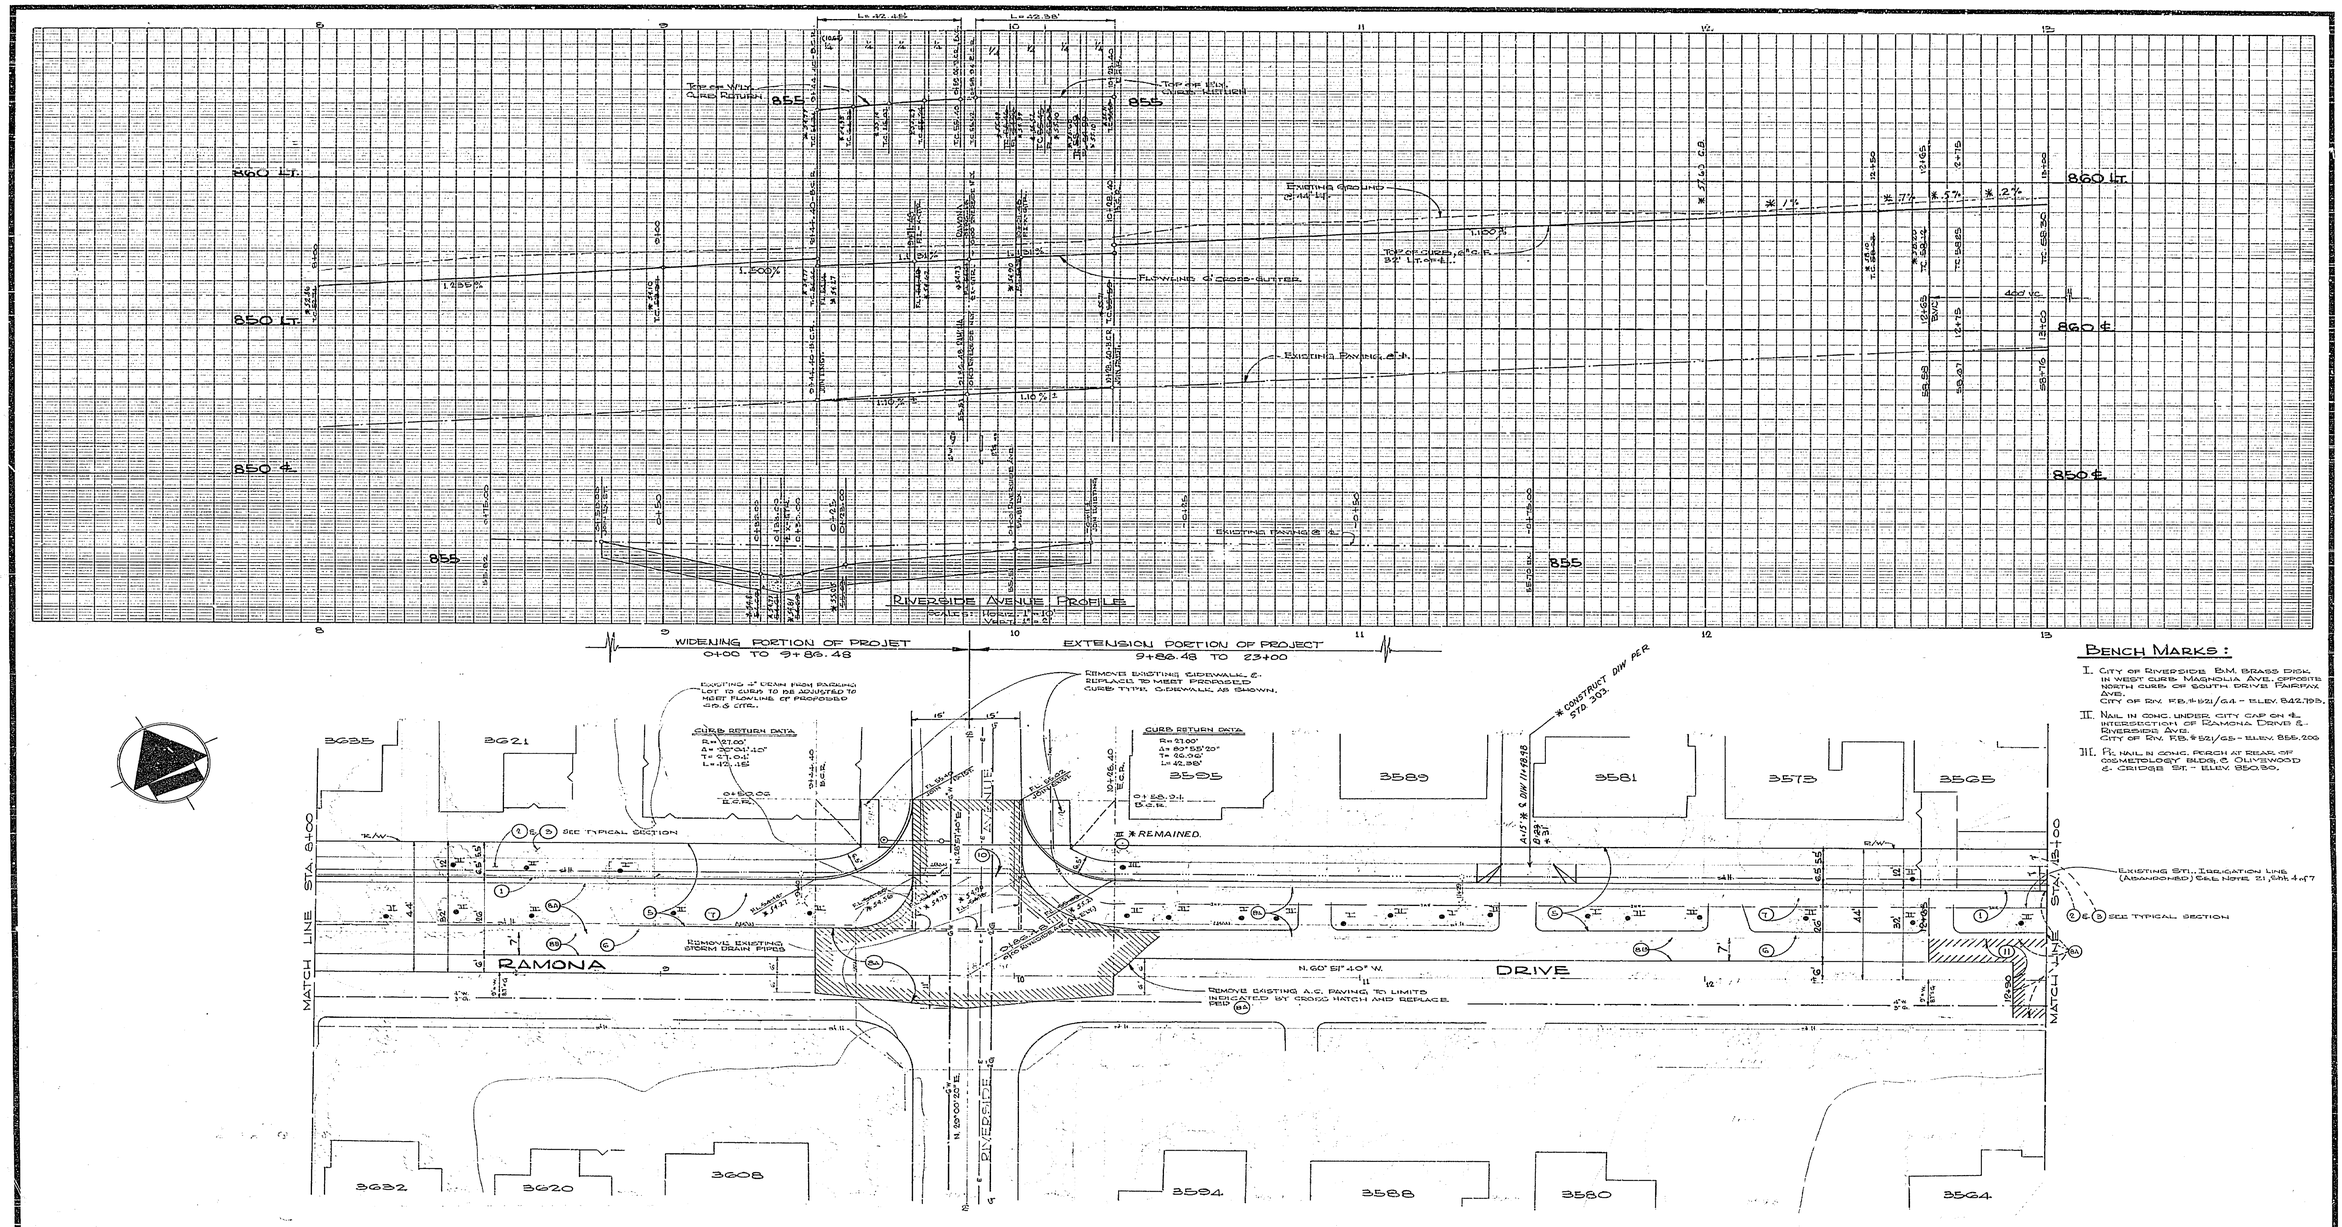

Bench Marks :

I. City of Riverside B.M. brass disk in west curb Magnolia Ave. opposite north curb of south drive Fairfax Ave.
City of Riv. F.B. 4-121/64 - Elev. 842.795.

II. Nail in conc. under City cap on ⊄ intersection of Ramona Drive & Riverside Ave.
City of Riv. F.B. 4-121/65 - Elev. 855.206

III. P.K. nail in conc. perch at rear of Cosmetology Bldg. ⊄ Olivewood & Cridge St. - Elev. 850.90.

* As Built 12-30-71 BDM

ALBERT A. WEBB ASSOCIATES
CIVIL ENGINEERS
RIVERSIDE, CALIFORNIA
APPROVED BY [signature] DATE 12/3/70
R.E. No. 2676
W.O. 70-187 FOR: RIVERSIDE CITY COLLEGE P.B. 1018

MARK	REVISIONS	APPR.	DATE

DESIGNED BY D.R.B. DRAWN BY V.G. CHECKED BY A.W.

CITY OF RIVERSIDE, CALIFORNIA
PUBLIC WORKS DEPARTMENT

APPROVED BY	BY	DATE
PRINCIPAL ENGINEER	[signature]	12/71
PARK DEPARTMENT	[signature]	12/71
TRAFFIC DIVISION	[signature]	12/71
CHIEF PUB. WKS. ENGR.	[signature]	12/71
C.C.C.	[signature]	12/71

APPROVED BY [signature]
DIRECTOR OF PUBLIC WORKS.
DATE 1-28-71

Ramona Drive
Widening and Extension
Magnolia Ave. to Olivewood Ave.

SCALES: Horizontal 1"=20', Vertical 1"=4'

ACCOUNT No. 3511
DRAWING NUMBER
R-1462
SHEET 8 OF 7
70-187

CURVE DATA				
No.	RAD.	Δ	T	L
(1)	45.00'	54°52'48"	25.68'	43.90'
(2)	116.81'	18°32'52"	17.96'	34.60'
(3)	978.00'	10°35'47"	108.90'	334.56'
(4)	1032.00'	10°35'47"	178.22'	352.92'
(5)	30.00'	54°24'05"	16.45'	30.08'
(6)	30.00'	38°11'50"	10.33'	19.99'
(7)	30.00'	27°49'21"	7.43'	14.57'
(8)	30.00'	17°11'20"	4.53'	9.00'
(9)	30.00'	109°10'55"	37.11'	57.60'
(10)	344.0'	5°11'05"	15.30'	29.93'
(11)	187.65'	27°58'10"	46.81'	91.64'
(12)	430.00	90°37'36"	2.12'	5.43'

BENCH MARKS:

I. CITY OF RIVERSIDE, B.M. BRASS DISK IN VALLEY GUTTER, MAGNOLIA AVE., OPPOSITE NORTH CURB OF CAMPBELL DRIVE, FAIRPLAIN AVE. CITY OF RIV. F.B.# 621/64 - ELEV. 840.705.

II. NAIL IN CONC. UNDER CITY CAP ON E. INTERSECTION OF RAMONA DRIVE & RIVERSIDE AVE. CITY OF RIV. F.B.# 621/65 - ELEV. 855.206.

III. PK. NAIL IN CONC. PORCH AT REAR OF GEOMETOLOGIST BLDG. @ OLIVEWOOD & CHICAGO ST. - ELEV. 850.50.

CONSTRUCTION NOTES

(11) REMOVE EXISTING PAVING FROM STA. 12+68 TO 19+20 PT. ON ℄ OF EXISTING RAMONA DRIVE. (LIMITS INDICATED BY CROSS HATCH)

(12) REMOVE EXISTING CURB AND GUTTER, EXISTING RAMONA DRIVE.
NORTHERLY SIDE: STA. 0+48 TO 19+24 PT. (OLD ℄).
SOUTHERLY SIDE: STA. 13+18 . 10 - 5.43' FROM 19+28 (OLD ℄).

(13) REMOVE EXISTING SIDEWALK FROM 3+20 PT. TO 3+98 PT.

(14) ALL SLOPES TO BE A MAXIMUM OF 2:1.

(15) CONSTRUCT SIDEWALK TRANSITION FROM EXISTING 5' CONC. PROPERTY LINE SIDEWALK TO TYPICAL 6' CONC. CURB LINE SIDEWALK, AS SHOWN. THICKNESS AND JOINTS SHALL BE PER STD. 225A.

(16) REMOVE EXISTING SIDEWALK AND STEPS AND REPLACE PER DETAIL, BELOW.

(17) REMOVE EXISTING CONC. DRIVE STEPS & RETAINING WALLS. REPLACE WITH 10' WIDE CONC. DRIVEWAY AS SHOWN. (ELEVATIONS 14+50, SEE SHT. 7 of 7 FOR PROFILE)

(18) REMOVE EXISTING DRIVEWAY APPROACH AND CONSTRUCT NEW DRIVEWAY AS SHOWN. (2½" A.C. PAVING OVER COMPACTED NATIVE SOIL) TOGETHER WITH 2'-0" SIDEWALK RETURNS.

(19) REMOVE EXISTING SIDEWALK BETWEEN HOUGHTY SIDEWALK & CURBS.

(20) AREA BETWEEN EXISTING PARKWAY AND TOP OF SLOPE TO BE GRADED TO DRAIN AS INDICATED.

(21) LOCATION OF EXISTING STEEL IRRIGATION IS APPROXIMATE PER CITY OF RIV. IRRIGATION DIV. WHERE INTERFERENCE OCCURS LINE IS TO BE REMOVED & PLUGGED. FOR ASSISTANCE CONTACT LAWSON BATTLEFIELD AT 787-7270.

(22) CONST. CURB ONLY, 6" C.F., PER STD. DWG. NO. 200 - AT POINT 'A' LEAVE 1.0' WIDE OPENING IN CURB FACE FOR DRAINAGE OUTLET. - EXACT LOCATION OF DRIVE TO BE ESTABLISHED IN THE FIELD.

(23) INSTALL 7.5'± OF 6'-6" x 1'-11" RECTANGULAR PIPE UNDER SIDEWALK PER STD. DWG. NO. 411. F.L. INLET 56.2, F.L. OUTLET 54.68. -- FROM 2.0' x 5' WIDE CONC. INLET APRON INVERT TO PICK UP DRAINAGE SWALE.

SEE SHEET 1 FOR NOTES 24 , 25 , 26

(27) GAS MAIN IS ABANDONED IN PROPOSED CUT AREA. WATER MAIN WILL BE ABANDONED UPON COMPLETION OF THE PROPOSED 8" MAIN BY THE WATER DIVISION - SEE SECTION 7-7 OF THE SPECIAL PROVISIONS.

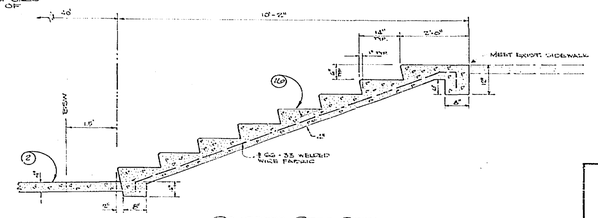
MEET EXIST. SIDEWALK
EDGE
2% MIN.
SEE NOTE 16
#3 BARS @ 18" CTRS.
#4 BARS @ 18" CTRS.

RAMONA DRIVE CUL-DE-SAC

SEE SHEET 4 OF 7 FOR PLAN

* AS BUILT 12-30-71 BDM

ALBERT A. WEBB ASSOCIATES CIVIL ENGINEERS RIVERSIDE, CALIFORNIA APPROVED BY [signature] DATE 12/3/70 R.E. No. 38716 W.O. 70-187 FOR: RIVERSIDE CITY COLLEGE F.B. 1015	MARK / REVISIONS / APPR. / DATE DESIGNED BY D.R.S. DRAWN BY V.S. CHECKED BY A.W.	CITY OF RIVERSIDE, CALIFORNIA PUBLIC WORKS DEPARTMENT APPROVED BY / BY / DATE PRINCIPAL ENGINEER — 12/4 PARK DEPARTMENT — 12-7 TRAFFIC DIVISION — 12-7 CHIEF PUB. WKS. ENGR. — 5-26 R.C.E. 4010 — 4/25 APPROVED BY [signature] DIRECTOR OF PUBLIC WORKS DATE 5-15-71	RAMONA DRIVE WIDENING AND EXTENSION MAGNOLIA AVE. TO OLIVEWOOD AVE. SCALES: HORIZONTAL 1"=40', VERTICAL 1"=4'	ACCOUNT No. 391 DRAWING NUMBER R-1462 SHEET 5 OF 7 70-187

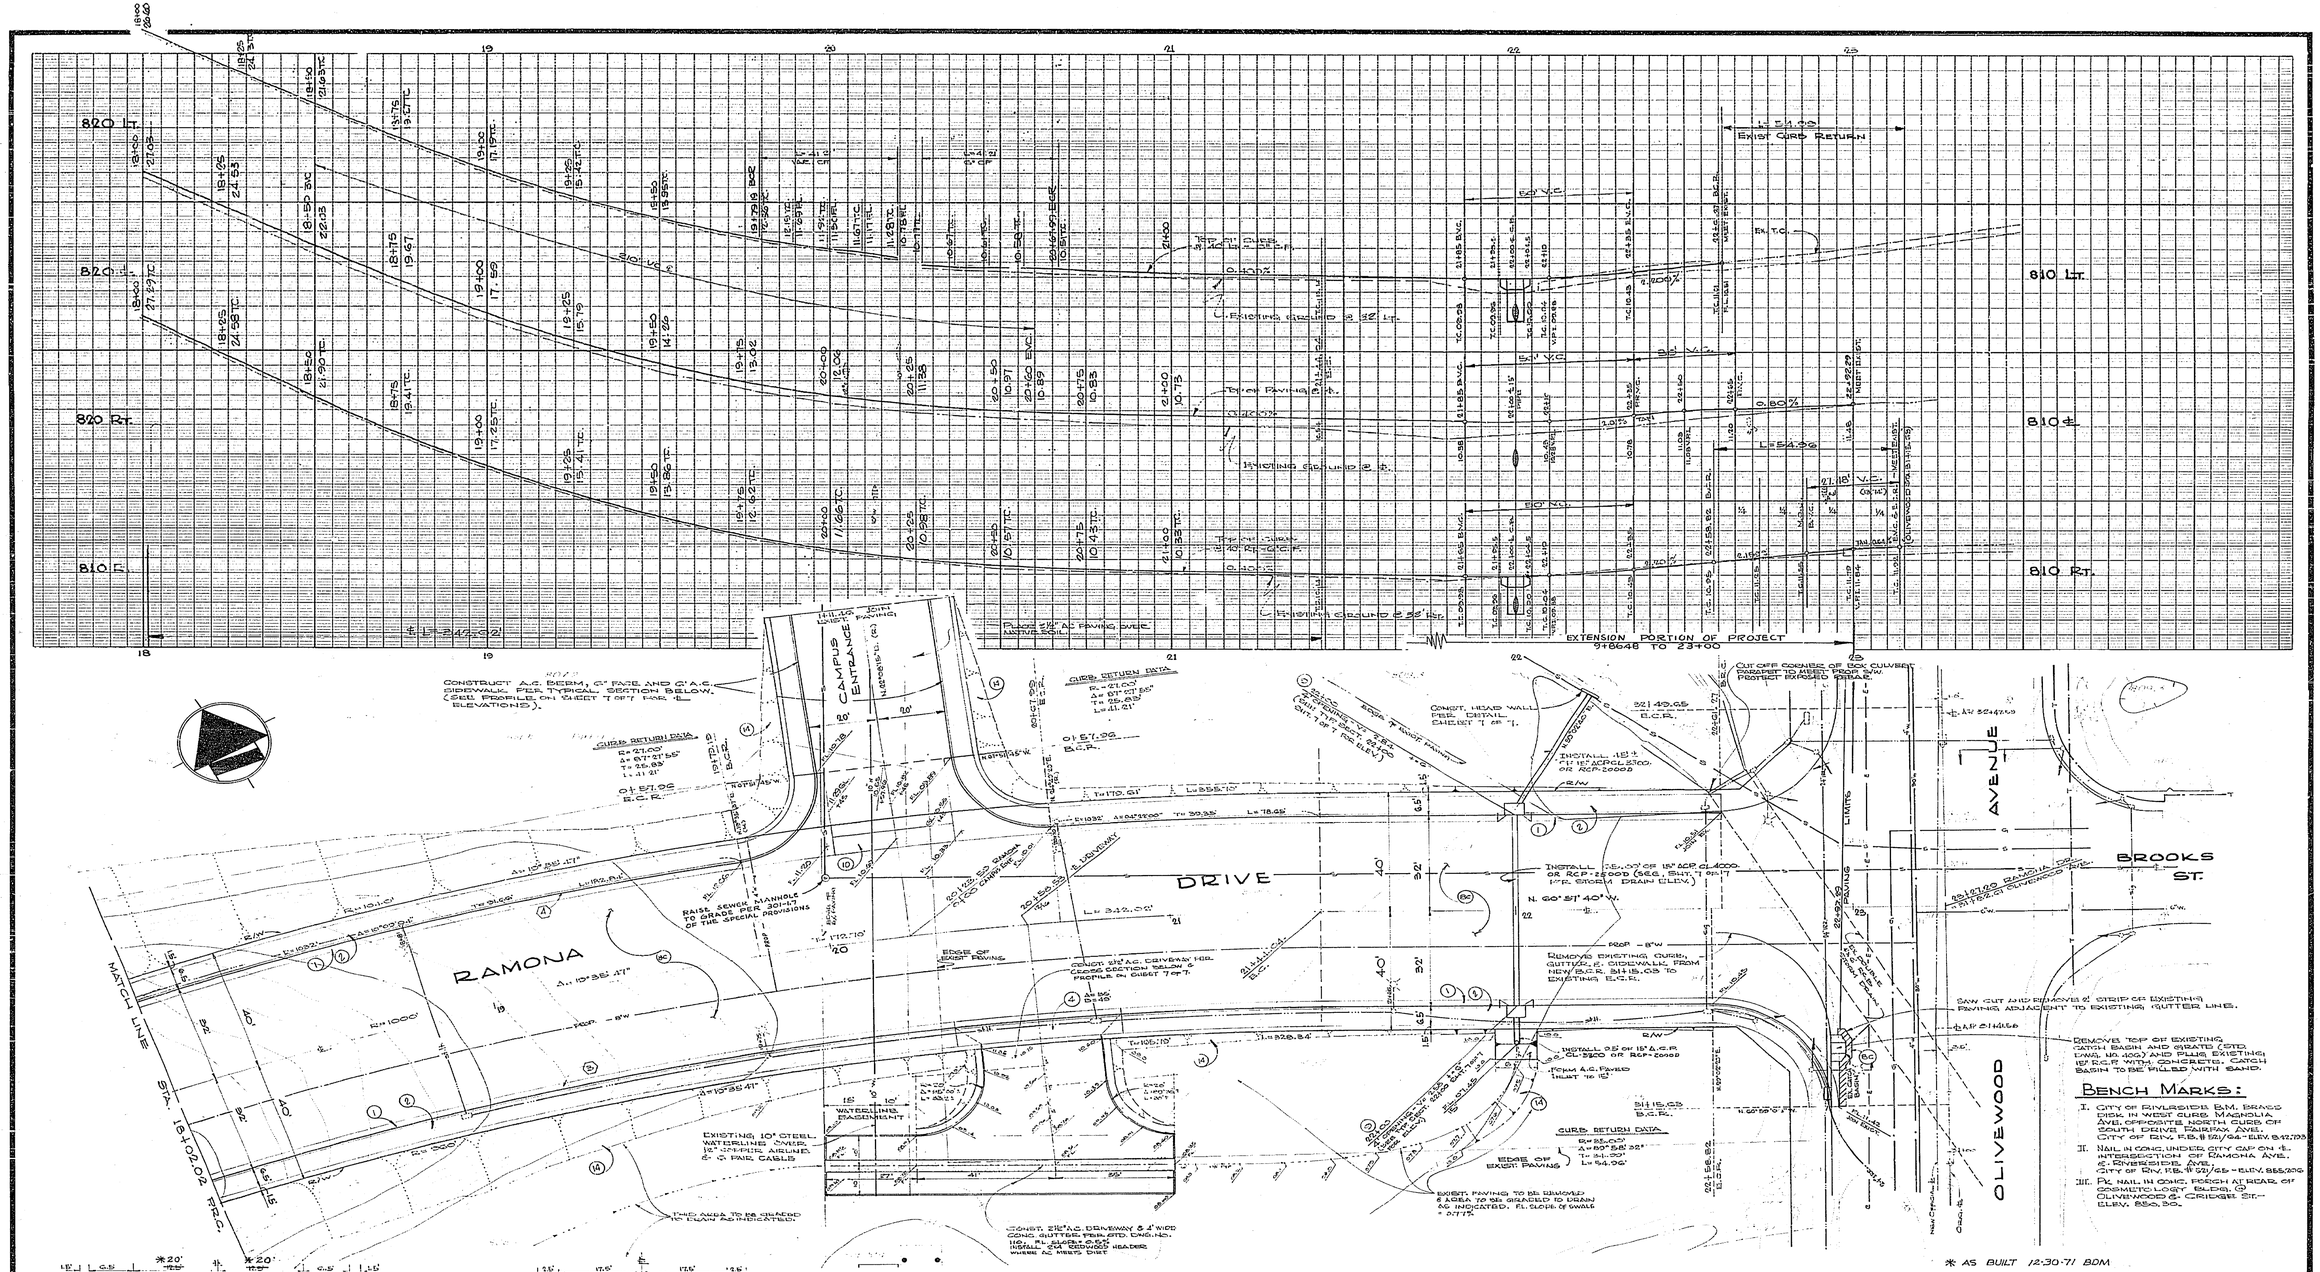
820 Lt.
820 Rt.
810 F.
810 Lt.
810 ℄
810 Rt.
EXTENSION PORTION OF PROJECT
9+66.48 TO 23+00
Ex. 15" CIRC RETURN
Ex. T.C.
EXISTING 8" A.C. PAVING
PLACE 3½" A.C. PAVING OVER
EXISTING A.C. PAVING
CONSTRUCT A.C. BERM, 6:1 FACE, AND 6' P.C.C. SIDEWALK PER TYPICAL SECTION BELOW. (SEE PROFILE ON SHEET 7 OF 7 FOR ELEVATIONS).
CAMPUS ENTRANCE ROAD
CURB RETURN DATA
R = 21.00'
Δ = 67° 21' 55"
T = 15.83'
L = 41.21'
℄ 57.06 B.C.R.
℄ 57.06 E.C.R.
CURB RETURN DATA
R = 21.00'
Δ = 67° 21' 55"
T = 15.83'
L = 41.21'
℄ 57.06 B.C.R.
RAMONA
DRIVE
BROOKS ST.
OLIVEWOOD
AVENUE
MAGNOLIA
MATCH LINE STA. 18+02.02 R.R.C.
RAISE SEWER MANHOLE TO GRADE PER 301-17 OF THE SPECIAL PROVISIONS
CONST. 21½" A.C. DRIVEWAY PER CALTRANS STD. A87A
CONST. 21½" A.C. DRIVEWAY & 4' WIDE CONC. GUTTER PER CITY STD. DWG. NO. 210
INSTALL 18" ℄ 11'-10" ACP CL. 3300 OR RCP-2000D
INSTALL 18" ℄ 11'-10" ACP CL. 3300 OR RCP-2000D
INSTALL 18" ℄ 11'-10" ACP CL. 3300 OR RCP-2000D (SEE SHT. 7 OF 7 FOR DETAIL)
CONST. HEAD WALL PER DETAIL. SHEET 7 OF 7.
INSTALL 18" ℄ 11'-10" ACP CL. 4000 OR RCP-2500D (SEE SHT. 7 OF 7 FOR DETAIL)

TYPICAL SECTION
RAMONA DRIVE EXTENSION
SECTION SHOWN IS AT 17+25
SCALES: HORIZ. 1"=10' VERT. 1"=5'

SECTION
RAMONA DRIVE EXTENSION
STA. 14+50
SCALES: HORIZ. 1"=50' VERT. 1"=5'

SECTION
RAMONA DRIVE
CUL-DE-SAC
(SEE SHEET 4 OF 7 FOR PLAN)
SCALES: HORIZ. 1"=10' VERT. 1"=5'

OUTLET BOX DETAIL
NOT TO SCALE
CONSTRUCT OUTLET BOX PER STD. DWG. NO. 410, SEE DETAIL
STA. 16+31.01

SECTION
RAMONA DRIVE EXTENSION
STA. 16+31.01
SCALES: HORIZ. 1"=10' VERT. 1"=5'

SECTION
RAMONA DRIVE EXTENSION
STA. 22+00
SCALES: HORIZ. 1"=10' VERT. 1"=2'

R.C.C. HEADWALL DETAIL
NOT TO SCALE
STA. 22+25 ± LT.

CAMPUS ENTRANCE
STA. 20+23.50
SCALES: HORIZ. 1"=20' VERT. 1"=4'

WELL SITE ENTRANCE
STA. 20+52.53

* AS BUILT 12-30-71 BDM

ALBERT A. WEBB ASSOCIATES CIVIL ENGINEERS RIVERSIDE, CALIFORNIA APPROVED BY [illegible] DATE 12/3/70 R.E. No. 28756 W.O. 70-187 FOR: RIVERSIDE CITY COLLEGE F.B. 1016	MARK	REVISIONS	APPR.	DATE	CITY OF RIVERSIDE, CALIFORNIA PUBLIC WORKS DEPARTMENT APPROVED BY / DATE PRINCIPAL ENGINEER [illegible] 9/27 PARK DEPARTMENT TRAFFIC DIVISION CHIEF PUB. WKS. ENGR. [illegible] 5-28-71 R.C.C. [illegible] 6-15	RAMONA DRIVE WIDENING AND EXTENSION MAGNOLIA AVE. TO OLIVEWOOD AVE. DETAIL SHEET APPROVED BY [illegible] DIRECTOR OF PUBLIC WORKS DATE 5-25-71 SCALE: AS NOTED	ACCOUNT No. 391 DRAWING NUMBER R-1462 SHEET 7 OF 7 70-187
	DESIGNED BY [illegible] DRAWN BY [illegible] CHECKED BY AW						

△ REPLANTED PALM LOCATION	SURFACE PREPARATION				
	SAW-CUT CONCRETE REMOVE CONCRETE	REMOVE TOTAL CONCRETE DRIVEWAY APRON	REMOVE TURF	SAW-CUT ASPHALT PAVING REMOVE ASPHALT, ADJ CURTSE	
1.	●				
2.		●			
3.		●			
4.			●		
5	●				
6 THROUGH 23				SAME	●

GENERAL NOTES

A. ALL TREE WELLS SHALL BE 6'x6' SIZE.
B. THE COLLEGE RESERVES THE RIGHT TO ADJUST TREE LOCATIONS TO SUIT CONDITIONS. OBTAIN COLLEGE APPROVAL BEFORE SAW-CUTTING
C. THE COLLEGE RESERVES THE RIGHT TO VARY THE TOTAL QUANTITY OF TREES TO BE REPLANTED
D. IRRIGATE & APPLY VITAMIN B-1 CONCENTRATE PER LABEL INSTRUCTIONS DURING REPLANTING
E. DO NOT MAKE ALLOWANCES FOR:
   (1.) UTILITY LINE RELOCATION
   (2.) REPLACEMENT OF POOR SOIL
F. MAKE ALL REASONABLE EFFORTS SUCH AS THE USE OF DETECTORS & EXAMINATION OF UTILITY DRAWINGS IN COLLEGE POSSESSION TO AVOID DAMAGE TO SUBTERRANEAN UTILITY LINES.

INDICATES REPLANTED PALM TREE LOCATION

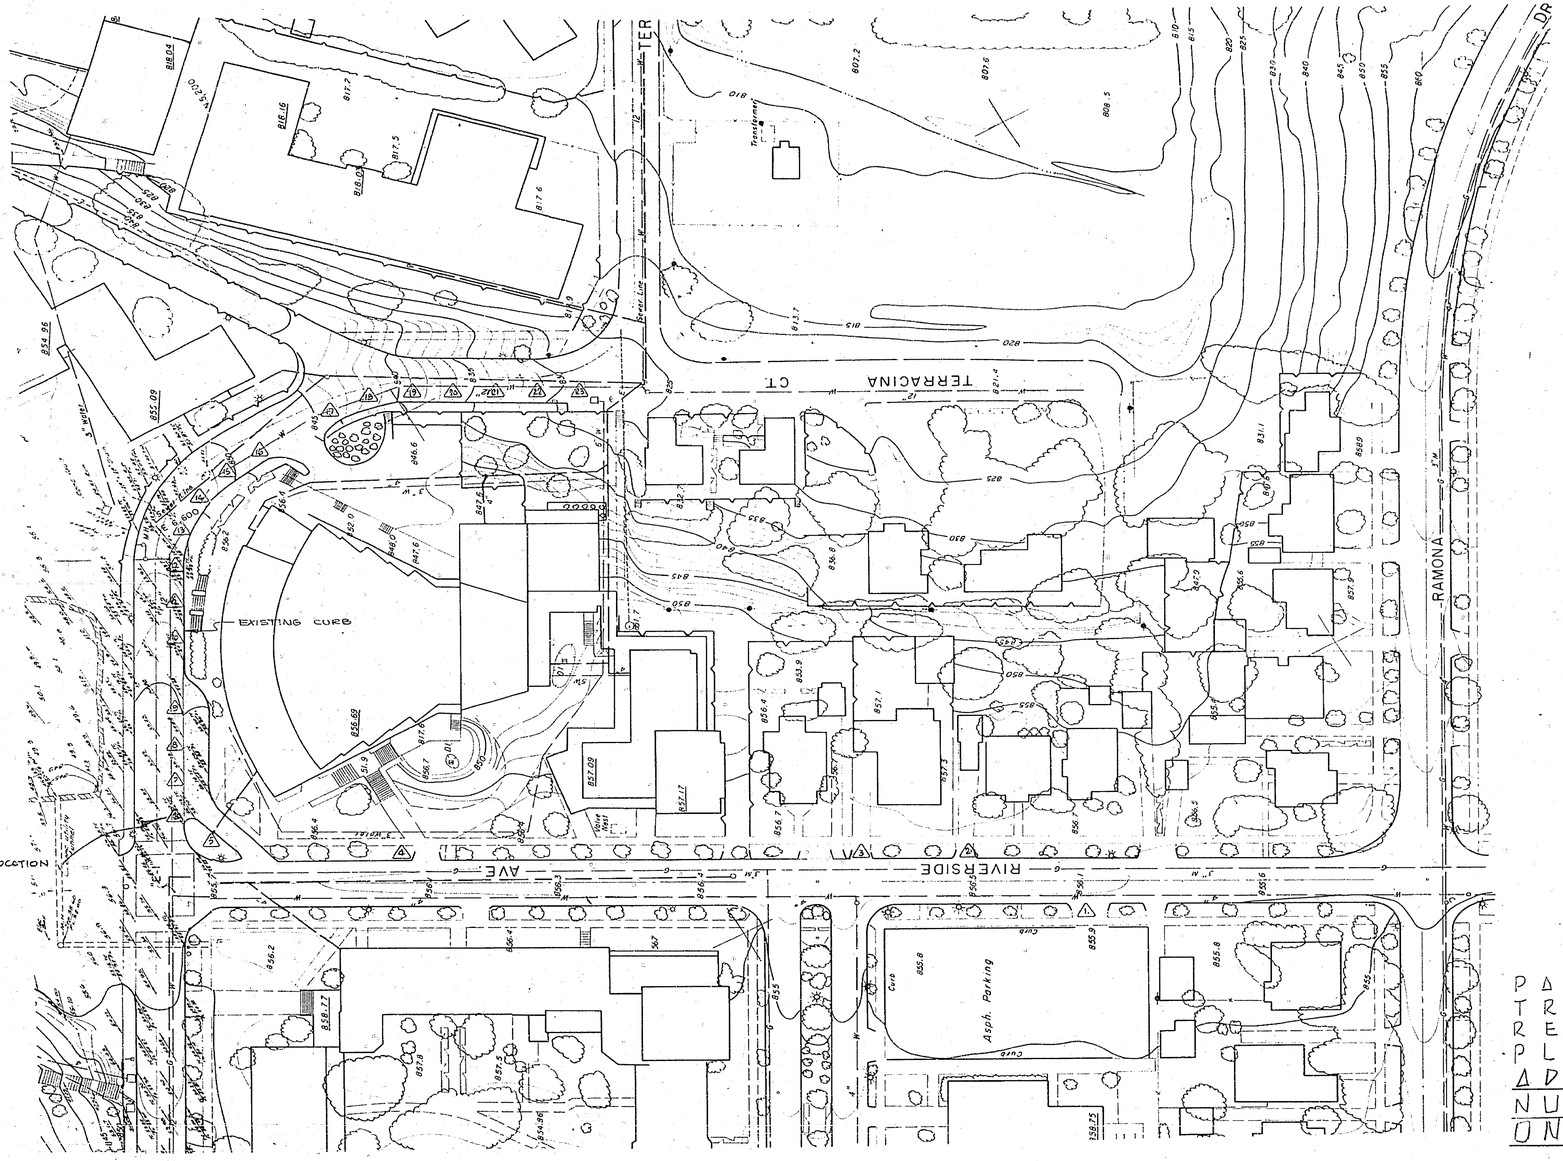

SCALE 1" = 40'

PALM TREE REPLANTING PLAN ADDENDUM NUMBER ONE

R-1962