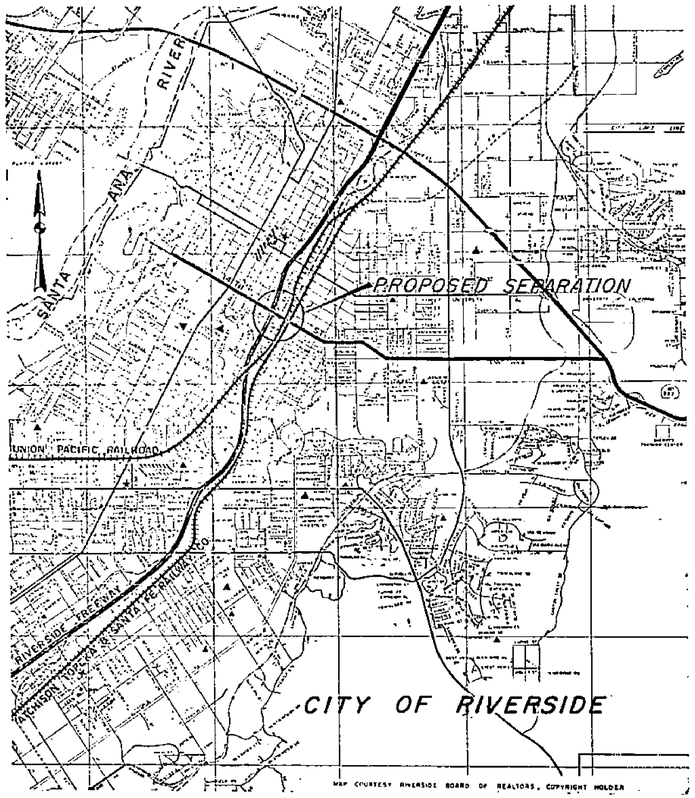

LOCATION MAP

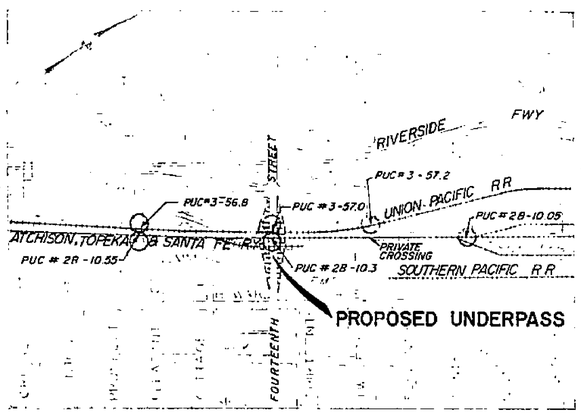

VICINITY MAP

SCALE: 1" = 600'

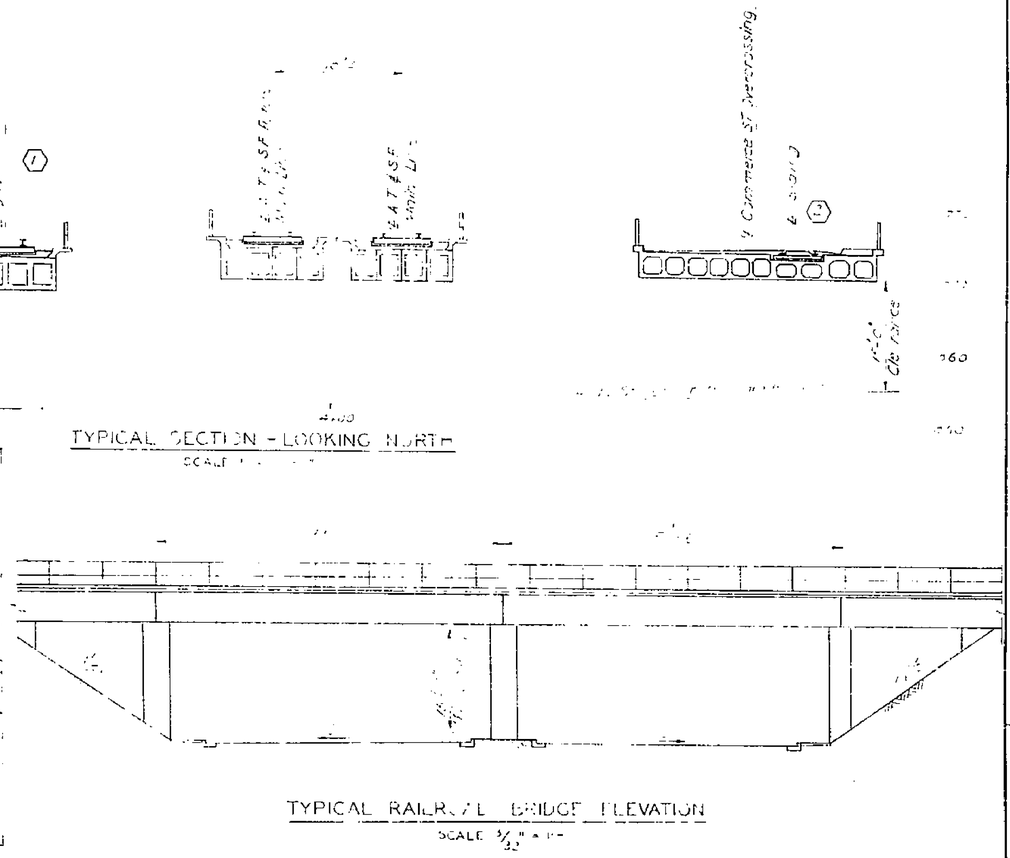

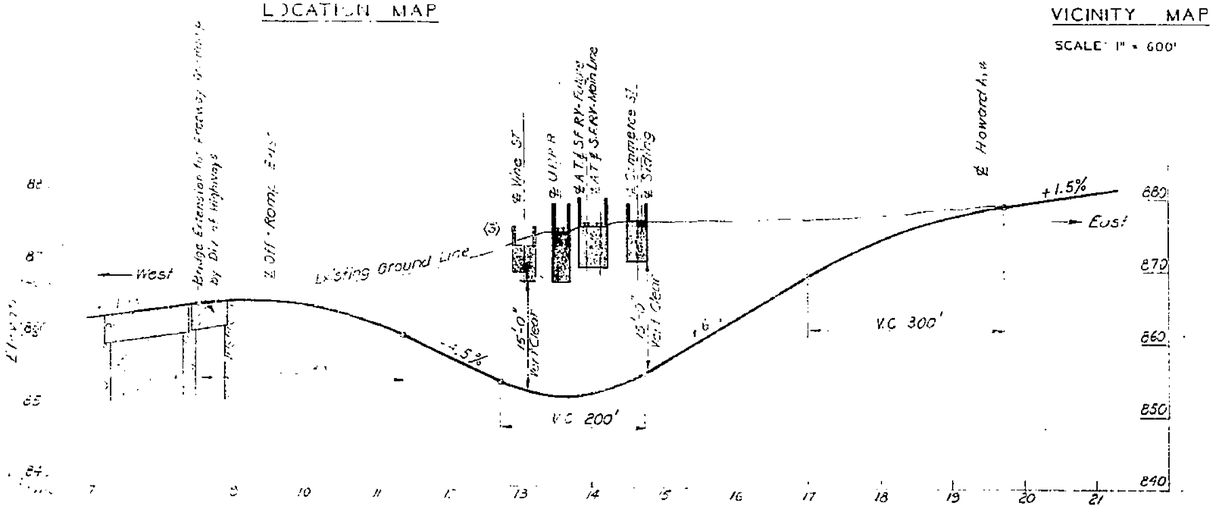

14 TH. ST. UNDERPASS PROFILE

SCALE: VERT. 1" = 10'-0"
HORIZ. 1" = 100'-0"

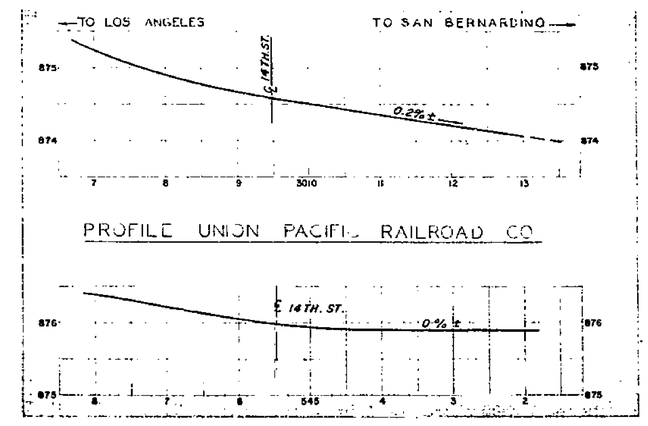

PROFILE UNION PACIFIC RAILROAD CO

PROFILE - ATCHISON, TOPEKA AND SANTA FE RAILWAY

SCALE: VERT. 1" = 10'-0"
HORIZ. 1" = 100'-0"

REV.	DESCRIPTION	DATE	BY
(6)	Ramp "2" removed	Mar. 71	R.M.B.
(5)	Siding Location revised	Nov. 70	R.M.B.
(7)	U.P.R.R. not relocated	Nov. 70	R.M.B.
	Location revised		

First Amendment

PUBLIC STREET IMPROVEMENT SHEET

EXHIBIT "B" SHEET NO. 1 (Rev)

CITY OF RIVERSIDE, CALIFORNIA

FOURTEENTH STREET UNDERPASS
UNDER TRACKS OF
ATCHISON, TOPEKA & SANTA FE RAILWAY
UNION PACIFIC RAILROAD COMPANY

DE LEUW, CATHER & COMPANY
CONSULTING ENGINEERS
SAN FRANCISCO, CALIFORNIA

DESIGNED L.R.O. — CHECKED
DRAWN E.R. — APPROVED R.M.B.

SCALE: As shown

DATE: Nov 1970

SHEET NO. 1

R-1484 PROJ. NO. 2023-00

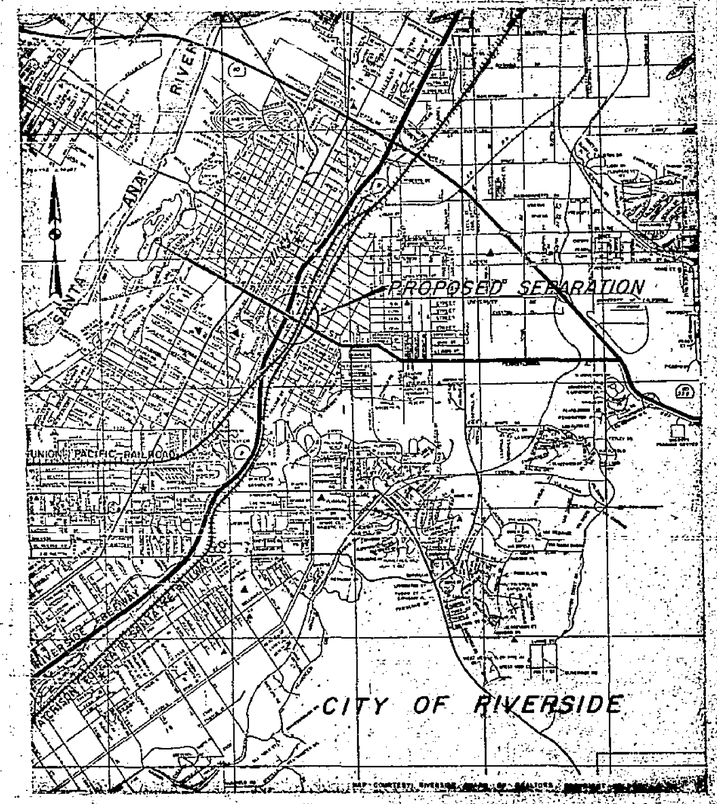

LOCATION MAP

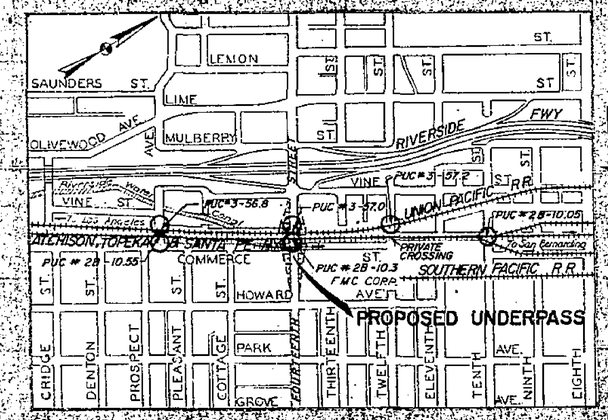

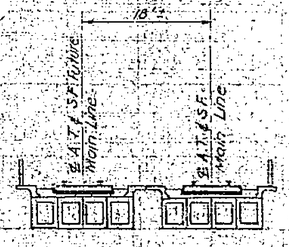

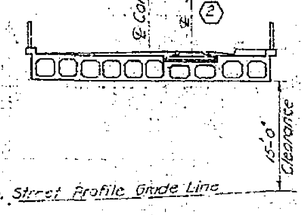

TYPICAL SECTION - LOOKING NORTH

SCALE: 1" = 10'-0"

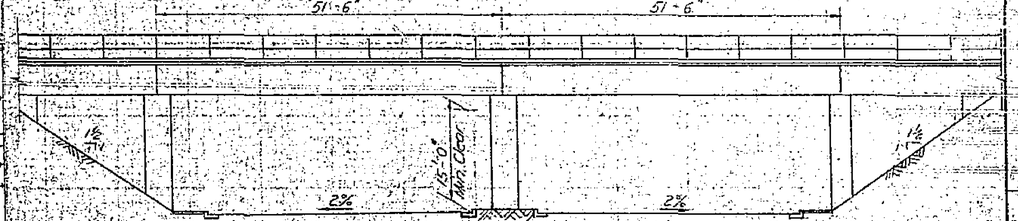

TYPICAL RAILROAD BRIDGE ELEVATION

SCALE: 3/32" = 1'-0"

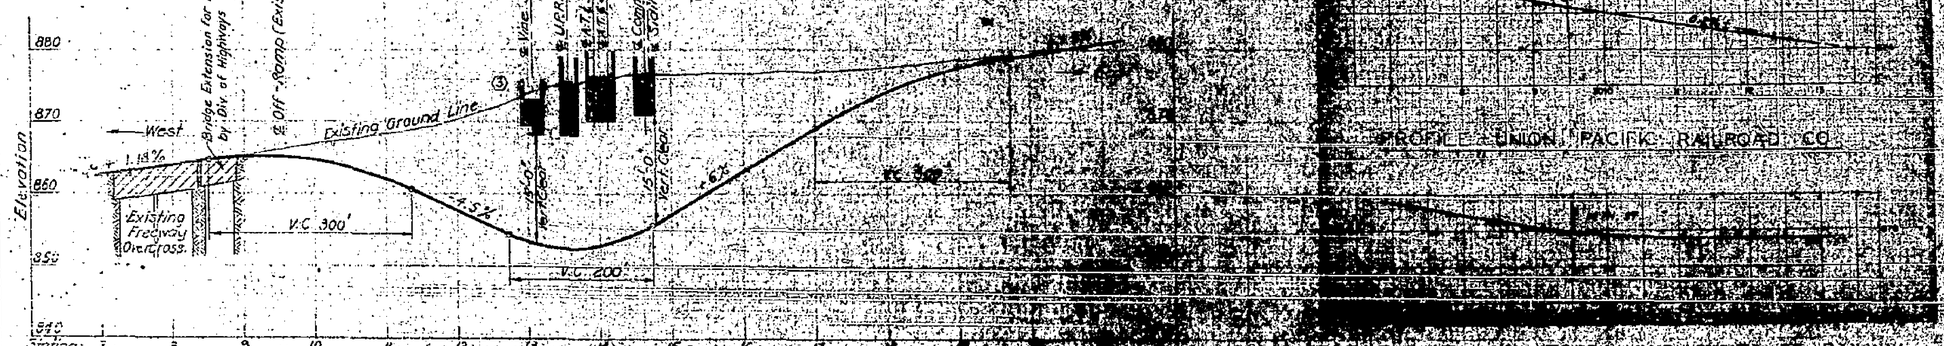

14 TH. ST. UNDERPASS PROFILE

SCALE: VERT. 1" = 10'-0"
HORIZ. 1" = 100'-0"

VICINITY MAP

SCALE: 1" = 200'

First Amendment

PUBLIC UTILITIES COMMISSION SHEET

EXHIBIT "B", SHEET NO. 1 (Rev.)

CITY OF RIVERSIDE, CALIFORNIA

FOURTEENTH STREET UNDERPASS
UNDER TRACKS OF
ATCHISON, TOPEKA & SANTA FE RAILWAY
UNION PACIFIC RAILROAD COMPANY

DE LEUW, CATHER & COMPANY
CONSULTING ENGINEERS
SAN FRANCISCO, CALIFORNIA

As shown

Nov. 1970

R-484