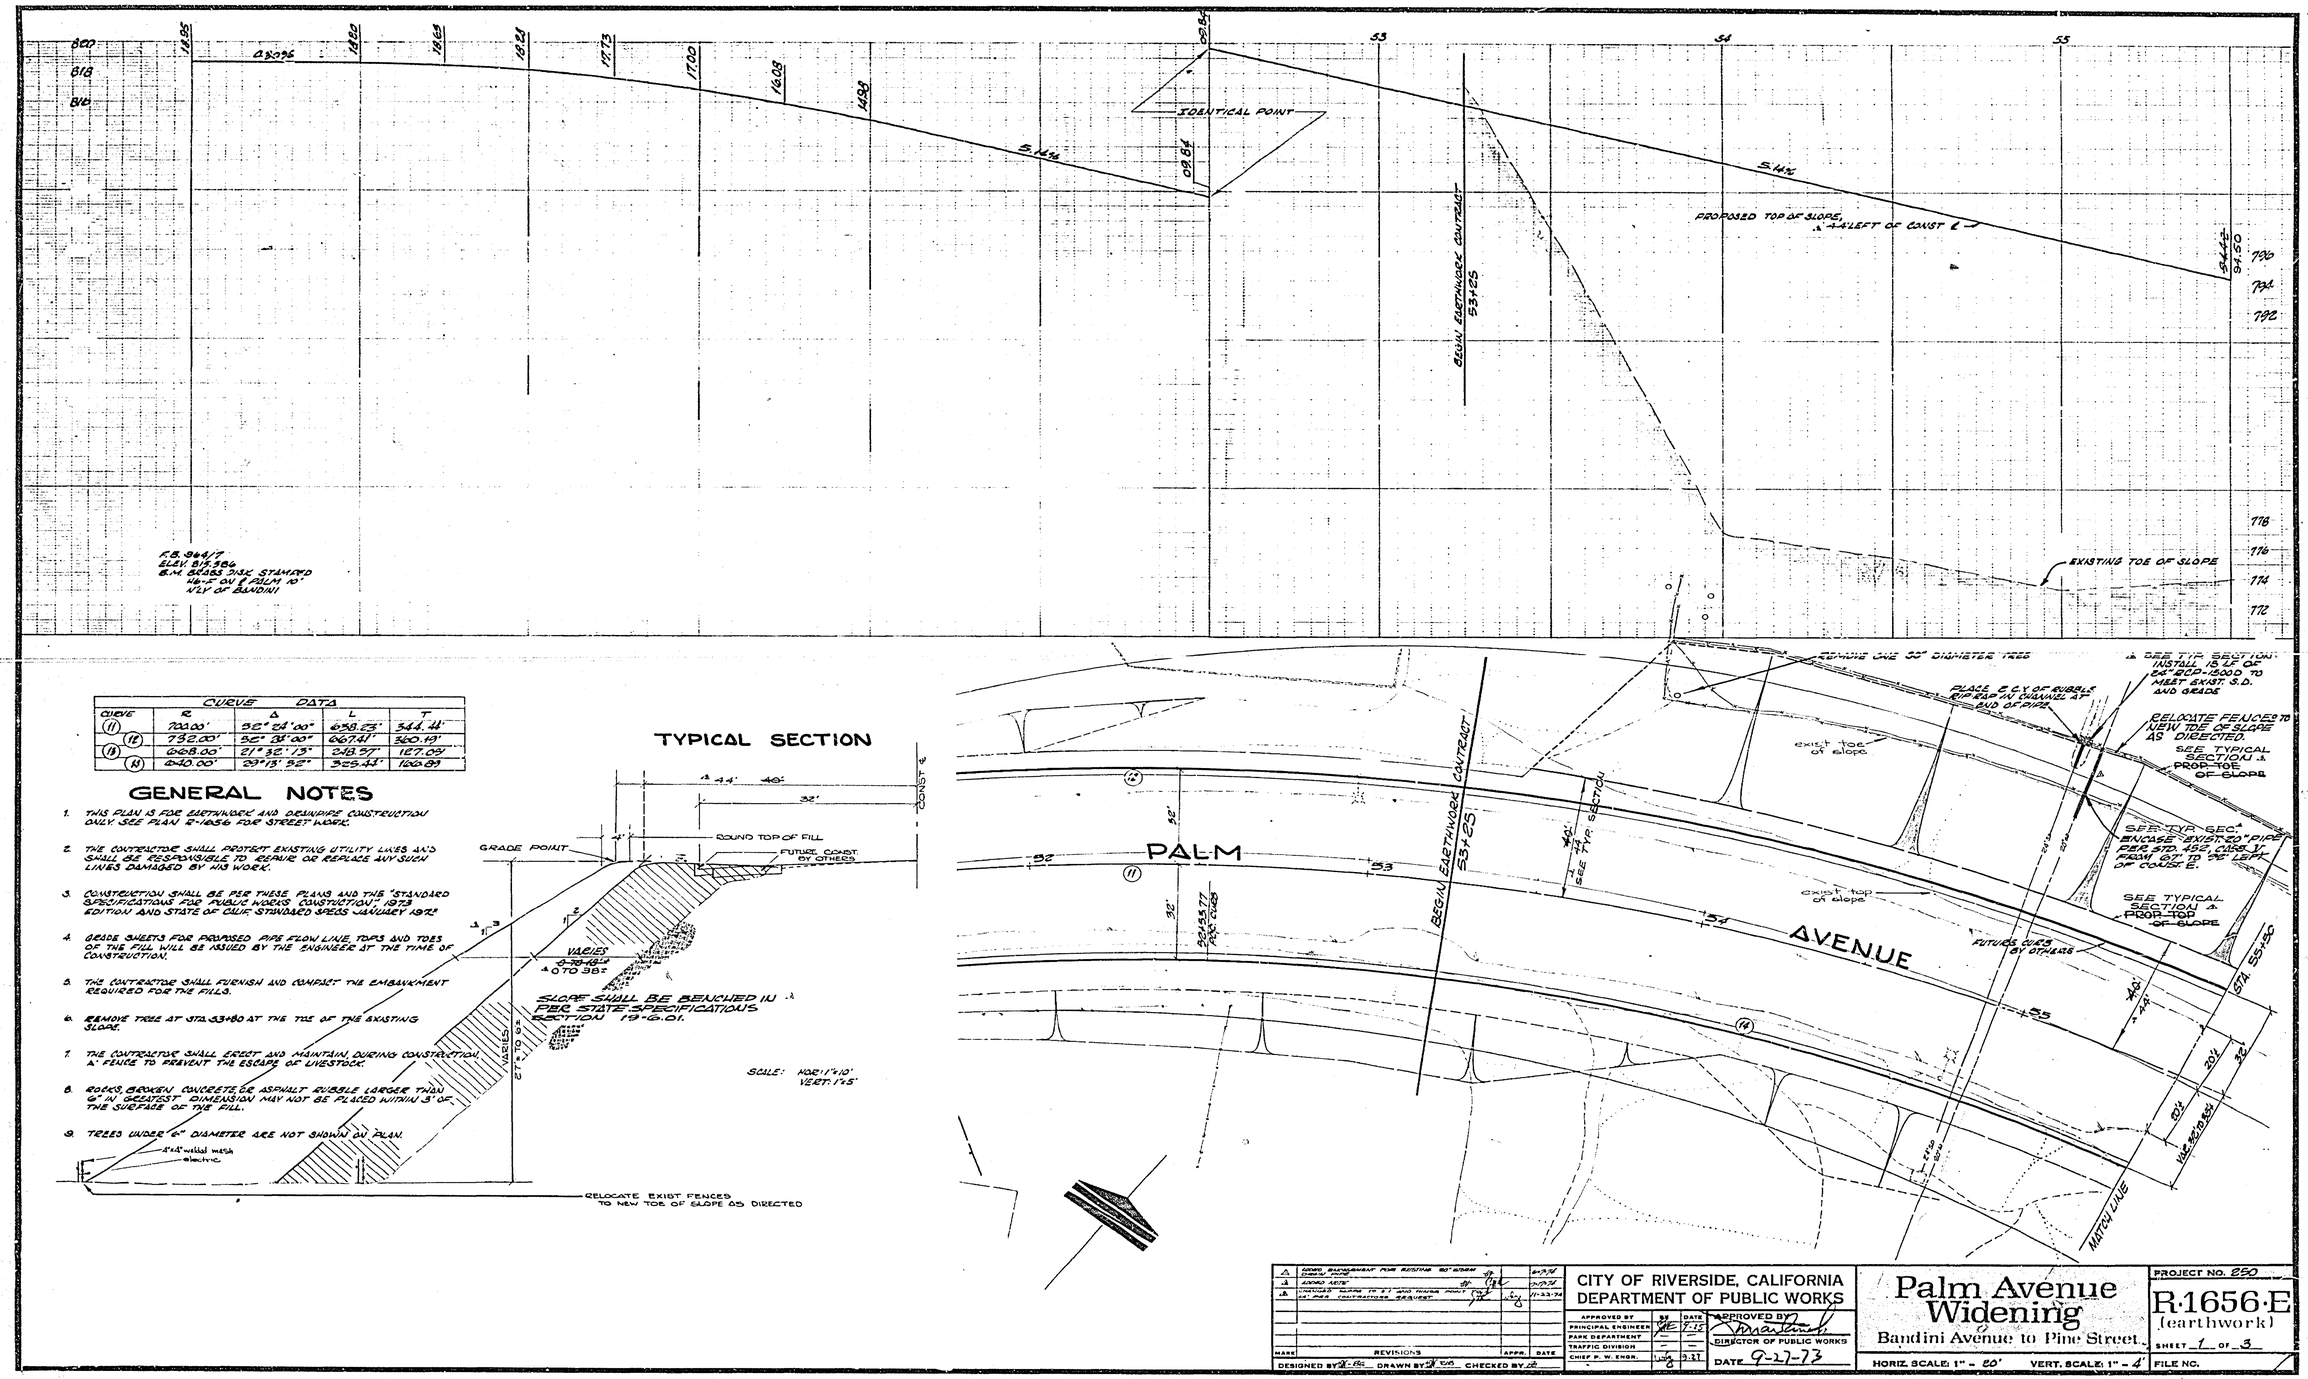

CURVE DATA				
CURVE	R	Δ	L	T
(11)	700.00'	35° 24' 00"	658.23'	344.41'
(12)	732.00'	52° 38' 00"	667.41'	360.19'
(13)	668.00'	21° 32' 13"	248.97'	126.02'
(14)	640.00'	29° 15' 52"	325.43'	166.89'

GENERAL NOTES

1. THIS PLAN IS FOR EARTHWORK AND DRAINPIPE CONSTRUCTION ONLY. SEE PLAN R-1656 FOR STREET WORK.
2. THE CONTRACTOR SHALL PROTECT EXISTING UTILITY LINES AND SHALL BE RESPONSIBLE TO REPAIR OR REPLACE ANY SUCH LINES DAMAGED BY HIS WORK.
3. CONSTRUCTION SHALL BE PER THESE PLANS AND THE "STANDARD SPECIFICATIONS FOR PUBLIC WORKS CONSTRUCTION" 1973 EDITION AND STATE OF CALIF. STANDARD SPECS. (AMJUNE 1972)
4. GRADE SHEETS FOR PROPOSED PIPE FLOW LINE, TOPS AND TOES OF THE FILL WILL BE ISSUED BY THE ENGINEER AT THE TIME OF CONSTRUCTION.
5. THE CONTRACTOR SHALL FURNISH AND COMPACT THE EMBANKMENT REQUIRED FOR THE FILLS.
6. REMOVE TREE AT STA. 53+80 AT THE TOE OF THE EXISTING SLOPE.
7. THE CONTRACTOR SHALL ERECT AND MAINTAIN, DURING CONSTRUCTION A FENCE TO PREVENT THE ESCAPE OF LIVESTOCK.
8. ROCKS, BROKEN CONCRETE, OR ASPHALT RUBBLE LARGER THAN 6" IN GREATEST DIMENSION MAY NOT BE PLACED WITHIN 3' OF THE SURFACE OF THE FILL.
9. TREES UNDER 6" DIAMETER ARE NOT SHOWN ON PLAN.

TYPICAL SECTION

SCALE: HOR. 1"=10' VERT. 1"=5'

MARK	REVISIONS	APPR.	DATE
A	GRADE ADJUSTMENT FOR EXISTING 60" SEWER MH	JP	6-7-74
B	ADDED NOTE	JP	7-17-74
C	CHANGED SLOPE TO 2:1 AND MOVED POINT 12' PER CONTRACTOR REQUEST	JP	11-13-74

DESIGNED BY JP DRAWN BY JP CHECKED BY JP

CITY OF RIVERSIDE, CALIFORNIA
DEPARTMENT OF PUBLIC WORKS

APPROVED BY	BY	DATE
PRINCIPAL ENGINEER		9-27-73
PARK DEPARTMENT	—	—
TRAFFIC DIVISION	—	—
CHIEF P. W. ENGR.		9-27-73

APPROVED BY
DIRECTOR OF PUBLIC WORKS
DATE 9-27-73

Palm Avenue Widening

Bandini Avenue to Pine Street

HORIZ. SCALE: 1" = 20' VERT. SCALE: 1" = 4'

PROJECT NO. 250

R-1656-E (earthwork)

SHEET 1 OF 3

FILE NO.

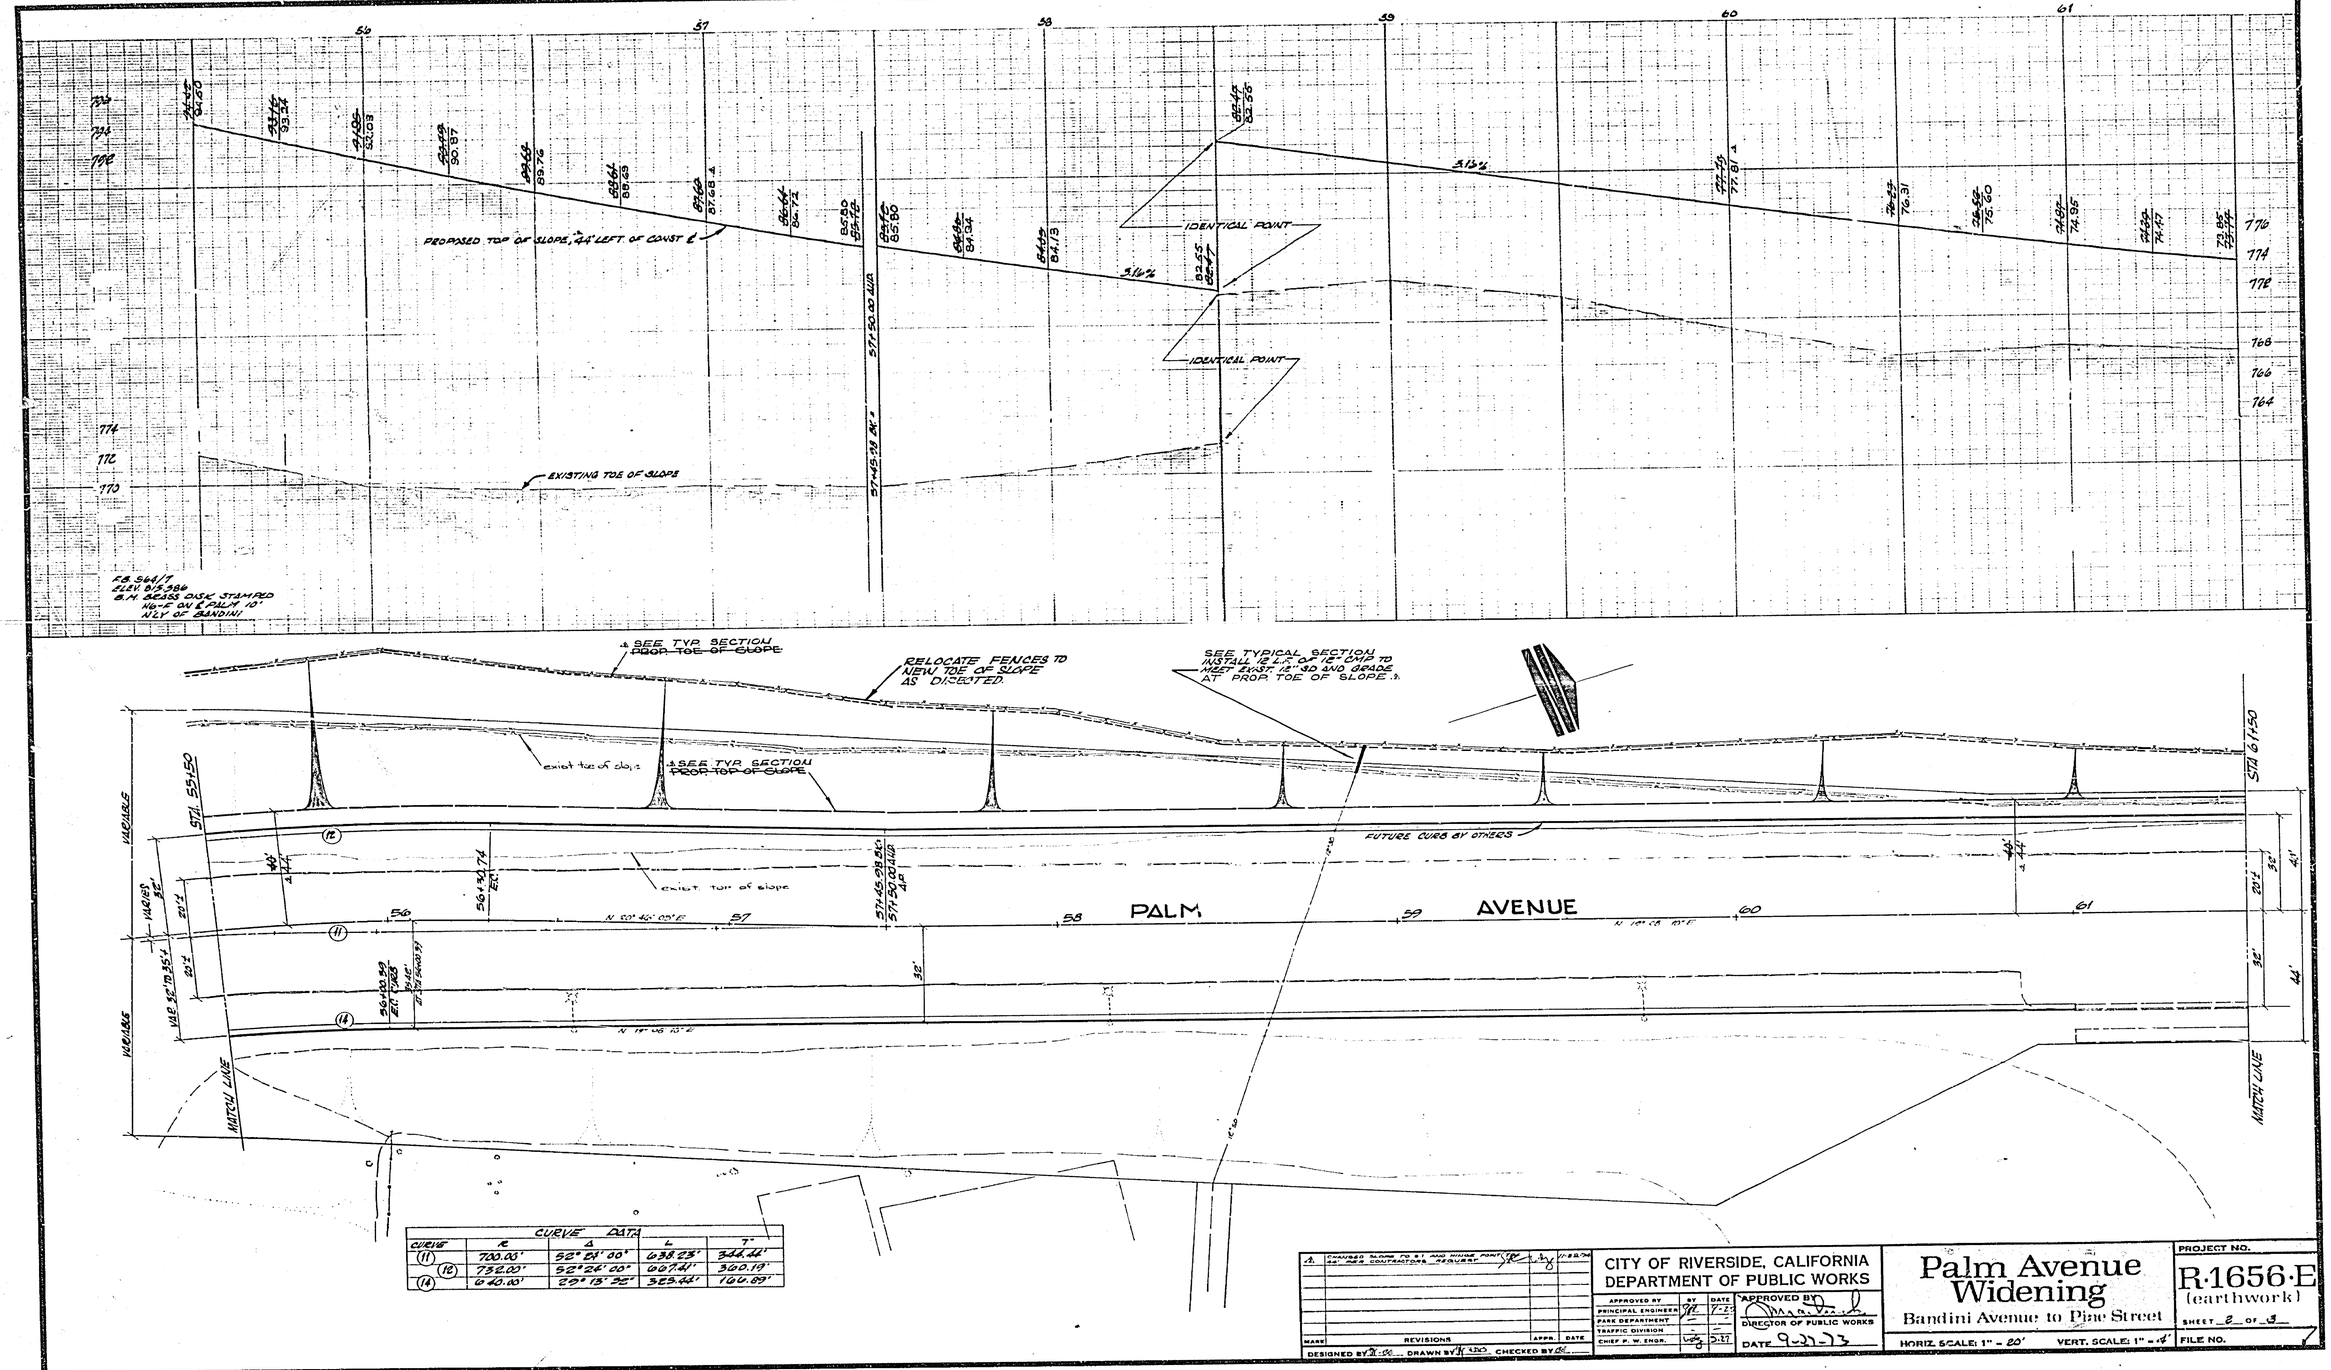

CURVE DATA				
CURVE	R	Δ	L	T

	REVISIONS	APPR.	DATE
A	CHANGED SLOPE TO 2:1 AND MINOR POINT AS PER CONTRACTOR REQUEST	JW	11-22-74

DESIGNED BY J.C. DRAWN BY J.C.D. CHECKED BY DC

CITY OF RIVERSIDE, CALIFORNIA
DEPARTMENT OF PUBLIC WORKS

APPROVED BY	BY	DATE
PRINCIPAL ENGINEER	JW	7-23
PARK DEPARTMENT	—	—
TRAFFIC DIVISION	—	—
CHIEF P. W. ENGR.	[illegible]	9-27

APPROVED BY
DIRECTOR OF PUBLIC WORKS
DATE 9-27-73

Palm Avenue Widening

Bandini Avenue to Pine Street

HORIZ. SCALE: 1" = 20' VERT. SCALE: 1" = 4'

PROJECT NO.
R-1656-E
(earthwork)
SHEET 2 OF 3
FILE NO.

CURVE DATA				
CURVE	R	Δ	L	T
(19)	1000.00'	18° 11' 00"	334.81'	168.99'
(16)	369.10	17° 16' 00"	190.95'	146.27'

RELOCATE FENCES TO NEW TOE OF SLOPE AS DIRECTED

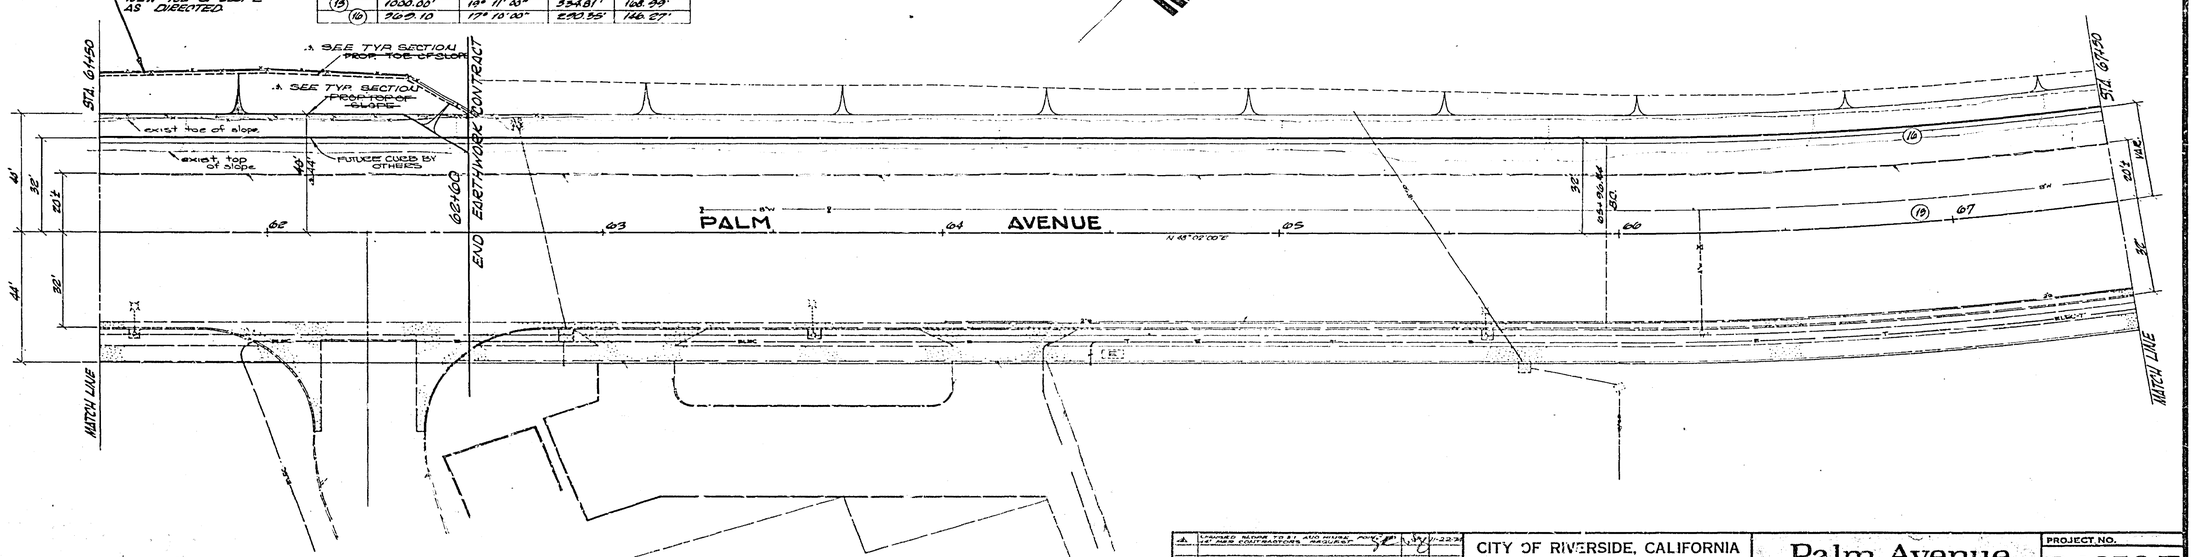

REVISIONS			
MARK		APPR	DATE

DESIGNED BY [illegible] DRAWN BY [illegible] CHECKED BY [illegible]

CITY OF RIVERSIDE, CALIFORNIA
DEPARTMENT OF PUBLIC WORKS

APPROVED BY	BY	DATE
PRINCIPAL ENGINEER	[illegible]	11-27-73
PARK DEPARTMENT	—	—
TRAFFIC DIVISION	—	—
CHIEF P. W. ENGR.	[illegible]	11-29-73

APPROVED BY [illegible]
DIRECTOR OF PUBLIC WORKS
DATE 9-21-73

Palm Avenue Widening
Bandini Avenue to Pine Street

HORIZ. SCALE: 1" = 20' VERT. SCALE: 1" = 4'

PROJECT NO. R-1656-E (earthwerk)
SHEET 3 OF 3
FILE NO.