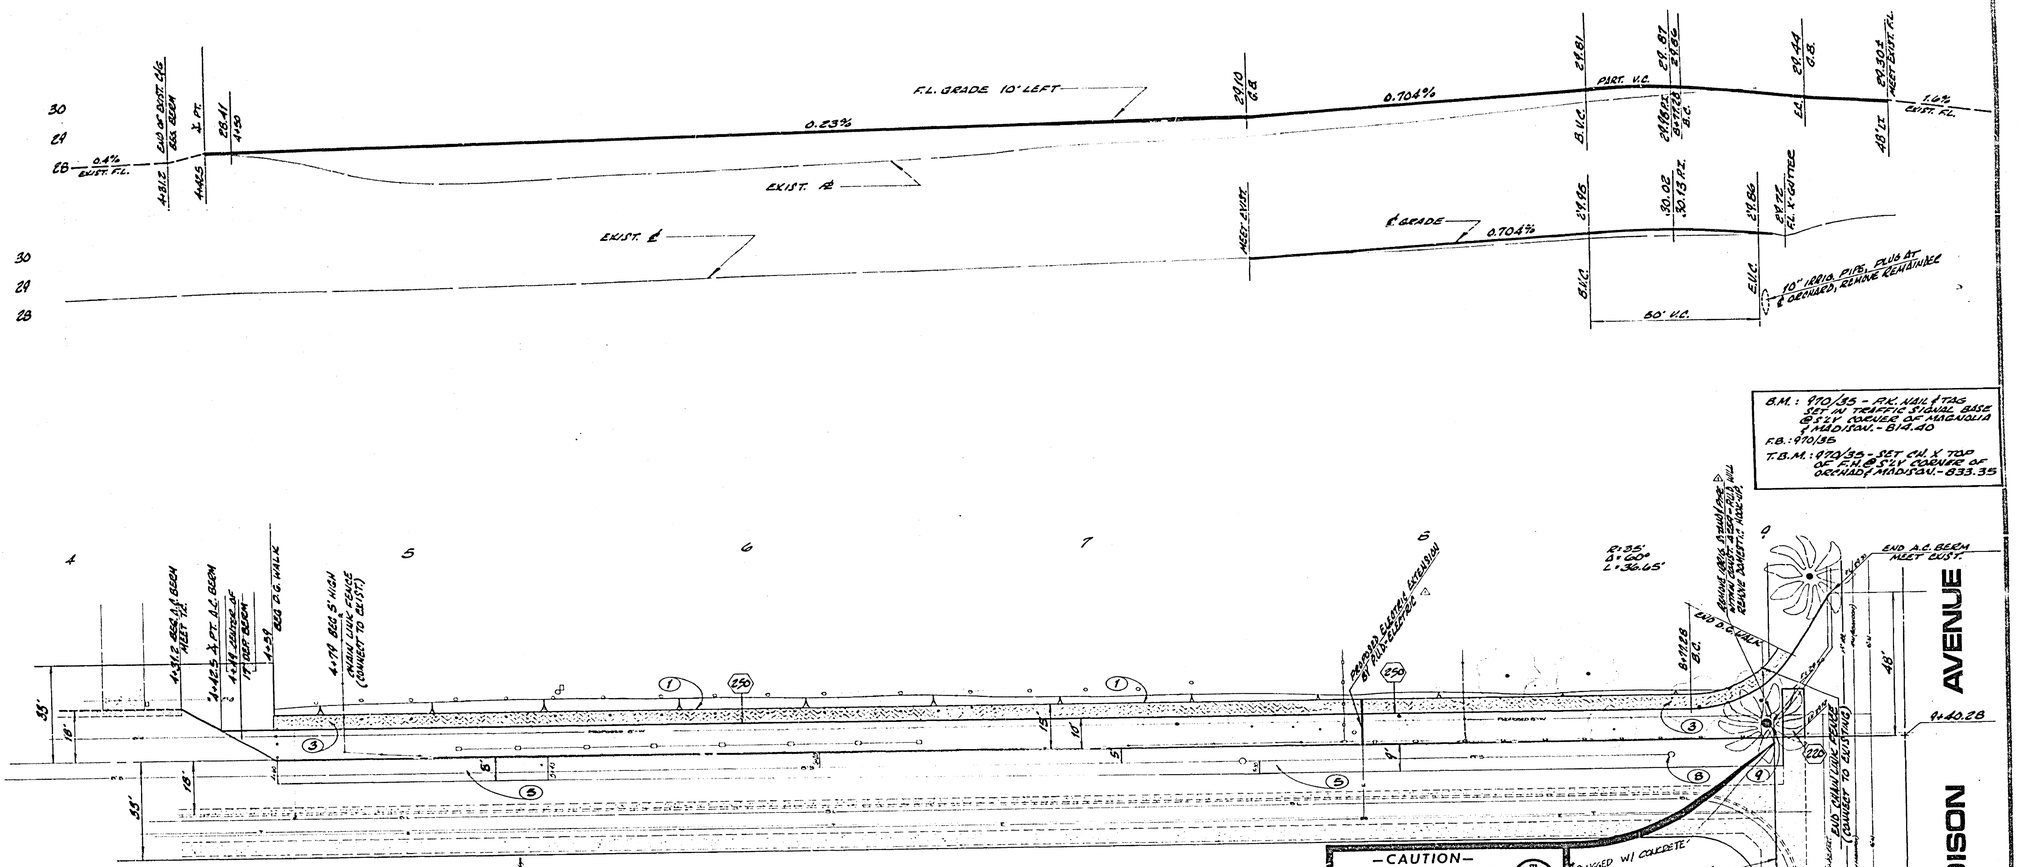

CONSTRUCTION NOTES

1. CONSTRUCTION SHALL BE IN ACCORDANCE WITH STANDARD SPECIFICATIONS FOR PUBLIC WORKS CONSTRUCTION, 1973 EDITION.
2. REMOVE ALL OBSTRUCTIONS WITHIN THE STREET RIGHT OF WAY AND WHERE REQUIRED FOR FILL CONSTRUCTION.

(250) INDICATES EXTEND EXIST. X-GUTTER BY 16'

(250) INDICATES TO CONST. TYPE I A.C. BERM AS PER STD. DWG. NO. 250

(1) INSTALL 5' HIGH CHAIN LINK FENCE ALONG ℄

(3) CONSTRUCT 4" THICK D.G. WALKWAY
(4) REMOVE EXIST. REDWOOD HEADER
(5) A.C. OVERLAY (VARIABLE THICKNESS)
(6) PLACE 0.21' OF A.C. PAVEMENT
(7) PLACE 0.67' OF SC. 3" CT NATURAL BASE
(8) ADJUST C.O. TO GRADE
(9) BALL PALM TREE AND TRANSPORT TO CITY NURSERY

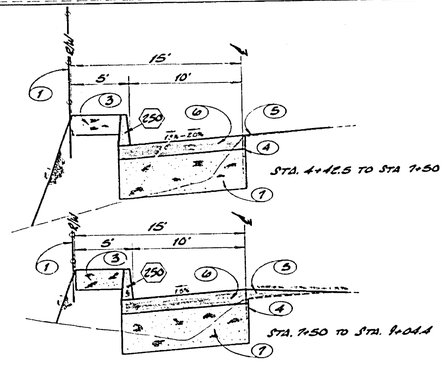

TYPICAL SECTIONS
SCALES: HORZ.-1"=6' VERT.-1"=1'

* "AS BUILT" E.K. 11/22/74

3	ADDED INDEX LINE & MADISON AVE.		7/30/74
2	ADDED INDEX & AVE.		7/25/74
1	REV. NOTES		6/24/74
MARK	REVISION	APPR.	DATE

DRAWN: [illegible] CHECKED: [illegible] CHECKED: [illegible]

CITY OF RIVERSIDE
PUBLIC WORKS DEPARTMENT

APPROVALS

PUBLIC WORKS ENGINEER	[illegible]	5-16
PARK DEPARTMENT	[illegible]	5-16
TRAFFIC DIVISION	[illegible]	5-16
TRAFFIC ENGINEER	[illegible]	5-16

APPROVED BY: [signature]
PUBLIC WORKS DIRECTOR
DATE 5-15-74

ORCHARD STREET WIDENING

Madison Avenue to 500' westerly

HORIZ. SCALE: 1" = 20' VERT. SCALE: 1" = 2'

ACCOUNT NO. 30-575-260-07

R-1730

SHEET 1 OF 1

FILE NO.