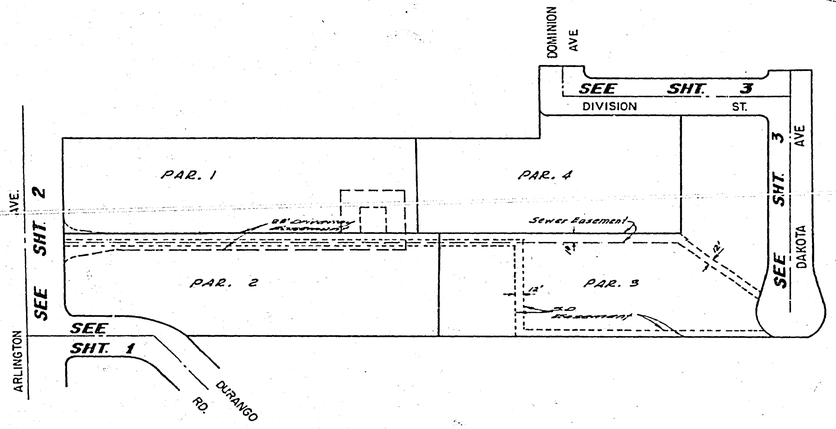

INDEX MAP
No Scale

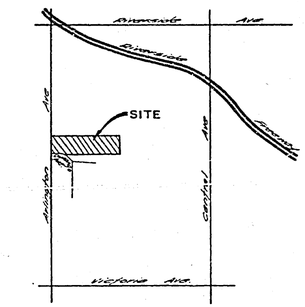

VICINITY MAP
No Scale

GENERAL NOTES

1. Construction shall be in accordance with the Standard Specifications for Public Works Construction 1979, Section 200 Latest City of Riverside Standard Drawings.
2. All flagged elevations shall be staked in the field by the Engineer.
3. The contractor shall arrange for a soil test to be made by a soils engineer after the grading has been completed to subgrade. Copies of these reports shall be delivered to the Engineer of Work and the City of Riverside Design Standards and Specifications.
4. Curb and Gutter to be staked at a 3' offset and at 25' intervals.
5. Traffic control signs must be in place prior to opening the street to traffic.
6. Construct Wheelchair Ramps per City of Riverside Std. No. 304.
7. It shall be the responsibility of the Contractor to stake the grid of row in accordance with the provisions of law as it affects each utility including irrigation lines and appurtenances, and at no cost to the City.
8. See "Street Lighting Plan" for number and location of street lights.
9. Contact Signal Maintenance at 787-7570 72 hours prior to start of work in area of Arlington Ave. & Durango Road.

BENCH MARK

At nail and City tag in top of retaining wall on south side of Arlington Ave. 151' W/ of centerline of "A" St. City of Riverside Elevation: 852.41 No. 8-G-11

STREET NAME & TRAFFIC CONTROL SIGN SCHEDULE		
Ⓐ	DOMINION AVE.	3200
	DIVISION ST.	5600
Ⓑ	DIVISION ST.	5600
	DAKOTA AVE.	3100
Ⓒ	W53R 24"x 24" (Not a through street)	
Ⓓ	R1 - (STOP SIGN) 30" OCTAGON	

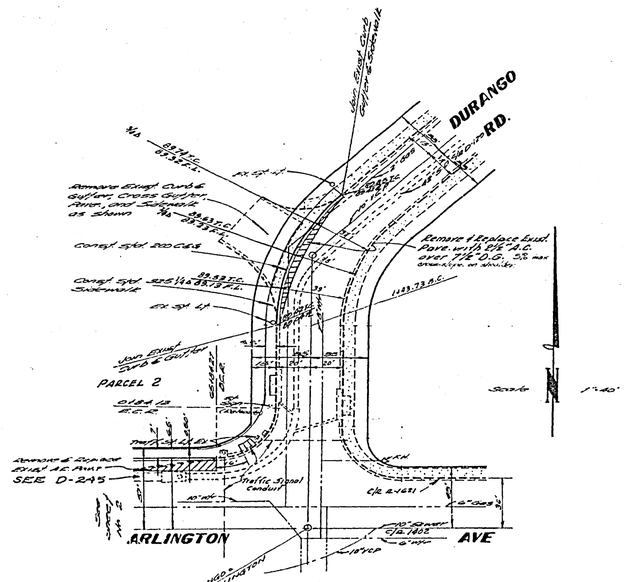

PLAN
DURANGO ROAD

"AS BUILT 3-77 KPT

INDEXED WB

ALBERT A. WEBB ASSOCIATES
CIVIL ENGINEERS
RIVERSIDE, CALIFORNIA
APPROVED BY [signature] DATE 4/30/14
R.E. No. 2424
W.O. 75-227 FOR: Sterling Devel. F.B. 1012

MARK	REVISIONS	APPR.	DATE

DESIGNED BY EMC DRAWN BY EMC CHECKED BY [illegible]

CITY OF RIVERSIDE, CALIFORNIA
PUBLIC WORKS DEPARTMENT

APPROVED BY	BY	DATE
PRINCIPAL ENGINEER	[illegible]	11/7/77
PARK DEPARTMENT	—	—
TRAFFIC DIVISION	[illegible]	11/7/77
CHIEF PUBLIC WKS. ENGR.	[illegible]	11-22-77

APPROVED BY [signature]
DIRECTOR OF PUBLIC WORKS
DATE 11-22-77

STREET PLAN AND PROFILE
INDEX MAP
SIDEWALK DURANGO RD.
PARCEL MAP NO. 123

ACCOUNT No.
DRAWING NUMBER
R-1762
SHEET 1 OF 3
SCALE As noted
75-227-A



















SEE SHEET ONE FOR GENERAL NOTES

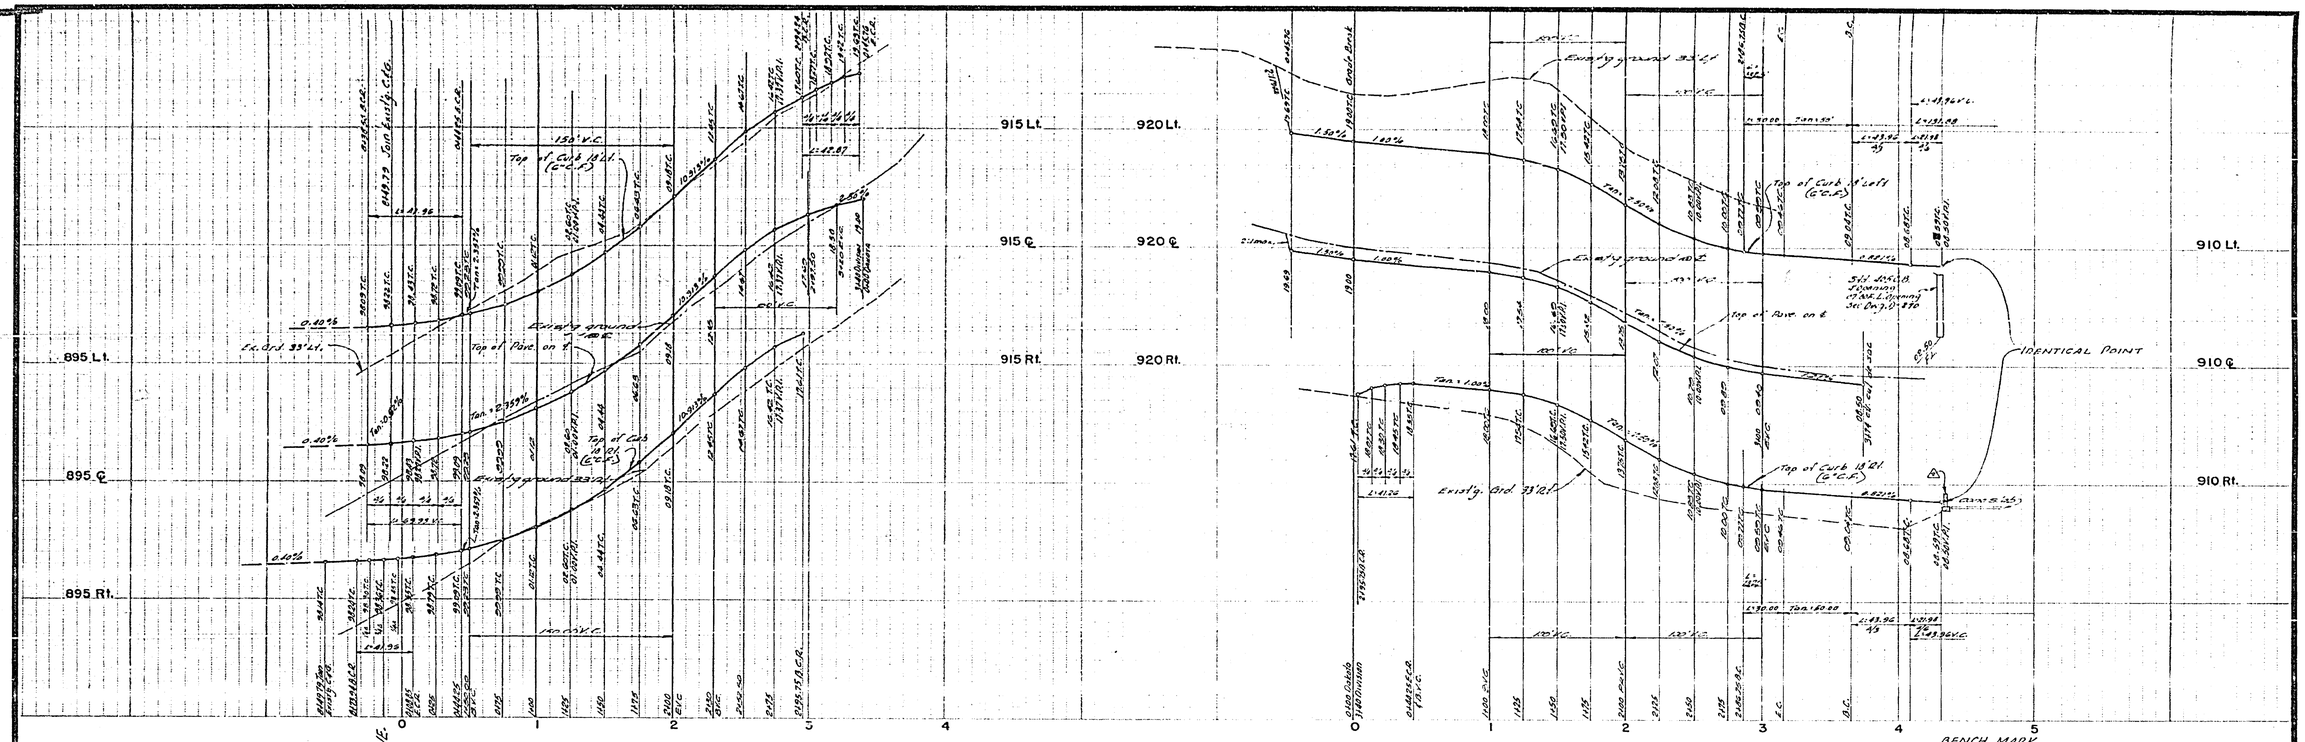

SEE SHEET ONE FOR GENERAL NOTES

BENCH MARK
PK nail and City tag in top of retaining wall on south side of Arlington Ave. 75'± W'ly. of Horace St.
Elev. 889.41'. No. G-6-H. City T.B. 938 17. No. G-6-H

"AS BUILT 3-77 KPT

ALBERT A. WEBB ASSOCIATES CIVIL ENGINEERS RIVERSIDE, CALIFORNIA APPROVED BY _____ DATE 4/30/76 R.E. No. 9876 W.O. 75-227 FOR: Sterling Davel. F.B. 1012	2 Added note for opening in barricade (DAVID) 10/1/76 1 Added Wall Info. Per "As Built" Condition and Rt. of Pub. Wks. Ltr. (DAVID) 9/10/76 MARK REVISIONS APPR. DATE DESIGNED BY AJC DRAWN BY _____ CHECKED BY _____	CITY OF RIVERSIDE, CALIFORNIA PUBLIC WORKS DEPARTMENT APPROVED BY / DATE PRINCIPAL ENGINEER (illegible) 12/13 PARK DEPARTMENT (illegible) 6-13 TRAFFIC DIVISION (illegible) ASST. PUB. WKS. ENGR. (illegible) 11-26 CITY ENGR. 0
APPROVED BY _____ DIRECTOR OF PUBLIC WORKS DATE 11-26-76	STREET PLAN AND PROFILE DIVISION STREET DAKOTA AVENUE PARCEL MAP NO. 123 SCALE: HORIZ. 1"=50' VERT. 1"=5'	ACCOUNT No. DRAWING NUMBER R-1762 SHEET 3 OF 3 75-227-A