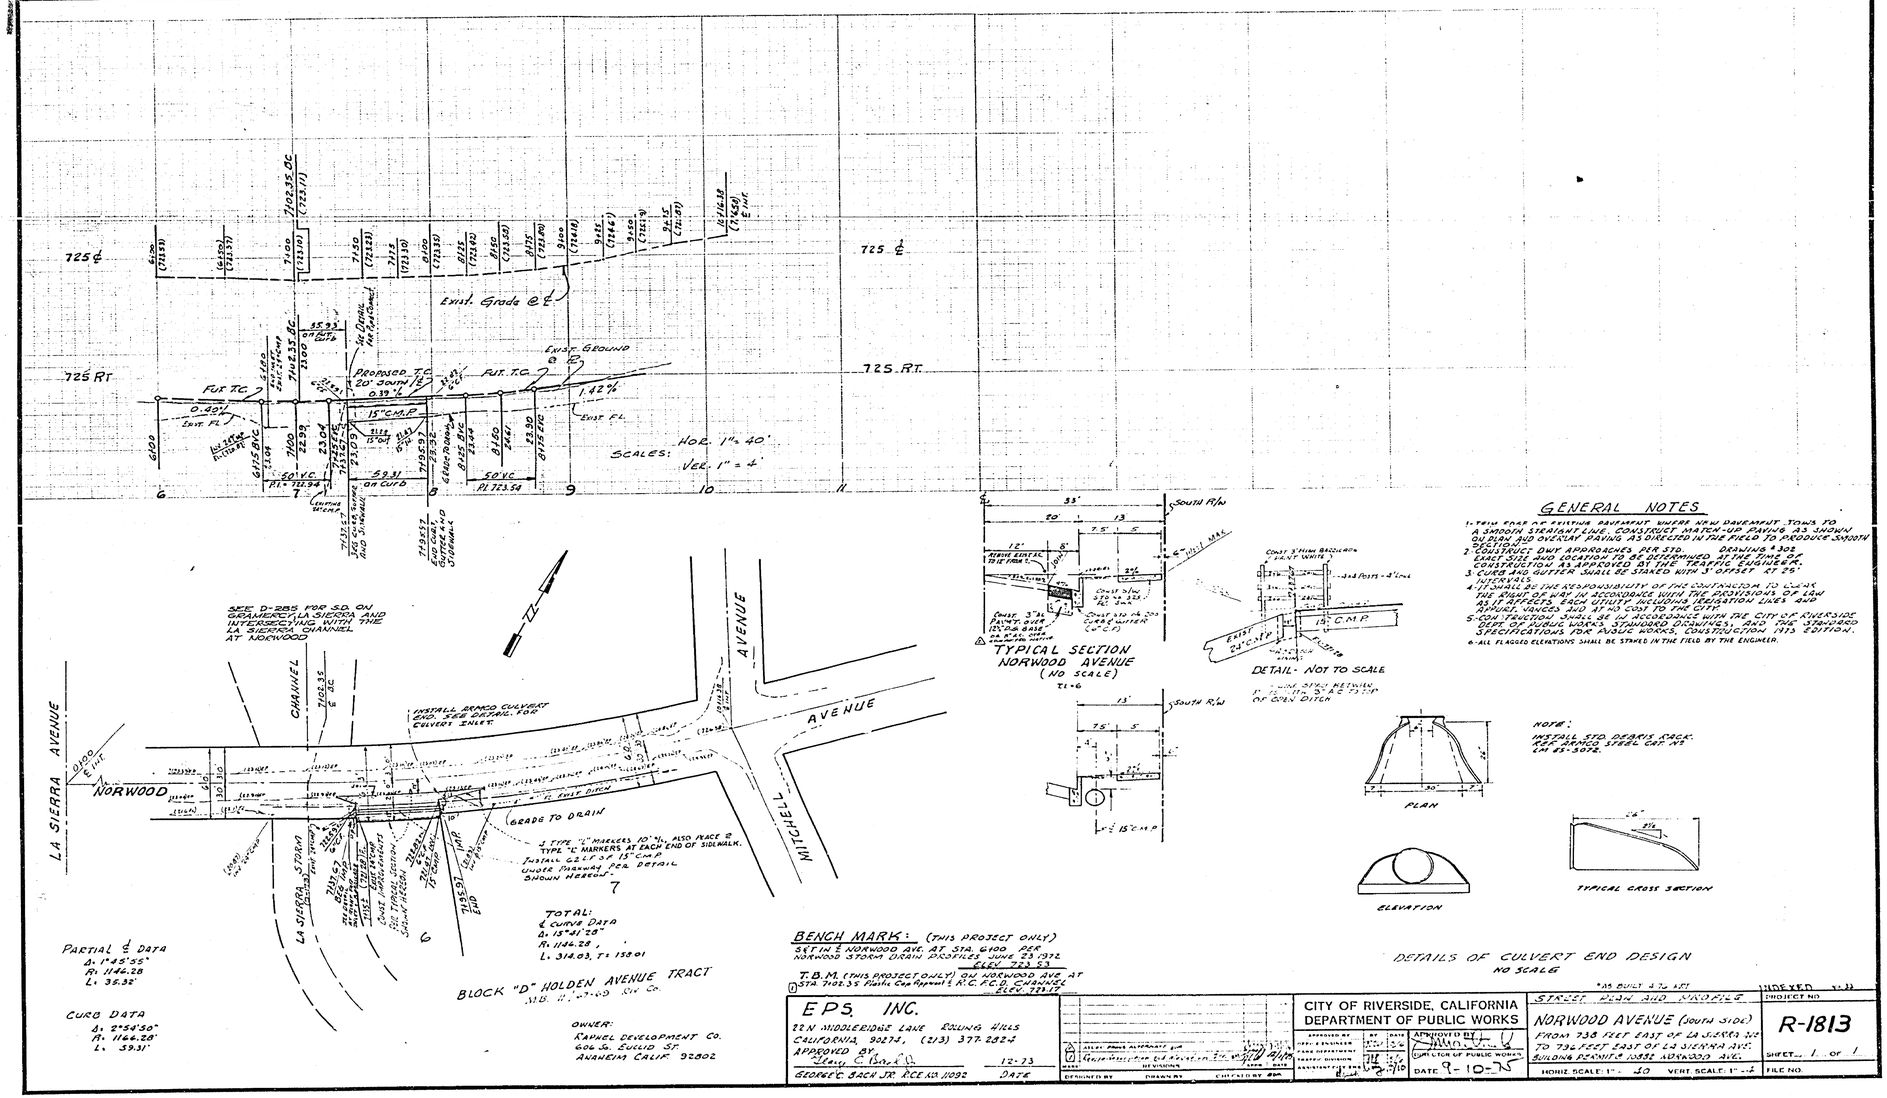

GENERAL NOTES

1. TRIM EDGE OF EXISTING PAVEMENT WHERE NEW PAVEMENT TIES TO A SMOOTH STRAIGHT LINE. CONSTRUCT MATCH-UP PAVING AS SHOWN ON PLAN AND OVERLAY PAVING AS DIRECTED IN THE FIELD TO PRODUCE SMOOTH SECTION.
2. CONSTRUCT DWY APPROACHES PER STD. DRAWING # 302 EXACT SIZE AND LOCATION TO BE DETERMINED BY THE TIME OF CONSTRUCTION AS APPROVED BY THE TRAFFIC ENGINEER.
3. CURB AND GUTTER SHALL BE STAKED WITH 3' OFFSET AT 25' INTERVALS.
4. IT SHALL BE THE RESPONSIBILITY OF THE CONTRACTOR TO CLEAR THE RIGHT OF WAY IN ACCORDANCE WITH THE PROVISIONS OF LAW AS IT AFFECTS EACH UTILITY INCLUDING IRRIGATION LINES AND REPAIRS, VARIES AND AT NO COST TO THE CITY.
5. CONSTRUCTION SHALL BE IN ACCORDANCE WITH THE CITY OF RIVERSIDE DEPT. OF PUBLIC WORKS STANDARD DRAWINGS, AND THE STANDARD SPECIFICATIONS FOR PUBLIC WORKS, CONSTRUCTION 1973 EDITION.
6. ALL FLAGGED ELEVATIONS SHALL BE STAKED IN THE FIELD BY THE ENGINEER.

NOTE:

BENCH MARK: (THIS PROJECT ONLY)
SET IN ℄ NORWOOD AVE. AT STA. 6100 PER NORWOOD STORM DRAIN PROFILES JUNE 23 1972
ELEV. 723.53

T.B.M. (THIS PROJECT ONLY) ON NORWOOD AVE. AT STA. 7102.35 (Hatch Cap Hydrant) R.C.F.C.D. CHANNEL
ELEV. 723.17

EPS INC.
22 N MIDDLERIDGE LANE ROLLING HILLS
CALIFORNIA 90274, (213) 377-2824
APPROVED BY: George C. Bach 12-73
GEORGE C. BACH JR. RCE NO 11092 DATE

REVISIONS

CITY OF RIVERSIDE, CALIFORNIA
DEPARTMENT OF PUBLIC WORKS
APPROVED BY: DIRECTOR OF PUBLIC WORKS
DATE 9-10-75

STREET PLAN AND PROFILE
NORWOOD AVENUE (South Side)
FROM 738 FEET EAST OF LA SIERRA AVE. TO 796 FEET EAST OF LA SIERRA AVE.
BUILDING PERMITS 10851 NORWOOD AVE.
HORIZ. SCALE: 1" = 40 VERT. SCALE: 1" = 4

"AS BUILT" 4-76 KFT

REVISED

PROJECT NO. R-1813
SHEET 1 OF 1
FILE NO.