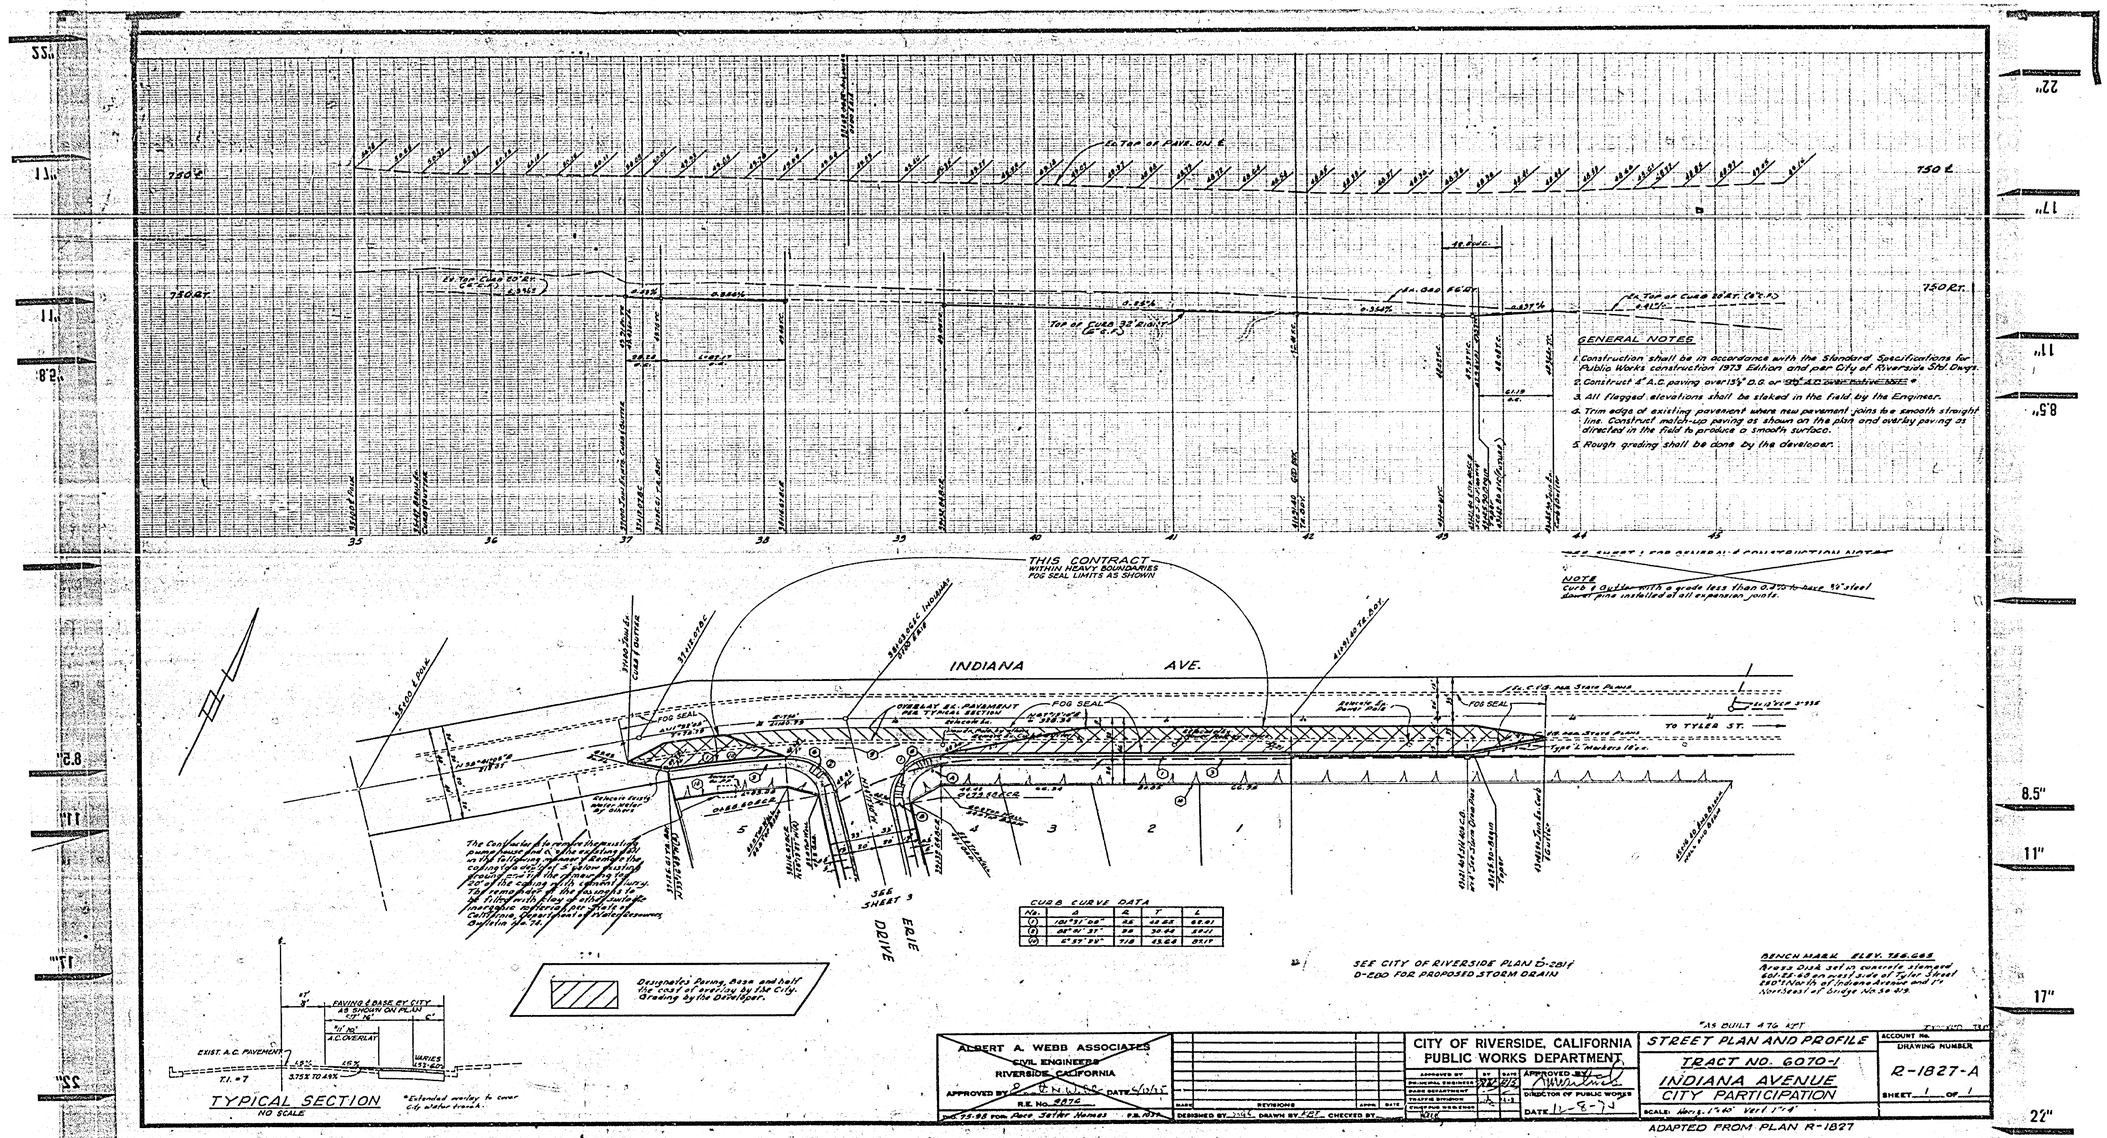


GENERAL NOTES

1. Construction shall be in accordance with the Standard Specifications for Public Works construction 1973 Edition and/or City of Riverside Std. Dwgs.
2. Construct 4" A.C. paving over 13½" D.B. on 95% R.C.S.M. subgrade.
3. All flagged elevations shall be staked in the field by the Engineer.
4. Trim edge of existing pavement where new pavement joins to a smooth straight line. Construct match-up paving as shown on the plan and overlay paving as directed in the field to produce a smooth surface.
5. Rough grading shall be done by the developer.

NOTE
Curb & Gutter with a grade less than 0.70% to have 40' steel dowel pins installed at all expansion joints.

ALBERT A. WEBB ASSOCIATES
CIVIL ENGINEERS
RIVERSIDE, CALIFORNIA
APPROVED BY [illegible] DATE 6/10/57
R.E. No. 8876
Doc. 73.98 from Rice Jaffe Homes P.B. 17/1

CITY OF RIVERSIDE, CALIFORNIA
PUBLIC WORKS DEPARTMENT

| APPROVED BY | DATE |
|---|---|
| PRINCIPAL ENGINEER | 12/6/57 |
| PARK DEPARTMENT | |
| TRAFFIC DIVISION | |
| SUPERVISOR WATER DIST. | |

APPROVED BY [signature]
DIRECTOR OF PUBLIC WORKS
DATE 12-8-57

| REVISIONS | APPR. | DATE |
|---|---|---|
| | | |

DESIGNED BY JWMS DRAWN BY JGT CHECKED BY

STREET PLAN AND PROFILE
TRACT NO. 6070-1
INDIANA AVENUE
CITY PARTICIPATION
SCALE: Horiz. 1"=40' Vert 1"=4'

ACCOUNT No.
DRAWING NUMBER R-1827-A
SHEET 1 OF 1

"AS BUILT 4/6 KPT