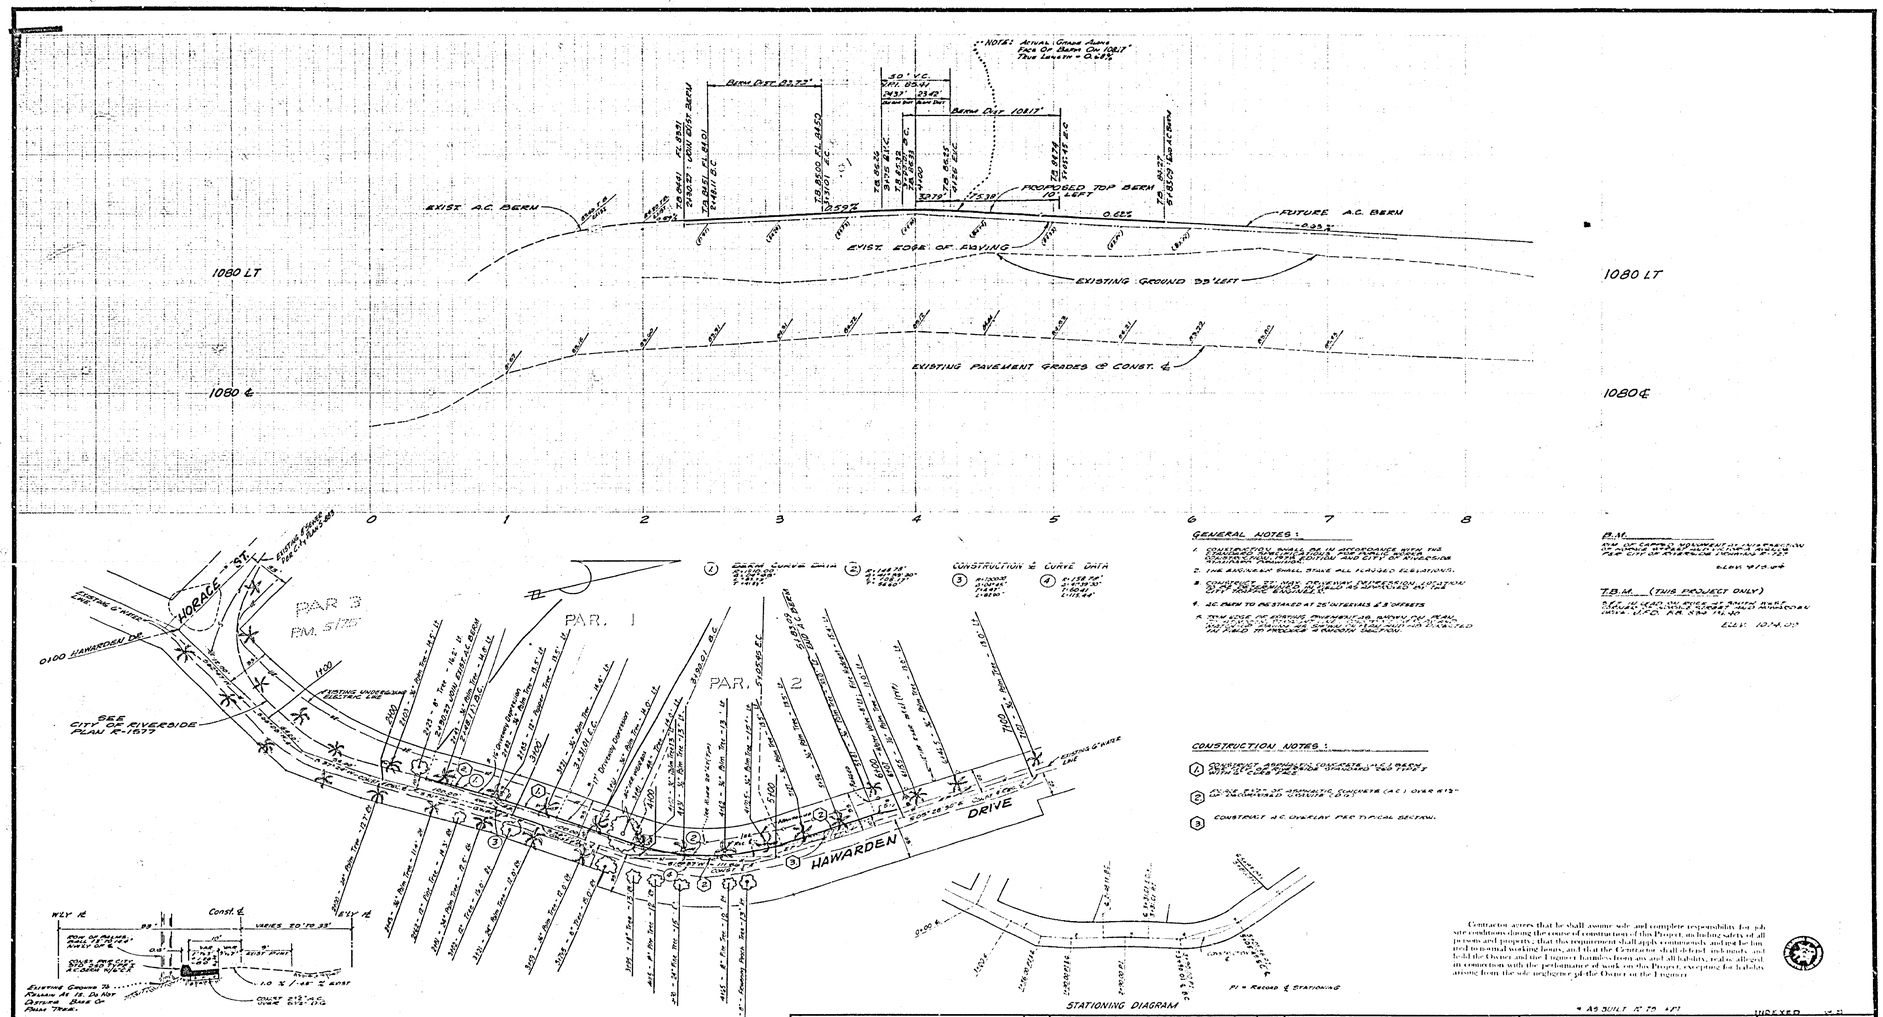

GENERAL NOTES:

1. CONSTRUCTION SHALL BE IN ACCORDANCE WITH THE STANDARD SPECIFICATIONS FOR PUBLIC WORKS CONSTRUCTION, 1976 EDITION AND CITY OF RIVERSIDE STANDARD DRAWINGS.
2. THE ENGINEER SHALL STAKE ALL FLAGGED ELEVATIONS.
3. CONTRACTOR SHALL MAY REVIEW DEPRESSION LOCATION TO BE DETERMINED AS APPROVED BY THE CITY TRAFFIC ENGINEER.
4. A.C. PATH TO BE STAKED AT 25' INTERVALS & 5' OFFSETS
5. TOW EDGE OF BERMS, DIVERSIONS, AROUND ON PEAK, AND TOP OF BERMS SHALL BE SHOWN ON PLAN AND AS FIELD TO PROVIDE A SMOOTH SECTION.

CONSTRUCTION NOTES:

1. CONSTRUCT APPROVED CONCRETE A.C. BERM WITH 6" CLASS FIG.
2. FINISH PATH OF ASPHALTIC CONCRETE (A.C.) OVER 8½" OF DECOMPOSED GRANITE (D.G.)
3. CONSTRUCT A.C. OVERLAY PER TYPICAL SECTION.

B.M.

T.B.M. (THIS PROJECT ONLY)

Contractor agrees that he shall assume sole and complete responsibility for job site conditions during the course of construction of this Project, including safety of all persons and property; that this requirement shall apply continuously and not be limited to normal working hours, and that the Contractor shall defend, indemnify, and hold the Owner and the Engineer harmless from any and all liability, real or alleged, in connection with the performance of work on this Project, excepting for liability arising from the sole negligence of the Owner or the Engineer.

* AS BUILT R 75 +PT

J. F. DAVIDSON ASSOCIATES
CIVIL ENGINEERS - SURVEYORS - PLANNERS
RIVERSIDE, CALIFORNIA
APPROVED BY [signature] DATE 8-7-75
R.E. No. 1369
W.O. 4450 FOR: R.S. WHITE F.B. 1014

MARK | REVISIONS | APPR. | DATE
DESIGNED BY R.F. DRAWN BY G.H. CHECKED BY [illegible]

CITY OF RIVERSIDE, CALIFORNIA
DEPARTMENT OF PUBLIC WORKS

APPROVED BY
PRINCIPAL ENGINEER
PARK DEPARTMENT
TRAFFIC DIVISION
CHIEF P.W. ENGR.
APPROVED BY [signature]
DIRECTOR OF PUBLIC WORKS
DATE 9-22-75

HAWARDEN DRIVE
230' NORTHEASTERLY OF HORACE STREET TO 881' NORTHEASTERLY
FOR PM 218
HORIZ. SCALE: 1" = 40' VERT. SCALE: 1" = 4'

PROJECT NO. R-1834
SHEET 1 OF 1
FILE NO. 4450