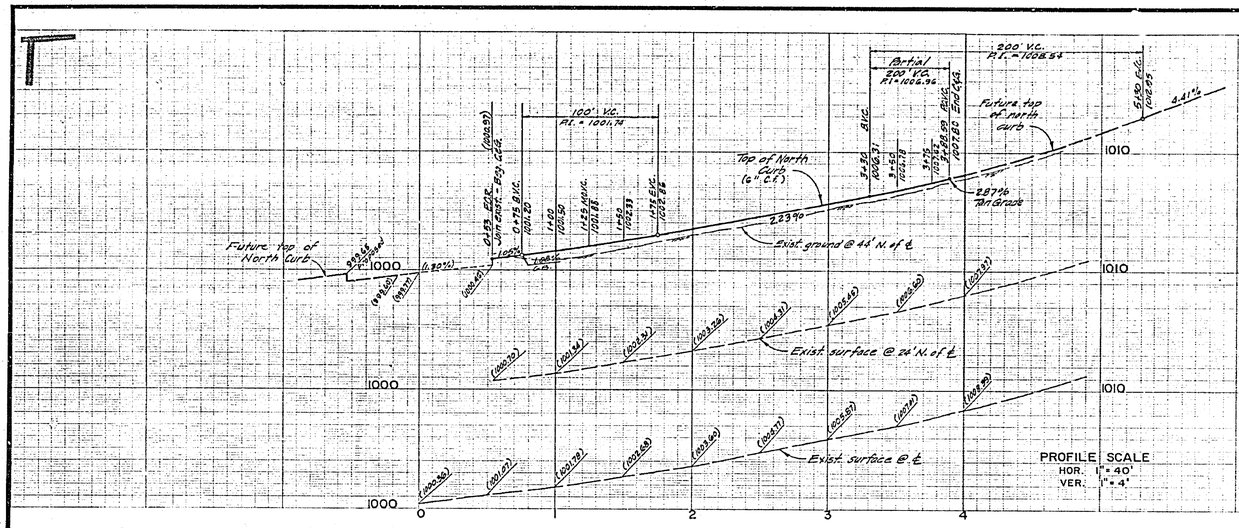

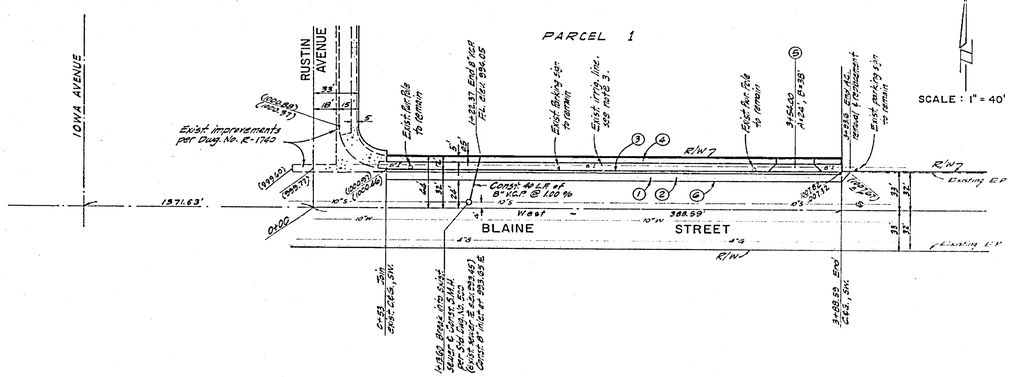

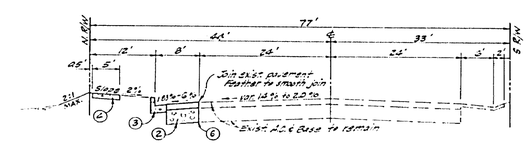

PROPOSED SECTION - BLAINE STREET
T.I. = 7

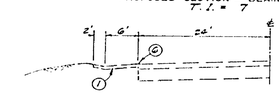

EXISTING SECTION

TYPICAL SECTION - BLAINE ST.

BENCH MARK Elev. 977.27

Top of N.W. bolt at base of pedestrian signal control button stand on N.W. corner of Blaine St. & Iowa Ave.
C.R.F.B. 951/19

CONSTRUCTION NOTES & QUANTITY ESTIMATES

1	Remove exist. pavement	2710	S.F.
2	Const. 4" A.C. over 10" D.G.	2030	S.F.
3	Const. P.C.C. Curb & Gutter, type I, 3" C.F., per Std. Dwg. No. 200	336	L.F.
4	Const. P.C.C. Sidewalk per Std. Dwg. No. 325	1540	S.F.
5	Const. P.C.C. Driveway Approach per Std. Dwg. No. 302	338	S.F.
6	Sawcut exist. pavement		

GENERAL NOTES

1. All work done shall be in accordance with "Standard Specifications for Public Works Construction, 1973 Edition, and City of Riverside Standard Drawings.
2. The Contractor shall be responsible for protecting all utility lines and existing improvements; and shall repair or replace in kind at his own expense any lines or improvements damaged by his operations during construction.
3. The Contractor shall remove or crush in place the existing 8" irrigation line shown 35'± from ℄ Blaine St. Plug exposed end with mortar.
4. It shall be the responsibility of the contractor to clear the Right of Way in accordance with the provisions of law as it affects each utility including irrigation lines and appurtenances and at no cost to the City.
5. Trim edge of exist. pavement where new pavement joins to a smooth, straight line. Construct match-up paving as shown on plan and overlay paving as directed in the field to produce a smooth section.
6. Curb and gutter shall be staked with 3' offsets at 25' intervals.
7. Contractor is to verify existing sewer elevation prior to construction.
8. Quantities shown are for information only and the City of Riverside is not responsible for their accuracy.

*AS BUILT 3-77 KFT

THE GAGE CANAL COMPANY C.C. Hare 12/5/75 APPROVED BY DATE	PREPARED BY... L.D. KING ENGINEERING CO., INC. 187 W. ORANGETHORPE AVE. SUITE E PLACENTIA, CA. (714) 993-6060 Everett Kjeroff 4 Dec 75 RCE 23056 DATE	DESIGNED BY / DRAWN BY / CHECKED BY	CITY OF RIVERSIDE, CALIFORNIA DEPARTMENT OF PUBLIC WORKS APPROVED BY / DIRECTOR OF PUBLIC WORKS DATE 12-16-75	PLAN AND PROFILE BLAINE STREET RUSTIN AVE. TO 388' EASTERLY P.M. 254 HORIZ. SCALE: 1" = 40' VERT. SCALE: 1" = 4'	PROJECT NO. R-1847 SHEET 1 OF 1 FILE NO.