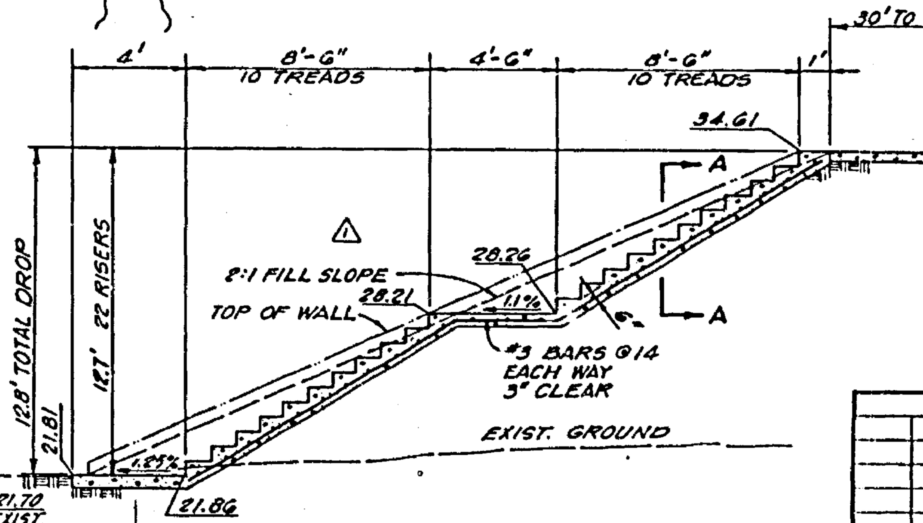

STAIRWAY DETAIL
NOT TO SCALE

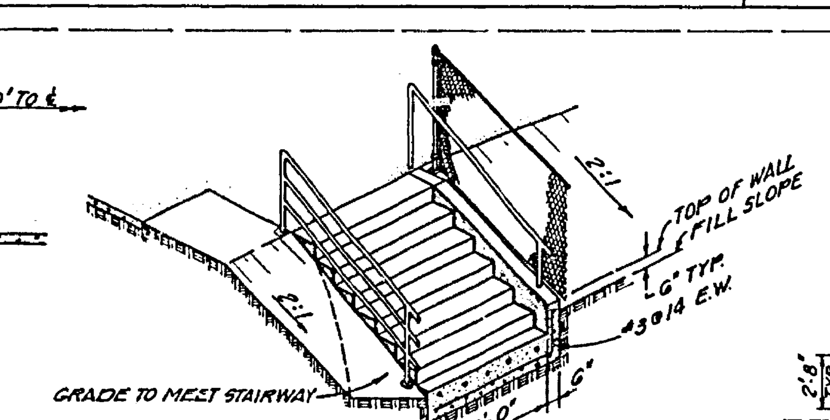

SECTION A-A

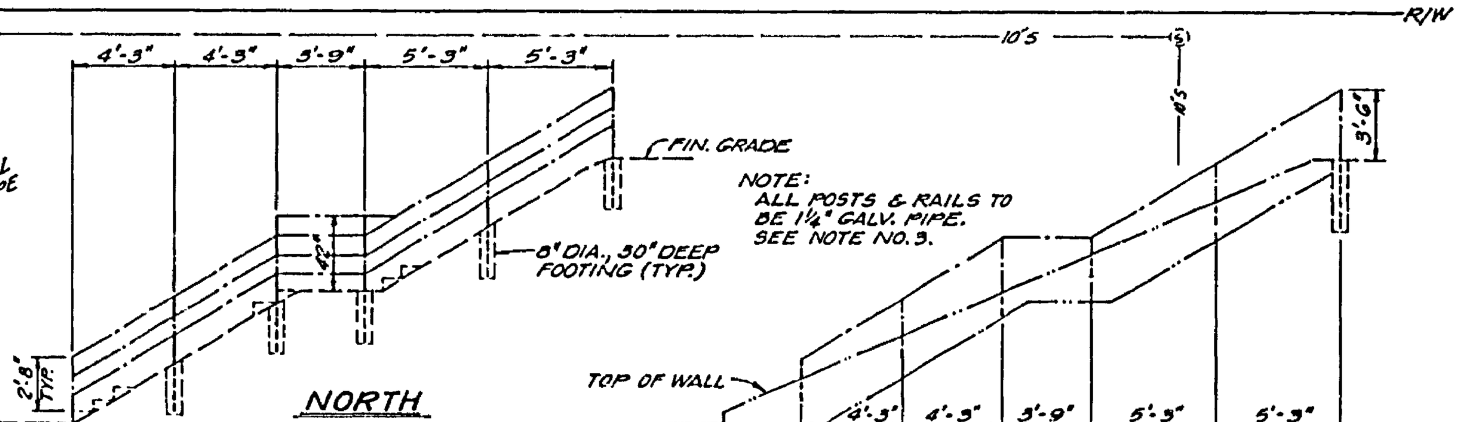

HANDRAIL ELEVATIONS

NOTES:

1. CONSTRUCTION TO BE IN ACCORDANCE WITH STD. SPECIFICATIONS FOR PUBLIC WORKS CONSTRUCTION, 1973 EDITION.
2. FOR CONSTRUCTION LEGEND SEE PLAN R-1856

(405) CONSTRUCT CATCH BASIN PER STD. DWG. NO. 405 AT STA. 34 + 72.5. CURB FACE AS SHOWN. EXTEND 12" CMP @ 2%. REMOVE EXISTING CATCH BASIN.

3. HANDRAIL CONSTRUCTION MUST CONFORM TO U.B.C. SHOP DRAWINGS REQUIRED.

MARK	REVISIONS	APPR.	DATE
1	Added elevs. to stairway KPT		7/13/76

DESIGNED BY ___ DRAWN BY KPT CHECKED BY ___

CITY OF RIVERSIDE
PUBLIC WORKS DEPARTMENT

APPROVED BY		
PRINCIPAL ENGINEER		6/23
PARK DEPARTMENT		
TRAFFIC DIVISION		6/28
CHIEF P. W. ENGINEER		6.30

APPROVED BY
PUBLIC WORKS DIRECTOR
DATE 7-1-76

ORANGE STREET IMPROVEMENTS
WESTERLY SIDE
HCD PROJECT

ALONG FREMONT SCHOOL

HORIZ. SCALE: 1" = 20' VERT. SCALE: 1" = 2'

ACCOUNT NO. 15-550-450

R-1856-A

SHEET 1 OF 1

FILE NO.