RIVERSIDE CALIFORNIA

PUBLIC WORKS DEPARTMENT

CENTRAL AVENUE BIKEWAY

CHAPALA TO U.S. 395

PROJECT LENGTH: 6300'

SPECIAL CONSTRUCTION NOTES

CONSTRUCT A.C. BIKEWAY 6' WIDE 0.25' THICK.

PLACE 4" OR 2½" A.C. OVER COMPACTED NATIVE SOIL AS SHOWN ON PLAN.

NUMBERS ABOVE 100 SHOWN IN ⬡ ON THE PLAN REFER TO THE RESPECTIVE STANDARD DRAWING NUMBERS AND SHALL BE CONSTRUCTED ACCORDINGLY UNLESS MODIFICATIONS ARE NOTED ON PLAN OF THIS SHEET BELOW. ANY NUMBER SHOWN BELOW THE STANDARD DRAWING NUMBER INDICATES THE SPECIFIC ALTERNATE TO BE CONSTRUCTED.

CONSTRUCT DOWN DRAIN PER DETAIL ON SHEET #6.*

EXISTING UNDERGROUND UTILITIES:

SANITARY SEWER	—8"S—	TELEPHONE CONDUIT	—T—
WATER LINE	—6"W—	ELECTRICAL CONDUIT	—E—
STORM DRAIN	—24"S.D—	STREET LIGHTING	—SL—
GAS LINE	—3"G—	TRAFFIC SIGNAL	—SIG—
IRRIGATION LINE	—20"IRR—	FIRE ALARM	—F—

EXISTING TOPOGRAPHY:

- BLOCK WALL
- BOARD FENCE
- WIRE FENCE
- CHAIN LINK FENCE
- TOP OF SLOPE
- TOE OF SLOPE
- DIRECTION OF FLOW
- SANITARY SEWER M.H.
- SANITARY SEWER CLEANOUT
- STORM DRAIN M.H.
- IRRIGATION AEIR
- WATER M.H.
- GAS M.H.
- ELECTRIC M.H.
- TELEPHONE M.H. OR VAULT
- WATER METER
- FIRE HYDRANT
- SPRINKLER HEAD
- VALVE
- POLE & GUY ANCHOR
- ELECTRIC POLE
- TELEPHONE POLE
- JOINT USE POLE
- PULL BOX
- TRAFFIC MAN
- PARKING METER
- FIRE ALARM BOX
- STREET NAME SIGN
- GAS METER
- MAIL BOX
- FAUCET
- WALK DON'T WALK PEDESTRIAN SIGNAL
- PEDESTRIAN PUSH BUTTON
- RAILROAD TRACKS
- RAILROAD SIGN
- RAILROAD SIGNAL
- STREET LIGHT & TRAFFIC SIGNAL ON MAST ARM
- STREET LIGHT (UPRIGHT)
- TRAFFIC SIGNAL
- TRAFFIC SIGNAL ON MAST ARM
- TRAFFIC SIGNAL CONTROLLER
- TRAFFIC SIGNAL PRESSURE DETECTOR
- TRAFFIC SIGNAL LOOP DETECTOR
- CONCRETE
- ASPHALT
- EDGE OF PAVEMENT
- BUILDING
- UNDERGROUND STRUCTURE
- OVERHANGING STRUCTURE
- CITRUS TREE
- OR DECIDUOUS TREE
- OR PALM TREE
- SHRUBBERY
- TREE STUMP

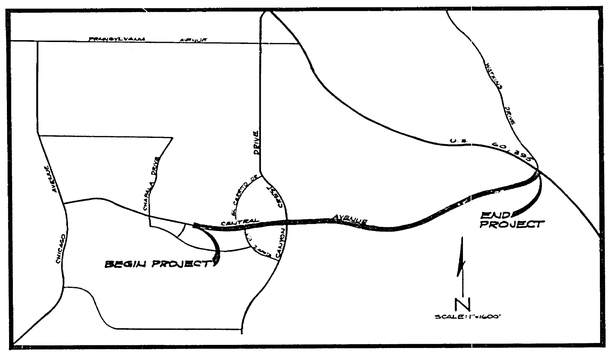

LOCATION MAP

GENERAL CONSTRUCTION NOTES

1. EXACT LOCATION AND DEPTH OF UNDERGROUND UTILITIES ARE UNKNOWN. THE LOCATIONS AND DEPTHS SHOWN ON THIS PLAN ARE FROM UTILITY RECORDS. THE CONTRACTOR IS REQUIRED TO TAKE DUE PRECAUTIONARY MEASURES TO LOCATE AND PROTECT ALL UNDERGROUND FACILITIES WHETHER OR NOT SHOWN ON PLAN. WHERE THE COVER TO THE TOP OF A UTILITY IS UNKNOWN IT IS SHOWN IN THE PROFILE BY: ?—— UTILITY NAME, BUT IS NOT EXPECTED TO CONFLICT WITH IMPROVEMENTS
2. CLEAR AND GRUB WHERE NEW CONSTRUCTION IS INDICATED.
3. TRAFFIC SIGNS REMOVED DURING CONSTRUCTION SHALL BE SALVAGED BY THE CONTRACTOR AND RELOCATED AS DIRECTED BY THE INSPECTOR.
4. UNLESS OTHERWISE NOTED ON THE PLAN: ALL FILL SLOPES TO BE 2:1. SLOPES LESS THAN 2' HIGH ARE NOT NECESSARILY SHOWN ON THE PLAN. ALL CUT SLOPES LESS THAN 2' HIGH TO BE 2:1. ALL CUT SLOPES 2' HIGH OR HIGHER TO BE 1½:1.
5. ALL ELEVATIONS SHOWN ON THE PLAN SHALL BE STAKED IN THE FIELD.
6. GRADE AS NECESSARY TO AND FROM PROPOSED DRAINS AND DITCHES.

* AS BUILT 7-8-77 DKV

CITY OF RIVERSIDE PUBLIC WORKS DEPARTMENT			Central Avenue Bikeway Chapala to U.S. 395	ACCOUNT NO 80 875 882 20
APPROVED BY			APPROVED BY [signature] PUBLIC WORKS DIRECTOR	R-1898
PRINCIPAL ENGINEER	[signature]	2/10	DATE 2-14-77	SHEET 1 OF 7
TRAFFIC DIVISION	[signature]	2-11	DESIGNED BY CEH DRAWN BY GRW CHECKED BY DKP	FILE NO.
CHIEF P.W. ENGINEER	[signature]	2-10		

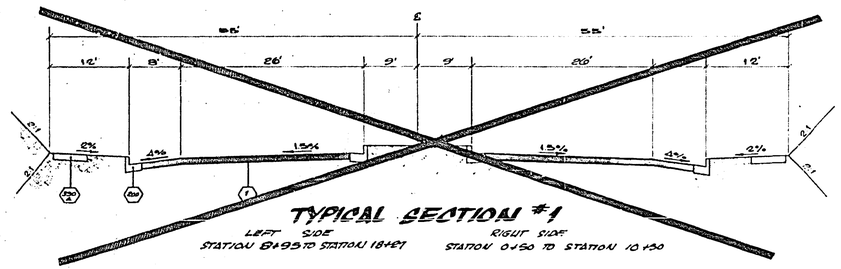

TYPICAL SECTION #1

LEFT SIDE
STATION 8+95 TO STATION 18+67

RIGHT SIDE
STATION 0+50 TO STATION 10+50

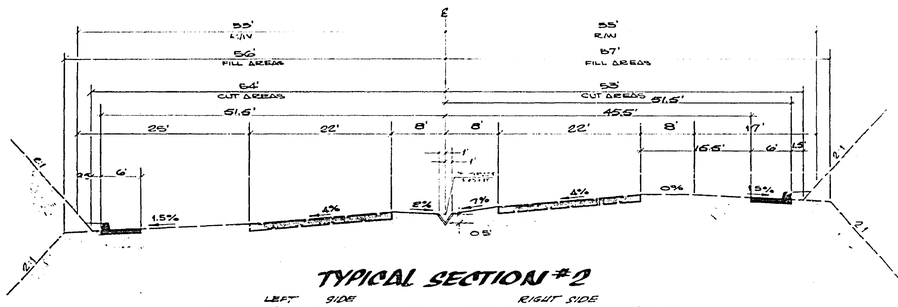

TYPICAL SECTION #2

LEFT SIDE
STATION 118+60 TO STATION 133+65

RIGHT SIDE
STATION 117+54 TO STATION 133+65

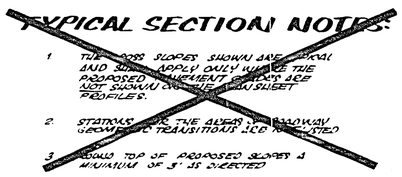

TYPICAL SECTION NOTES:

1. THE ABOVE SLOPES SHOWN ARE TYPICAL AND WILL APPLY ONLY WHERE THE PROPOSED ALIGNMENT COINCIDES WITH SHOWN OR EXISTING ROADWAY PROFILES.
2. STATIONS FOR THE ABOVE ROADWAY SECTIONS ARE TRANSITIONS AND ARE APPROXIMATED
3. SHOULD TOP OF PROPOSED SLOPES A MINIMUM OF 3' IS DIRECTED

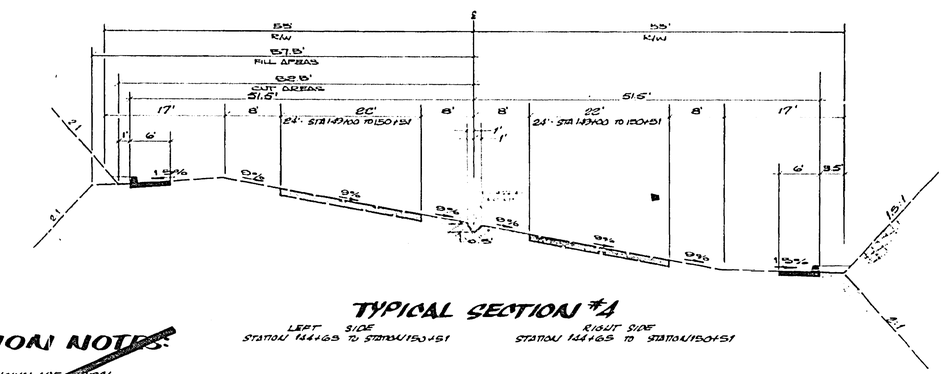

TYPICAL SECTION #4

LEFT SIDE
STATION 144+65 TO STATION 150+51

RIGHT SIDE
STATION 144+65 TO STATION 150+51

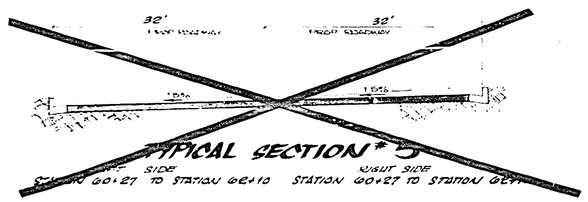

TYPICAL SECTION #5

LEFT SIDE
STATION 60+27 TO STATION 62+10

RIGHT SIDE
STATION 60+27 TO STATION 62+10

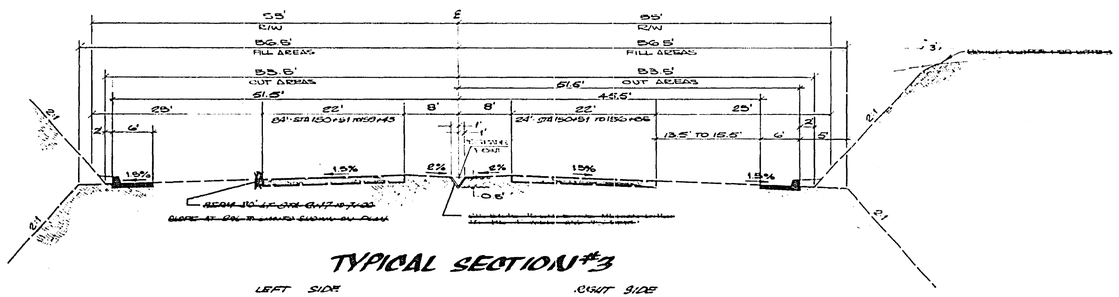

TYPICAL SECTION #3

LEFT SIDE	RIGHT SIDE
~~STATION 6+47 TO STATION 7+00~~	~~STATION 16+08 TO STATION 19+67~~
STATION 133+65 TO STATION 144+65	STATION 133+65 TO STATION 144+65
STATION 150+51 TO STATION 157+43	STATION 150+51 TO STATION 156+65

FOR SECTIONS FROM STA. 61+20 TO STA. 71+00 AND STA. 71+90 TO STA. 80+60 SEE SHEET 3 & 4.

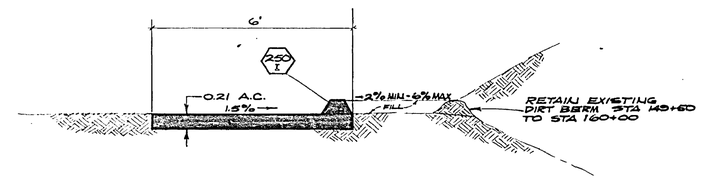

TYPICAL BIKEWAY SECTION

SCALE: HORIZ: 1" = 2'
VERT: 1" = 1'

LEFT SIDE
STA. 118+60 TO STA. 169+85

RIGHT SIDE
STA. 117+54 TO STA. 160+00

* AS BUILT TOPO DRW.

MARK	REVISIONS	APPR	DATE

DESIGNED BY LEH DRAWN BY LA-GFW CHECKED BY DZR

CITY OF RIVERSIDE, CALIFORNIA
DEPARTMENT OF PUBLIC WORKS

	BY	DATE
APPROVED BY: OFFICE ENGINEER		
TRAFFIC DIVISION		
ASSISTANT CITY ENG.		2-10

APPROVED BY: DIRECTOR OF PUBLIC WORKS
DATE 2-11-10

Central Avenue Bikeway
Chapala to U.S. 395

PROJECT NO 93 075 242 R
R-1898
SHEET 2 OF 7
FILE NO.

HORIZ. SCALE: 1" = 10' VERT. SCALE: 1" = 4'

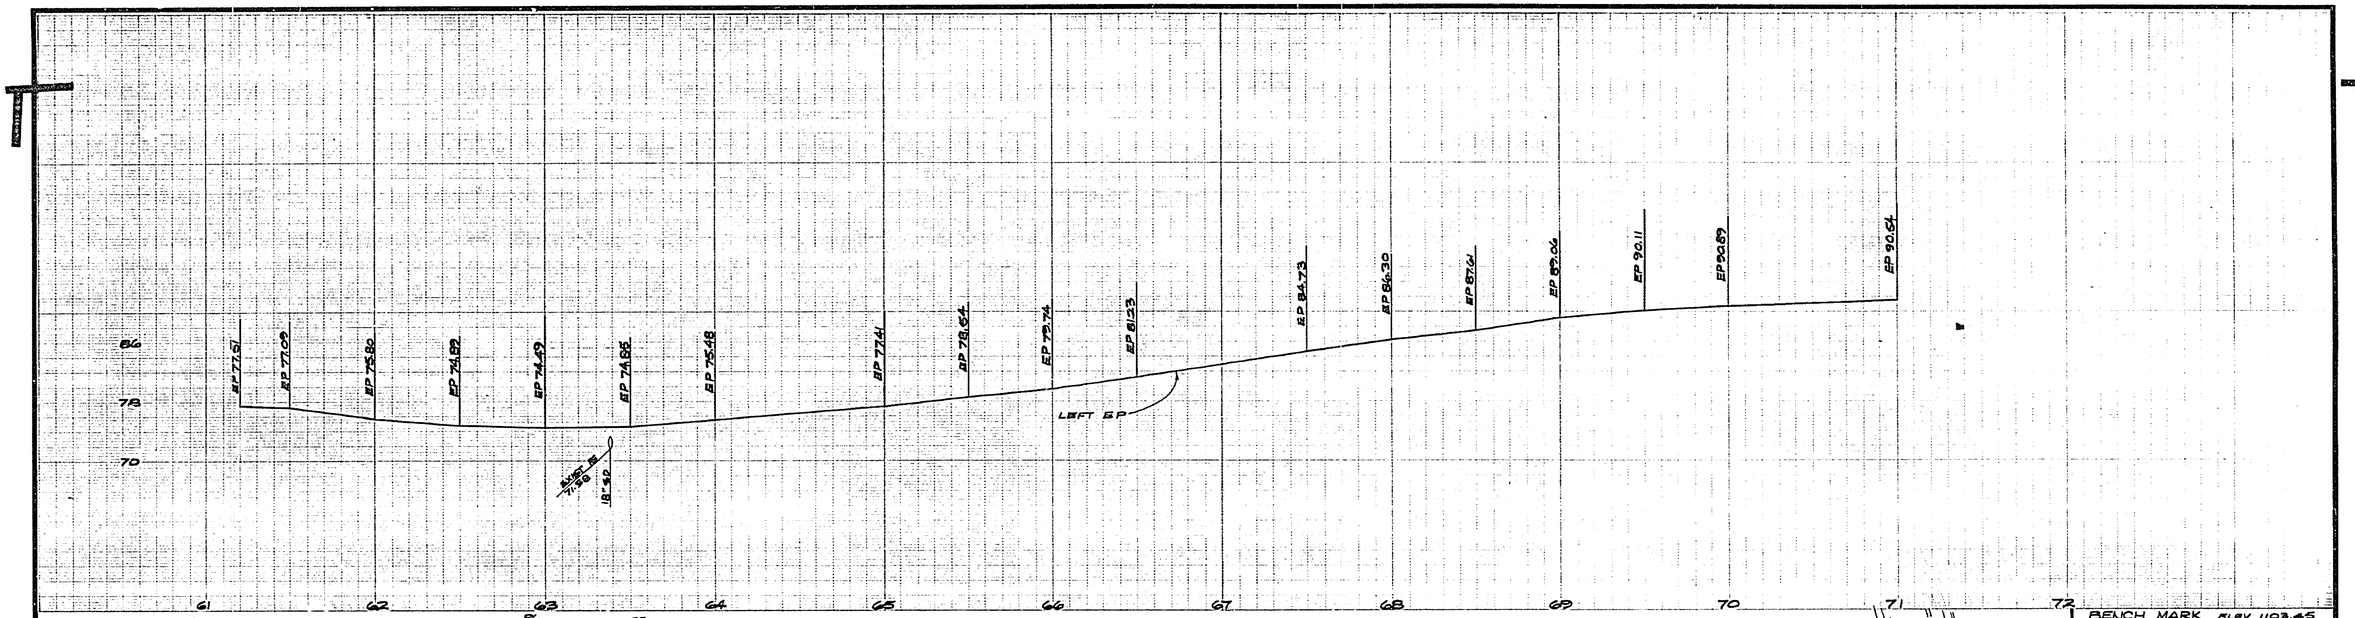

BENCH MARK ELEV 1103.45
PK & C.R. TAG IN BASE OF LIGHT STD. W. SIDE OF CANYON CREST RD. 5'LY OF S. CRESTVAL AVE. REF C.R. PRECISE LEVEL NET

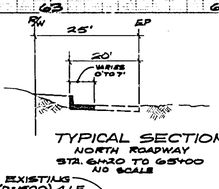

TYPICAL SECTION
NORTH ROADWAY
STA. 64+20 TO 65+00
NO SCALE

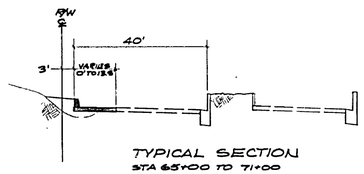

TYPICAL SECTION
STA 65+00 TO 71+00
NO SCALE

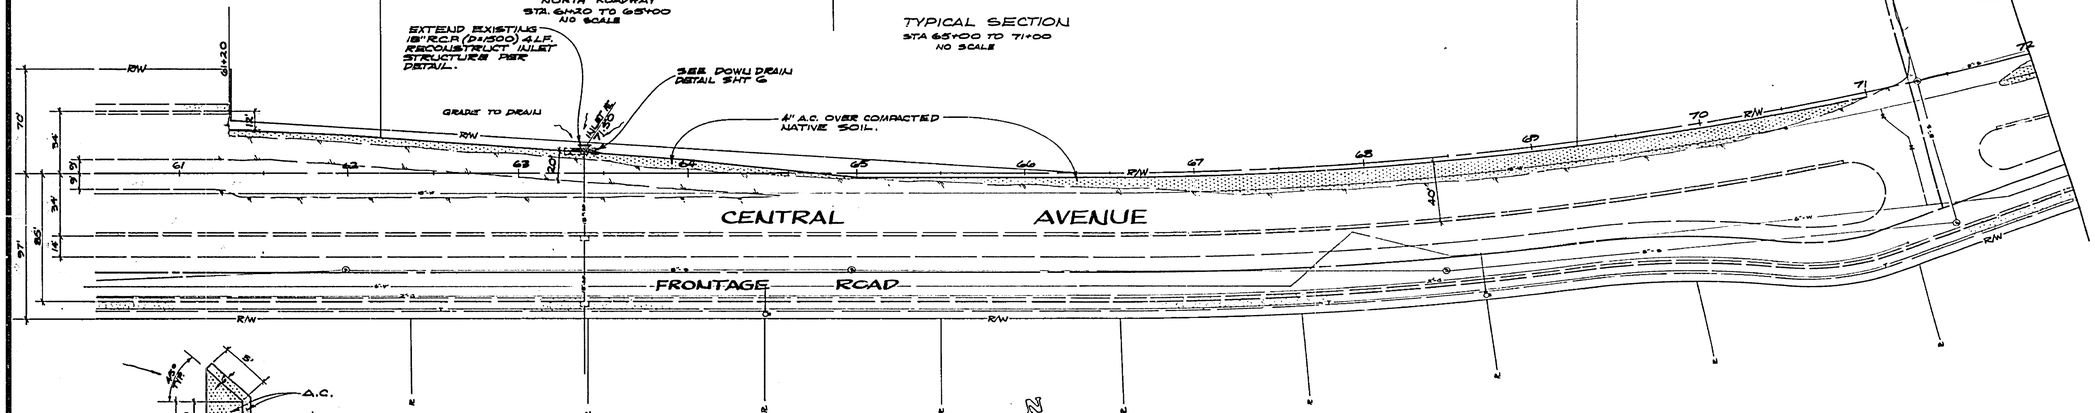

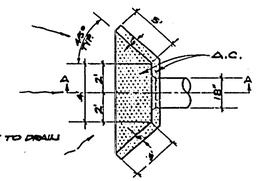

*AS BUILT 7-8-77 J.K.V.

MARK	REVISIONS	APPR.	DATE

DESIGNED BY RCH DRAWN BY RAW CHECKED BY DLR

CITY OF RIVERSIDE
PUBLIC WORKS DEPARTMENT

APPROVED BY PRINCIPAL ENGINEER		
TRAFFIC DIVISION		
CHIEF P. W. ENGINEER		

APPROVED BY PUBLIC WORKS DIRECTOR
DATE 2-14-77

Central Avenue Bikeway
Chapala to U.S. 395

HORIZ. SCALE: 1" = 40' VERT. SCALE: 1" = 8'

ACCOUNT NO. 30 675 382 20

R-1898

SHEET 3 OF 7

FILE NO.

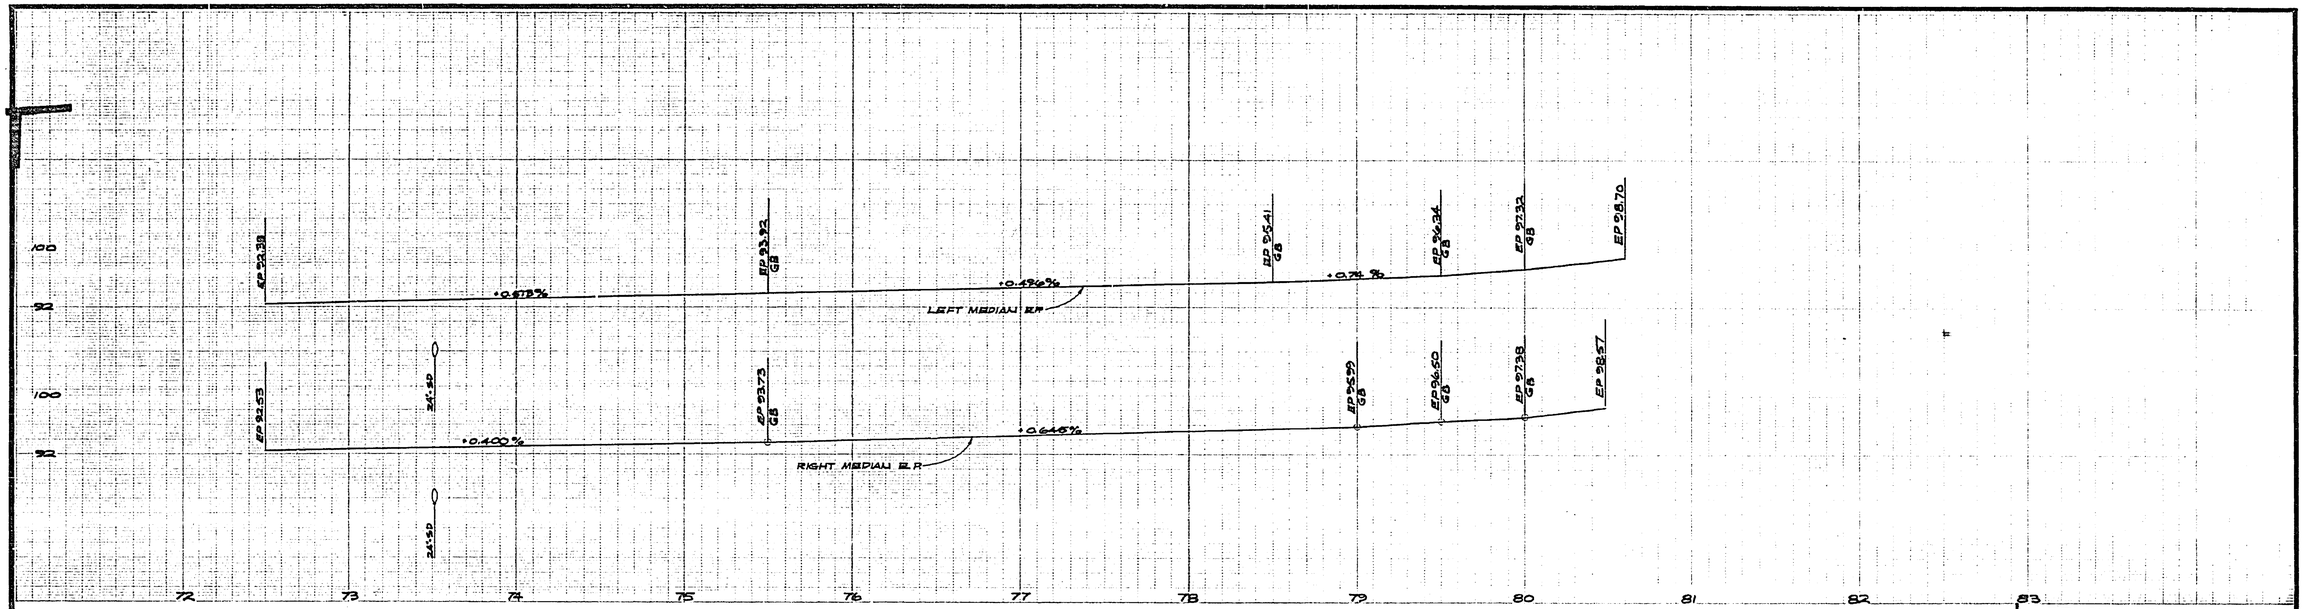

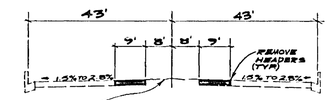

GRADE MEDIAN AS DIRECTED IN THE FIELD.

TYPICAL SECTION
STA. 71+90 TO STA. 80+60

BENCH MARK ELEV. 1103.46
PK & C.R. TAG IN BASE OF LIGHT STR. W. SIDE OF CANYON CREST 20' S'LY OF E. CENTRAL AVE.
REF. C.R. PRECISE LEVEL NET.

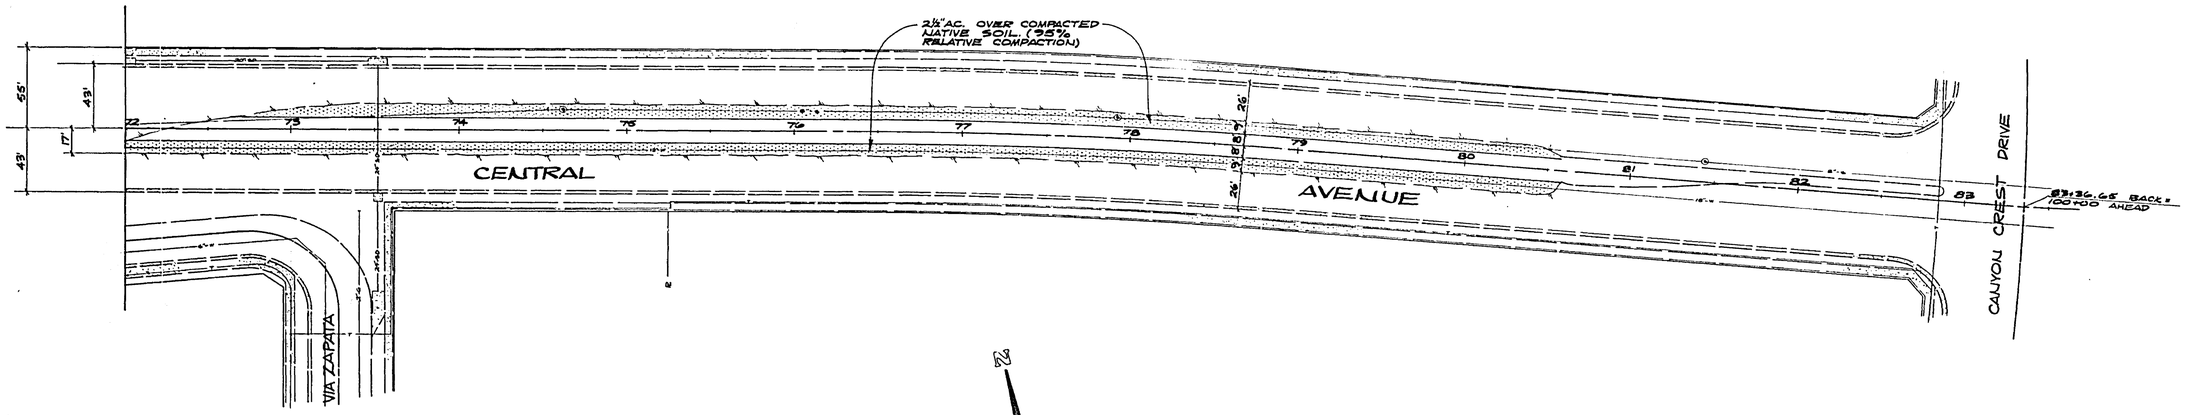

*AS BUILT 7-8-77 J.K.V.

MARK	REVISIONS	APPR	DATE

DESIGNED BY REH DRAWN BY GRW CHECKED BY DCR

CITY OF RIVERSIDE
PUBLIC WORKS DEPARTMENT

APPROVED BY PRINCIPAL ENGINEER		4/11
TRAFFIC DIVISION		
CHIEF P.W. ENGINEER		5/10

APPROVED BY _____ PUBLIC WORKS DIRECTOR
DATE 2-14-77

Central Avenue Bikeway
Chapala to U.S. 395

HORIZ. SCALE: 1" = 40' VERT. SCALE: 1" = 8'

ACCOUNT NO. 30 879 382 80

R-1898

SHEET 4 OF 7

FILE NO.

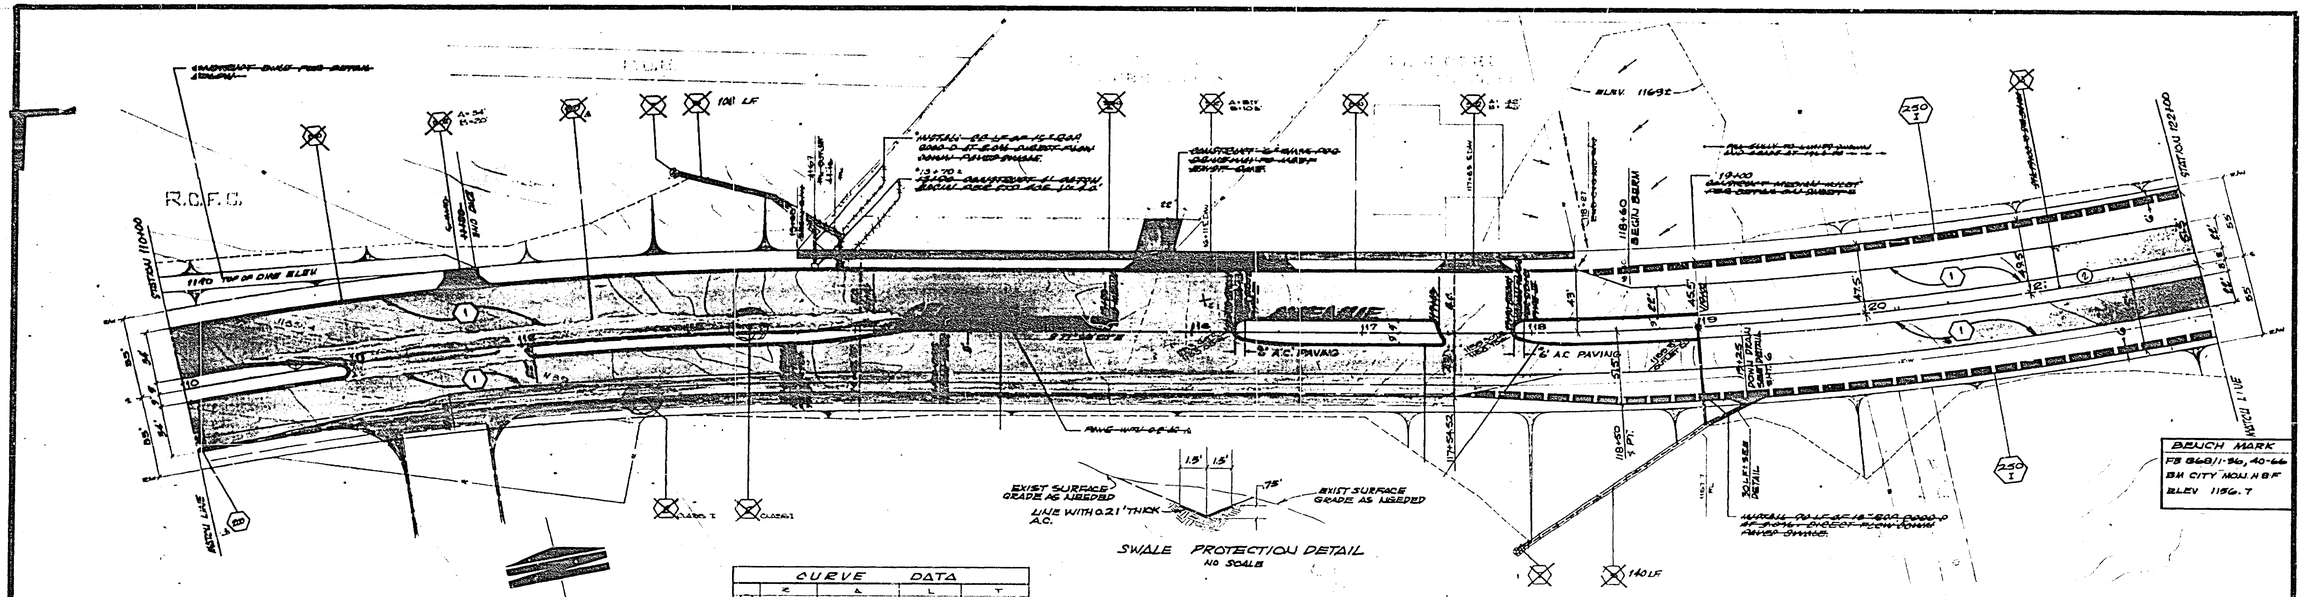

CURVE DATA				
	R	Δ	L	T
①	2000'	15° 00' 00"	538.60	271.08'
②	2000	48° 07' 40"	1680.16	851.58'

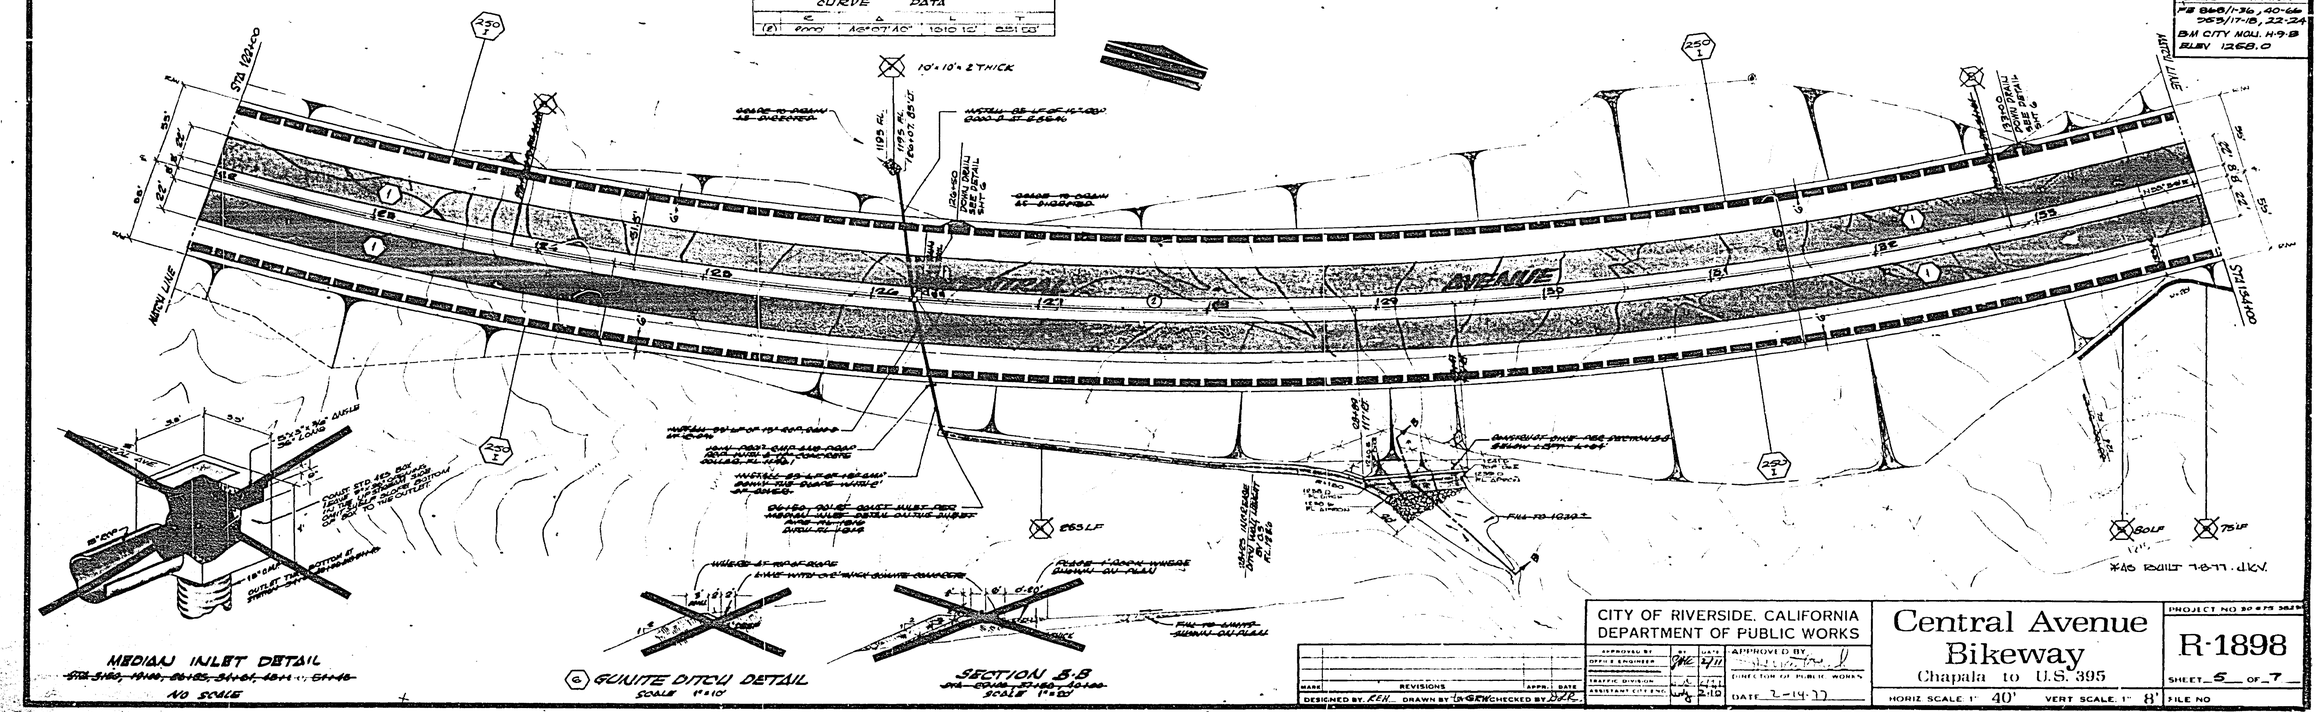

BENCH MARK
PB 868/1-36, 40-66
265/17-18, 22-24
BM CITY MON. H-9-8
ELEV 1268.0

CITY OF RIVERSIDE, CALIFORNIA DEPARTMENT OF PUBLIC WORKS		
APPROVED BY OFFICE ENGINEER	DATE 4/11	APPROVED BY DIRECTOR OF PUBLIC WORKS
TRAFFIC DIVISION		
ASSISTANT CITY ENG.	4-11-77	
DESIGNED BY KEH DRAWN BY CHECKED BY DKR	DATE 2-14-77	

NAME	REVISIONS	APPR.	DATE

Central Avenue Bikeway
Chapala to U.S. 395

HORIZ SCALE 1" 40' VERT SCALE 1" 8'

PROJECT NO 30-875 3825

R-1898

SHEET 5 OF 7

FILE NO

RIPRAP OUTLET STRUCTURE

CURVE DATA				
	R	Δ	L	T
(B)	1600'	68°04'41"	588.08'	300.00'

TRANSITION FROM 6' TO 8' WIDE BIKEWAY

FILL TO 187

GRADE AS DIRECTED

855 LF

17 CLASS I PERMO

10'x10'x8" THICK

MATCH LINE

STA 134+00

STA 146+00

155+00 RELD BERM

SECTION C-C
NO SCALE

20' DOWN DRAIN, GRADE TO MEET EXIST. CONC. DITCH.

142+65 BEGIN 35'RR

SEE SWALE PROTECTION DETAIL SHT. 5

6'LONG x 4'WIDE x 6"THICK GRADE TO DRAIN AS DIRECTED

TRANSITION FROM

N 84° 00' 41" E

CENTRAL AVENUE

CONSTRUCT DOWN DRAIN W/GRADE TO MEET EXIST. DOWN DRAIN AT R/W.

4' WIDE x 1.75' DEEP

660.4 LF

1½:1 SLOPE

CITY / COUNTY

MATCH LINE

DEPRESS 0.5' BELOW E.P.

DOWN DRAIN DETAIL
NO SCALE

BENCH MARK
FB 868/1-36, 44-66
983/17-18, 22-24
BM CITY MON. H-9-C
ELEV. 1248.4

BENCH MARK
FB 868/1-36, 44-66
983/17-18, 22-24
BM CITY MON. H-9-B
ELEV. 1312.6

AS BUILT 7-8-77. D.V.V.

COUNTY OF RIVERSIDE
APPROVED BY
COUNTY ROAD COMMISSIONER DATE

CITY OF RIVERSIDE, CALIFORNIA
DEPARTMENT OF PUBLIC WORKS

APPROVED BY
CITY ENGINEER OF PUBLIC WORKS
DATE 7-14-77

DESIGNED BY ZEN DRAWN BY DV CHECKED BY ZER

MARK	REVISIONS	APPR	DATE
1			4/77
2			6/11

Central Avenue Bikeway
Chapala to U.S. 395

HORIZ SCALE 1" = 40' VERT SCALE 1" = 8'

PROJECT NO 30 575 882 50

R-1898

SHEET 6 OF 7

FILE NO

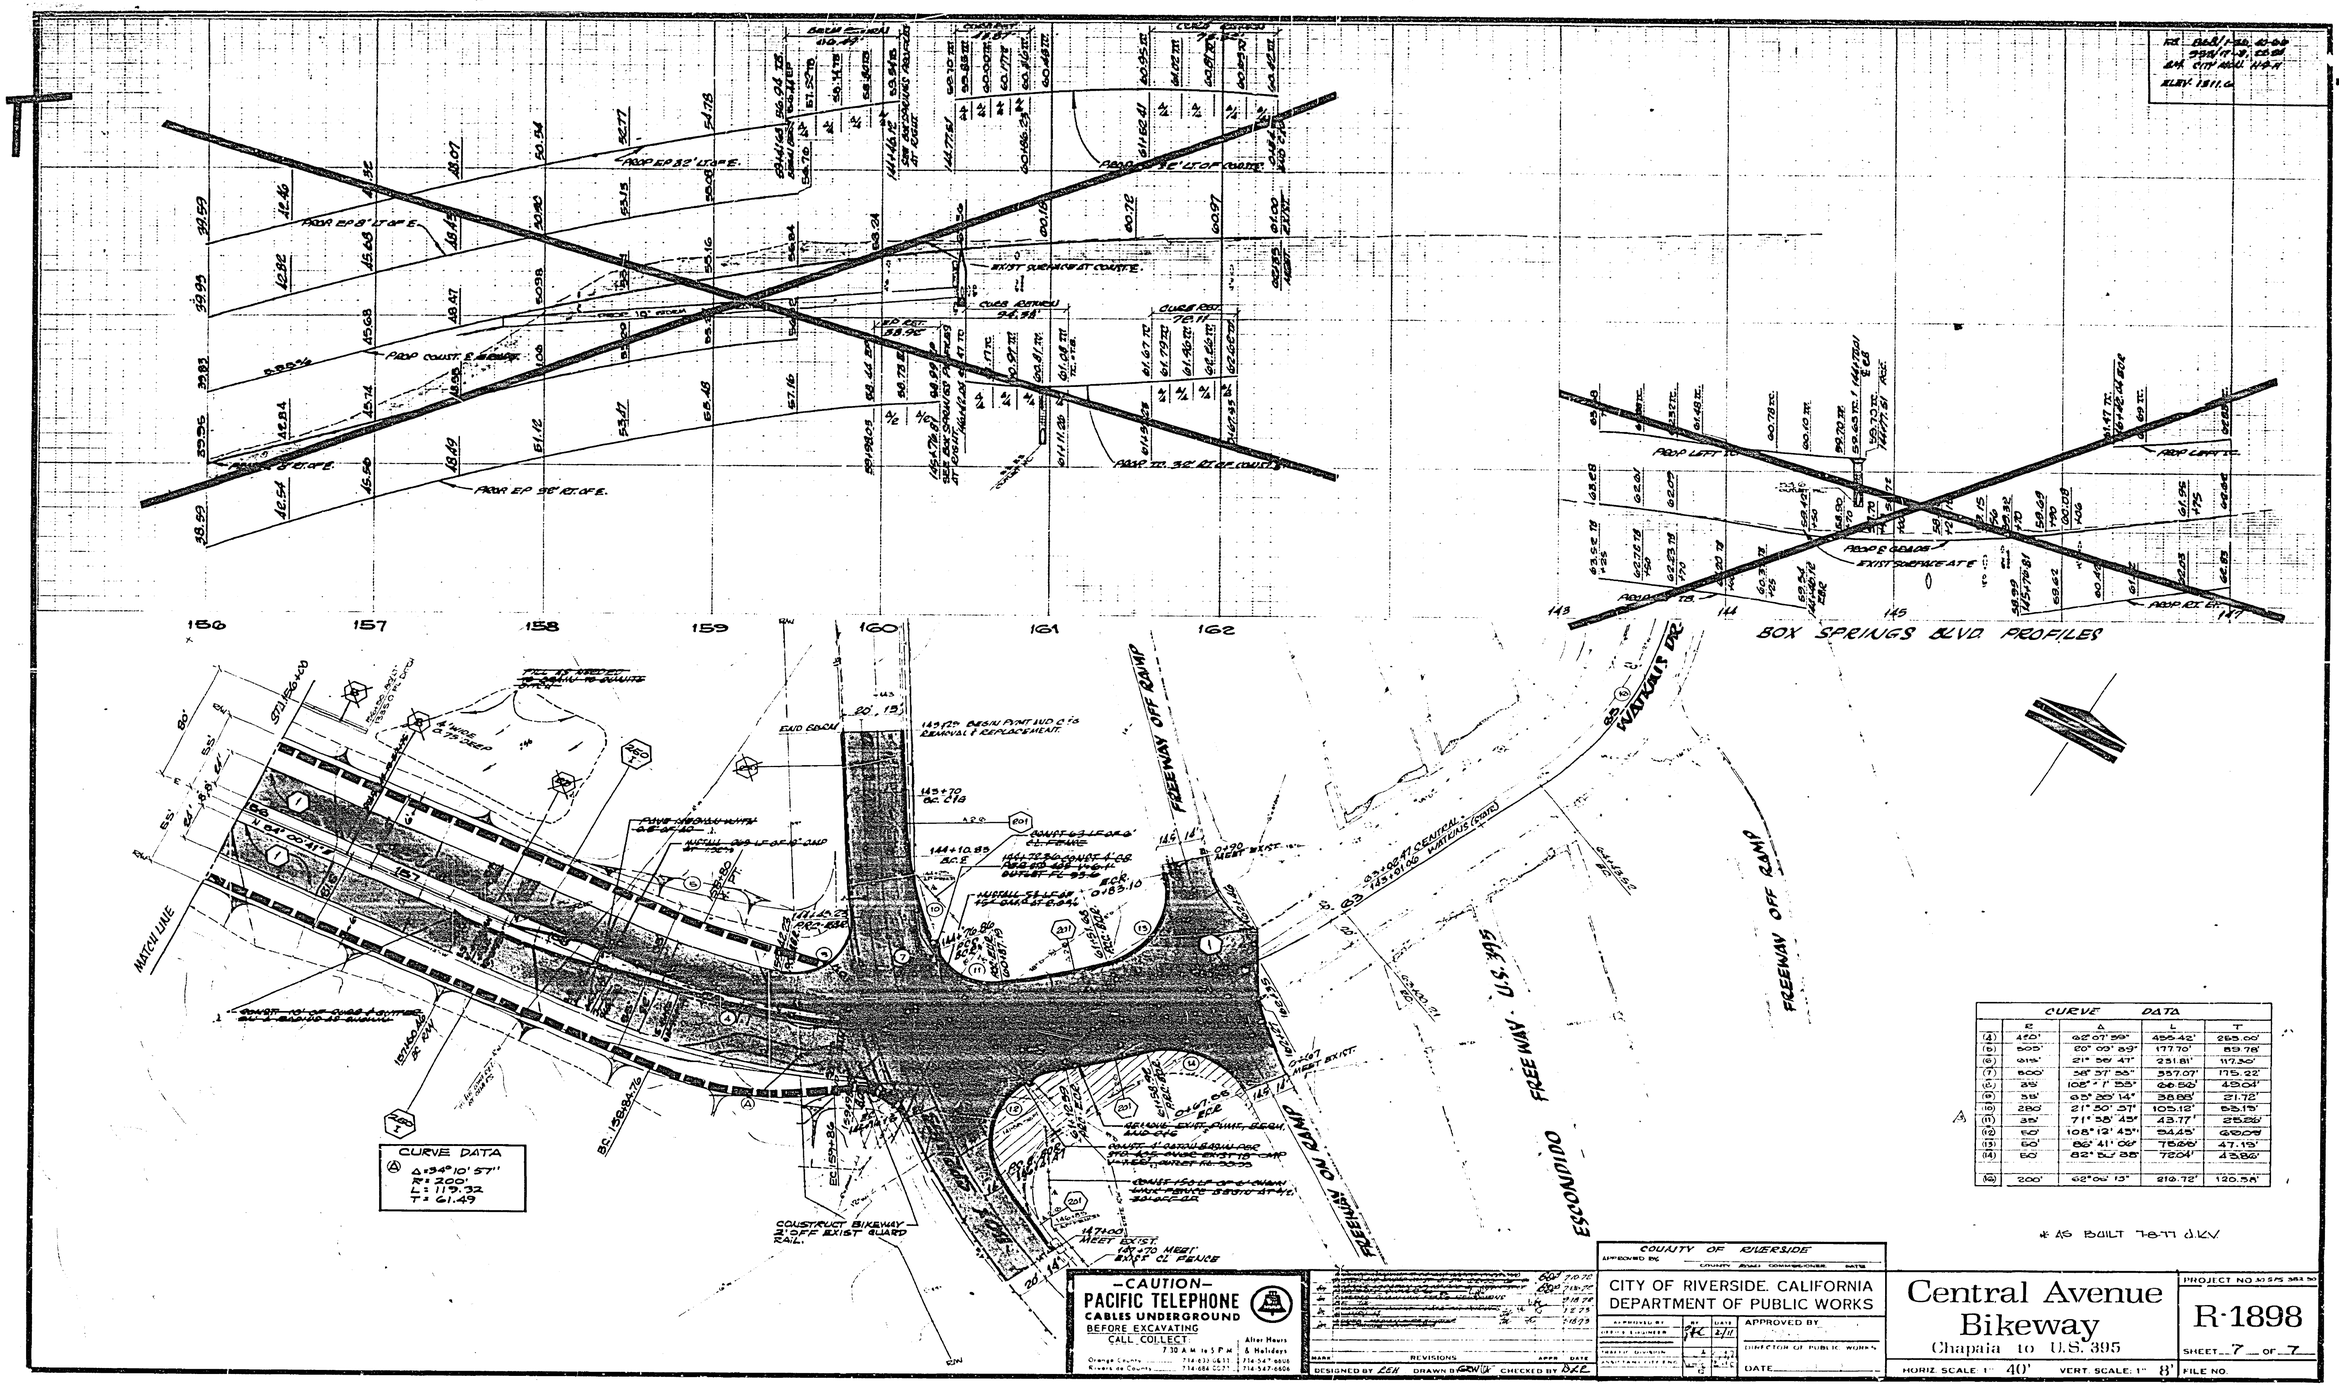
BOX SPRINGS BLVD PROFILES
MATCH LINE
FREEWAY ON RAMP
FREEWAY OFF RAMP
FREE WAY · U.S. 395
ESCONDIDO
WATKINS DR
CURVE DATA
Δ=34° 10' 57"
R=200'
L=119.32
T=61.49
CURVE DATA
A 450' 62° 07' 39" 486.42' 265.00'
B 505' 20° 09' 59" 177.70' 89.78'
C 615' 21° 56' 47" 231.81' 117.30'
D 500' 38° 37' 55" 337.07' 175.22'
E 35' 105° 1' 55" 64.52' 45.53'
F 55' 93° 20' 14" 58.85' 21.72'
G 280' 21° 50' 37" 105.12' 53.15'
H 35' 71° 38' 45" 43.77' 25.26'
I 50' 108° 12' 45" 94.45' 66.09'
J 60' 86° 41' 06" 75.26' 47.13'
K 60' 82° 52' 55" 72.04' 45.86'
L 200' 62° 04' 13" 216.72' 120.54'
-CAUTION-
PACIFIC TELEPHONE
CABLES UNDERGROUND
BEFORE EXCAVATING
CALL COLLECT
7:30 A.M. to 5 P.M.
After Hours & Holidays
Orange County 714-633-0611 714-547-6808
Riverside County 714-686-0071 714-547-6808
REVISIONS
DESIGNED BY ZEH DRAWN BY GEW CHECKED BY DKE
COUNTY OF RIVERSIDE
APPROVED FOR COUNTY ROAD COMMISSIONER DATE
CITY OF RIVERSIDE, CALIFORNIA
DEPARTMENT OF PUBLIC WORKS
APPROVED BY
DIRECTOR OF PUBLIC WORKS
DATE
Central Avenue
Bikeway
Chapala to U.S. 395
PROJECT NO. 10 575 383 50
R-1898
SHEET 7 OF 7
HORIZ. SCALE 1" = 40'
VERT. SCALE 1" = 8'
FILE NO.