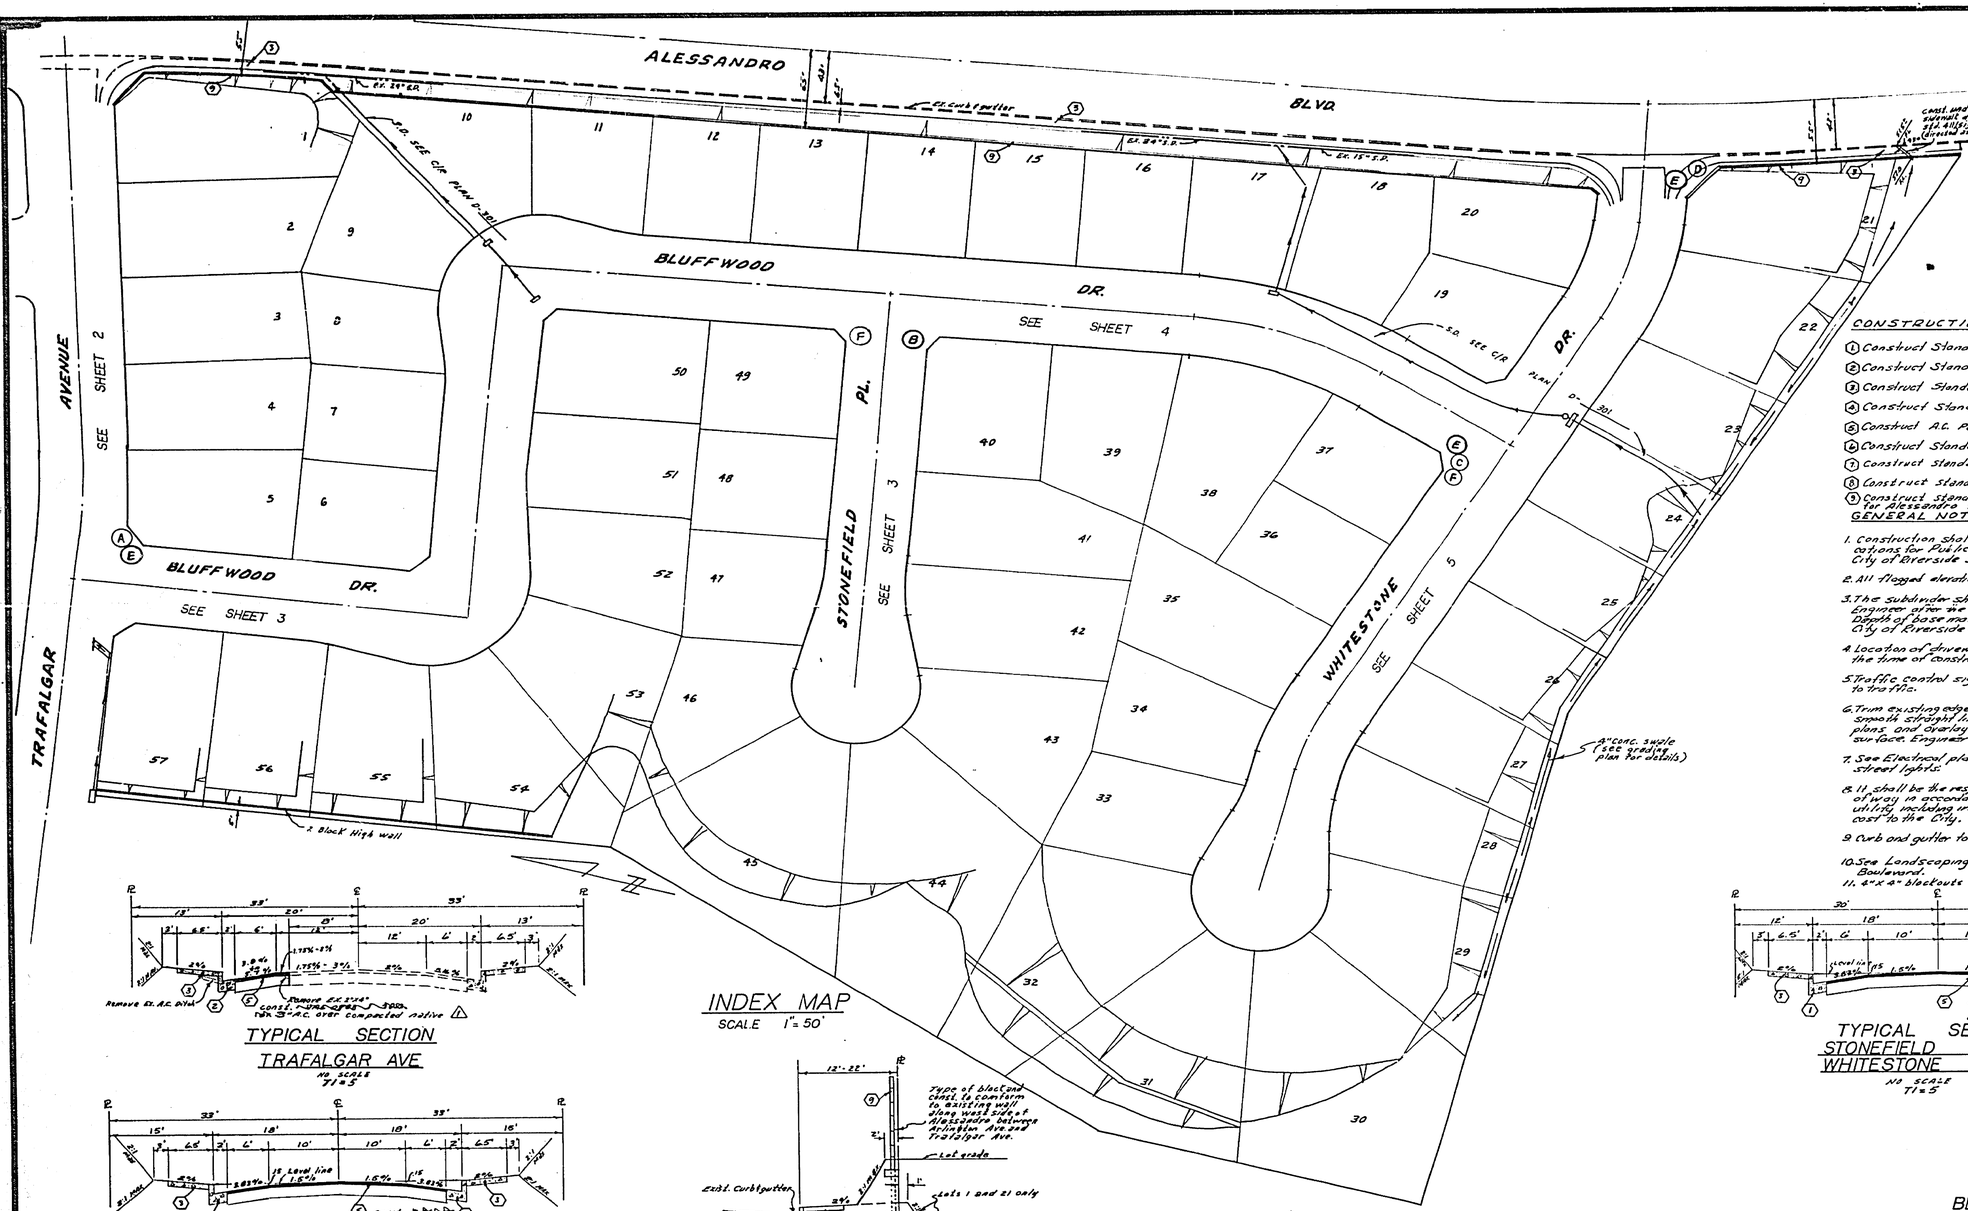

STREET NAME AND TRAFFIC SIGN SCHEDULE		
A	TRAFALGAR AVE	2100
	BLUFFWOOD DR	6100
B	BLUFFWOOD DR	6200
	STONE FIELD PL	2100
C	WHITE STONE DR	2100
	BLUFFWOOD DR	6200
D	ALESSANDRO BLVD	6200
	WHITE STONE DR	2100
E	STOP SIGN (R1) 30" OCTAGON	
F	W53 (NOT A THROUGH STREET) 24"X24"	
G	R-10 (RT.)	

CONSTRUCTION NOTES

1. Construct Standard 200 Curb & Gutter (6" C.F.)
2. Construct Standard 200 Curb & Gutter (8" C.F.)
3. Construct Standard 325 Curb Line Sidewalk.
4. Construct Standard 220 Cross Gutter (width shown on plans)
5. Construct A.C. Paving per Typical Section
6. Construct Standard 304 Wheel chair ramp
7. Construct Standard 405 Catch Basin (see D-301 for details)
8. Construct standard 407 Catch Basin.
9. Construct standard 706 6' high block wall. See landscaping plans for Alessandro for type block, color, etc.

GENERAL NOTES

1. Construction shall be in accordance with the Standard Specifications for Public Works Construction 1976 Edition and per City of Riverside Standard Drawings.
2. All flagged elevations shall be staked in the field by the Engineer
3. The subdivider shall arrange for a soil test to be made by a Soils Engineer after the streets have been prepared to rough grade. Depth of base material and A.C. paving shall be determined by the City of Riverside design standards and test procedures.
4. Location of driveway approaches (Std. 302) to be determined at the time of consideration as opposed by the Traffic Engineer.
5. Traffic control signs must be in place prior to opening streets to traffic.
6. Trim existing edge of pavement where new pavement joins to a smooth straight line. Construct match up paving as shown on the plans and overlay paving as directed in order to produce a smooth surface. Engineer to direct overlay to be 2" min.
7. See Electrical plan for the number and location of required street lights.
8. It shall be the responsibility of the Contractor to clear the right of way in accordance with the provisions of law and to protect each utility including irrigation lines and appurtenances, and at no cost to the City.
9. Curb and gutter to be staked on a 3' offset at 25' intervals.
10. See Landscaping and Sprinkler System plans for Alessandro Boulevard.
11. 4"x 4" black paint for mailboxes required in curb s/w.

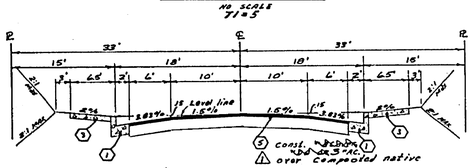

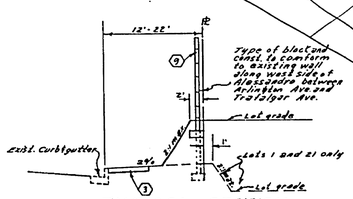

INDEX MAP
SCALE 1"=50'

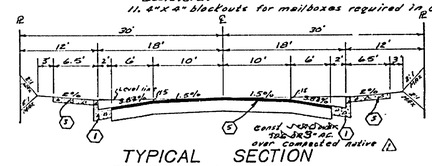

BENCH MARK

Elev. 1134.642
C/R BM No G-7-C pk nail on curb return
SE Corner Chicago, Arlington and Alessandro.
INDEX C.O. Q.R.

EXP 6-47 E-62

ALBERT A. WEBB ASSOCIATES
CIVIL ENGINEERS
RIVERSIDE, CALIFORNIA
APPROVED BY L.A. Wamsley DATE 6-18-76
R.E. No. 18056
W.O. 76-40 FOR: PRESLEY COMPANY P.D. 1022

MARK	REVISIONS	APPR.	DATE
1	Added paving section	DRW	9-19-77

DESIGNED BY REC DRAWN BY L.R.M. CHECKED BY

CITY OF RIVERSIDE, CALIFORNIA
PUBLIC WORKS DEPARTMENT

APPROVED BY	BY	DATE
PRINCIPAL ENGINEER		7-76
PARK DEPARTMENT		7-76
TRAFFIC DIVISION		11-76
CHIEF PUB. WKS ENGR.		11-77
PLANNING DEPT.		11-7-77

APPROVED BY [signature] DIRECTOR OF PUBLIC WORKS
DATE 1-17-77

STREET PLAN & PROFILE
TRACT NO 5423-2
INDEX SHEET
SCALE: AS SHOWN

ACCOUNT No.
DRAWING NUMBER R-1920
SHEET 1 OF 5
76-40-A

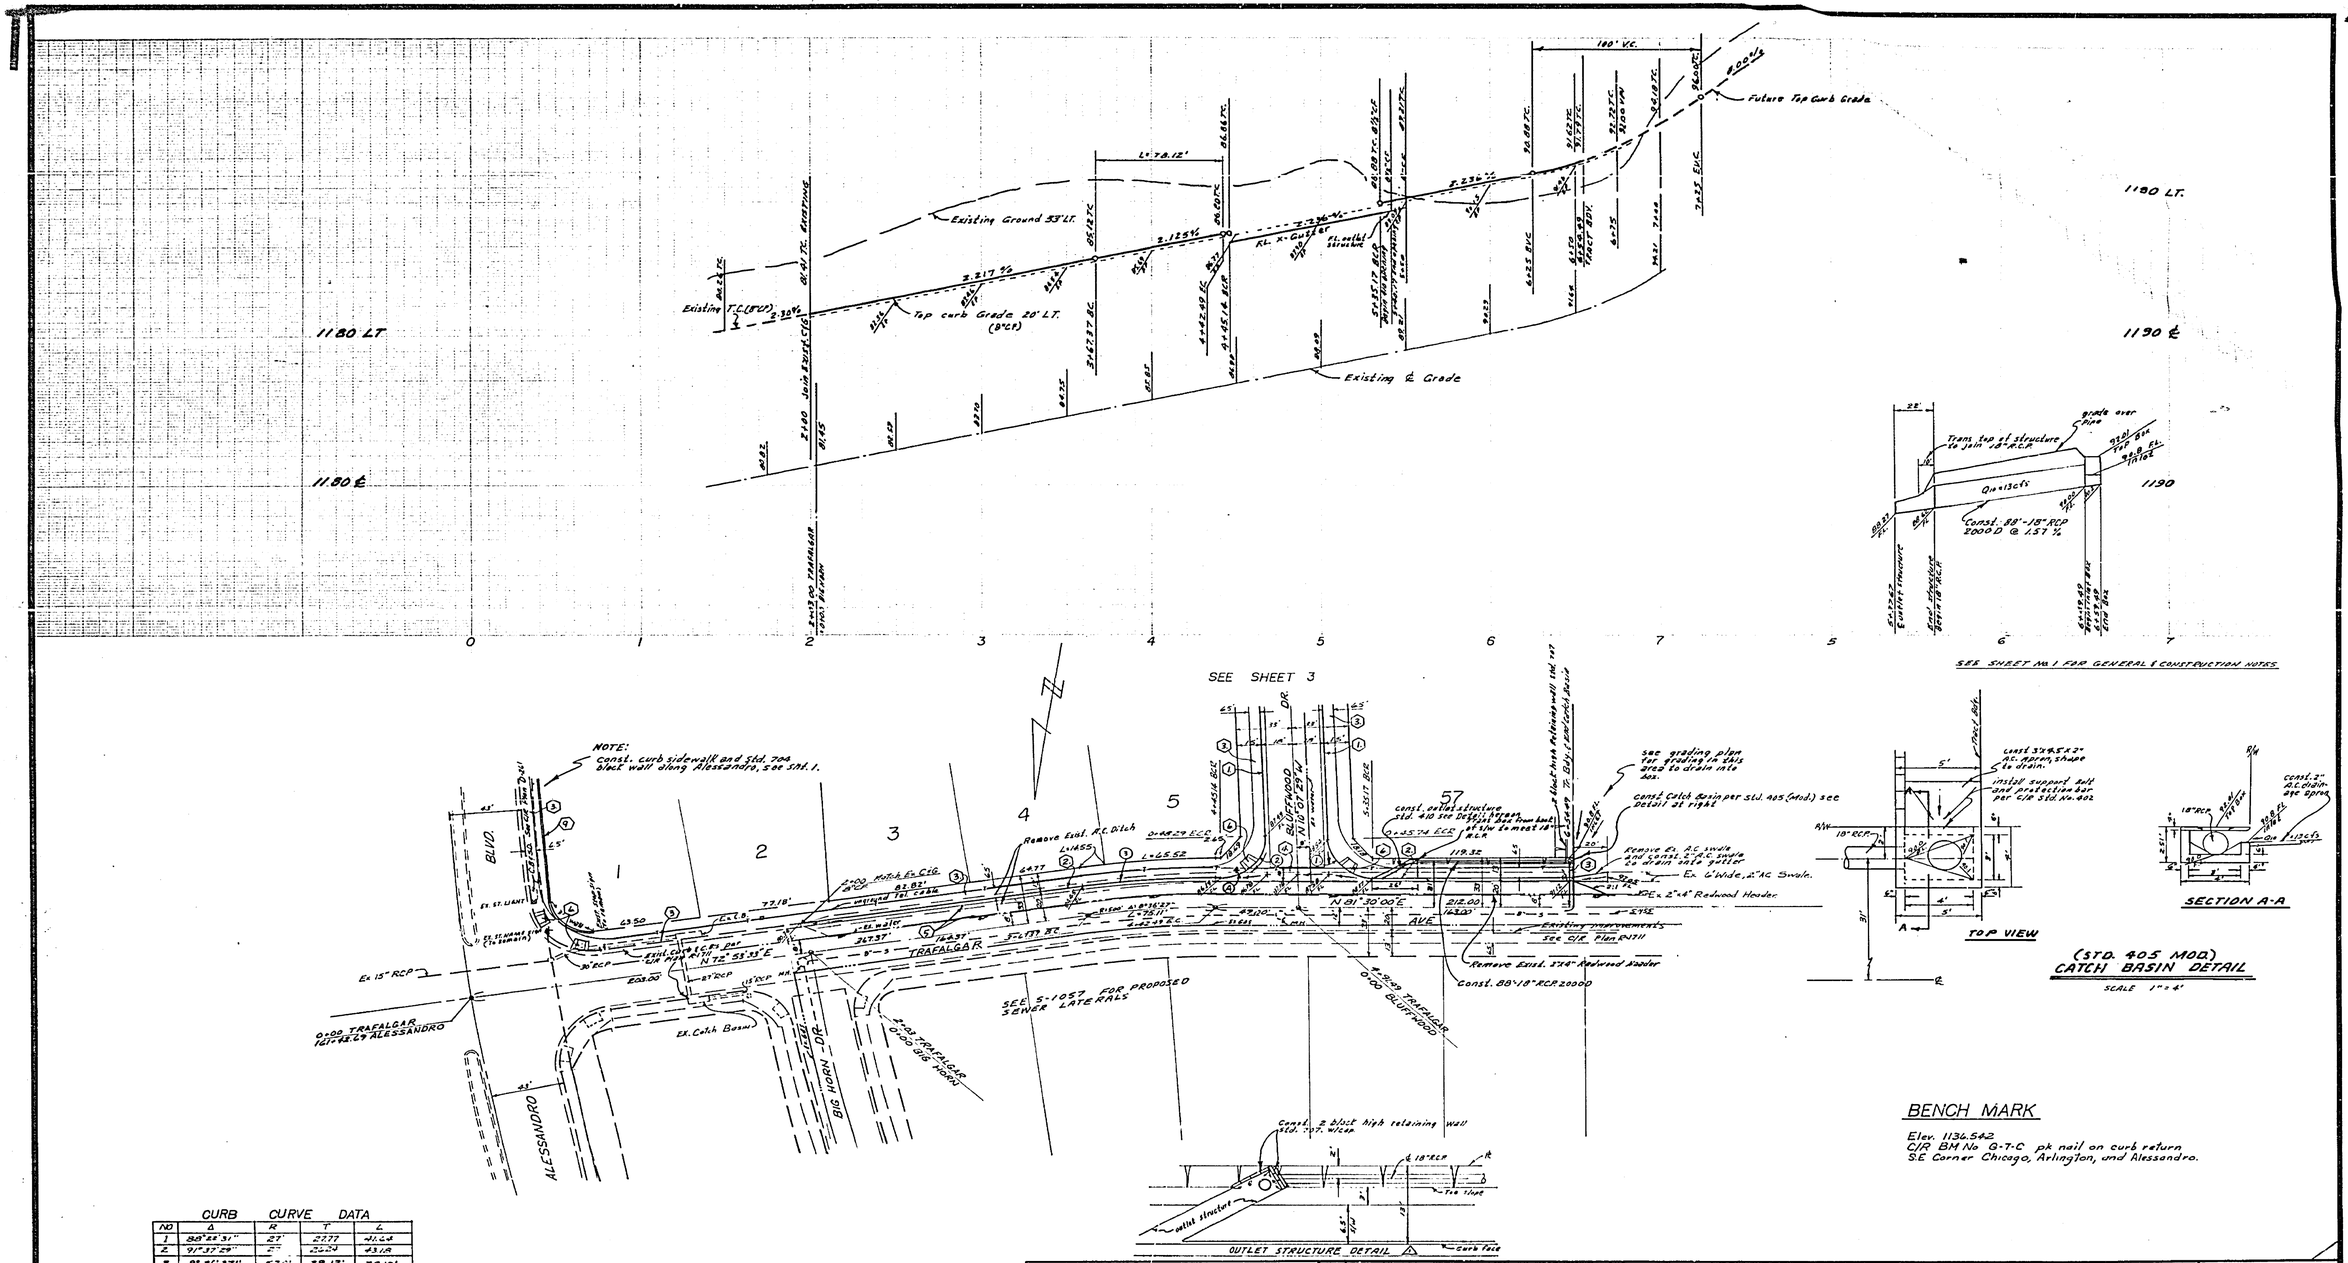

CURB CURVE DATA				
NO	Δ	R	T	L
3	8°36'27"	522'	39.13'	78.12'

BENCH MARK

Elev. 1134.542
C/R BM No G-T-C pk nail on curb return S.E. Corner Chicago, Arlington, and Alessandro.

ALBERT A. WEBB ASSOCIATES CIVIL ENGINEERS RIVERSIDE, CALIFORNIA APPROVED BY L.A. Hamilton DATE 6-19-74 R.E. No. 16056 W.O. 74-40 FOR: PRESLEY COMPANY F.B. 1022	MARK / REVISIONS / APPR. / DATE 1 Added Detail for Ret. Wall PW 6/14/77 DESIGNED BY REC DRAWN BY LRM CHECKED BY	CITY OF RIVERSIDE, CALIFORNIA PUBLIC WORKS DEPARTMENT APPROVED BY / BY / DATE PRINCIPAL ENGINEER PARK DEPARTMENT TRAFFIC DIVISION CHIEF PUB. WKS. ENGR. PLANNING DEPT. DATE 1-10-77	STREET PLAN & PROFILE TRACT NO 5423-2 TRAFALGAR AVE APPROVED BY DIRECTOR OF PUBLIC WORKS SCALE: HORIZ 1"=40' VERT 1"=4'	ACCOUNT No. DRAWING NUMBER R-1920 SHEET 2 OF 5 74-40-A

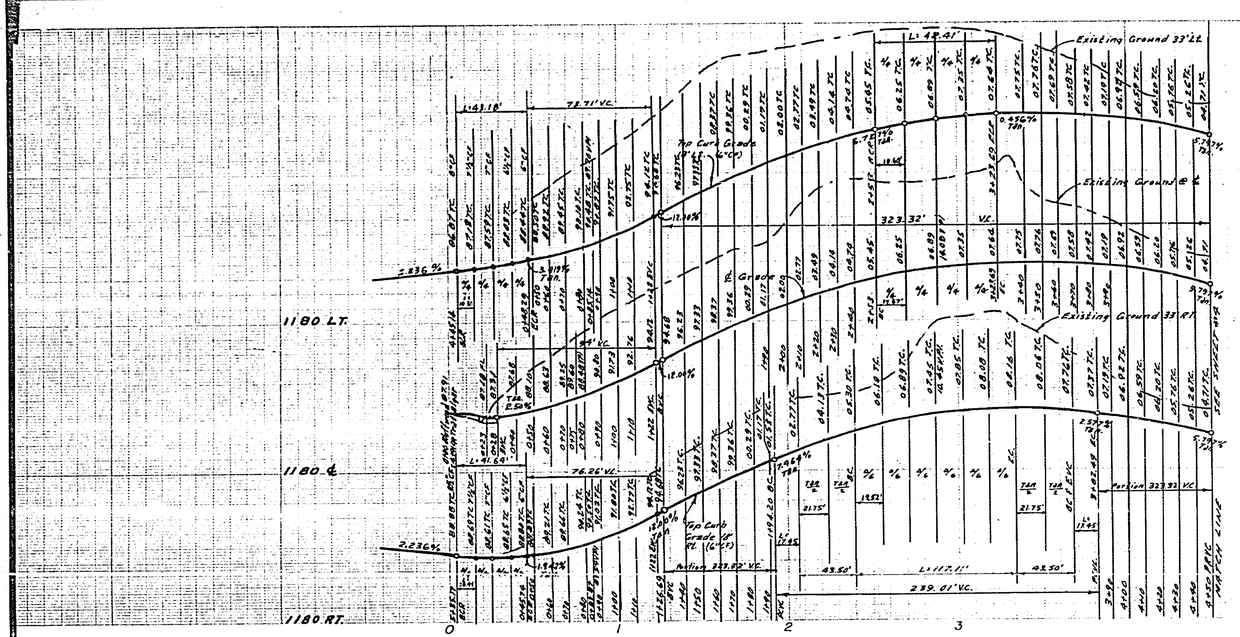

SEE SHEET NO. 1 FOR GENERAL AND CONST. NOTES

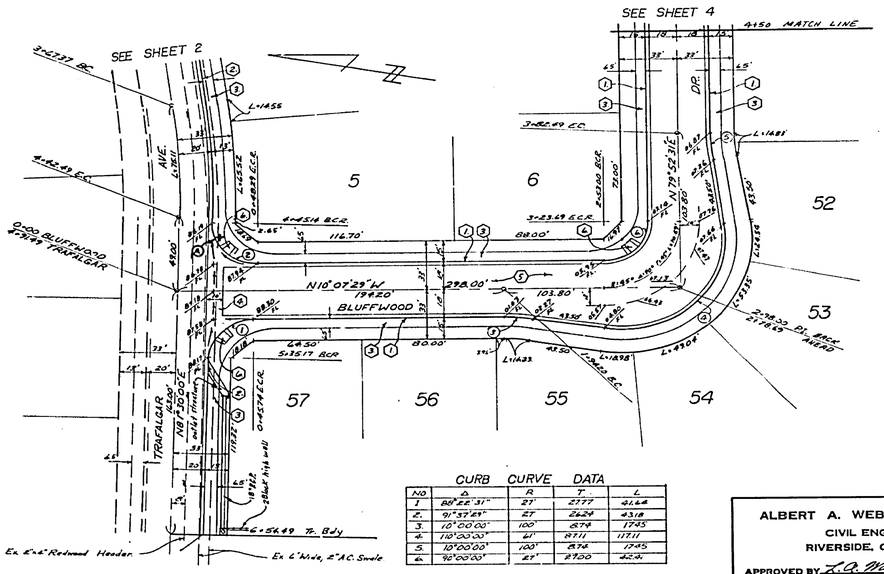
SEE SHEET 2
SEE SHEET 4
4+50 MATCH LINE
BLUFFWOOD
DR.
AVE.
TRAFALGAR
N10°07'29"W
1920'
298.00'
N 79°52'31"E
103.80'

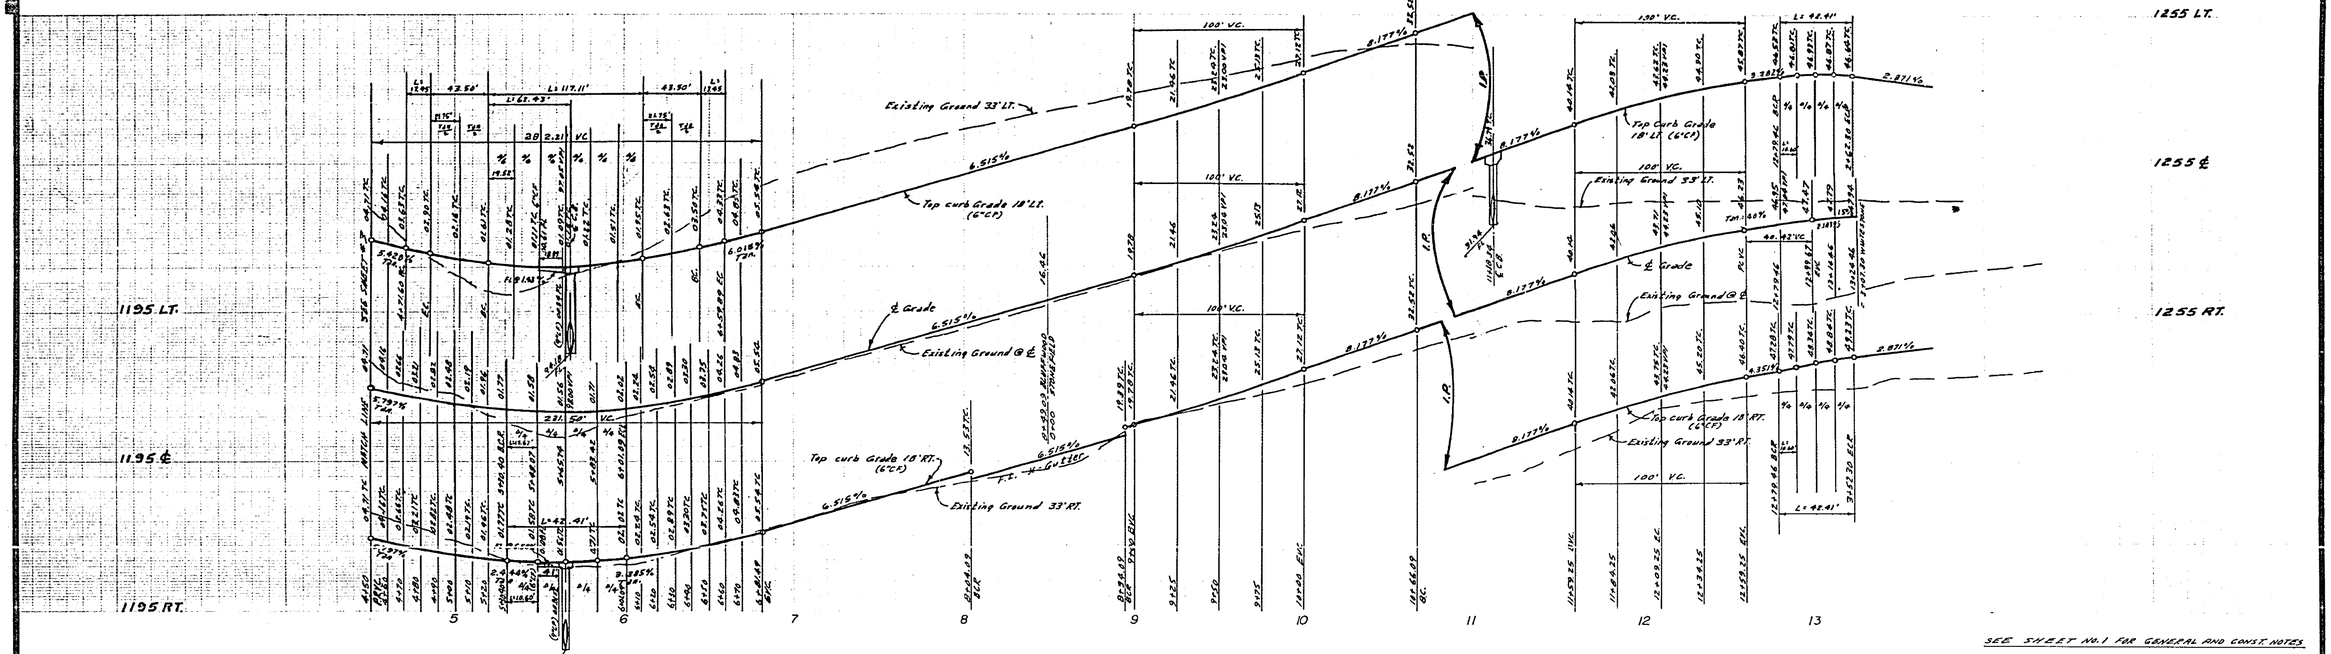

SEE SHEET NO. 1 FOR GENERAL AND CONST. NOTES

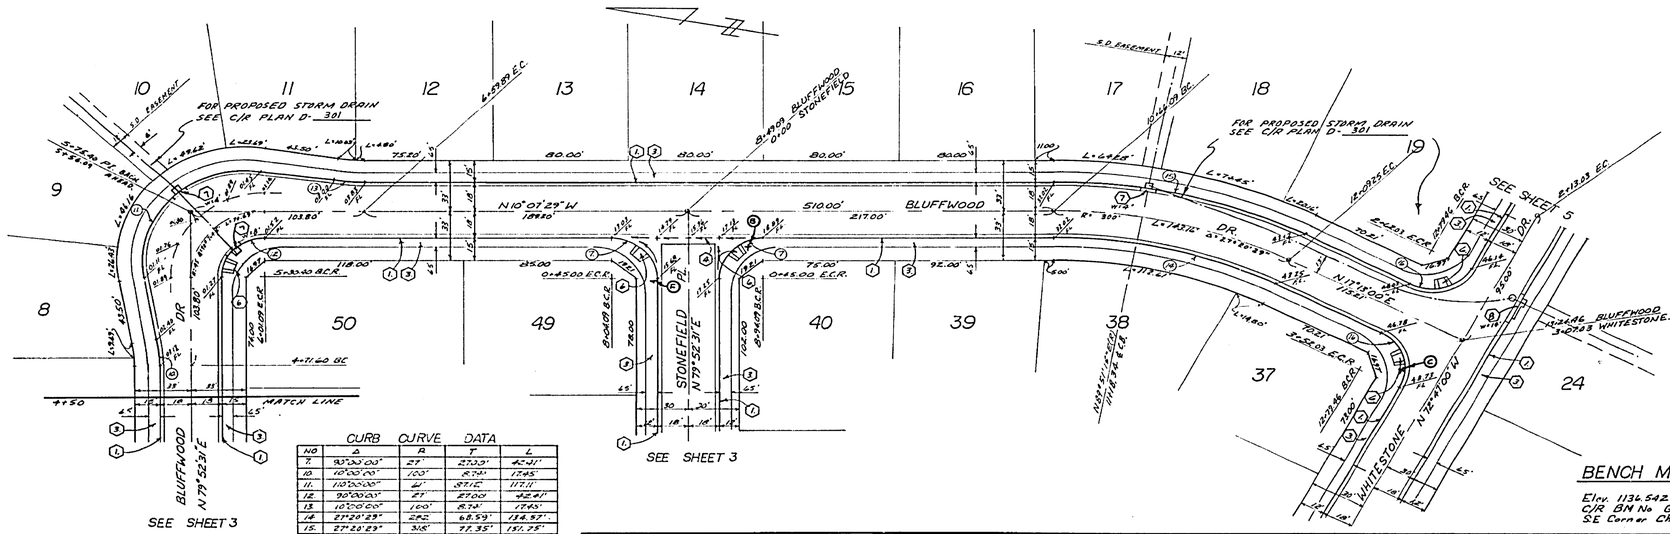

CURB CURVE DATA

NO	Δ	R	T	L

BENCH MARK

Elev. 1134.542
C/R BM No G-7-C ph nail on curb return
SE Corner Chicago, Arlington and Alessandro.

ALBERT A. WEBB ASSOCIATES
CIVIL ENGINEERS
RIVERSIDE, CALIFORNIA
APPROVED BY R.A. Wamsley DATE 6-18-76
R.E. No 16056

W.O. 76-40 FOR: PRESLEY COMPANY F.B. 1022

MARK	REVISIONS	APPR.	DATE

DESIGNED BY REC DRAWN BY LRM CHECKED BY RAW

CITY OF RIVERSIDE, CALIFORNIA
PUBLIC WORKS DEPARTMENT

	BY	DATE
APPROVED BY		
PRINCIPAL ENGINEER		
PARK DEPARTMENT		
TRAFFIC DIVISION		
CHIEF PUB. WKS. ENGR.		

APPROVED BY [signature]
DIRECTOR OF PUBLIC WORKS
DATE 1-17-77

STREET PLAN & PROFILE
TRACT NO 5423-2
BLUFFWOOD DR

SCALE: HORIZ 1"=40' VERT 1"=8'

ACCOUNT No.
DRAWING NUMBER R-1920
SHEET 4 OF 5
76-40-A

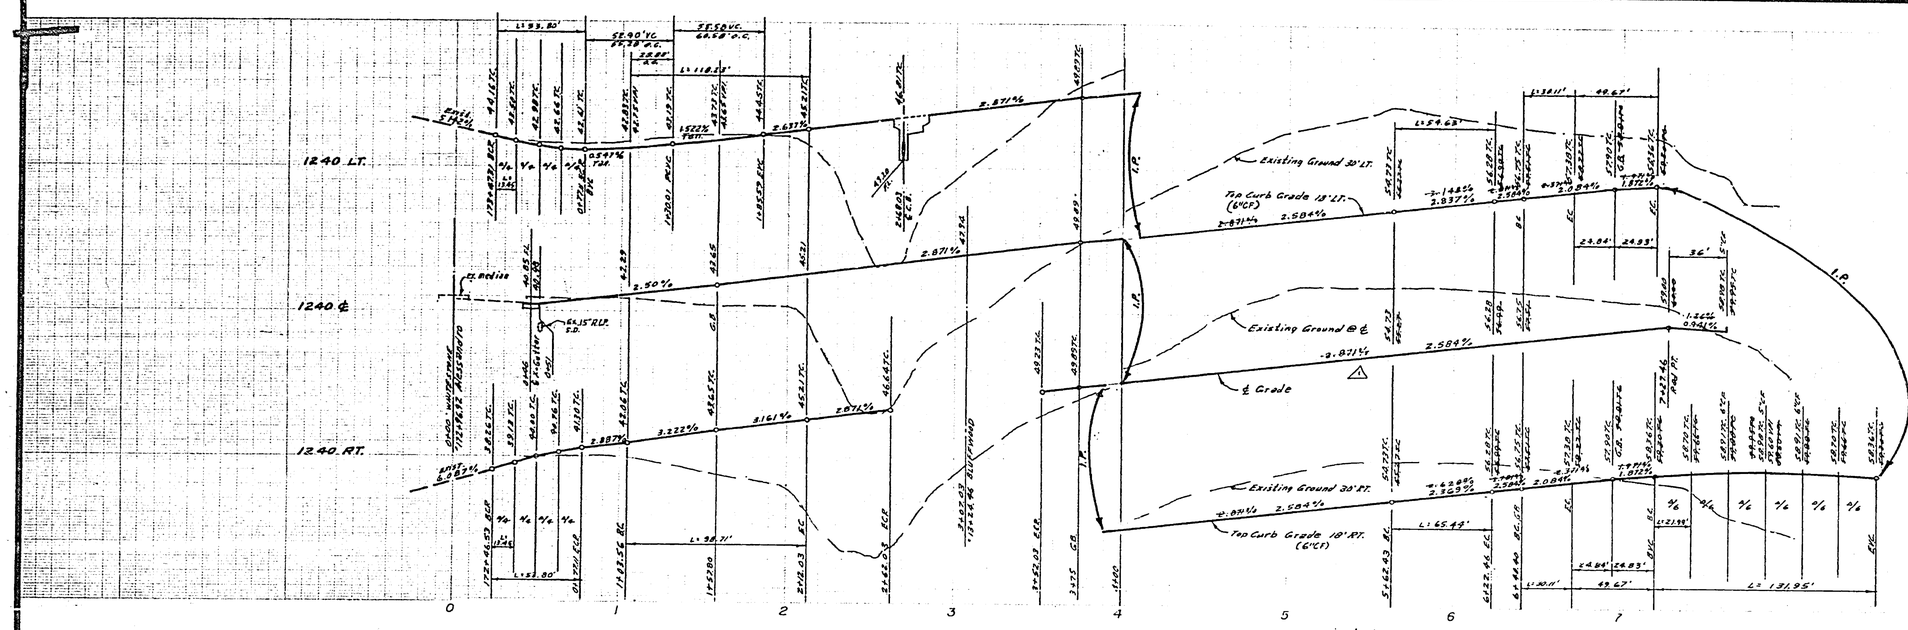
1240 LT.
1240 ℄
1240 RT.
Existing Ground 30' LT.
Top Curb Grade 18' LT. (6"CF)
Existing Ground ℄
℄ Grade
Existing Ground 30' RT.
Top Curb Grade 18' RT. (6"CF)
Ex. Radius
Ex. 15" R.C.P. S.D.
PROP. WHITESTONE TO PARK & ALESSANDRO
0 1 2 3 4 5 6 7

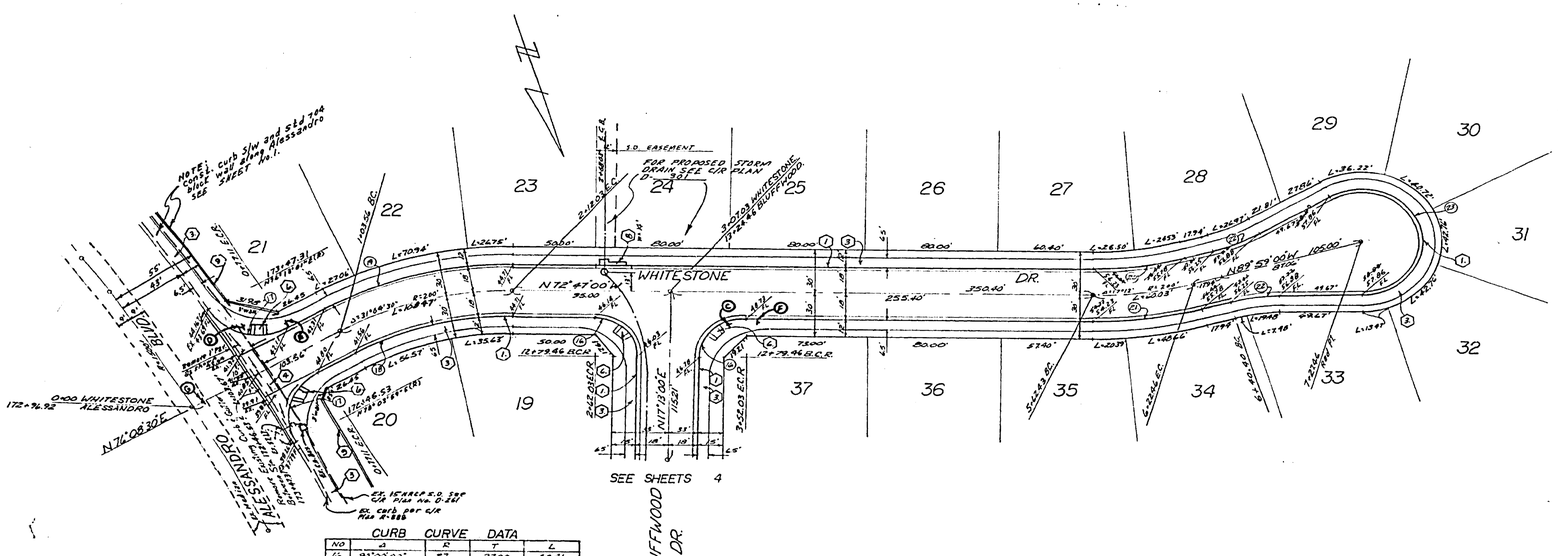
WHITESTONE DR.
N 72°47'00" W
350.40'
255.40'
N 89°53'00" W
105.00'
ALESSANDRO BLVD.
BLUFFWOOD DR.
N 74°08'30" E
172+76.92
0+00 WHITESTONE ALESSANDRO
10' EASEMENT FOR PROPOSED STORM DRAIN SEE C/R PLAN
SEE SHEETS 4
NOTE: Curb S/W and S/d Tie Block with Storm Alessandro SEE SHEET No. 1.
Ex. 15" R.C.P. S.D. See C/R Plan No. 2.561
Ex. curb per C/R No. 2-886
