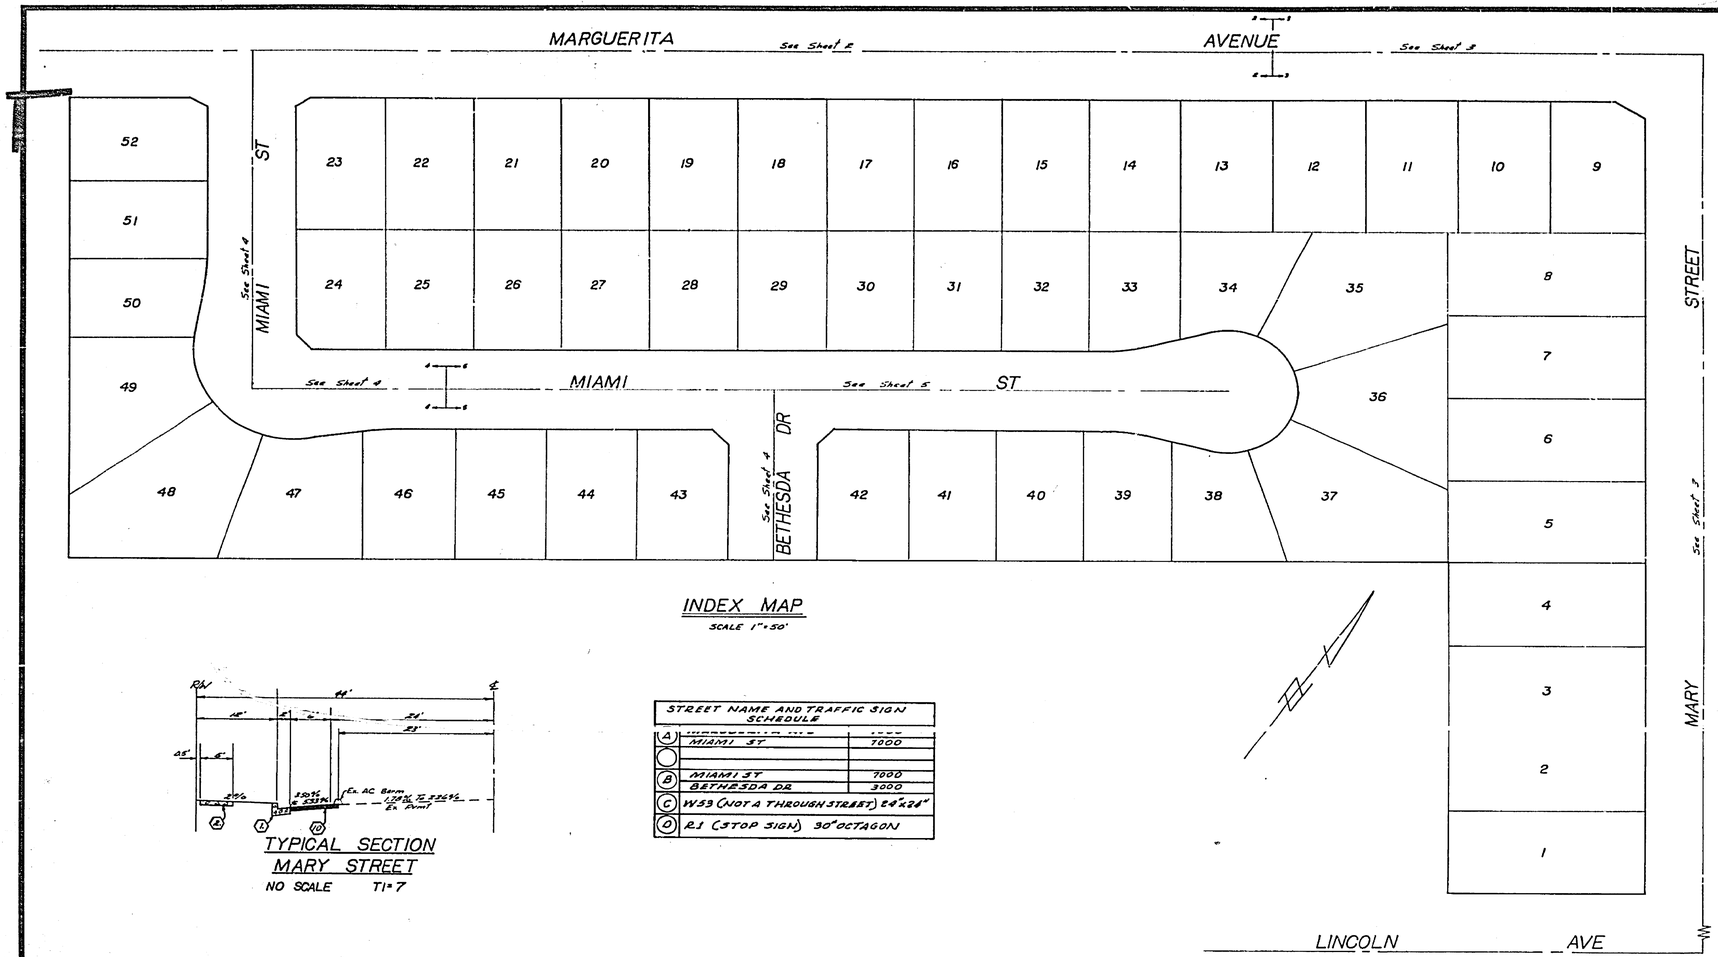

INDEX MAP

SCALE 1"=50'

STREET NAME AND TRAFFIC SIGN SCHEDULE		
A	MIAMI ST.	7000
B	MIAMI ST	7000
	BETHESDA DR	3000
C	W39 (NOT A THROUGH STREET) 24"x24"	
D	R1 (STOP SIGN) 30" OCTAGON	

TYPICAL SECTION
MARY STREET
NO SCALE TI=7

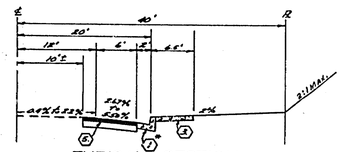

TYPICAL SECTION
MARGUERITA AVE
NO SCALE TI=5
*8"C.F. STA 15+11.40 To 16+03.40

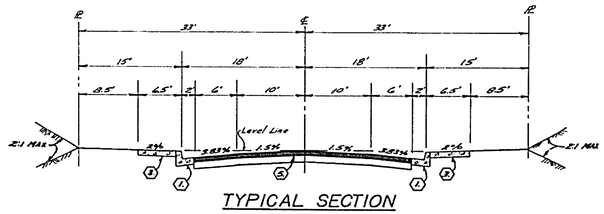

TYPICAL SECTION
BETHESDA DR
MIAMI ST
NO SCALE TI=5

GENERAL NOTES

1. The private engineer signing these plans is responsible for the accuracy and acceptability of the work hereon. In the event of discrepancies arising during construction, the private engineer shall be responsible for determining an acceptable solution and revising the plans for approval by the City.
2. Construction shall be in accordance with the Standard Specifications for Public Works Construction, 1976 Edition, and per City of Riverside Standard Drawings.
3. All flagged elevations shall be staked in the field by the Private Engineer.
4. The Subdivider shall arrange for a soils test to be made by a Soils Engineer after the streets have been prepared to rough grade. Depth of base material and A.C. paving shall be determined by the City of Riverside design standards and test procedures.
5. Driveway approaches shall be located in the field and constructed per City of Riverside Standard No. 207 (A=20', B=35'). Location to be determined at time of construction by the Developer and as approved by the Traffic Engineer.
6. Curb will be staked at 25' intervals and 3' of curb.
7. Traffic control signs must be in place prior to opening streets to traffic.
8. It shall be the responsibility of the contractor to clear the right of way in accordance with the provisions of law as it affects each utility, including irrigation lines and appurtenances and at no cost to the City.
9. See Electrical Plans for number and location of required street lights.
10. Trim edge of existing pavement where new pavement joins to a smooth straight line. Construct match up paving as shown on plans and overlay paving as directed in the field to produce a smooth section. Engineer estimates overlay to be 47 tons.
11. 4"x4" Blockouts for mailboxes required in curbline sidewalk.

CONSTRUCTION NOTES

1. Construct P.C.C. Curb & Gutter per Riverside City Std #200 (6" C.F.)
2. Construct 5' P.C.C. Property Line sidewalk per Riverside City Std #325.
3. Construct 6' P.C.C. Curb Line Sidewalk per Riverside City Std #325.
4. Construct P.C.C. cross gutter per Riverside City Std #220 (width shown on plans)
5. Construct 2½ A.C. Pavement over 6" D.G. Base or 5½ A.C. Pavement over Compacted native.
6. Place 2"x4" Redwood Header
7. Construct Barricade per Riverside City Std #180
8. Construct Wheelchair Ramp per Riverside City Std #304
9. Construct P.C.C. Curb & Gutter per Riverside City Std #200 (8" C.F.)
10. Construct 4" A.C. Pavement over 9" D.G. Base or 7½ A.C. Pavement over Compacted native.

BENCH MARK

Pk nail & tag in Westerly curb return, Washington & Lincoln
Elev. 912.448 City B.M. G63

ALBERT A. WEBB ASSOCIATES
CIVIL ENGINEERS
RIVERSIDE, CALIFORNIA
APPROVED BY: [signature] DATE 10/25/76
R.E. No. 9870
W.O. 76-148 FOR: Woolhaven Enterprises F.B. 1039

MARK	REVISIONS	BY	DATE
B	Revised Note 5, Driveway width & Elev.	[illegible]	11-17
A	Added structural section per Soils Report	[illegible]	3-4-77

DESIGNED BY R.E.C. DRAWN BY C.R.A. CHECKED BY B.M.

CITY OF RIVERSIDE, CALIFORNIA
PUBLIC WORKS DEPARTMENT

APPROVED BY	BY	DATE
PRINCIPAL ENGINEER	[illegible]	3-7-77
PARK DEPARTMENT	[illegible]	1-10
TRAFFIC DIVISION	[illegible]	3-18
CHIEF PUB. WKS. ENGR.	[illegible]	4-25

APPROVED BY [signature]
DIRECTOR OF PUBLIC WORKS
DATE 4-27-77

STREET PLAN & PROFILE
TRACT NO 6734-1
INDEX SHEET
SCALE: AS SHOWN

INDEXED ZM
ACCOUNT NO. 5
DRAWING NUMBER R-1962
SHEET 1 OF 5
76-148-A

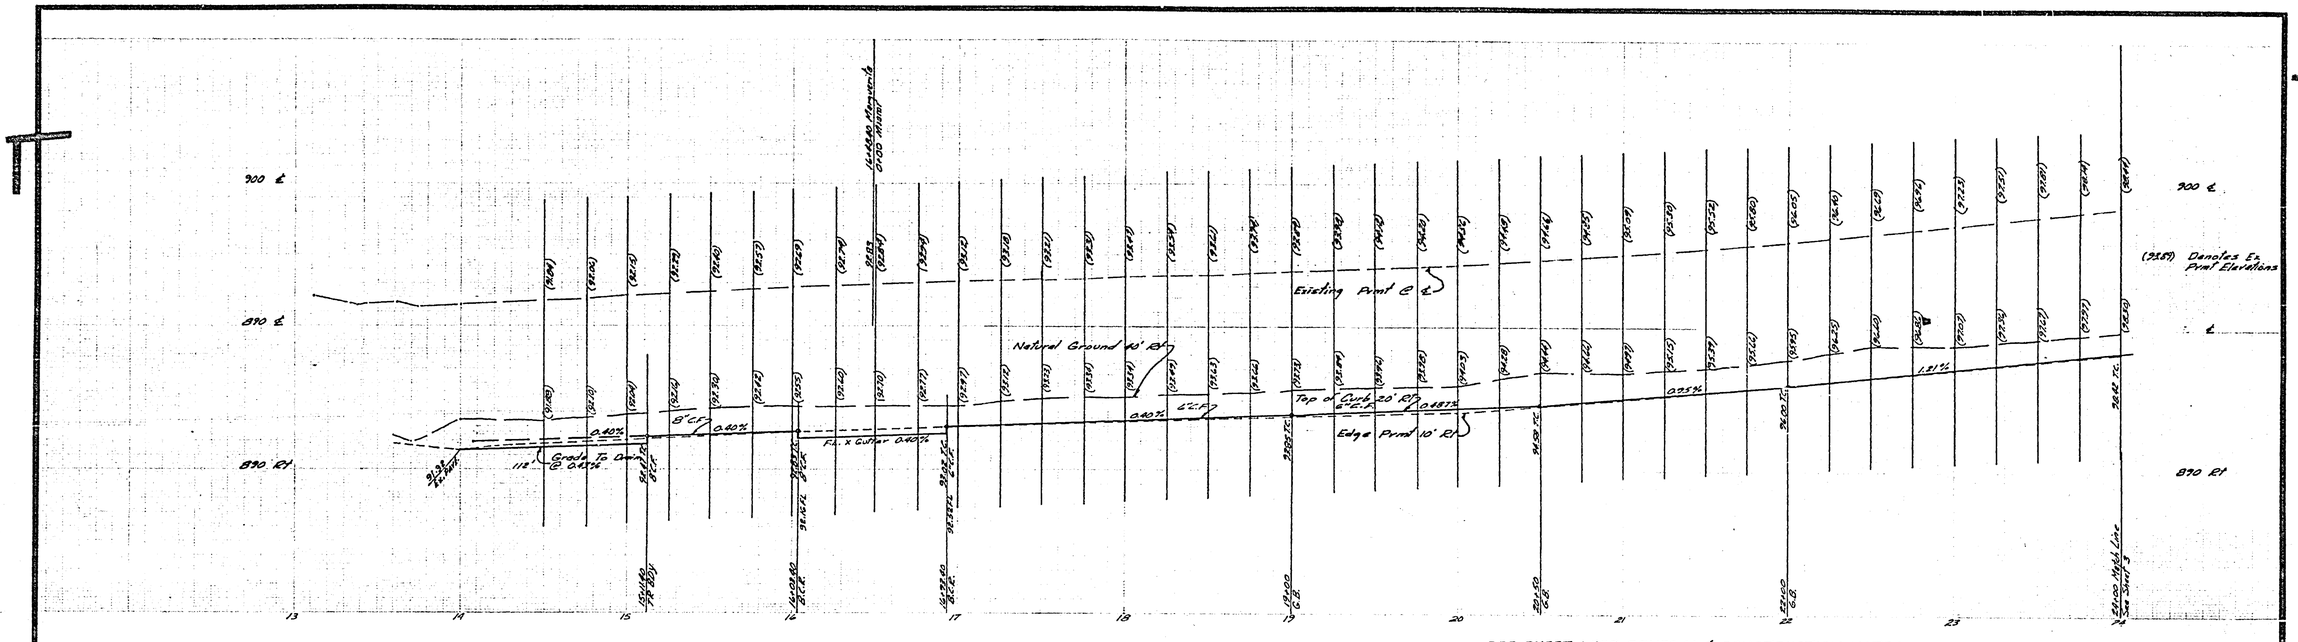

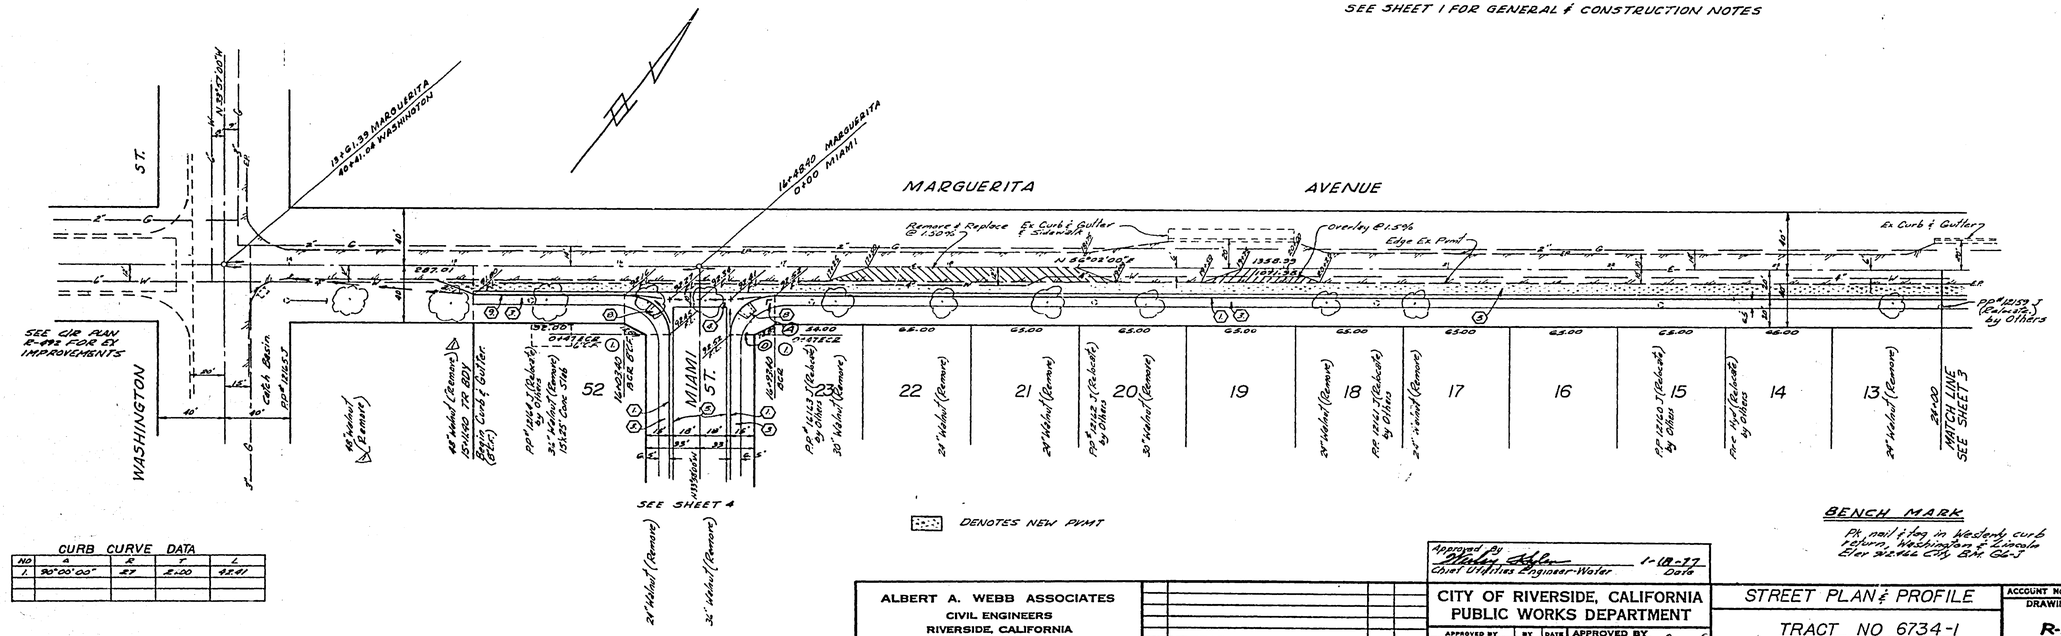

CURB CURVE DATA

NO	Δ	R	T	L

BENCH MARK


Approved By _____ Chief Utilities Engineer-Water 1-18-77 Date

ALBERT A. WEBB ASSOCIATES
CIVIL ENGINEERS
RIVERSIDE, CALIFORNIA
APPROVED BY: _____ DATE 10/24/76
R.E. No. 9876
W.O. 76-145 FOR: WOODHAVEN ENTERPRISES P.B. 1039

MARK	REVISIONS	APP.	DATE
1	Added 2 trees, take removed & Misc. work		9/11

DESIGNED BY RCC DRAWN BY EC CHECKED BY _____

CITY OF RIVERSIDE, CALIFORNIA
PUBLIC WORKS DEPARTMENT

APPROVED BY	BY	DATE
PRINCIPAL ENGINEER		4/25
PARK DEPARTMENT		1-30
TRAFFIC DIVISION		4/4
CHIEF PUB. WKS. ENGR.		4-25

APPROVED BY: _____ DIRECTOR OF PUBLIC WORKS
DATE 4-25-77

STREET PLAN & PROFILE
TRACT NO 6734-1
MARGUERITA AVE

SCALE: HORIZ. 1"=40' VERT. 1"=4'

ACCOUNT No.
DRAWING NUMBER R-1962
SHEET 2 OF 5
76-145-A

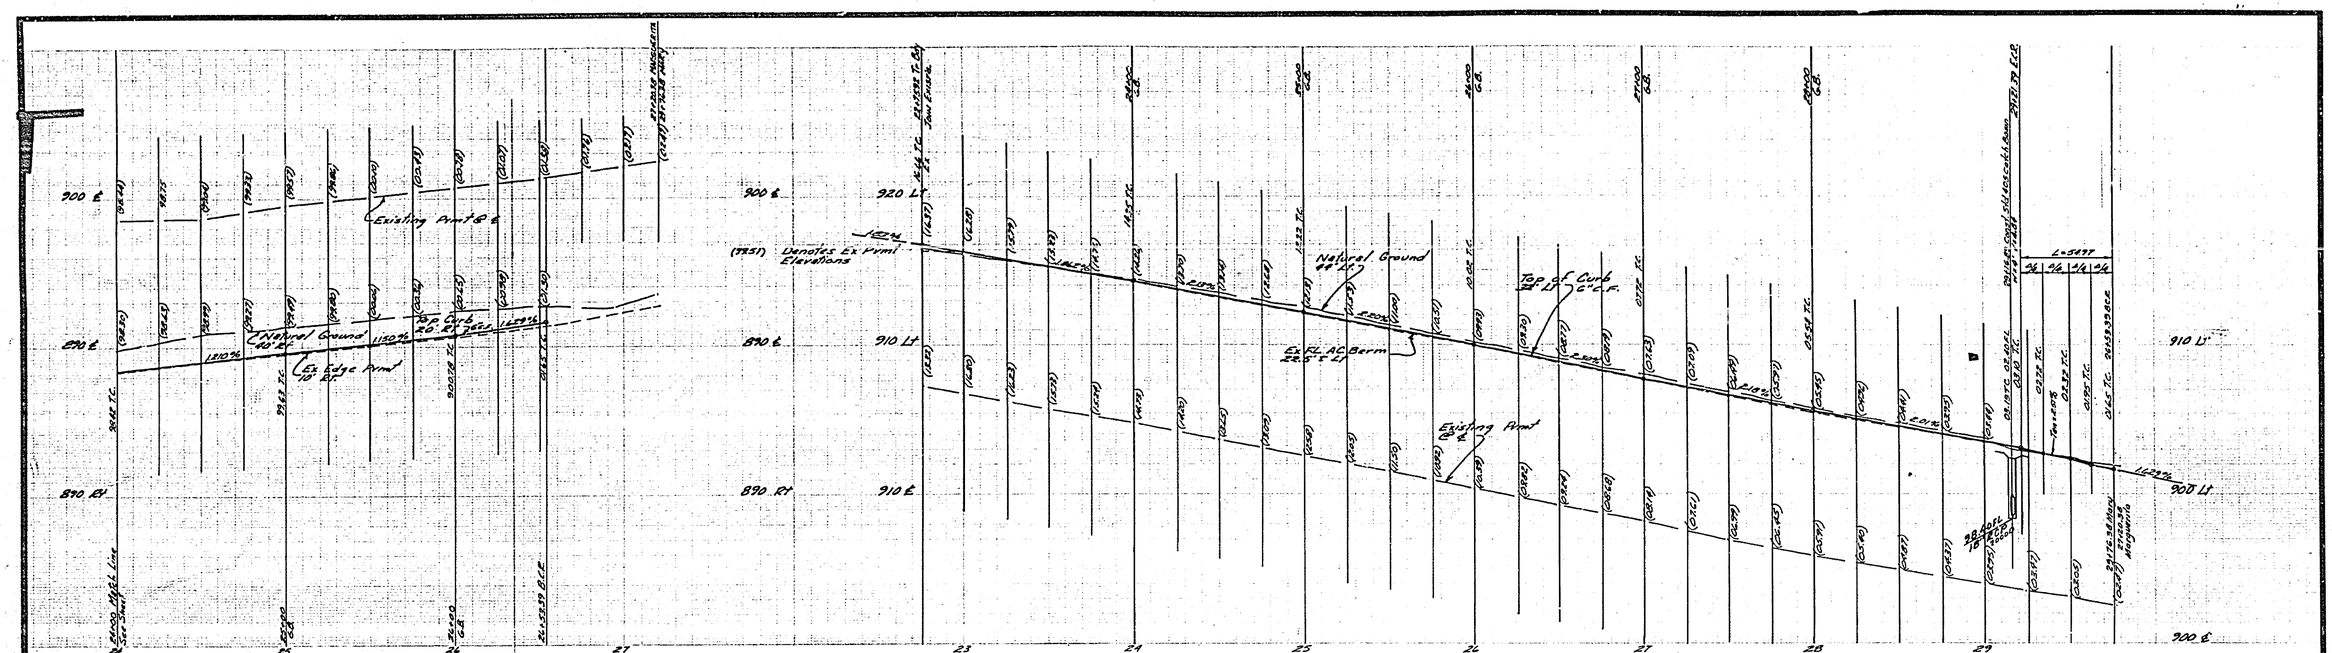
900 E
890 Rt
890 E
910 Lt
900 Lt
920 Lt
910 E
(7951) Denotes Ex Prml Elevations
Existing Prml @ E
Natural Ground
Ex Edge Prml
B.C. Curb
Ex FL AC Berm
Top of Curb
Existing Prml @
Ex 18" ECP

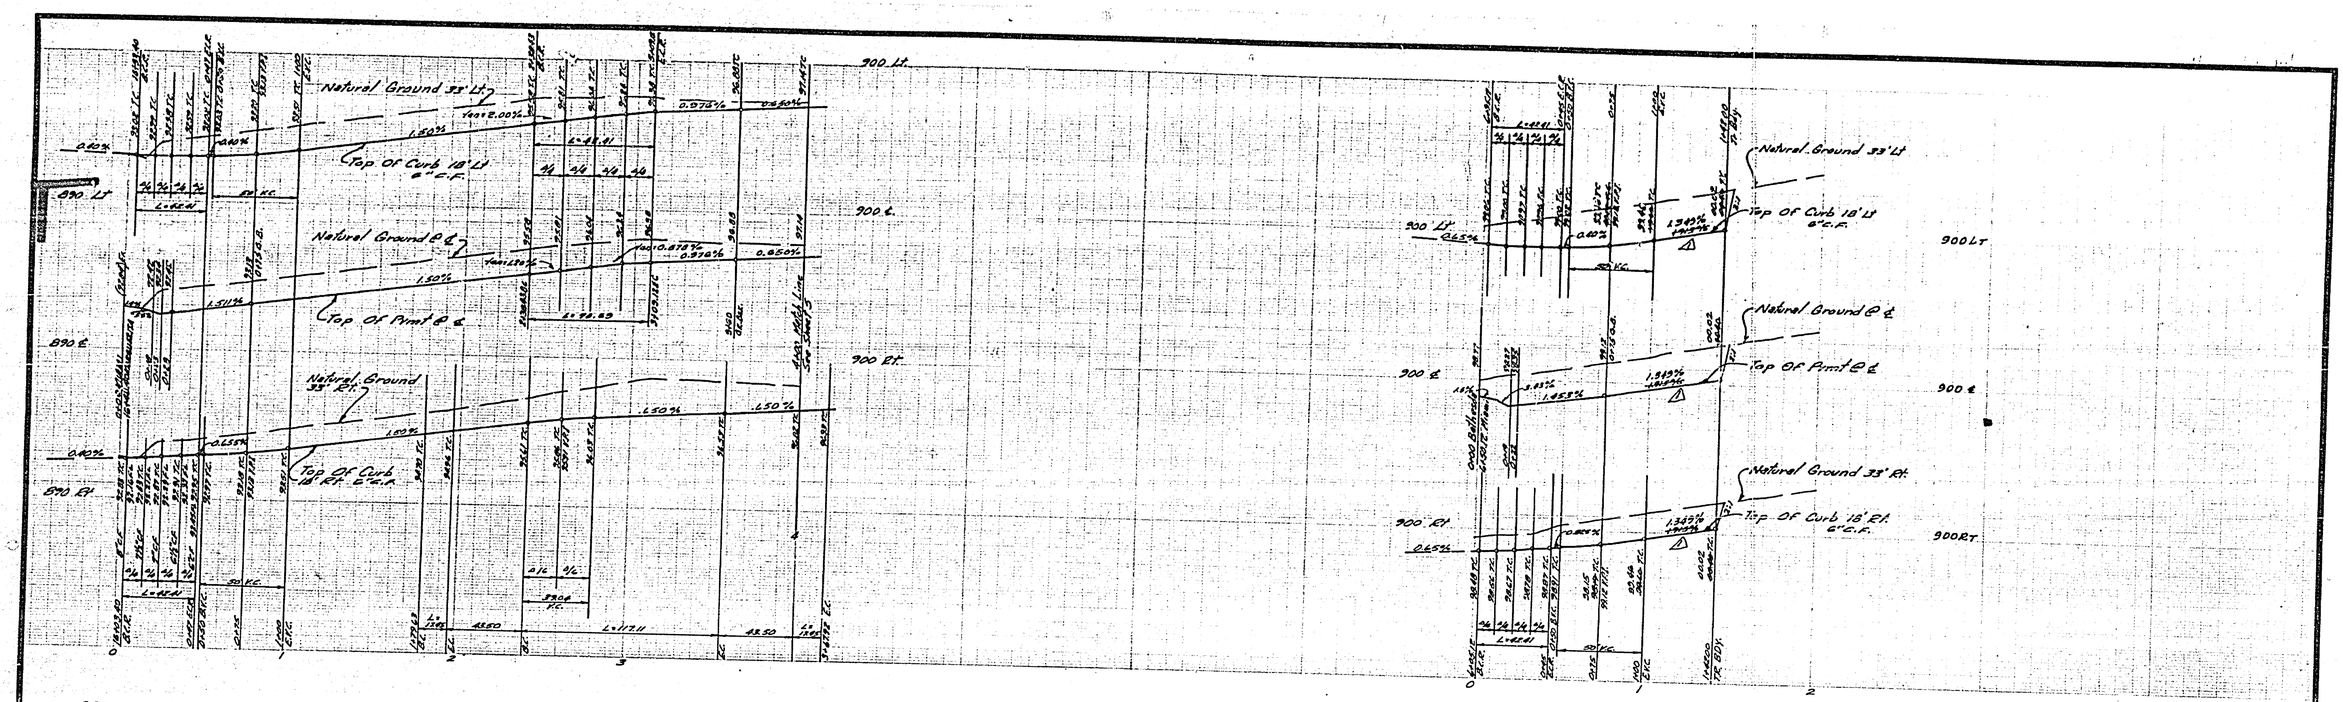

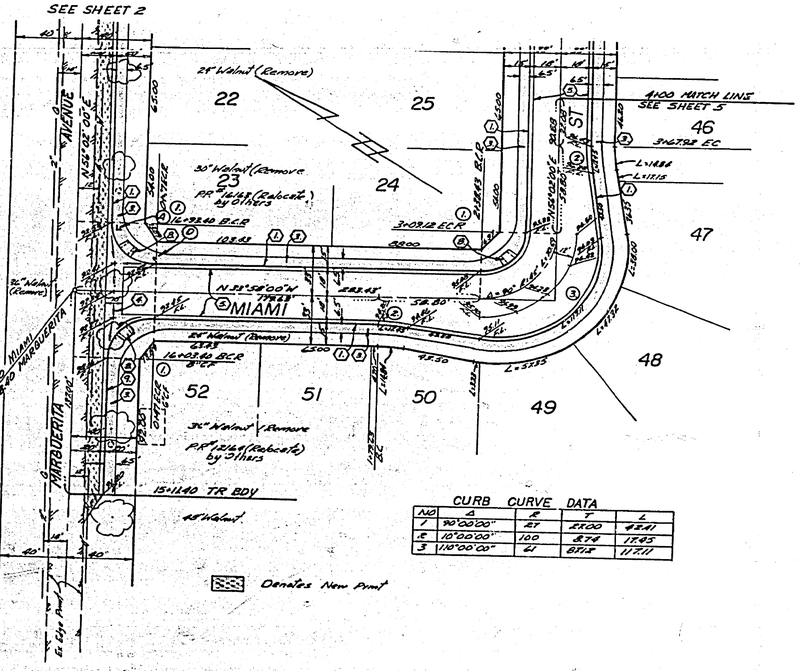

CURB CURVE DATA

NO	Δ	R	T	L
1	90°00'00"	27	27.00	42.41
2	10°00'00"	100	8.74	17.45

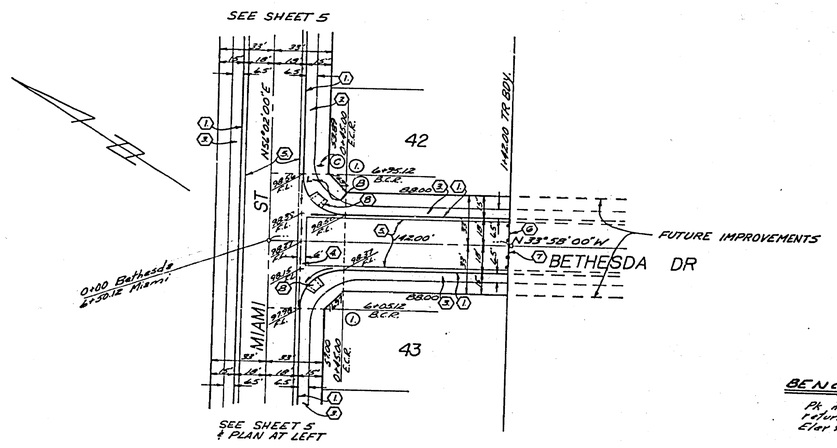

BENCH MARK

Pk nail & tag in westerly curb return, Washington & Lincoln Elev 818.66 City B.M. 6273

ALBERT A. WEBB ASSOCIATES
CIVIL ENGINEERS
RIVERSIDE, CALIFORNIA
APPROVED BY [illegible] DATE 12/14/76
R.E. No. 9876
W.O. 76-148 for: Wood Homes Enterprises, Inc. 1139

MARK REVISIONS APPR. DATE
1 Lowered Street - Bethesda Dr. E.W.H. 4/7/77

DESIGNED BY EAC DRAWN BY LEE CHECKED BY RDH

CITY OF RIVERSIDE, CALIFORNIA
PUBLIC WORKS DEPARTMENT

APPROVED BY	BY	DATE
PRINCIPAL ENGINEER	[illegible]	4-25
PARK DEPARTMENT	[illegible]	4-25
TRAFFIC DIVISION	[illegible]	4-25
CHIEF PUB. WKS. ENGR.	[illegible]	4-25
CITY ENGR.	[illegible]	4-25

APPROVED BY [illegible]
DIRECTOR OF PUBLIC WORKS
DATE 4-27-77

STREET PLAN PROFILE
TRACT NO 6734-1
MIAMI ST
BETHESDA DR

ACCOUNT No.
DRAWING NUMBER R-1962
SHEET 4 OF 5
SCALE: Horiz 1"=40' Vert 1"=4'
76-148-1

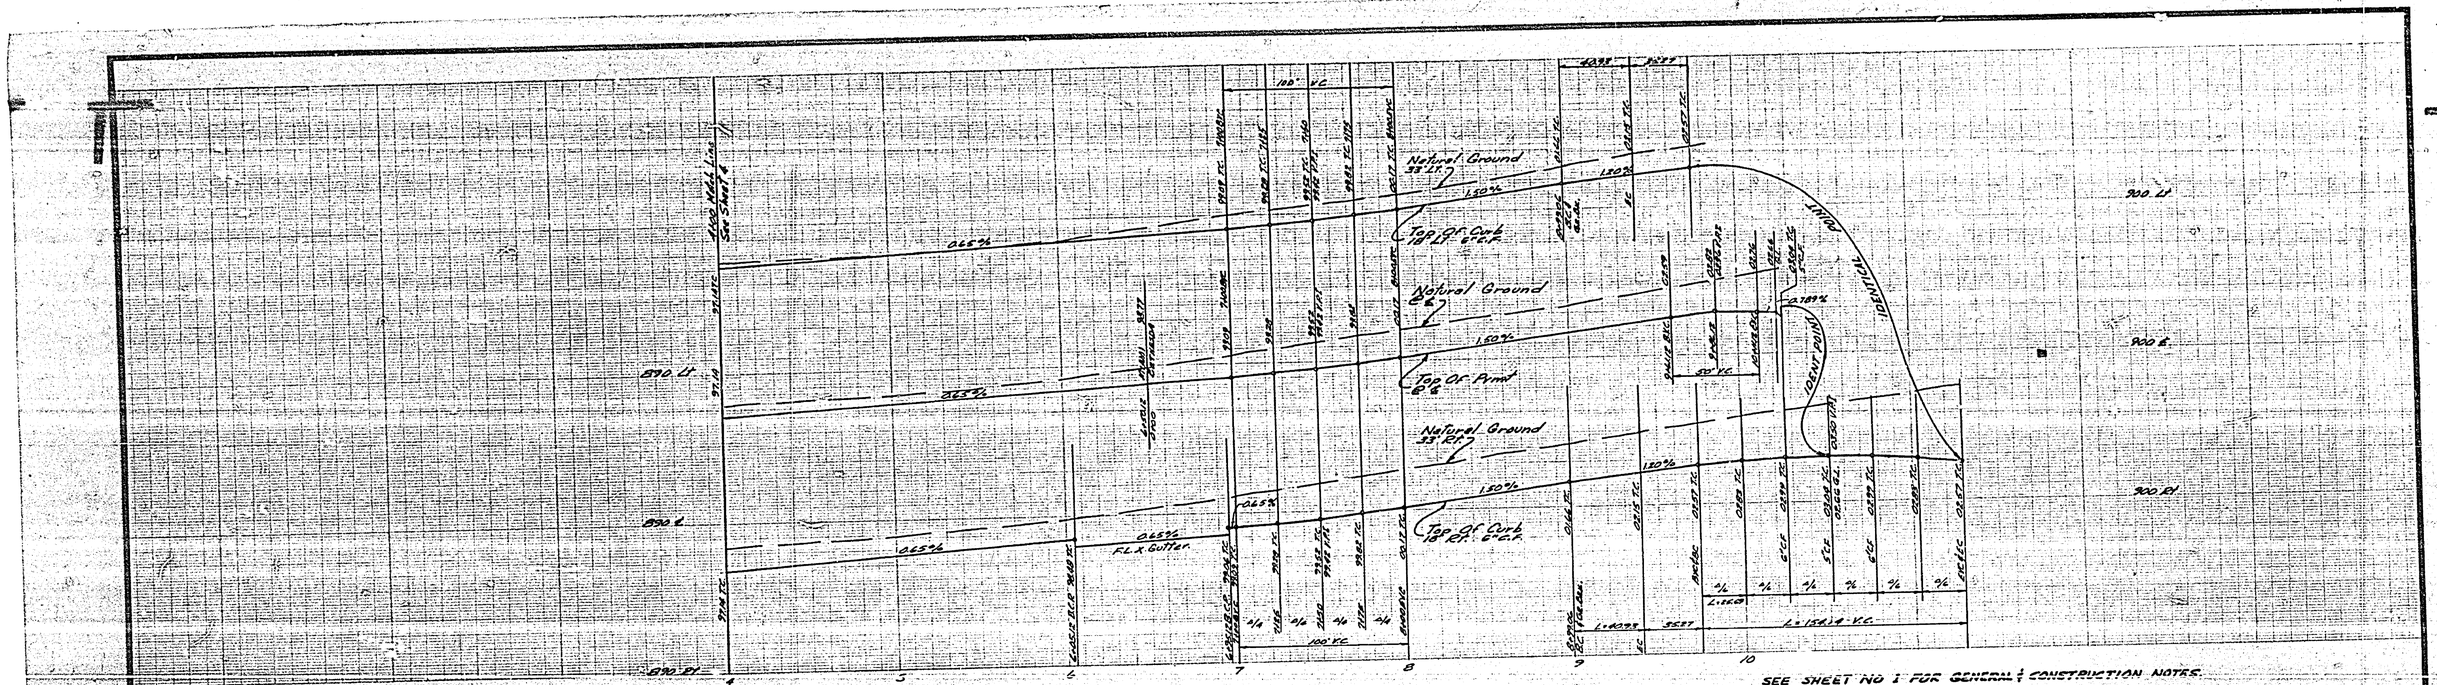

CURB CURVE DATA				
NO	Δ	R	T	L
1	91°-00'-00"	27	27.00	42.41
4	20°-23'-27"	115	20.63	40.93
5	220°-46'-54"	40		154.14

BENCH MARK

Pk nail & tag in Westerly curb returns, Washington & Lincoln
Elev. 824.466 City, Bnk. GL-J

ALBERT A. WEBB ASSOCIATES
CIVIL ENGINEERS
RIVERSIDE, CALIFORNIA
APPROVED BY: D. O'Neill DATE 10/24/72
R.E. No. 9576
W.O. 76-148 FOR: Woodhaven Enterprises F.B. 1079

MARK	REVISIONS	APPR.	DATE

DESIGNED BY: ETC DRAWN BY: LEM CHECKED BY: RDH

CITY OF RIVERSIDE, CALIFORNIA
PUBLIC WORKS DEPARTMENT

APPROVED BY	BY	DATE
PRINCIPAL ENGINEER	[illegible]	4/26
PARK DEPARTMENT	RD	1-00
TRAFFIC DIVISION	[illegible]	4/26
CHIEF PUB. WKS. ENGR.	[illegible]	4-25

APPROVED BY: [signature]
DIRECTOR OF PUBLIC WORKS
DATE 4-25-77

STREET PLAN & PROFILE
TRACT NO 6734-1
MIAMI ST

SCALE: Horiz 1"=40' Vert 1"=4'

ACCOUNT No.
DRAWING NUMBER R-1962
SHEET 5 OF 5
76-148-A