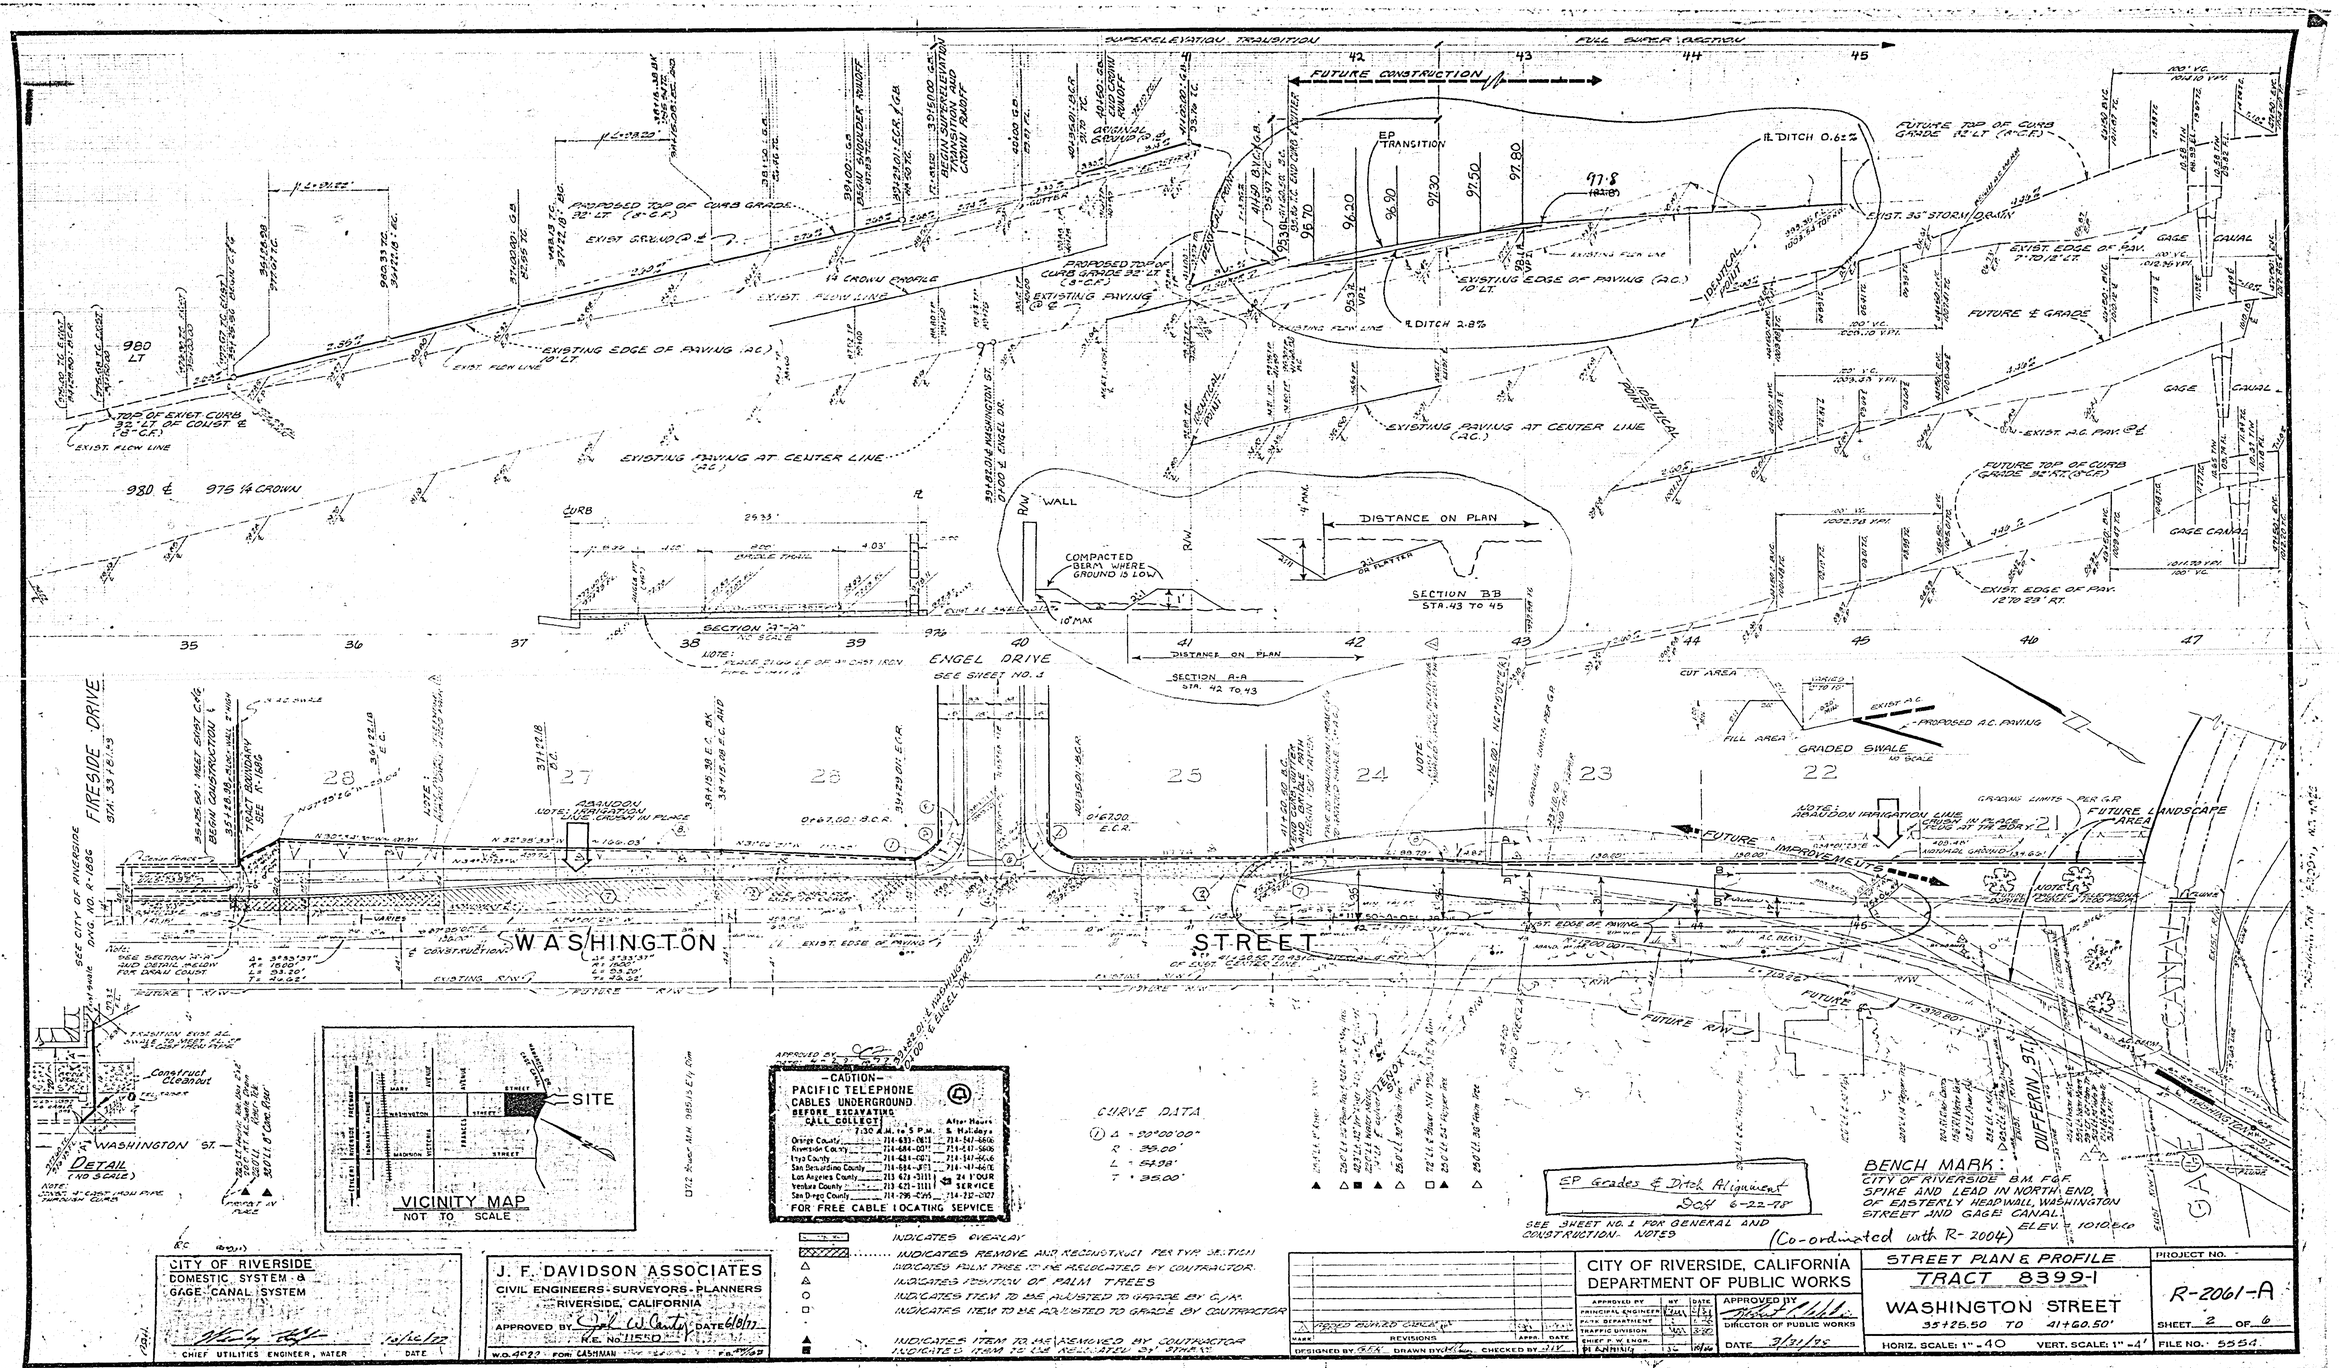

SUPERELEVATION TRANSITION
FULL SUPER SECTION
FUTURE CONSTRUCTION
EP TRANSITION
PROPOSED TOP OF CURB GRADE 32' LT. (8" C.F.)
EXIST. GROUND @ ℄
EXISTING EDGE OF PAVING (A.C.) 10' LT.
EXISTING PAVING AT CENTER LINE (A.C.)
EXISTING PAVING @ ℄
EXIST. FLOW LINE
TOP OF EXIST. CURB 32' LT. OF CONST. ℄ (8" C.F.)
980 LT
980 ℄ 975 ¼ CROWN
FUTURE TOP OF CURB GRADE 32' LT. (8" C.F.)
EXIST. 36" STORM DRAIN
EXIST. EDGE OF PAV. 7' TO 12' LT.
FUTURE ℄ GRADE
GAGE CANAL
EXIST. A.C. PAV. @ ℄
EXIST. EDGE OF PAV. 12' TO 23' RT.
℄ DITCH 0.62%
℄ DITCH 2.8%
IDENTICAL POINT
WALL
COMPACTED BERM WHERE GROUND IS LOW
DISTANCE ON PLAN
SECTION BB STA. 43 TO 45
SECTION A-A STA. 42 TO 43
SECTION "A"-"A" NO SCALE
ENGEL DRIVE SEE SHEET NO. 1
FIRESIDE DRIVE
CUT AREA
FILL AREA
GRADED SWALE
PROPOSED A.C. PAVING
FUTURE LANDSCAPE AREA
FUTURE IMPROVEMENTS
WASHINGTON STREET
DUFFERIN ST.
GAGE CANAL
DETAIL (NO SCALE)
WASHINGTON ST.
Construct Cleanout
VICINITY MAP NOT TO SCALE
SITE
CAUTION
PACIFIC TELEPHONE CABLES UNDERGROUND BEFORE EXCAVATING CALL COLLECT
7:30 A.M. to 5 P.M.
After Hours & Holidays
Orange County 714-633-0611 714-547-6606
Riverside County 714-684-0011 714-547-6606
Inyo County 714-684-0011 714-547-6606
San Bernardino County 714-684-0011 714-547-6606
Los Angeles County 213-623-3111 24 HOUR SERVICE
Ventura County 213-621-1111
San Diego County 714-296-0295 714-232-3207
FOR FREE CABLE LOCATING SERVICE
CURVE DATA
① Δ = 90°00'00"
R = 35.00'
L = 54.98'
T = 35.00'
EP Grades & Ditch Alignment DCH 6-22-78
SEE SHEET NO. 1 FOR GENERAL AND CONSTRUCTION NOTES
BENCH MARK: CITY OF RIVERSIDE B.M. F.G.F. SPIKE AND LEAD IN NORTH END OF EASTERLY HEADWALL, WASHINGTON STREET AND GAGE CANAL. ELEV. = 1010.60
(Co-ordinated with R-2004)
INDICATES OVERLAY
INDICATES REMOVE AND RECONSTRUCT PER TYP. SECTION
INDICATES PALM TREE TO BE RELOCATED BY CONTRACTOR
INDICATES POSITION OF PALM TREES
INDICATES ITEM TO BE ADJUSTED TO GRADE BY C.I.R.
INDICATES ITEM TO BE ADJUSTED TO GRADE BY CONTRACTOR
INDICATES ITEM TO BE REMOVED BY CONTRACTOR
INDICATES ITEM TO BE RELOCATED BY OTHERS
CITY OF RIVERSIDE DOMESTIC SYSTEM & GAGE CANAL SYSTEM
CHIEF UTILITIES ENGINEER, WATER
DATE
J. F. DAVIDSON ASSOCIATES
CIVIL ENGINEERS - SURVEYORS - PLANNERS
RIVERSIDE, CALIFORNIA
APPROVED BY
DATE 6/8/77
R.E. No. 11550
W.O. 4022 FOR: CASHMAN
CITY OF RIVERSIDE, CALIFORNIA
DEPARTMENT OF PUBLIC WORKS
APPROVED BY
DIRECTOR OF PUBLIC WORKS
DATE 3/31/78
STREET PLAN & PROFILE
TRACT 8399-1
WASHINGTON STREET
35+25.50 TO 41+60.50'
HORIZ. SCALE: 1" = 40
VERT. SCALE: 1" = 4'
PROJECT NO. R-2061-A
SHEET 2 OF 6
FILE NO. 5554