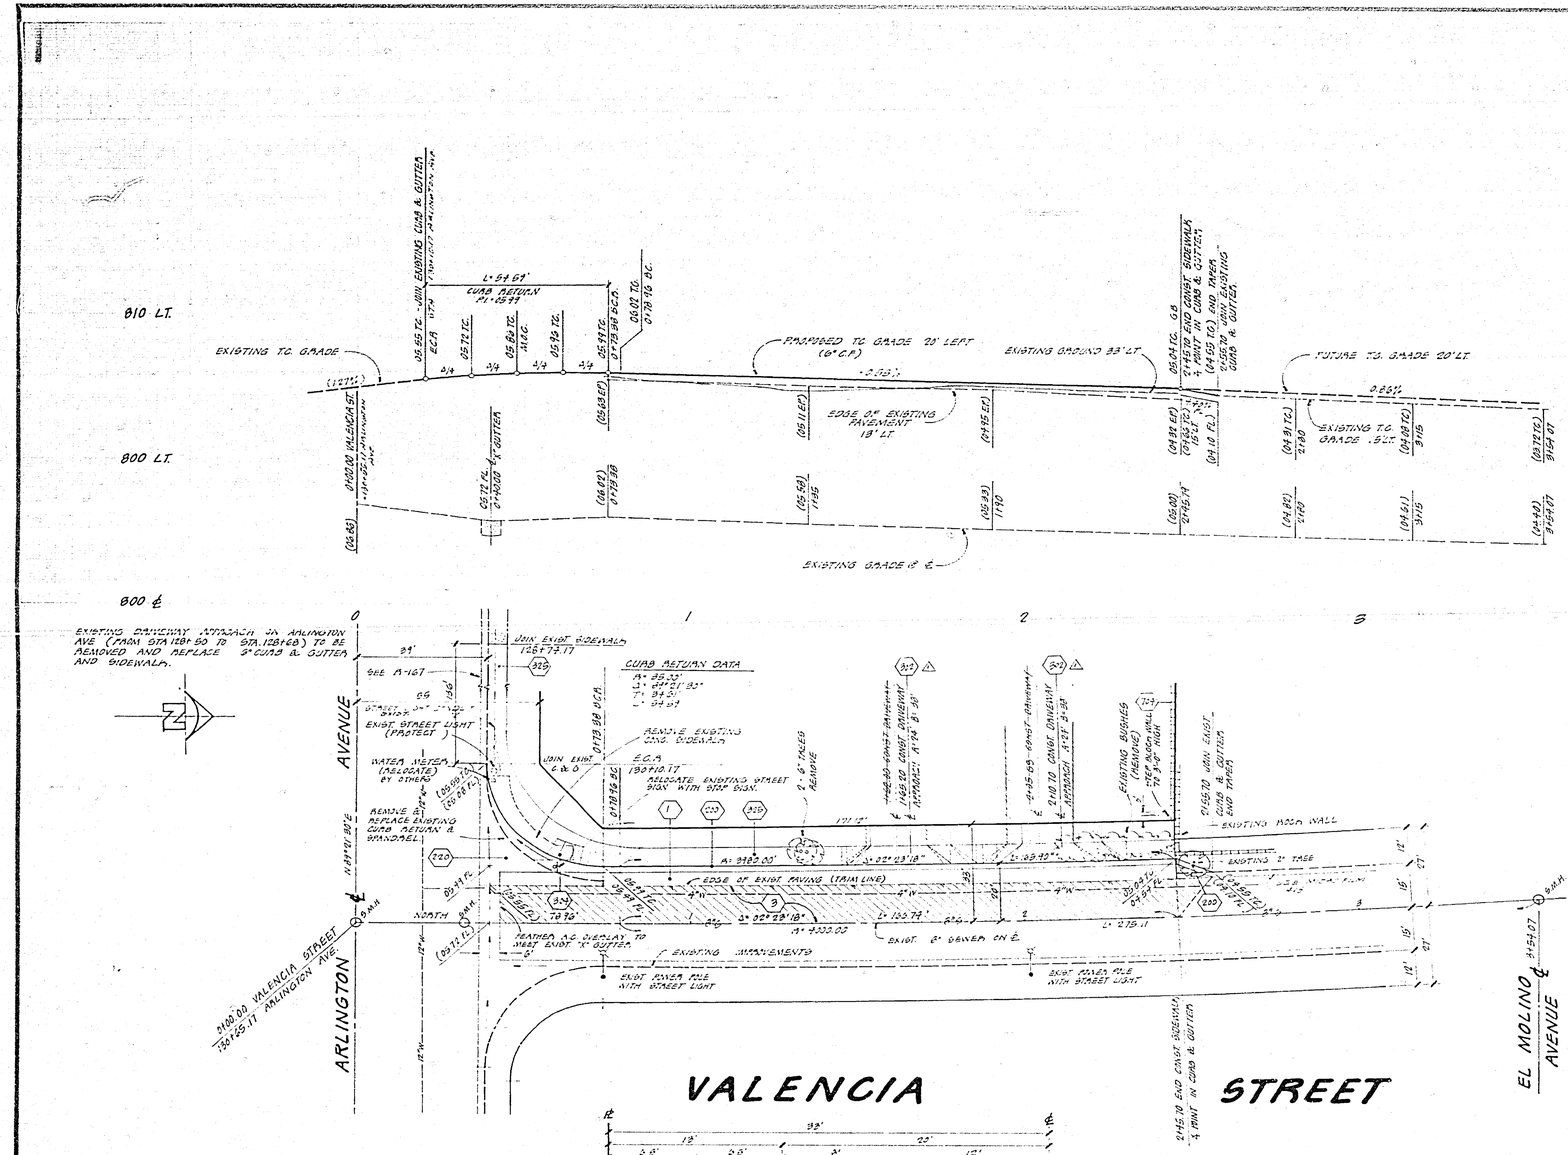
810 LT.
800 LT.
800 ℄
EXISTING T.G. GRADE
(127.7')
0100.00 VALENCIA ST.
1301.29.11 ARLINGTON AVE.
(130.46)
EXISTING DRIVEWAY APPROACH ON ARLINGTON AVE (FROM STA 1281+50 TO STA 1281+68) TO BE REMOVED AND REPLACE 6" CURB & GUTTER AND SIDEWALK.
JOIN EXIST. SIDEWALK 1284+77.17
SEE A-167
EXIST. STREET LIGHT (PROTECT)
WATER METER (RELOCATE) BY OTHERS
REMOVE & REPLACE EXISTING CURB RETURN & SPANDREL
N 89°11' 30" E
(89.98 FT.)
(89.72 FT.)
NORTH
ARLINGTON AVENUE
ARLINGTON ℄
℄ VALENCIA STREET
℄ EL MOLINO AVENUE
CURB RETURN DATA
Δ= 35°32'
D= 64°31' 00"
T= 94.51'
L= 94.61'
R= 89.56'
0+178.38 B.C.
0+273.17 E.C.
RELOCATE EXISTING STREET SIGN WITH STOP SIGN.
JOIN EXIST. C & G
0+178.38 B.C.
E.C.A.
1301+73.17
REMOVE EXISTING CONC. SIDEWALK
2' 6" TALES REMOVE
1+56.99 BEGIN 6" CONST. DRIVEWAY APPROACH A-1 BY 8'-0"
1+45.69 6" CONST. DRIVEWAY APPROACH A-1 BY 8'-0"
2+10.70 END CONST. DRIVEWAY APPROACH A-1 BY 8'-0"
EXISTING BUSHES (REMOVE)
SEE BLOCK WALL TO 5'-0" HIGH
2+56.70 JOIN EXIST. CURB & GUTTER AND TAPER
EXISTING BLOCK WALL
EXISTING 2" TREE
A= 9382.00'
Δ= 02° 23' 18"
L= 195.90'
EDGE OF EXIST. PAVING (TRIM LINE)
2" A.C. OVERLAY
3" A.C. OVERLAY
3.00%
2.00%
EXIST. 8" SEWER ON ℄
EXISTING IMPROVEMENTS
EXIST. POWER POLE WITH STREET LIGHT
EXIST. POWER POLE WITH STREET LIGHT
2+45.11 END CONST. SIDEWALK & POINT IN CURB & GUTTER
9 P.M.H.
3+54.07
PROPOSED T.G. GRADE 20' LEFT (6" C.P.)
EXISTING GROUND 33' LT.
FUTURE T.G. GRADE 20' LT.
0.25%
EDGE OF EXISTING PAVEMENT 18' LT.
0+04.84 T.G. G.B.
0+45.12 END CONST. SIDEWALK & CURB & GUTTER
(41.0 F.L.)
1+56.99 JOIN EXISTING CURB & GUTTER
EXISTING T.G. GRADE 15' LT.
EXISTING GRADE ℄
(127.12)
(127.46)
(127.46)
(127.46

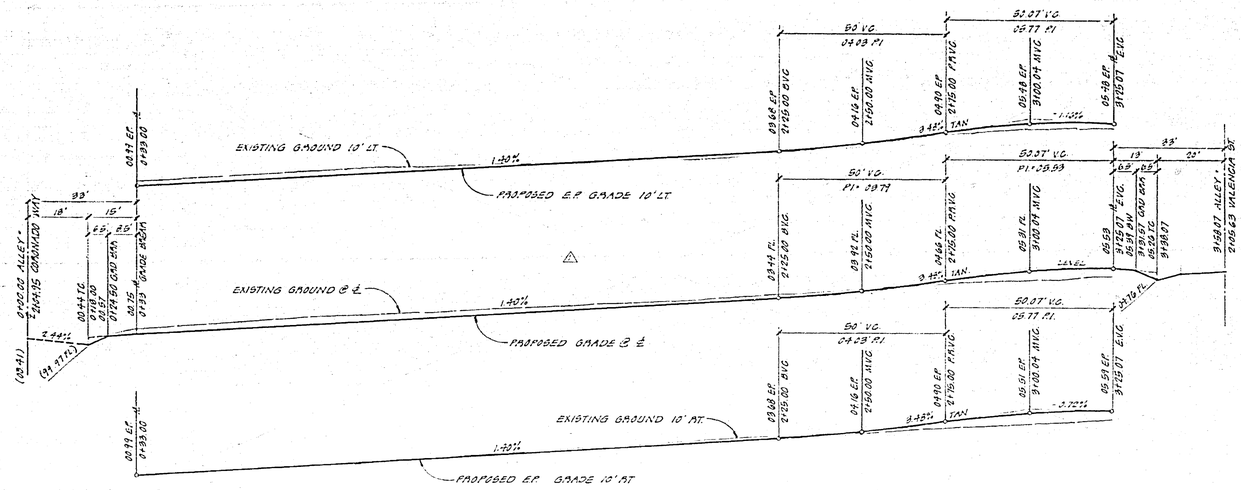

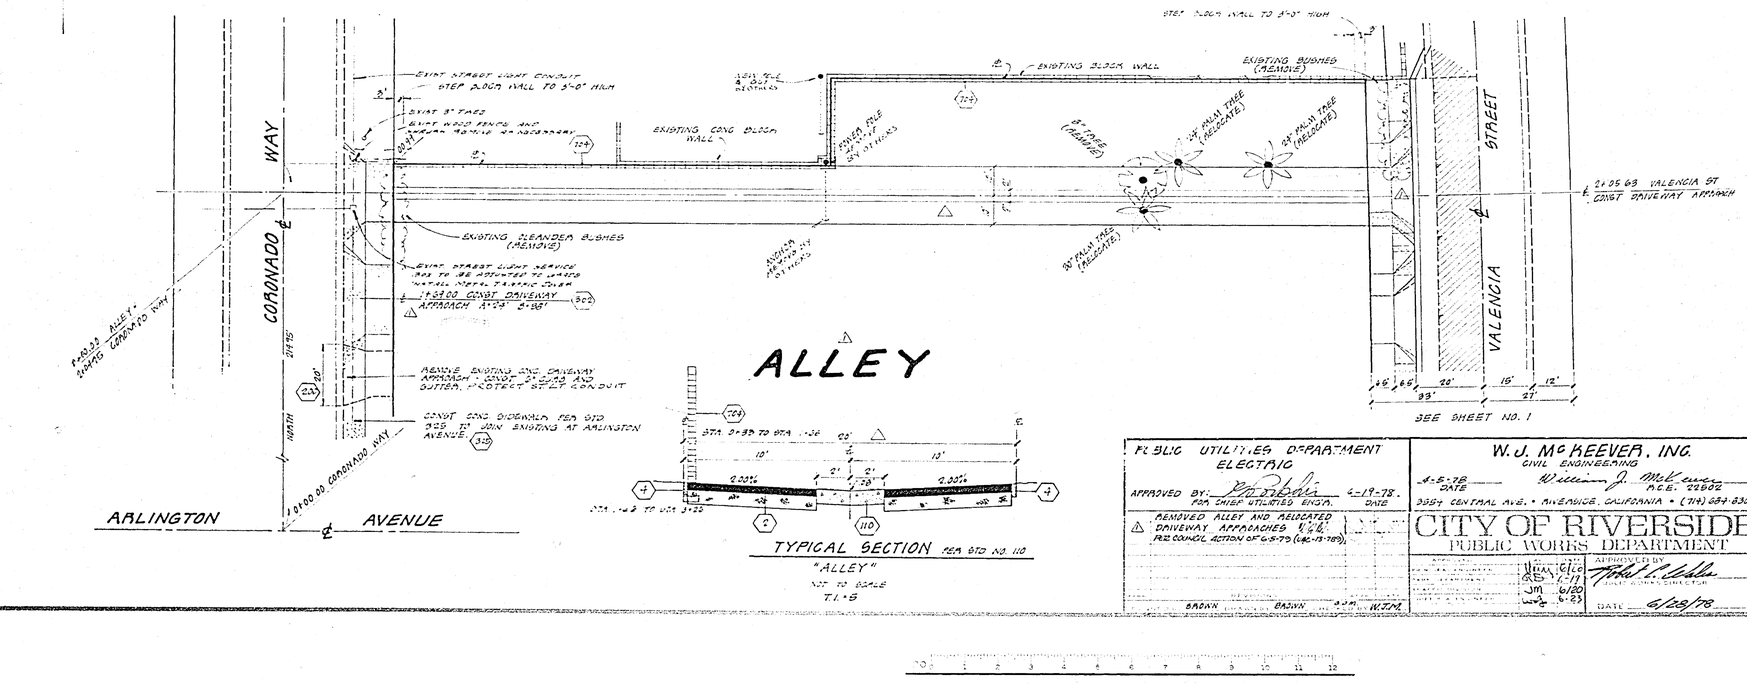

BENCH MARK: CITY OF RIVERSIDE 68-G

FOUND CONCRETE MONUMENT WITH WIRE DOWN 14" SET MONUMENT CAP AT INTERSECTION OF ARLINGTON AVE. AND PALOMAR ST. P.B. 7/35/21 ELEV. 719.69

PUBLIC UTILITIES DEPARTMENT ELECTRIC APPROVED BY: _____ FOR CHIEF UTILITIES ENGR. 6-19-78 DATE	W. J. McKEEVER, INC. CIVIL ENGINEERING 6-5-78 DATE 3954 CENTRAL AVE. • RIVERSIDE, CALIFORNIA • (714) 684-8300	PLANNING DEPARTMENT APPROVED BY: _____ 6/19/78 ACTING PLANNING DIRECTOR DATE
⚠ REMOVED ALLEY AND RELOCATED DRIVEWAY APPROACHES 6/26/78 PER COUNCIL ACTION OF 6-5-78 (CAL-13-78)	CITY OF RIVERSIDE PUBLIC WORKS DEPARTMENT	STREET PLAN & PROFILE OF (A-26-723) ALLEY FROM "CORONADO WAY" TO "VALENCIA STREET"
DRAWN _____ CHECKED BR DRAWN _____ W.J.M.	APPROVED BY: _____ DIRECTOR OF PUBLIC WORKS DATE 6/28/78	ACCOUNT NO R-2111 SHEET 2 OF 2 HORIZ. SCALE 1" = 20' VERT. SCALE 1" = 4'

P4-1