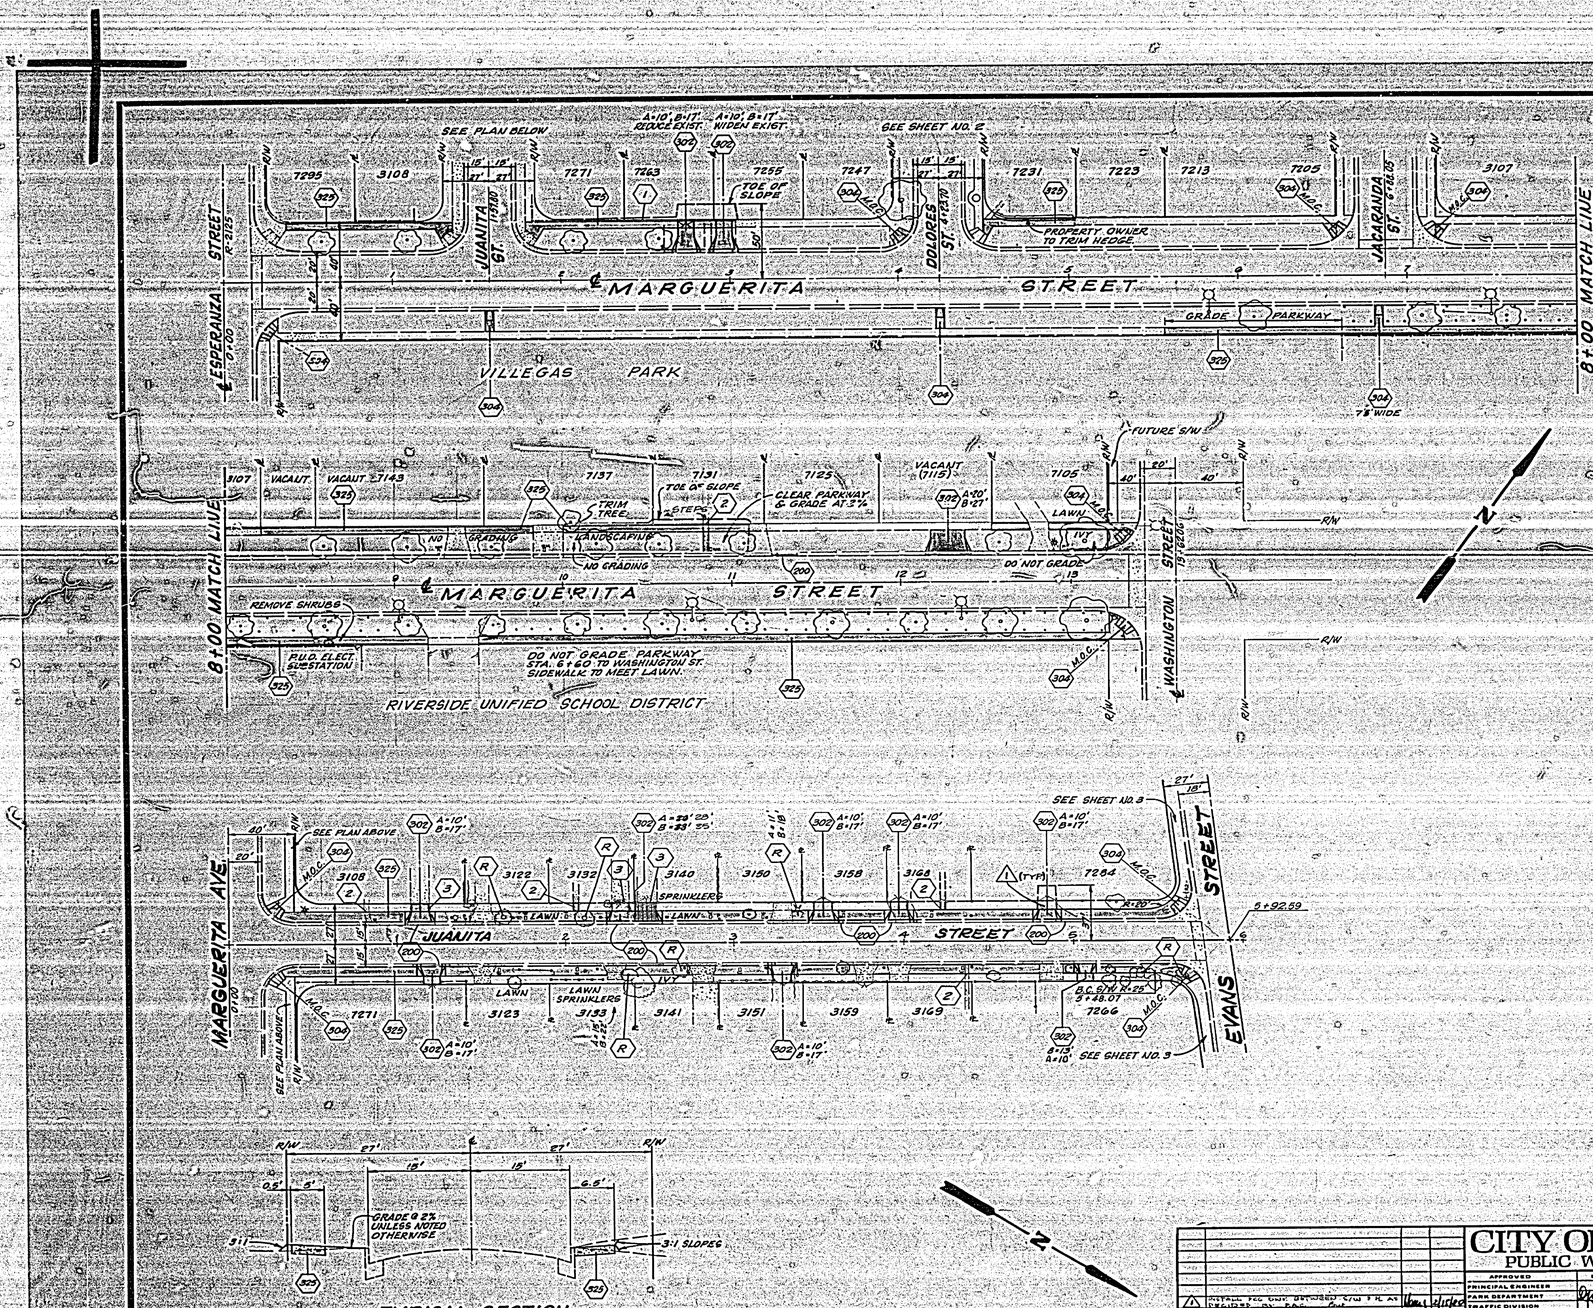

CONSTRUCTION NOTES

1. CONSTRUCTION SHALL BE IN ACCORDANCE WITH STANDARD SPECIFICATIONS FOR PUBLIC WORKS CONSTRUCTION, 1979 EDITION, AND CITY OF RIVERSIDE STD. DWGS.
2. CONTRACTOR TO RESET ANY STREET NAME AND TRAFFIC SIGNS.

CONSTRUCTION LEGEND

- (200) CONST. CURB & GUTTER, PER STD. DWG. NO. 200.
- (302) CONST. DRIVEWAY APPROACH PER STD. DWG. NO. 302.
- (304) CONST. WHEELCHAIR RAMP PER STD. DWG. NO. 304.
- (325) CONST. SIDEWALK PER STD. DWG. NO. 325.
- (R) REMOVE ENTIRE TREE.
- (1) RELOCATE FENCE.
- (2) CONNECT PCC WALK TO S/W.
- (3) EXTEND PCC D/W.

AS BUILT 10/28/81 BCBT

INDEXED BNF

MARK	REVISIONS	APP.	DATE
1	Install PCC Curb, Gutter, Sidewalk, C/W & R.R. As Directed By ...	Wm. L. Stiles	

DESIGNED BY: WMH DRAWN BY: KK CHECKED BY:

CITY OF RIVERSIDE
PUBLIC WORKS DEPARTMENT

	BY	DATE
APPROVED PRINCIPAL ENGINEER		
PARK DEPARTMENT	[illegible]	9-14-79
TRAFFIC DIVISION	[illegible]	9-14-79
CHIEF F. W. ENGINEER	[illegible]	10-3

APPROVED BY: [signature] PUBLIC WORKS DIRECTOR
DATE 10/3/79

HCD PROJECT 1978-79
CASA BLANCA AREA
MARGUERITA & JUANITA STREETS

HORIZ. SCALE: 1" = 40' VERT. SCALE: 1" =

ACCOUNT NO. 8-850-447

R-2145

SHEET 1 OF 3

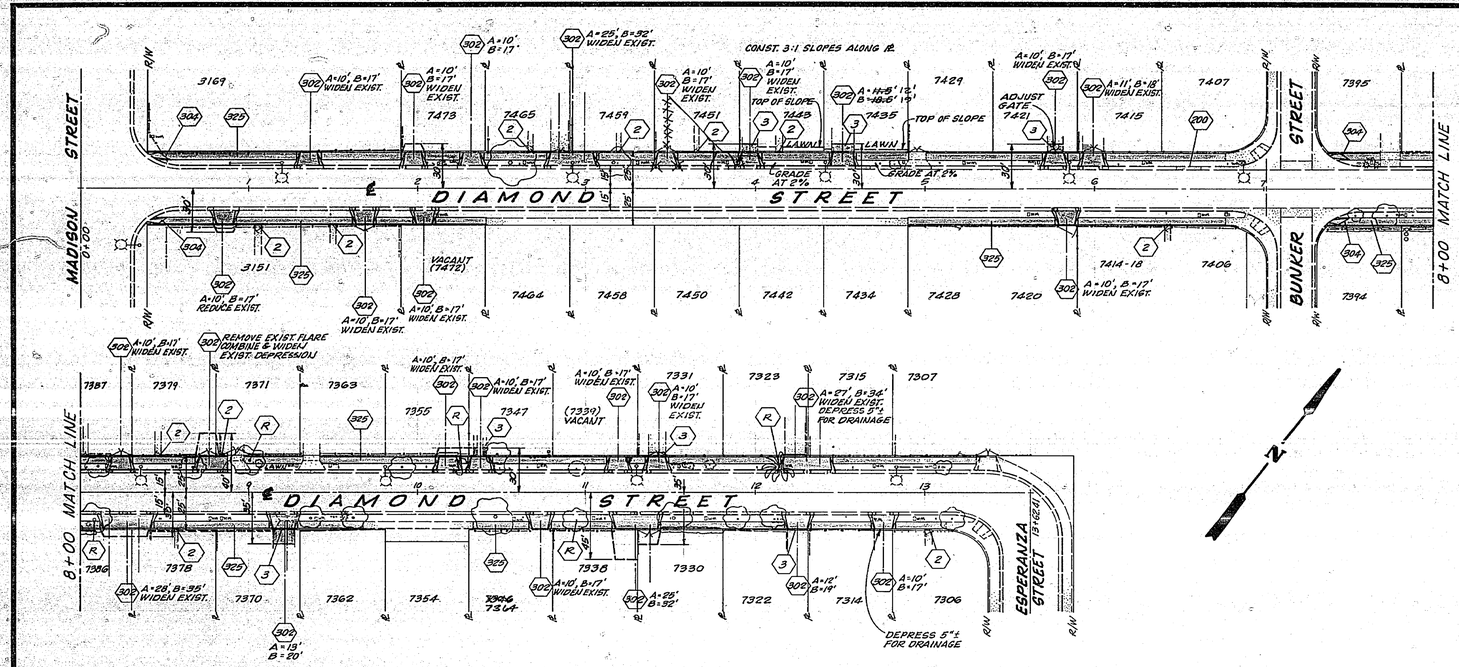

NOTE:
SEE SHEET NO. 1 FOR CONSTRUCTION NOTES & LEGEND.

△ ON DIAMOND ST. ~~AND DOLORES ST.~~ GRADE PARKWAY ADJACENT TO NEW CONSTRUCTION, EXCEPTION: PROPERTY OWNERS HAVE LANDSCAPED THE AREA AND IT IS AT THE PROPER PARKWAY SLOPE.

* AS BUILT 10/26/81 SBBT

MARK	REVISIONS	APPR.	DATE
1	INSTALL V.C.P. INLET, RECONSTRUCT R/D AND		
2	PER AS BUILT BY PWE (DWG.		
3	CHANGED TO CURB & G/D AS EXISTING		
4	BY PROPERTY OWNERS		

DESIGNED BY: [illegible] DRAWN BY: [illegible] CHECKED BY: [illegible]

CITY OF RIVERSIDE
PUBLIC WORKS DEPARTMENT

APPROVED	BY	DATE
PRINCIPAL ENGINEER		
PARK DEPARTMENT	[illegible]	7-30-79
TRAFFIC DIVISION	[illegible]	9-11-79
CHIEF P. W. ENGINEER	[illegible]	10-3

APPROVED BY: [illegible]
PUBLIC WORKS DIRECTOR
DATE 10/3/79

HCD PROJECT 1978-79
CASA BLANCA AREA
DIAMOND & DOLORES STREETS

HORIZ. SCALE: 1" = 40' VERT. SCALE: 1" =

INDEXED NAME
ACCOUNT NO 15-550-497
R-2145
SHEET 2 OF 3

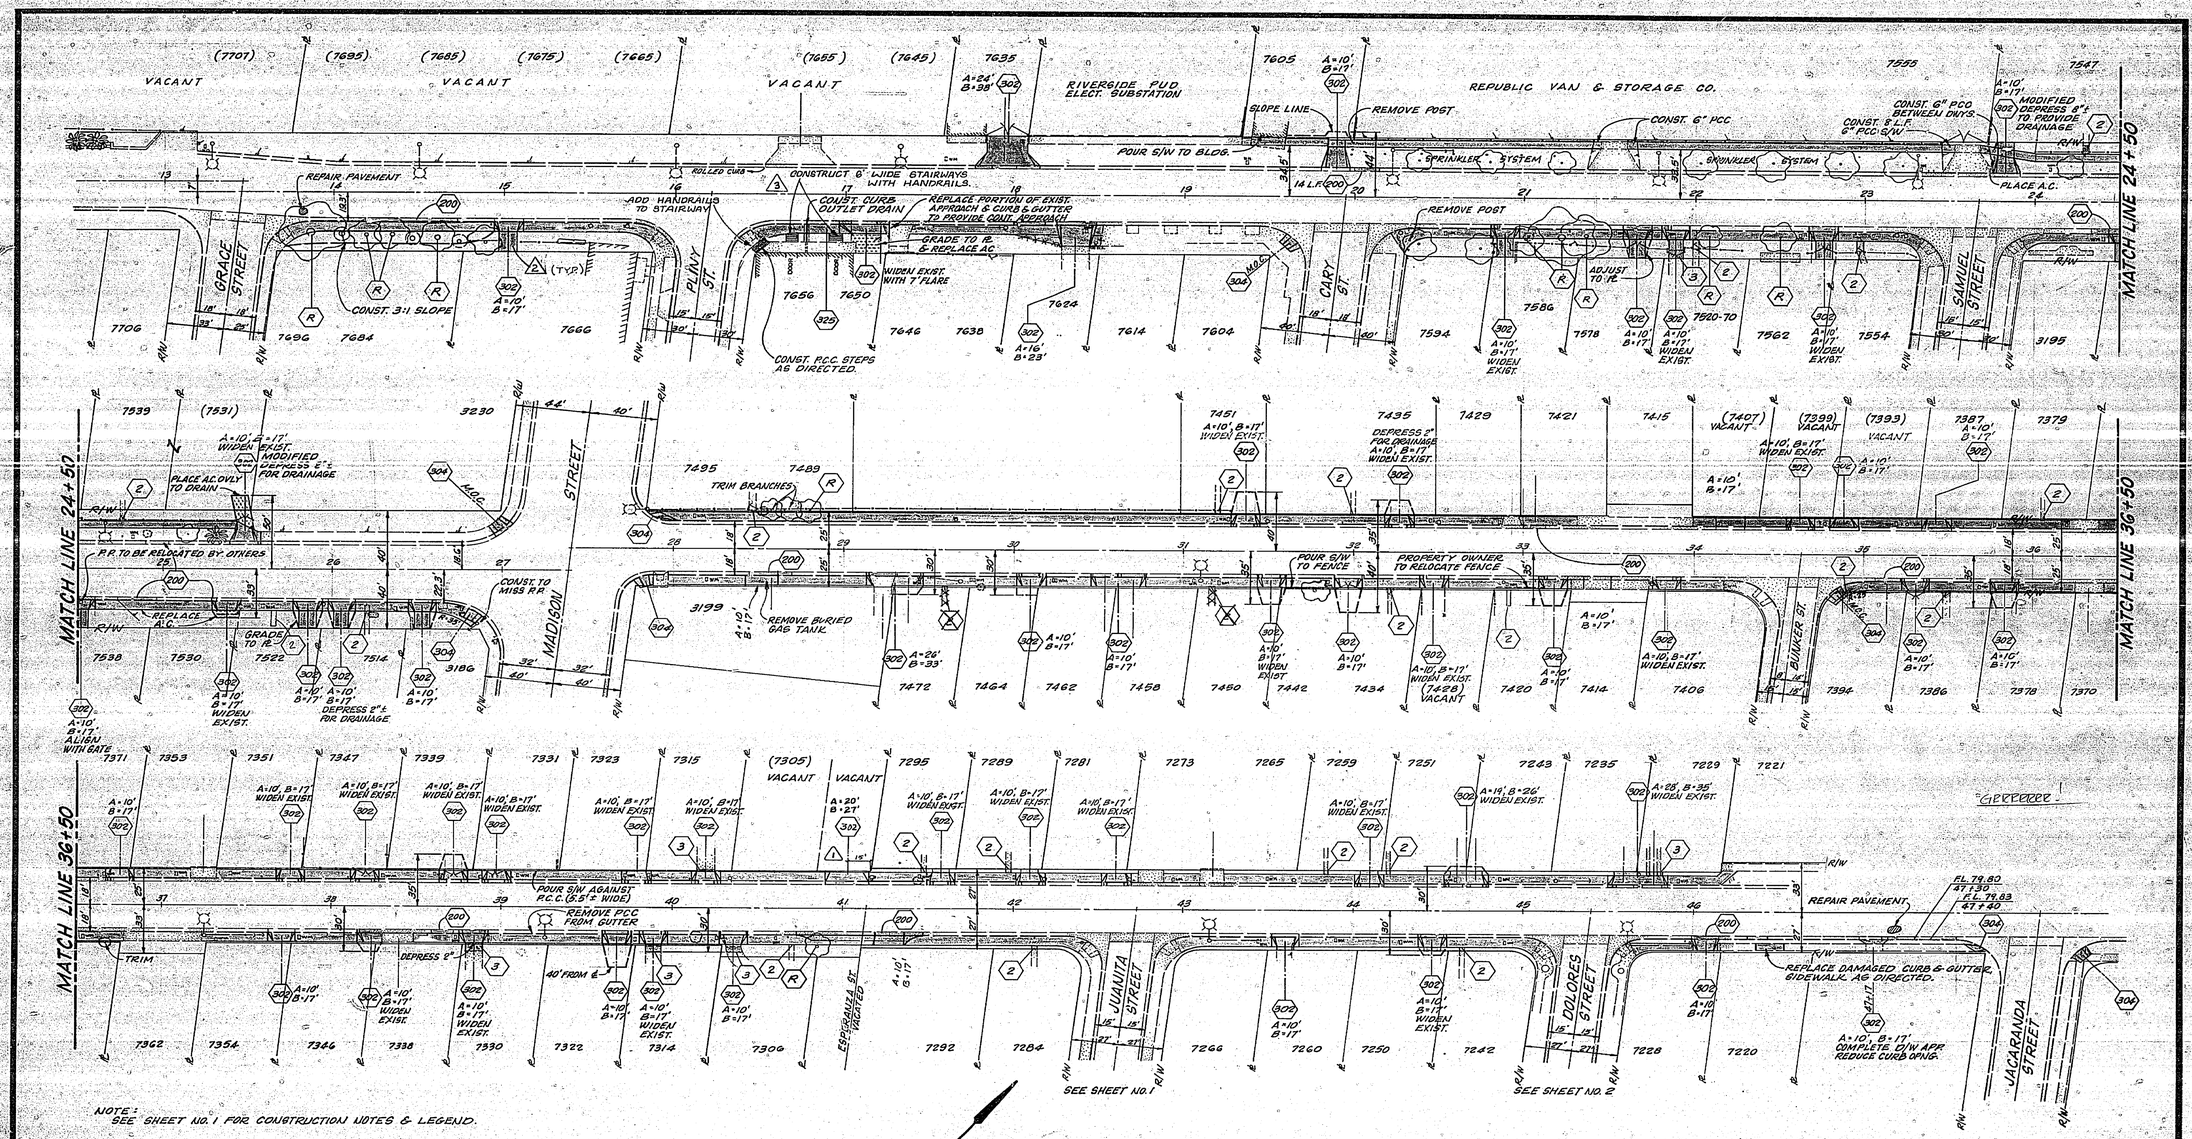

NOTE:
SEE SHEET NO. 1 FOR CONSTRUCTION NOTES & LEGEND.

* as built 10/26/81 BRET

MARK	REVISIONS	APPR.	DATE
3	ADDED 2 STAIRWAYS AND HANDRAILS AS DESIGNED BY P.A.C.	[illegible]	4/27/80
2	INSTALL PCC DWY. GRT. S/W AND ℄ AS DESIGNED BY P.A.C. (Bid)	[illegible]	2/15/80
1	ADD DRIVEWAY FOR 7505 EVANS REQUESTED BY PROPERTY OWNER	[illegible]	1/29/80

DESIGNED BY [illegible] DRAWN BY KRT CHECKED BY

CITY OF RIVERSIDE
PUBLIC WORKS DEPARTMENT

APPROVED	BY	DATE
PRINCIPAL ENGINEER		
PARK DEPARTMENT	[illegible]	9-26-79
TRAFFIC DIVISION	[illegible]	9-18-79
CHIEF P. W. ENGINEER	[illegible]	10-3

APPROVED BY [signature]
PUBLIC WORKS DIRECTOR
DATE 10/3/79

HCD PROJECT 1978-79
CASA BLANCA AREA
EVANS STREET

HORIZ. SCALE: 1" = 40' VERT. SCALE: 1" =

INDEXED FILE
ACCOUNT NO. 15-550-497

R-2145

SHEET 3 OF 3

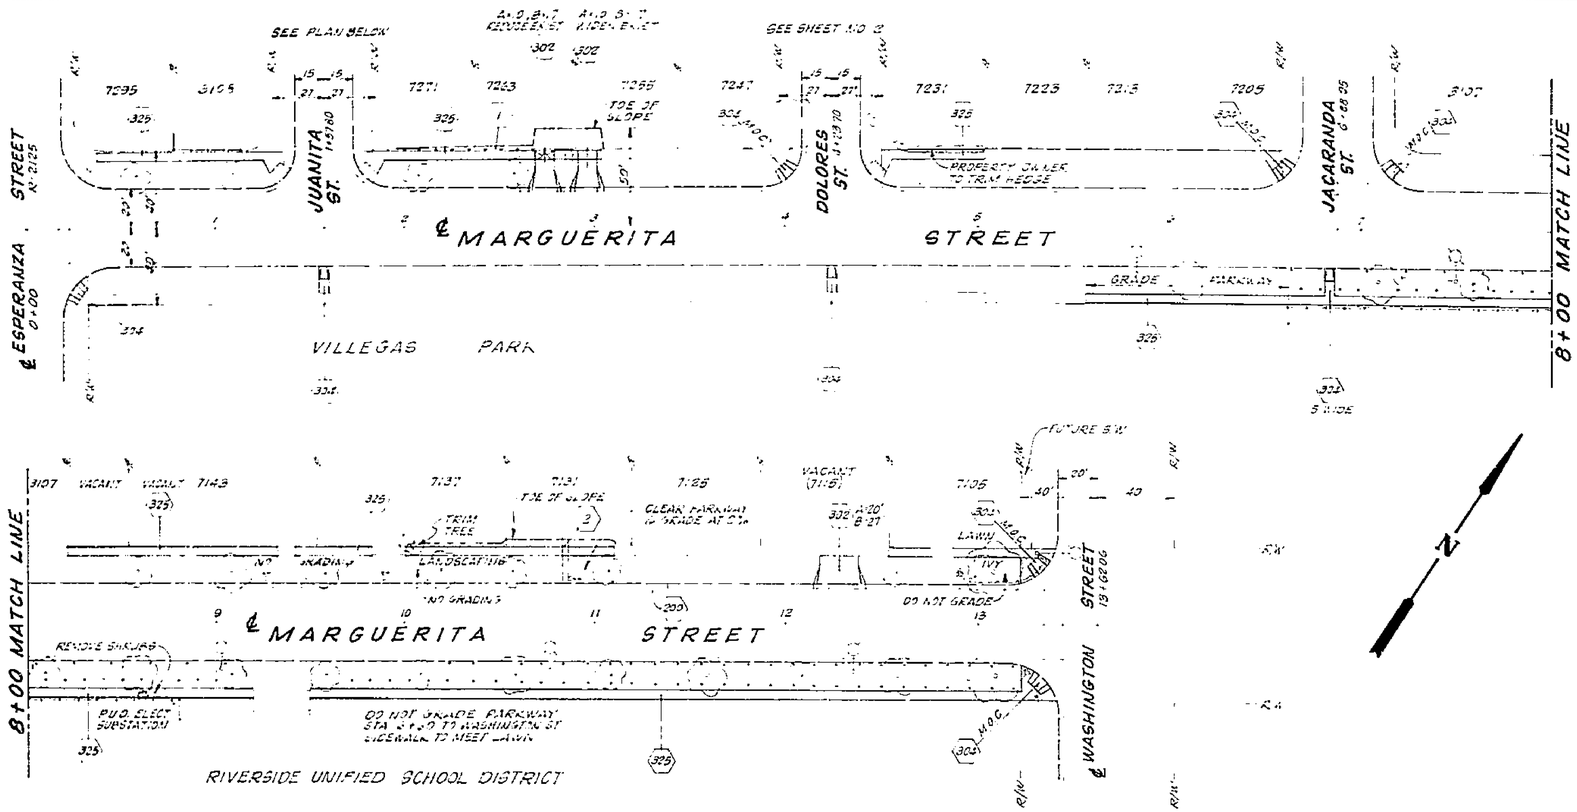

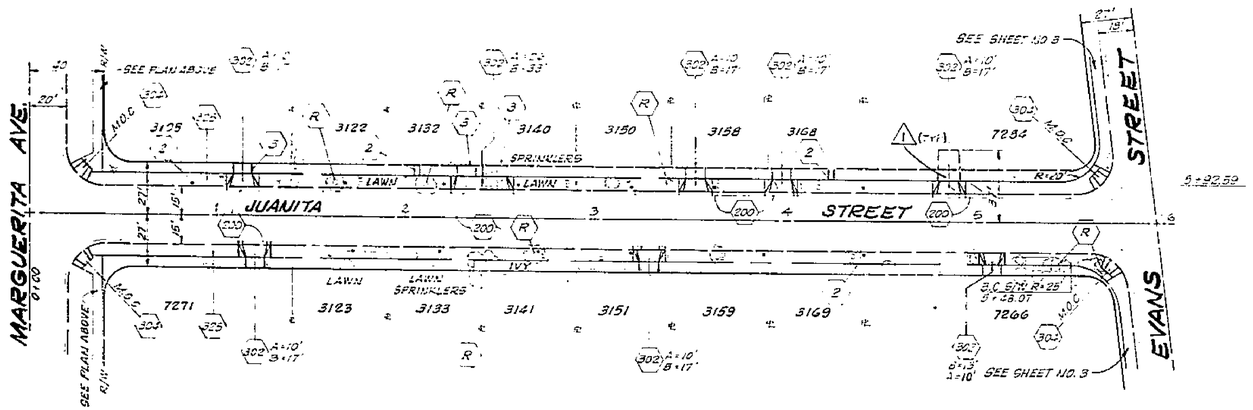

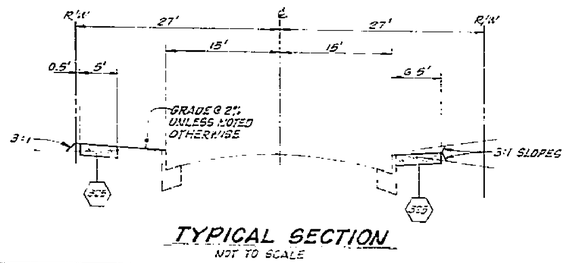

TYPICAL SECTION
NOT TO SCALE

CONSTRUCTION NOTES

1 CONSTRUCTION SHALL BE IN ACCORDANCE WITH STANDARD SPECIFICATIONS FOR PUBLIC WORKS CONSTRUCTION, 1979 EDITION, AND CITY OF RIVERSIDE GTP DWGS

2 CONTRACTOR TO RESET ANY STREET NAME AND TRAFFIC SIGNS.

CONSTRUCTION LEGEND

- (R) REMOVE ENTIRE TREE.
- (1) RELOCATE FENCE.
- (2) CONNECT PCC WALK TO S/W
- (3) EXTEND PCC D/W

	CITY OF RIVERSIDE PUBLIC WORKS DEPARTMENT	HCD PROJECT 1978-79 CASA BLANCA AREA MARGUERITA & JUANITA STREETS	THOMAS BROS. ACCOUNT NO R-550-497 R-2145 SHEET 1 OF 3
DESIGNED BY ____ DRAWN BY ____ CHECKED BY ____	APPROVED BY PUBLIC WORKS DIRECTOR DATE 10/2/79	HORIZ SCALE 1" 40' VERT SCALE 1"	

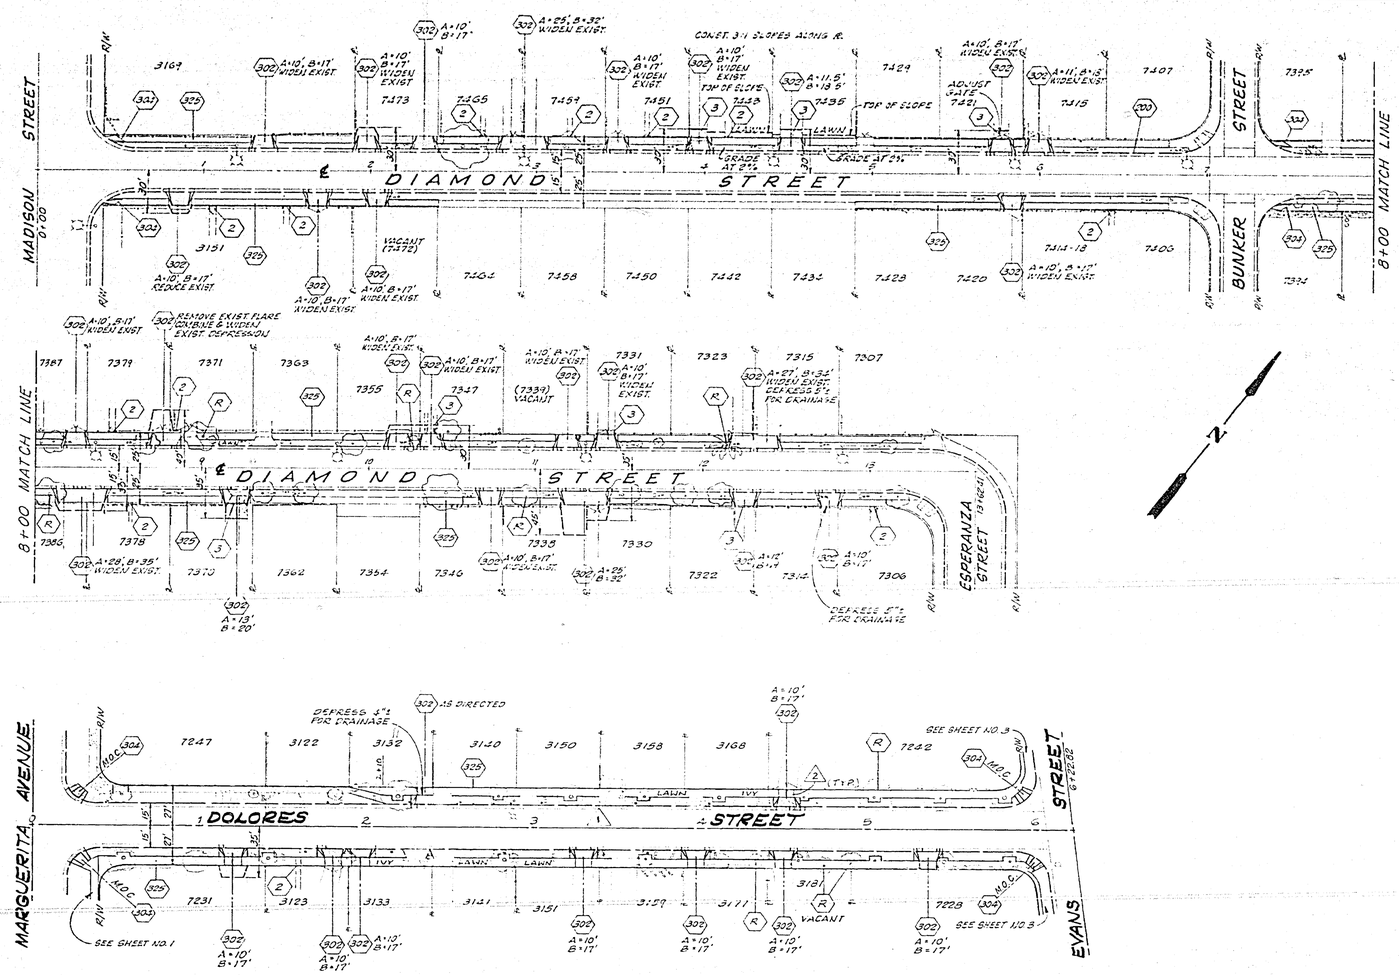

NOTE:
SEE SHEET NO. 1 FOR CONSTRUCTION NOTES & LEGEND.

ON DIAMOND ST. ~~AND DOLORES ST.~~ GRADE PARKWAY ADJACENT TO NEW CONSTRUCTION. EXCEPTION: PROPERTY OWNERS HAVE LANDSCAPED THE AREA AND IT IS AT THE PROPER PARKWAY SLOPE.

CITY OF RIVERSIDE PUBLIC WORKS DEPARTMENT	HCD PROJECT 1978-79 CASA BLANCA AREA	INDEXED BMF ACCOUNT NO 15-550-497	R-2145
APPROVED BY PUBLIC WORKS DIRECTOR DATE 10/3/78	DIAMOND & DOLORES STREETS HORIZ. SCALE: 1" = 40' VERT. SCALE: 1" =	SHEET 2 OF 3	

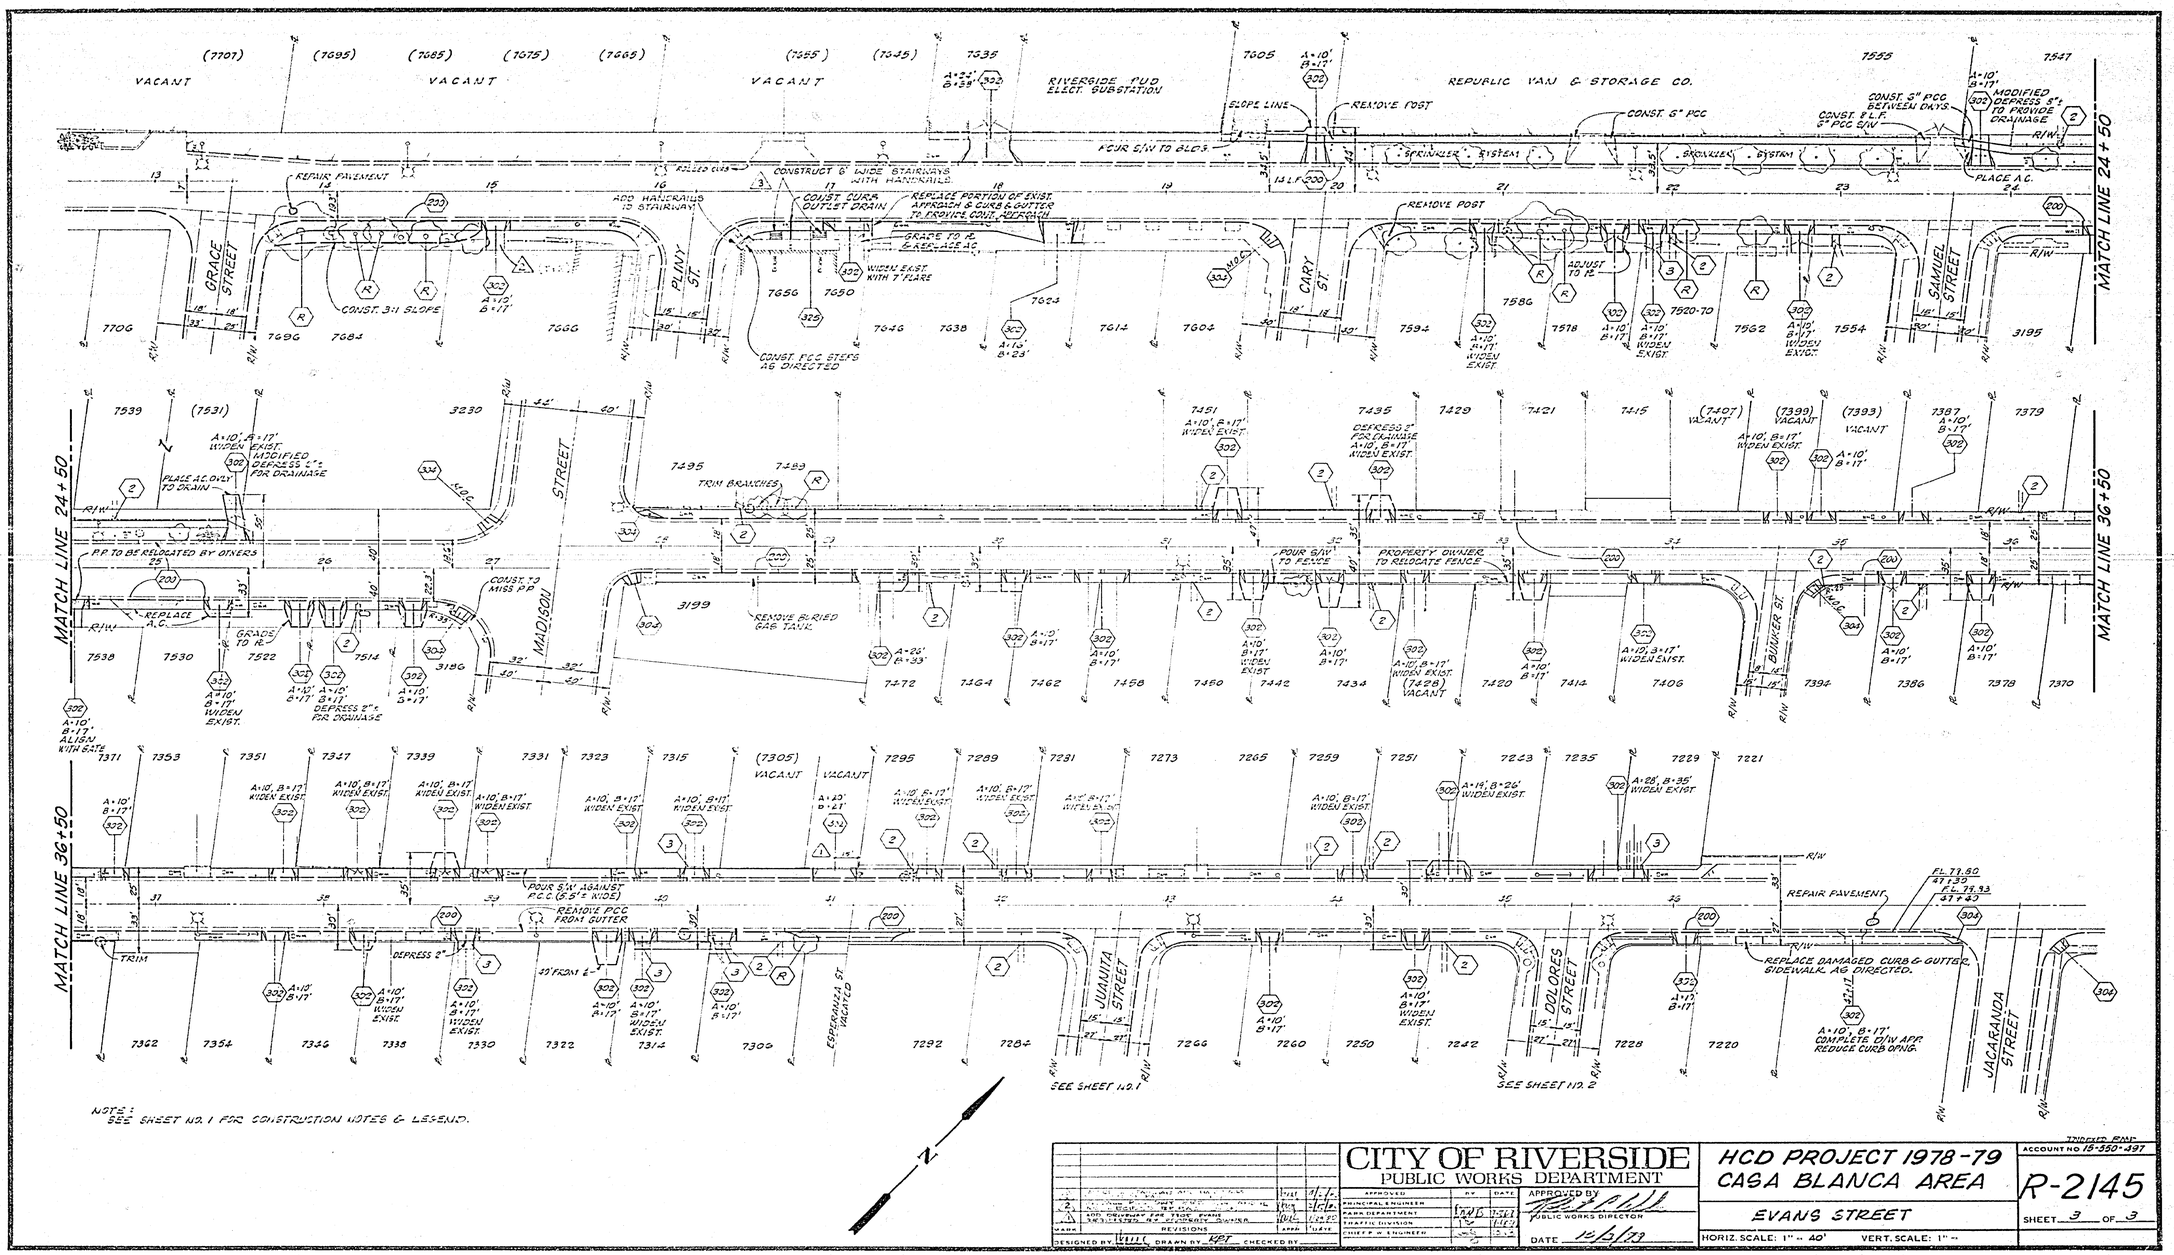

NOTE:
SEE SHEET NO. 1 FOR CONSTRUCTION NOTES & LEGEND.

MARK	REVISIONS	APPR.	DATE

DESIGNED BY [illegible] DRAWN BY KPT CHECKED BY

CITY OF RIVERSIDE
PUBLIC WORKS DEPARTMENT

APPROVED	BY	DATE
PRINCIPAL ENGINEER	[illegible]	[illegible]
PARK DEPARTMENT	[illegible]	11-5-79
TRAFFIC DIVISION	[illegible]	11-6-79
CHIEF M. ENGINEER	[illegible]	11-7-79

APPROVED BY [illegible]
PUBLIC WORKS DIRECTOR
DATE 12/3/79

HCD PROJECT 1978-79
CASA BLANCA AREA

EVANS STREET

HORIZ. SCALE: 1" = 40' VERT. SCALE: 1" =

TRIPLETT PAINT
ACCOUNT NO 15-550-497

R-2145

SHEET 3 OF 3