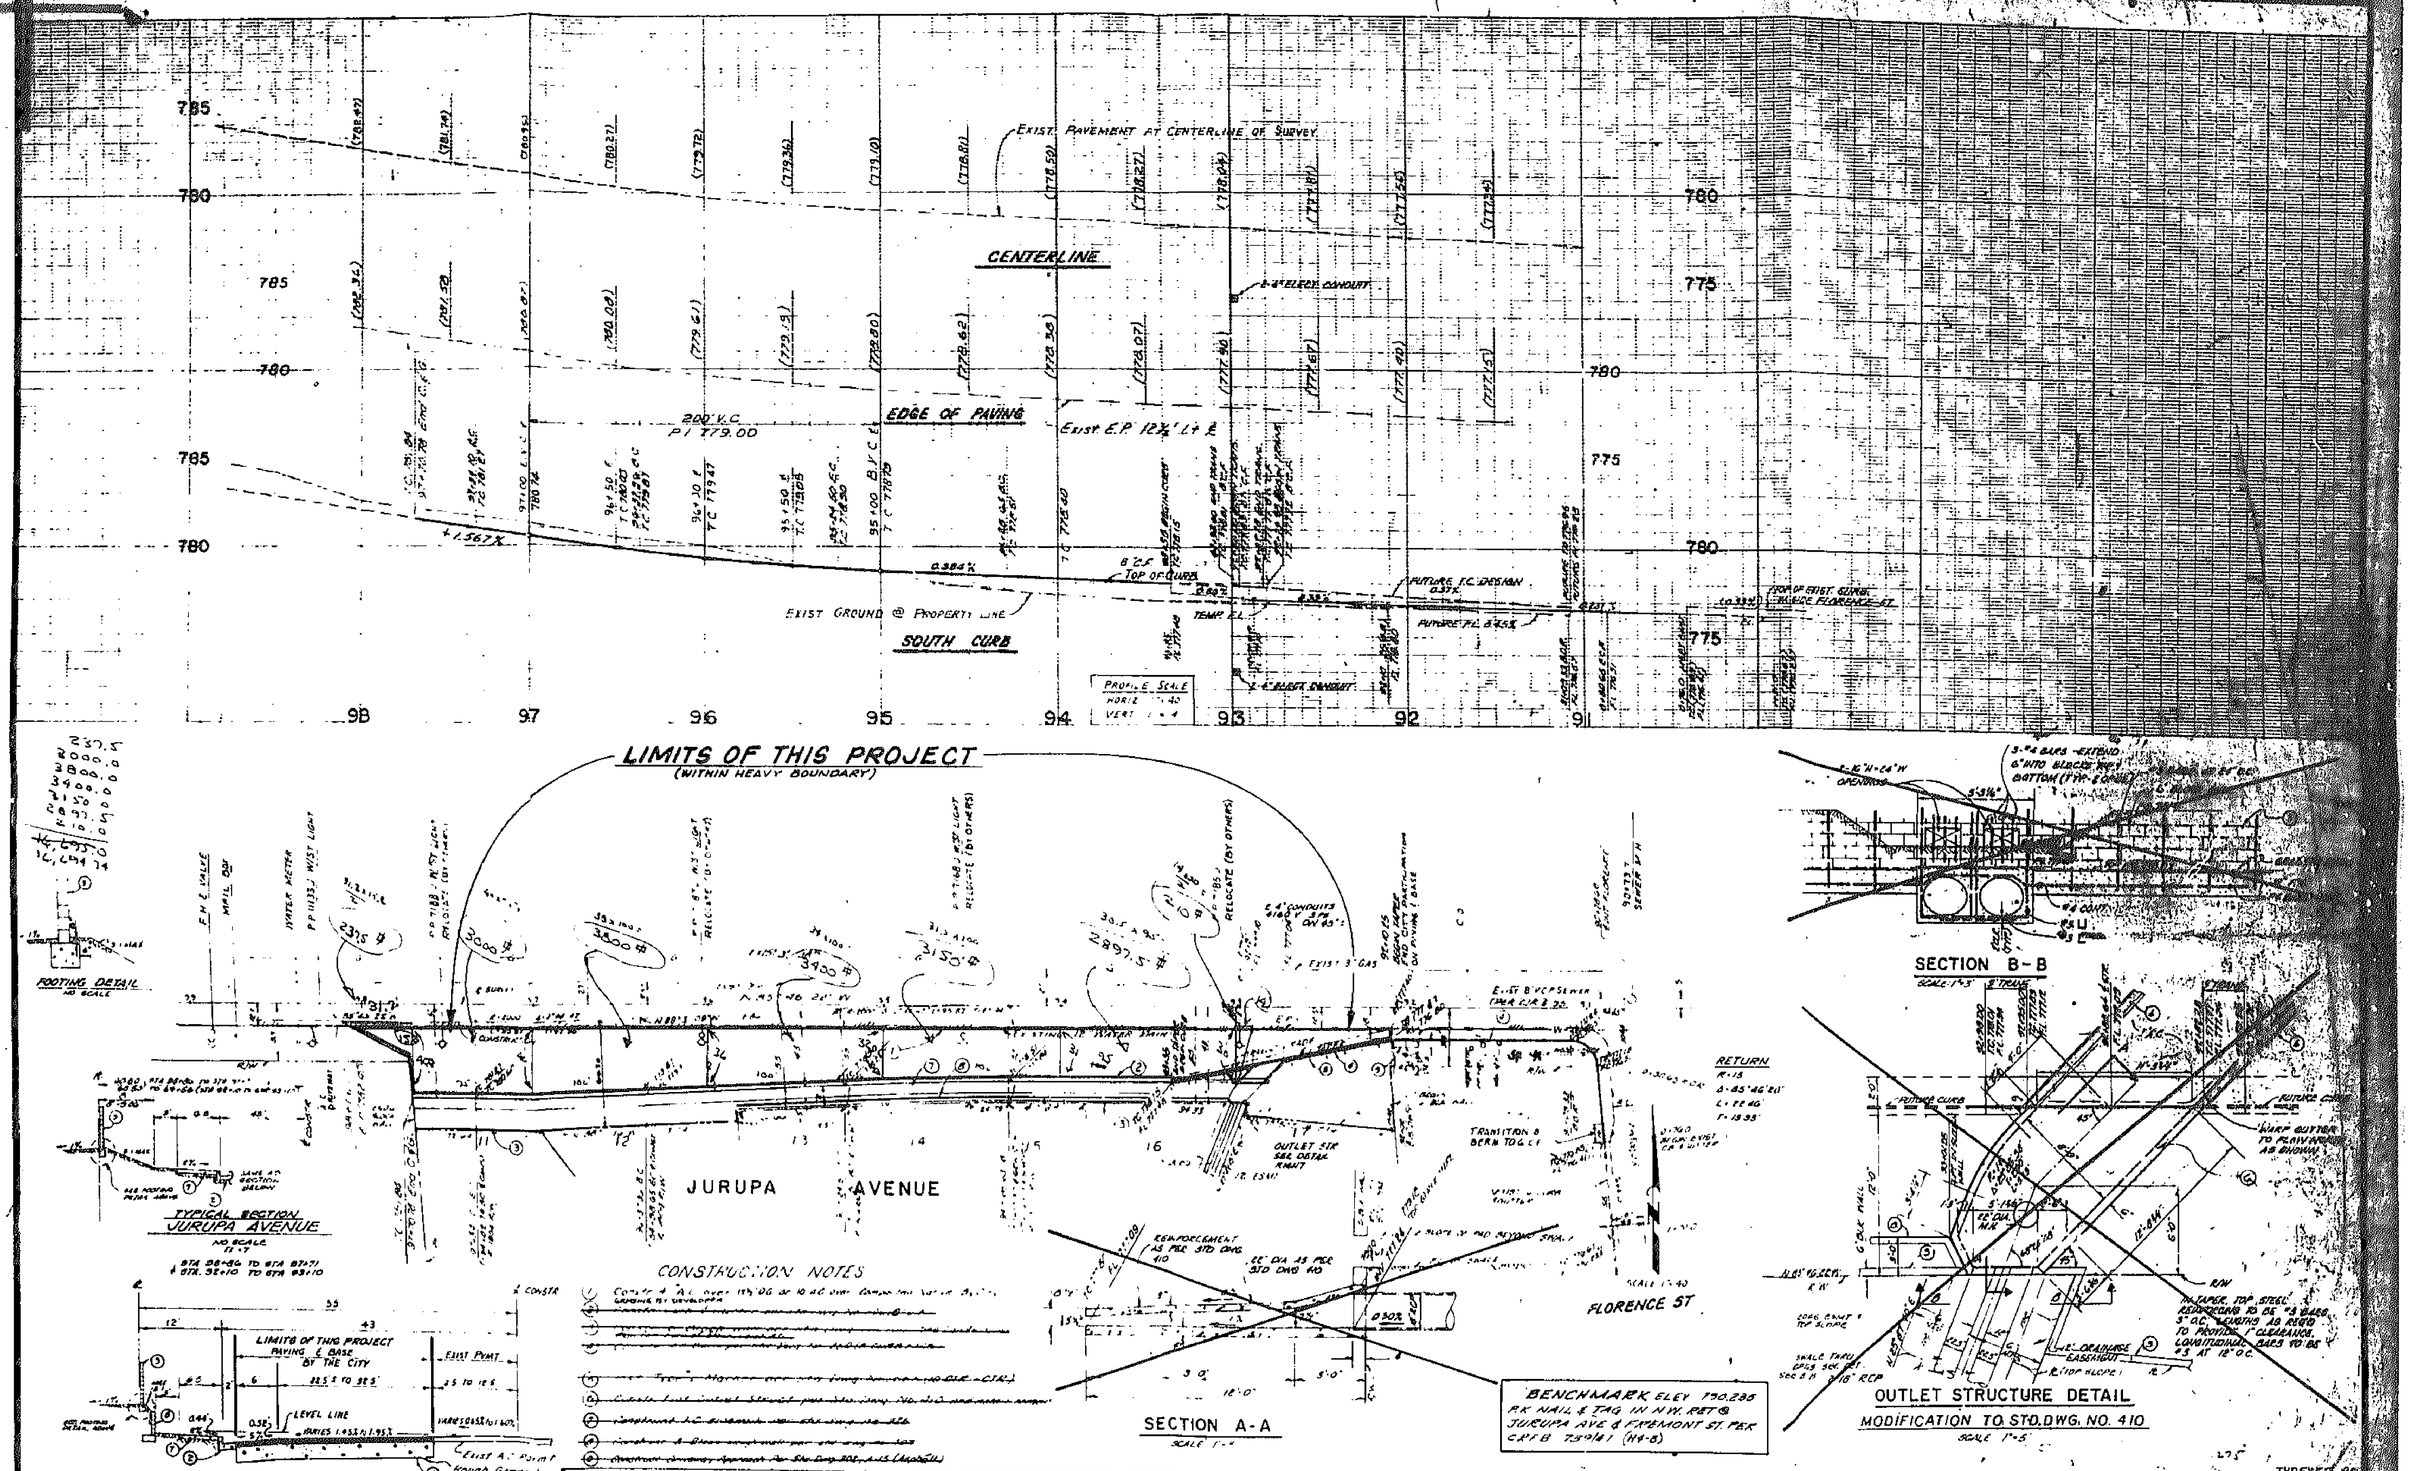
EXIST. PAVEMENT AT CENTERLINE OF SURVEY
CENTERLINE
EDGE OF PAVING
200' V.C.
P.I. 779.00
Exist E.P. 12¾' Lt. ℄
EXIST GROUND @ PROPERTY LINE
SOUTH CURB
TOP OF CURB
FUTURE F.C. DESIGN
TEMP. F.L.
PROFILE SCALE
HORIZ. 1:40
VERT. 1:4
LIMITS OF THIS PROJECT
(WITHIN HEAVY BOUNDARY)
FOOTING DETAIL
NO SCALE
TYPICAL SECTION
JURUPA AVENUE
NO SCALE
JURUPA AVENUE
CONSTRUCTION NOTES
SECTION A-A
SCALE 1:4
RETURN
FLORENCE ST
BENCHMARK ELEV. 790.286
PK NAIL & TAG IN N.W. RET @
JURUPA AVE & FREMONT ST. PER
C.P.B. 75/141 (H4-8)
SECTION B-B
SCALE 1:4
OUTLET STRUCTURE DETAIL
MODIFICATION TO STD. DWG. NO. 410
SCALE 1:5
TYPICAL SECTION
JURUPA AVENUE
NO SCALE
CITY OF RIVERSIDE
DOMESTIC WATER SYSTEM
CITY OF RIVERSIDE
PUBLIC UTILITIES ELECTRIC
CHARLES HAVER AND ASSOCIATES
PREPARED UNDER THE SUPERVISION OF
CHARLES J. HAVER RCE 9503
CITY OF RIVERSIDE, CALIFORNIA
DEPARTMENT OF PUBLIC WORKS
APPROVED BY
OFFICE ENGINEER
PARK DEPARTMENT
TRAFFIC DIVISION
ASSISTANT CITY ENG.
APPROVED BY
DIRECTOR OF PUBLIC WORKS
DATE
REVISIONS
DESIGNED BY
CHECKED BY
STREET PLAN AND PROFILE
JURUPA AVENUE PAVEMENT
PARTICIPATION WITH TR. 9662
STA. 92+10.25 TO STA. 97+70.40
SOUTH SIDE ONLY
HORIZ. SCALE 1" = 40'
VERT. SCALE 1" = 4'
ADAPTED FROM PLAN R-514
PROJECT NO. 90-TR-78-01
R-514A
SHEET 4 OF 4