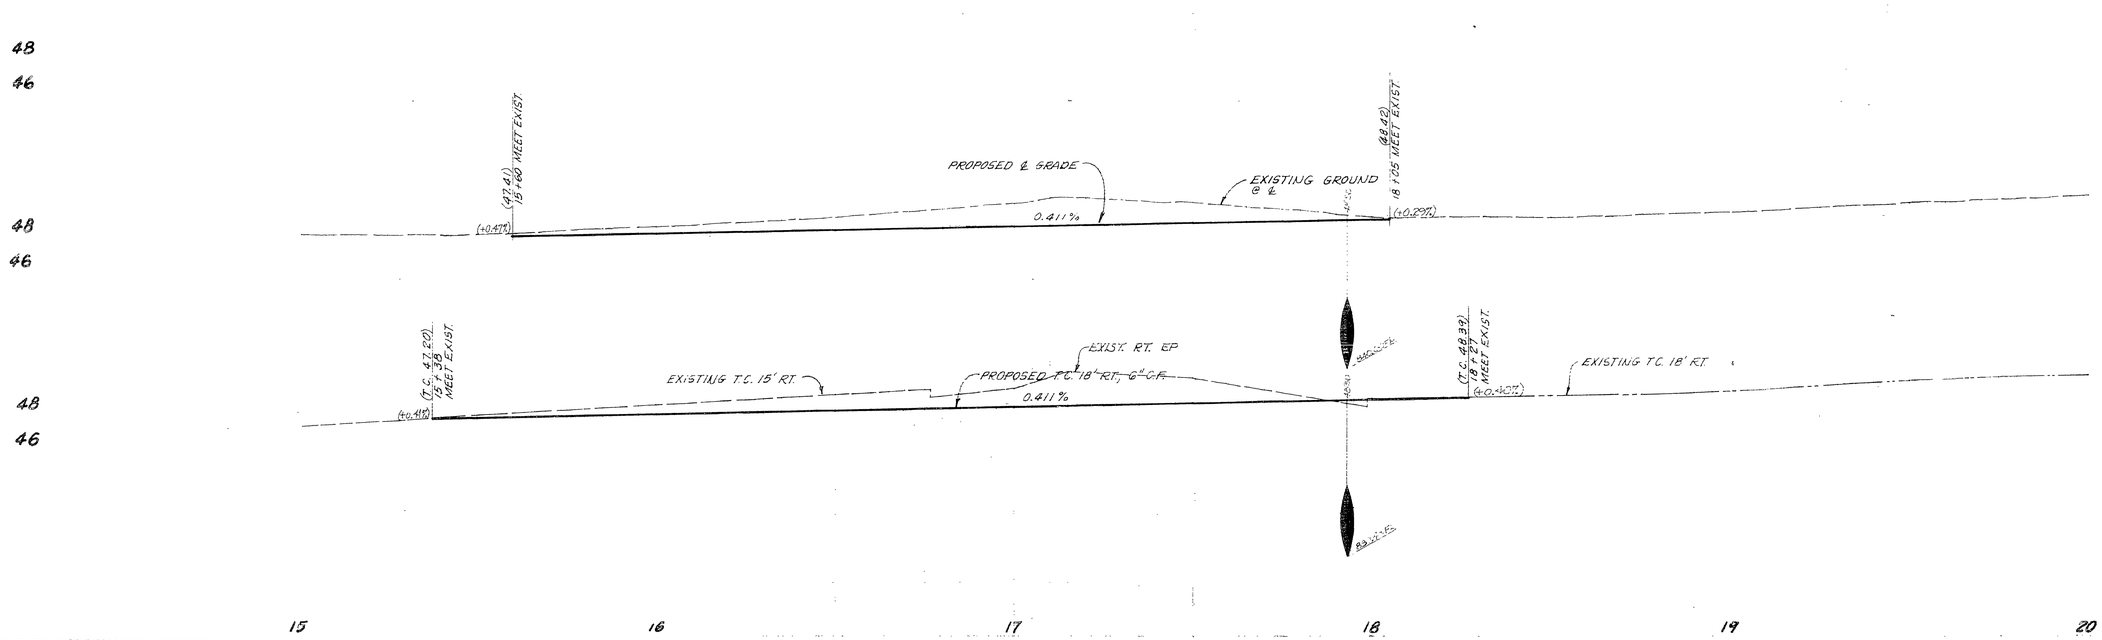

Underground Service Alert
Call TOLL FREE
1-800
422-4133

~~NOTE: WORK TO BE DONE PRIOR TO OVERLAYING OF ORANGE ST~~

BENCH MARK
PRECISE B.M. I7-F
ELEV: 833.211

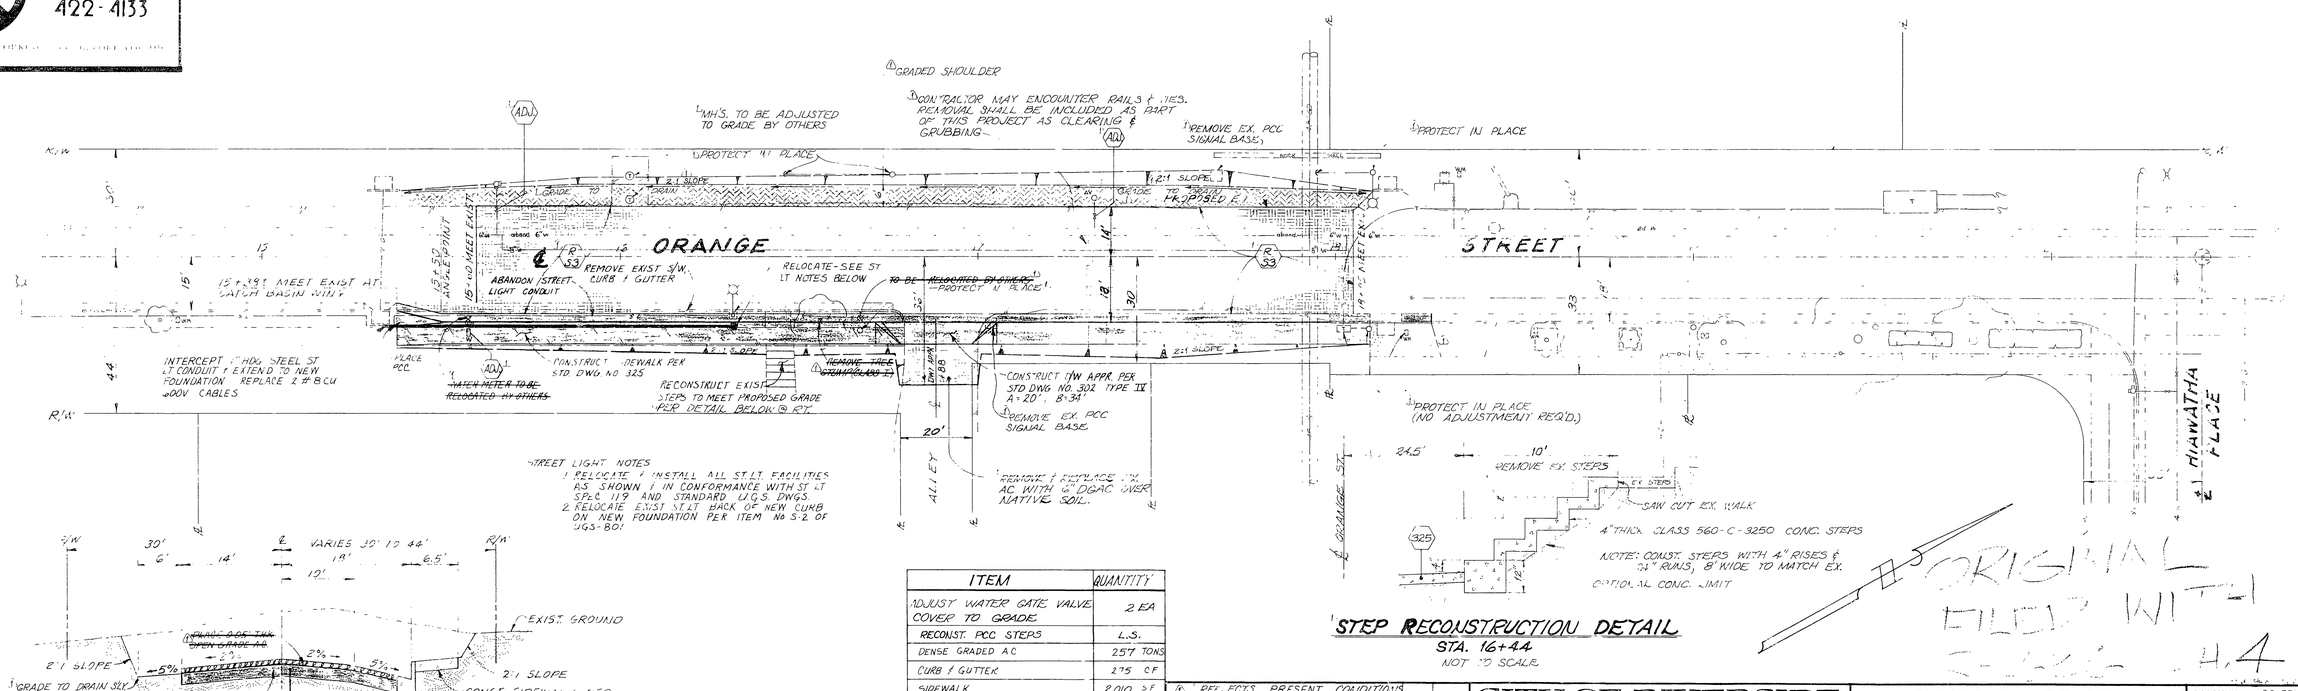

STEP RECONSTRUCTION DETAIL
STA. 16+44
NOT TO SCALE

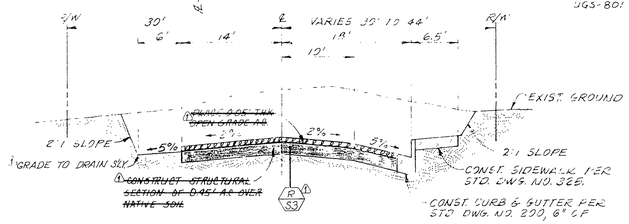

TYPICAL SECTION
NOT TO SCALE
T.I. = 6.0

ITEM	QUANTITY
ADJUST WATER GATE VALVE COVER TO GRADE	2 EA
RECONST. PCC STEPS	L.S.
DENSE GRADED AC	257 TONS
CURB & GUTTER	275 C.F.
SIDEWALK	2,010 S.F.
CURB & GUTTER REMOVAL	204 L.F.
S/W REMOVAL	710 S.F.
RELOCATE ST. LT.	1 EA.
EXCAVATION	466 C.Y.
D/V APPR. (PCC)	204 S.F.
OPEN GRADED AC	53 TONS

MARK	REVISIONS	APPR.	DATE
	REFLECTS PRESENT CONDITIONS & ADDS THIS DWG. TO R-2636		

DESIGNED BY [illegible] DRAWN BY [illegible] CHECKED BY [illegible]

CITY OF RIVERSIDE
PUBLIC WORKS DEPARTMENT

APPROVED BY
PRINCIPAL ENGINEER
PARK DEPARTMENT
TRAFFIC DIVISION
CHIEF ENGINEER
APPROVED BY
PUBLIC WORKS DIRECTOR
DATE

ORANGE STREET IMPROVEMENTS
BETWEEN FIRST STREET & HIAWATHA PLACE

HORIZ. SCALE: 1" = 20' VERT. SCALE: 1" = 4'

ACCOUNT NO. 30-575-291-09
30-575-288-09

R-2196
FILE WITH R-2636
SHEET 1 OF 1

ORIGINAL FILED WITH R-2636 H.4

SHEET 4 OF 5 OF R 2636
(SHEET 3 OF 3 M-307)

INCLUDED IN CLEARING & GRUBBING