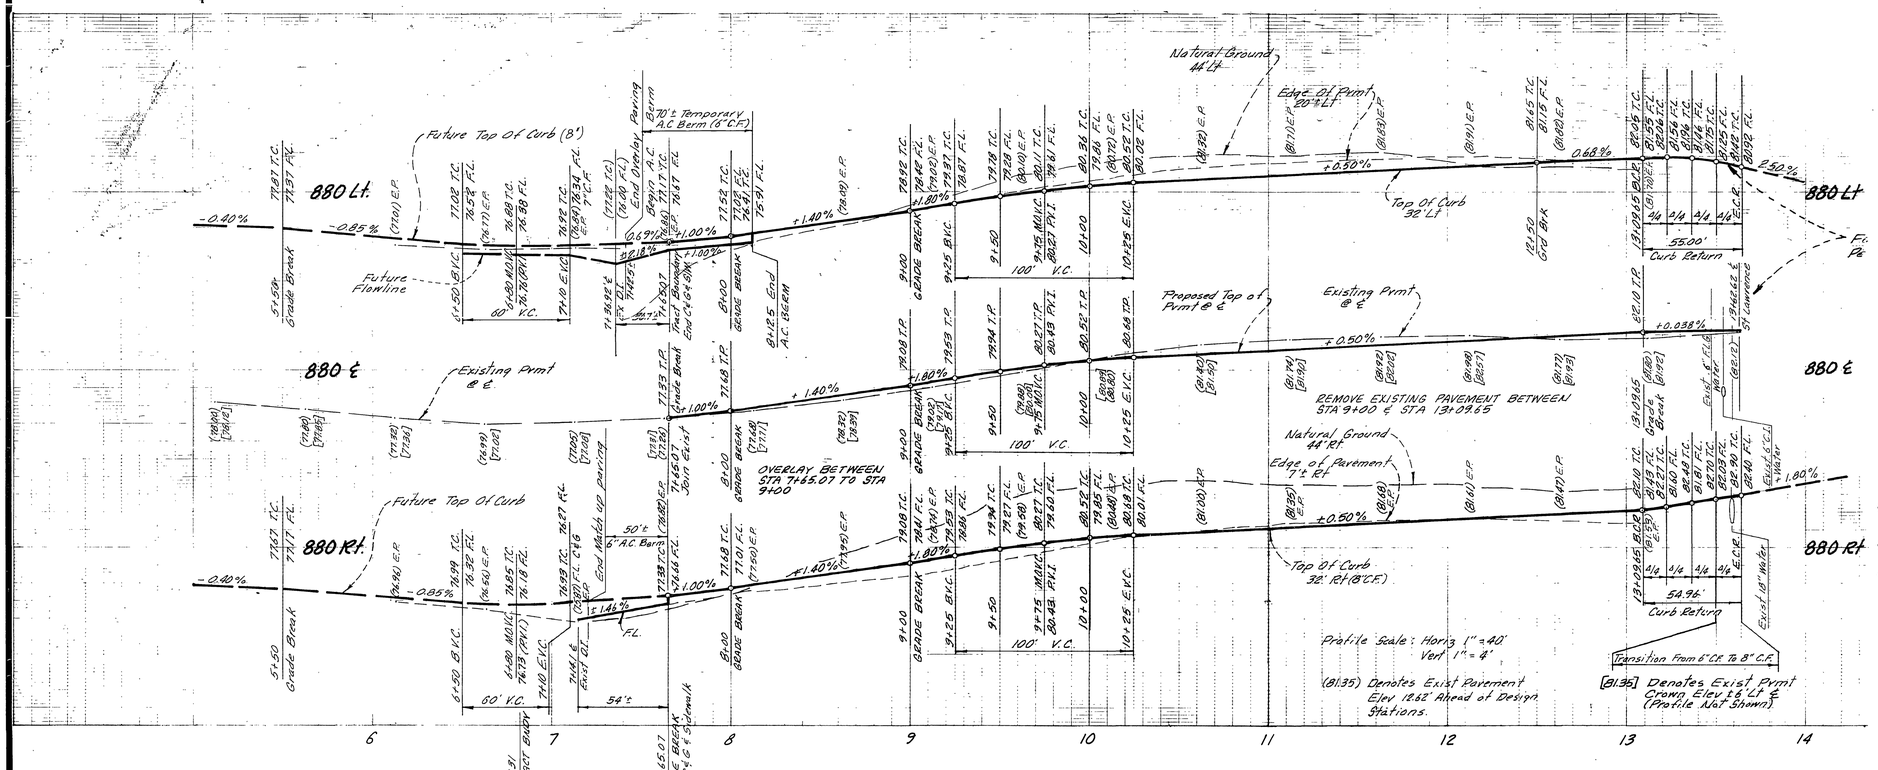

GENERAL NOTES

1. Construction shall be in accordance with the City of Riverside Department of Public Works, Standard Drawings, and the Standard Specifications for Public Works Construction, 1972 edition.
2. Trim edge of existing pavement where new pavement joins to a smooth straight line. Construct match-up paving as shown on plan and overlay paving as directed in the field to produce a smooth section. Engineer "ultimate" overlay to be [illegible] ton.
3. All flagged elevations shall be "take" in the field by the private engineer.

CONSTRUCTION NOTES

(5) Relocate Existing Water Valves, Fire Hydrants, Signs, Street Lights, etc. (BY OTHERS)

(8) Const 4" A.C. pavement over 8" D.G. Base.

(10) Adjust existing water valves, fire hydrants, etc. (BY OTHERS)

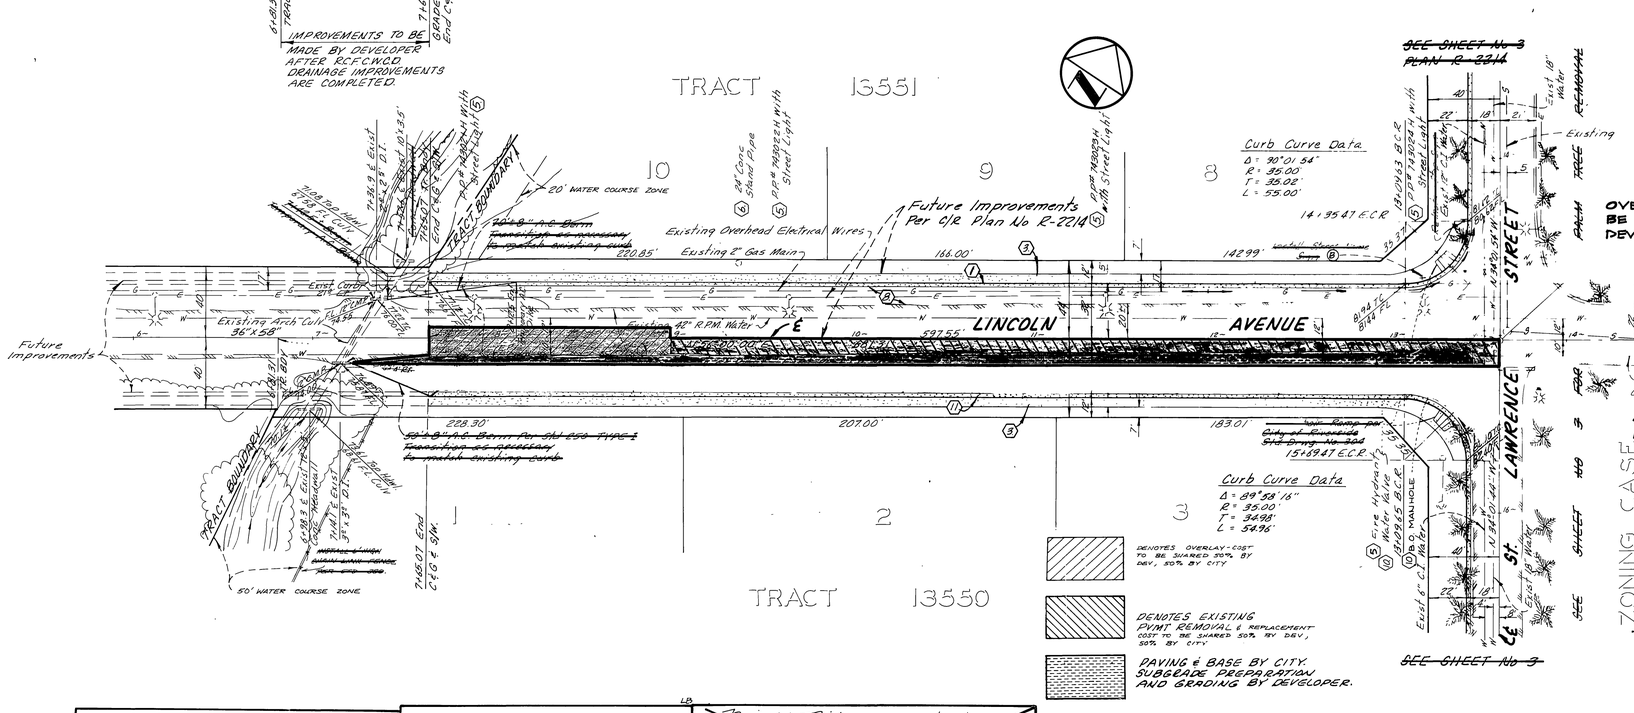

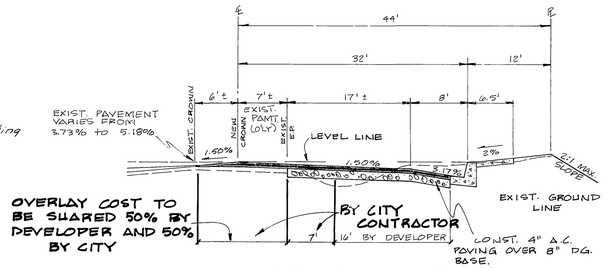

TYPICAL SECTION
LINCOLN AVENUE
STA. 7+65.07 TO STA. 9+00.00

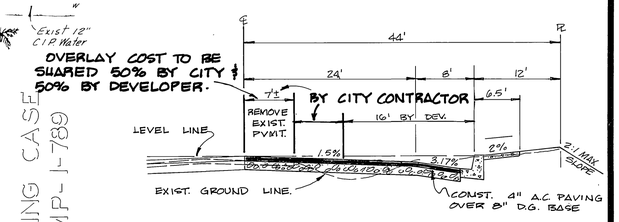

TYPICAL SECTION
LINCOLN AVE.
STA. 9+00.00 TO ST. LAWRENCE STREET

BENCH MARK:
FS-I: Fd P.K. nail in curb return at Lincoln Street entrance to Municipal Corporation yard. Elev. = 882.034
FB 238/98 INDEXED BLD

CITY OF RIVERSIDE
OVERHEAD & UNDERGROUND
11-2-79
CHIEF UTILITIES ENGINEER ELECTRICAL DATE

CITY OF RIVERSIDE
DOMESTIC SYSTEM
5/25/79
CHIEF UTILITIES ENGINEER WATER DATE

2/26/79
RICHARD J. RIEKER R.C.E. 14750 DATE

CM ENGINEERING ASSOCIATES
Mail P. O. Box 6087 92412
Phone (714) 884-8804 or (714) 825-6402
225 East Airport Drive, San Bernardino, California

MARK	REVISIONS	APPR	DATE

DESIGNED BY F.L. DRAWN BY E.R.M. CHECKED BY R.A.

CITY OF RIVERSIDE
PUBLIC WORKS DEPARTMENT

APPROVED	BY	DATE
PRINCIPAL ENGINEER		
PARK DEPARTMENT		
TRAFFIC DIVISION		
CHIEF P. W. ENGINEER		

APPROVED BY
PUBLIC WORKS DIRECTOR
DATE 1961

STREET IMPROVEMENT PLANS
TRACT NO 13550
LINCOLN AVENUE
STA 6+81.31 TO ST. LAWRENCE ST

ACCOUNT NO.
R-2213 A
SHEET 1 OF 1
HORIZ. SCALE: 1" = 40' VERT. SCALE: 1" = 4'

ADAPTED FROM R-2213