CONSTRUCTION LEGEND

CENTER LINE	℄	TOP OF SLOPE	
RIGHT-OF-WAY LINE	R/W	TOE OF SLOPE	
SUBDIVISION LOT LINE	P.L.	DIRECTION OF FLOW	

(1) (2) VARIABLE AC OVERLAY

CONSTRUCT STRUCTURAL SECTION OF 0.5' AC OVER NATIVE SOIL OR 0.21 AC OVER 0.75' CRUSHED AGGREGATE BASE OR CRUSHED SLAG BASE.

SPECIFIC CONSTRUCTION NOTES

⬢ NUMBERS ABOVE 100 IN A HEXAGON ON THE PLAN REFER TO THE RESPECTIVE STANDARD DRAWING AND SHALL BE CONSTRUCTED ACCORDINGLY, UNLESS MODIFICATIONS ARE NOTED ON THE PLAN OR COVER SHEET BELOW. ANY NUMBER SHOWN BELOW THE STANDARD DRAWING NUMBER INDICATES THE SPECIFIC ALTERNATE TO BE CONSTRUCTED.

(R / III) REMOVE EXISTING TREE. CLASS III (OVER 36" DIA.)

GENERAL CONSTRUCTION NOTES

(1) RIGHTS OF ENTRY HAVE BEEN OBTAINED FOR WORK SHOWN ON RAILROAD PROPERTY.

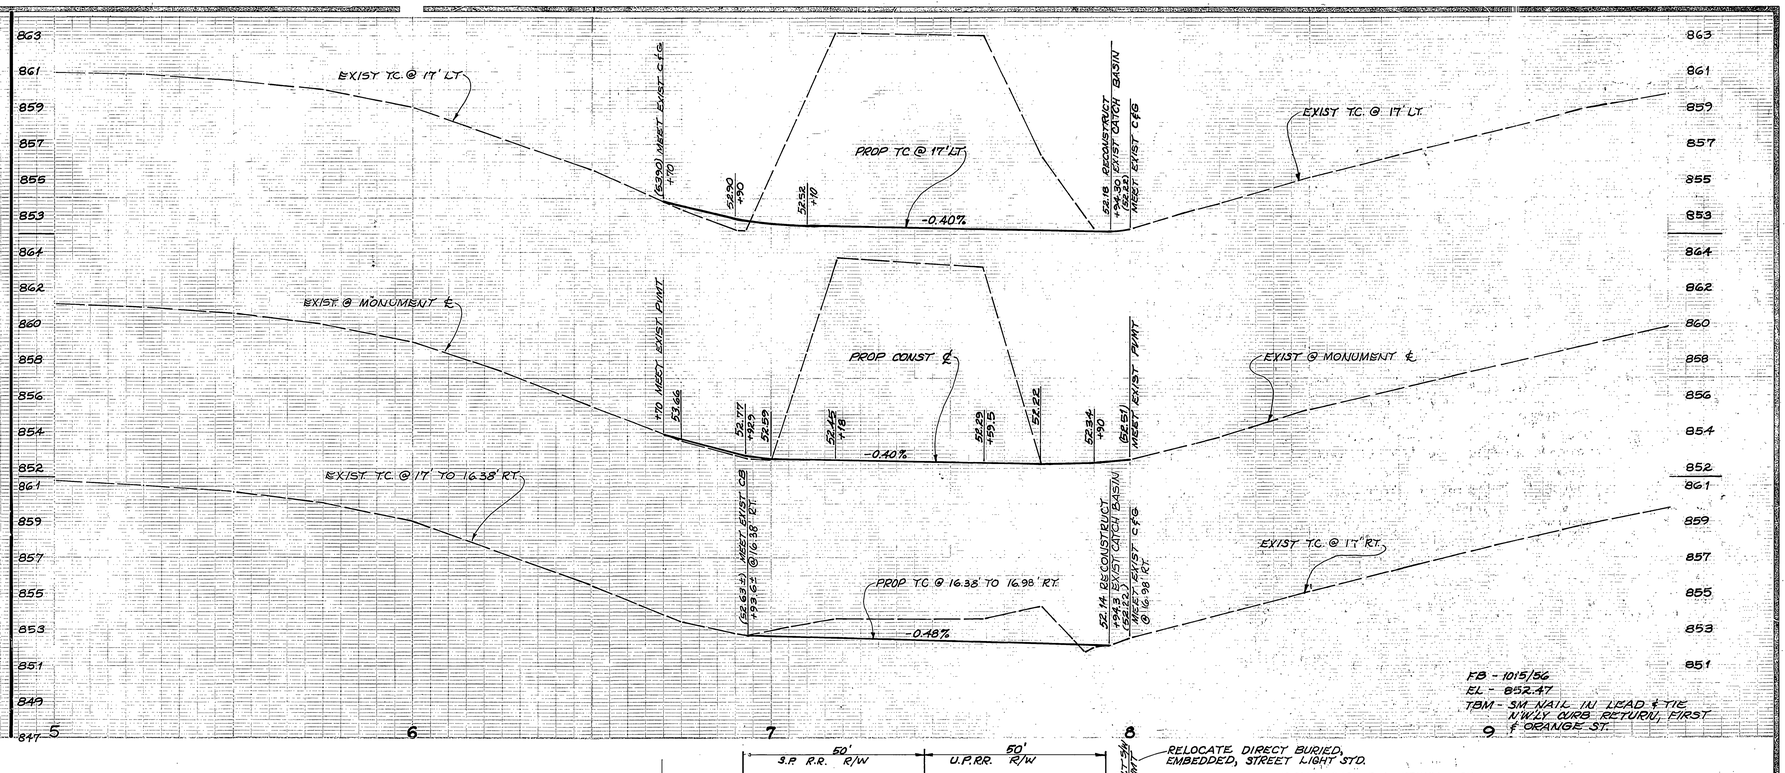

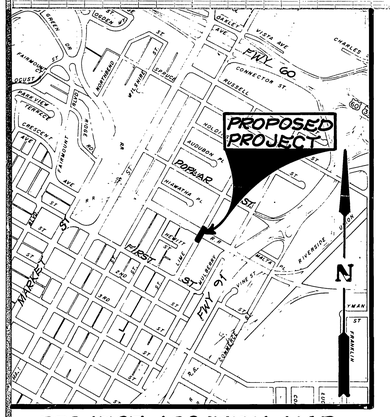

PROJECT LOCATION MAP
SCALE : 1" = 1,000'
T. I. = 5.0

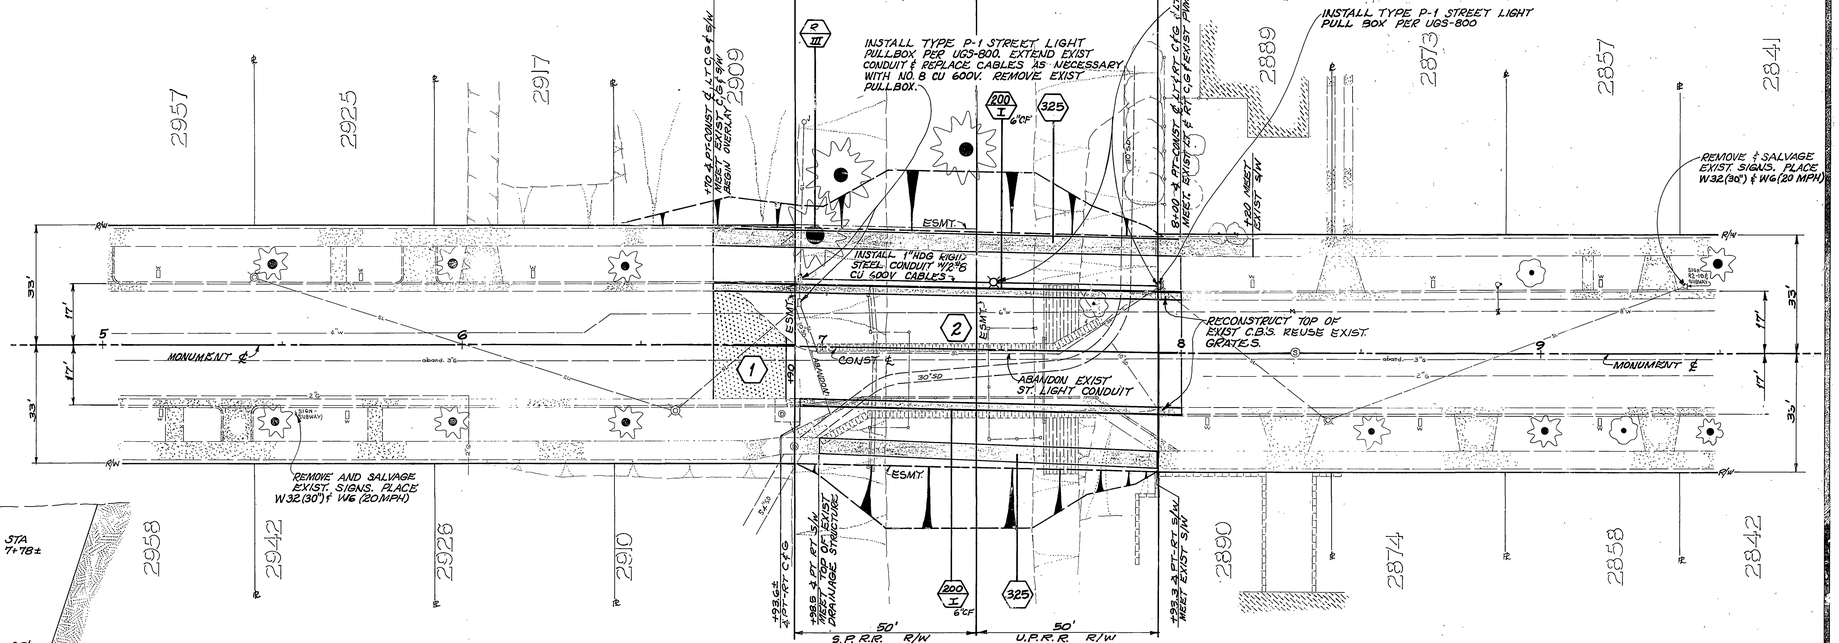

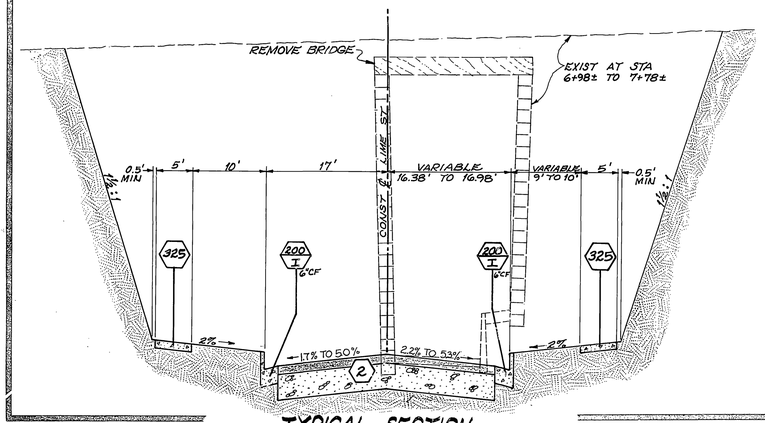

TYPICAL SECTION
STA. 6+70 TO 8+00
N.T.S.

MARK	REVISIONS	APPR.	DATE	BY	
DESIGNED BY JC	DRAWN BY	CHECKED BY			

CITY OF RIVERSIDE
PUBLIC WORKS DEPARTMENT

	APPROVED BY	DATE	BY
PRINCIPAL ENGINEER		7-21-81	
PARK DEPARTMENT		7-31-81	
TRAFFIC DIVISION		9/11/81	
CHIEF PLAN ENGINEER		8-26-81	

APPROVED BY
PUBLIC WORKS DIRECTOR
DATE 8/20/81

INDEXED BLD
*43 BUILT 11-26-81 20M
ACCOUNT NO. 30-575-336-01

LIME STREET WIDENING AND BRIDGE REMOVAL

R-2290

SHEET 1 OF 1

HORIZ. SCALE: 1" = 20' VERT. SCALE: 1" = 4'