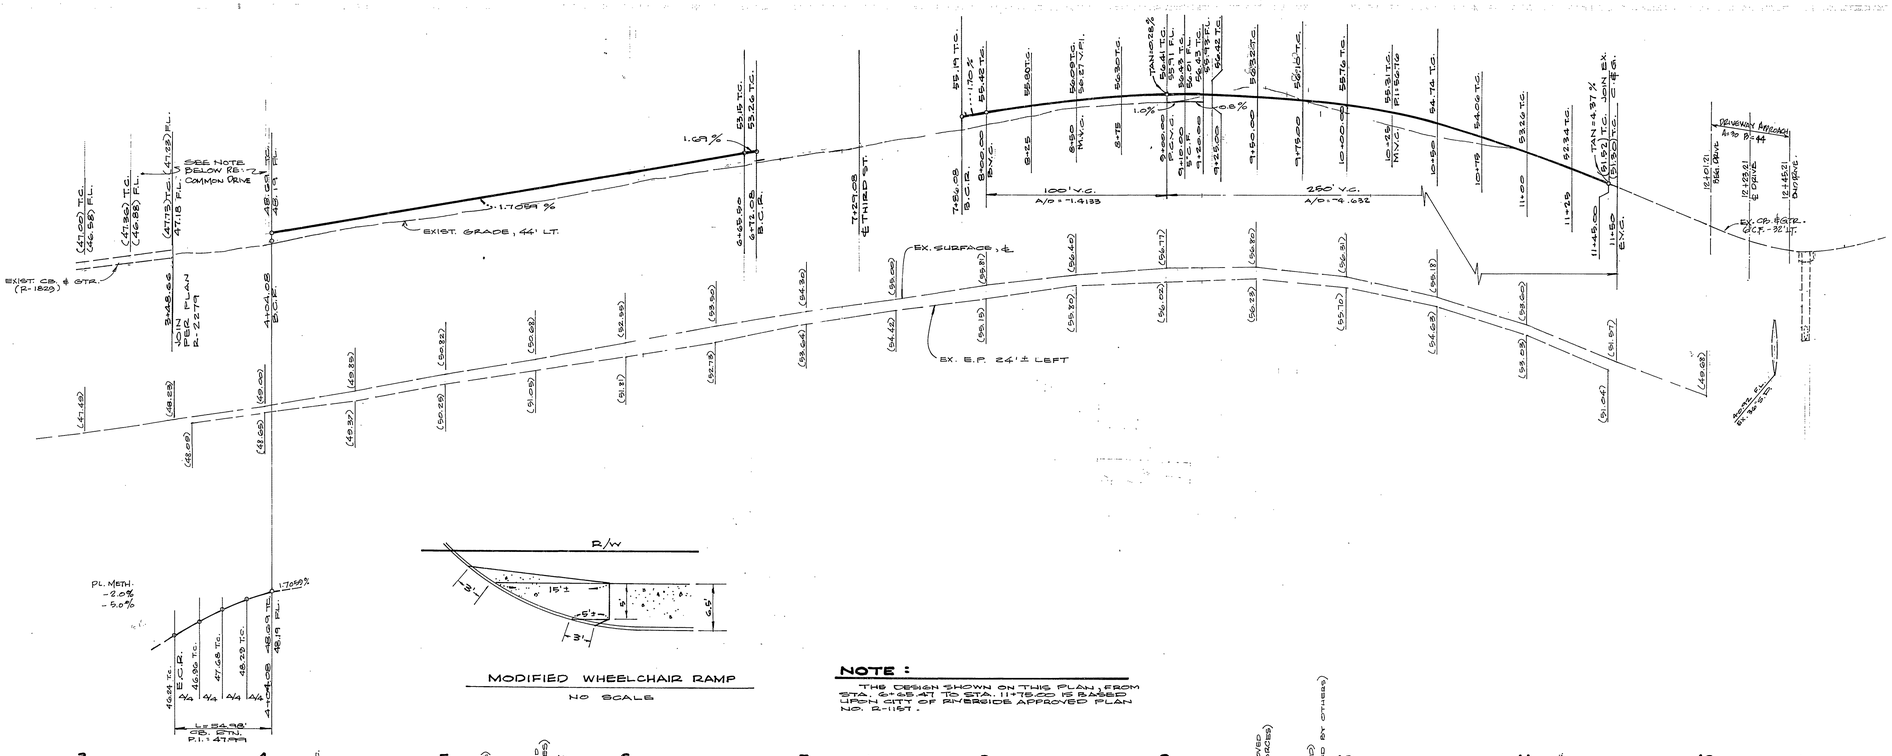

NOTE :

THE DESIGN SHOWN ON THIS PLAN, FROM STA. 4+65.47 TO STA. 11+75.00 IS BASED UPON CITY OF RIVERSIDE APPROVED PLAN NO. 2-1157.

CURB RETURN DATA				
#	Δ	R	T	L
1	88°59'50"	35.00'	35.00'	54.98'
2	89°58'00"	35.00	35.00'	54.98'

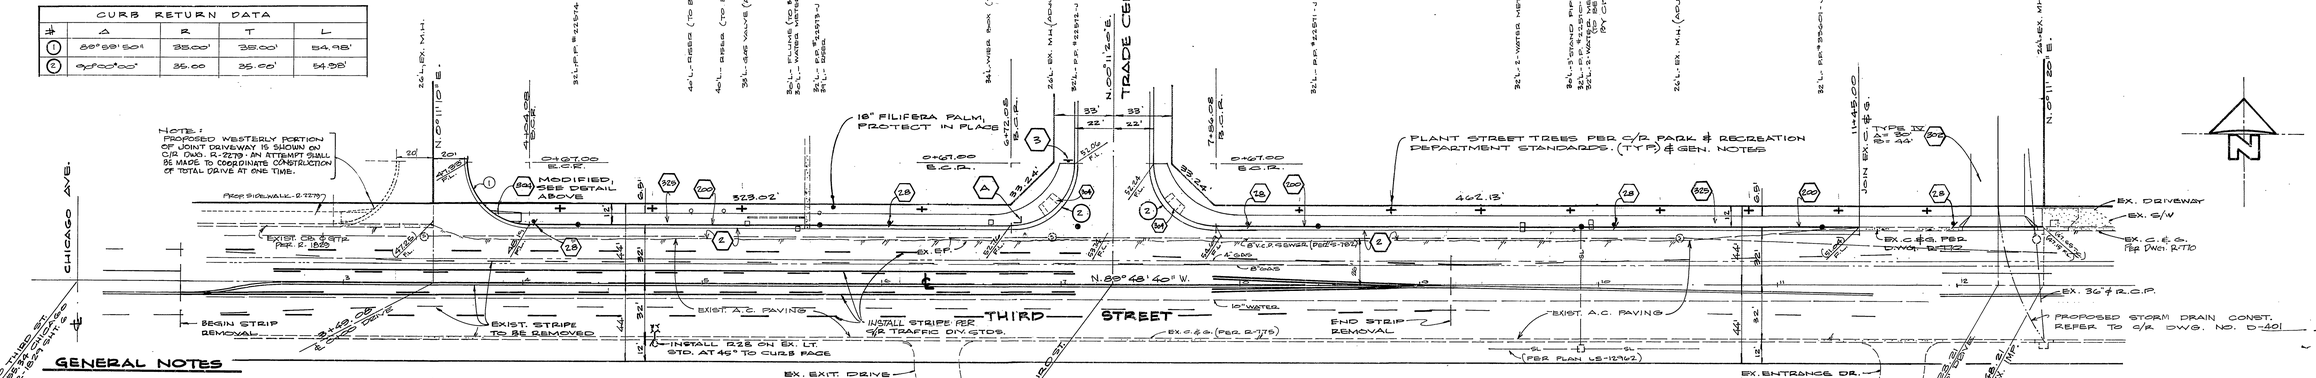
TRADE CENTER DR.
CHICAGO AVE.
THIRD STREET
N.00°11'02"E.
N.89°48'40"W.
EX. EXIT DRIVE (NORTH HIGH SCHOOL)
EX. ENTRANCE DR. (NORTH HIGH SCHOOL)
EX. DRIVEWAY
EX. S/W
EX. C.B. & G. PER DWG. R-1112
EX. 36"ϕ R.C.P.
EX. C.B. & G. PER DWG. R-1112
PROPOSED STORM DRAIN CONST. REFER TO C/R DWG. NO. D-401
EXIST. A.C. PAVING
EXIST. STRIPE TO BE REMOVED
BEGIN STRIP REMOVAL
END STRIP REMOVAL
INSTALL STRIPE PER C/R TRAFFIC DIV. STDS.
INSTALL R.26 ON EX. LT. STD. AT 45° TO CURB FACE
PLANT STREET TREES PER C/R PARK & RECREATION DEPARTMENT STANDARDS. (TYP.) & GEN. NOTES
16" FILIFERA PALM, PROTECT IN PLACE
MODIFIED, SEE DETAIL ABOVE
NOTE: PROPOSED WESTERLY PORTION OF JOINT DRIVEWAY IS SHOWN ON C/R DWG. R-2279. AN ATTEMPT SHALL BE MADE TO COORDINATE CONSTRUCTION OF TOTAL DRIVE AT ONE TIME.
PROP. SIDEWALL, R-2279
TYPE IV A = 30° R = 44'
462.13'
523.02'
33.24'
0+467.00 E.C.R.
0+472.08 B.C.R.
0+207.00 E.C.R.
7+84.08 B.C.R.
7+89.08 ℄ THIRD ST.
7+89.08 ℄ THIRD ST. 0+00
11+45.00 JOIN EX. C & G.
EX. 24"ϕ R.C.P.
EX. MH.
EX. 8"W.
EX. 8"SEWER (PER C/R 79-790)
EX. 6"GAS
EX. 12"W.
EX. 8"W.
EX. 8"SEWER (PER C/R 79-790)
EX. 8

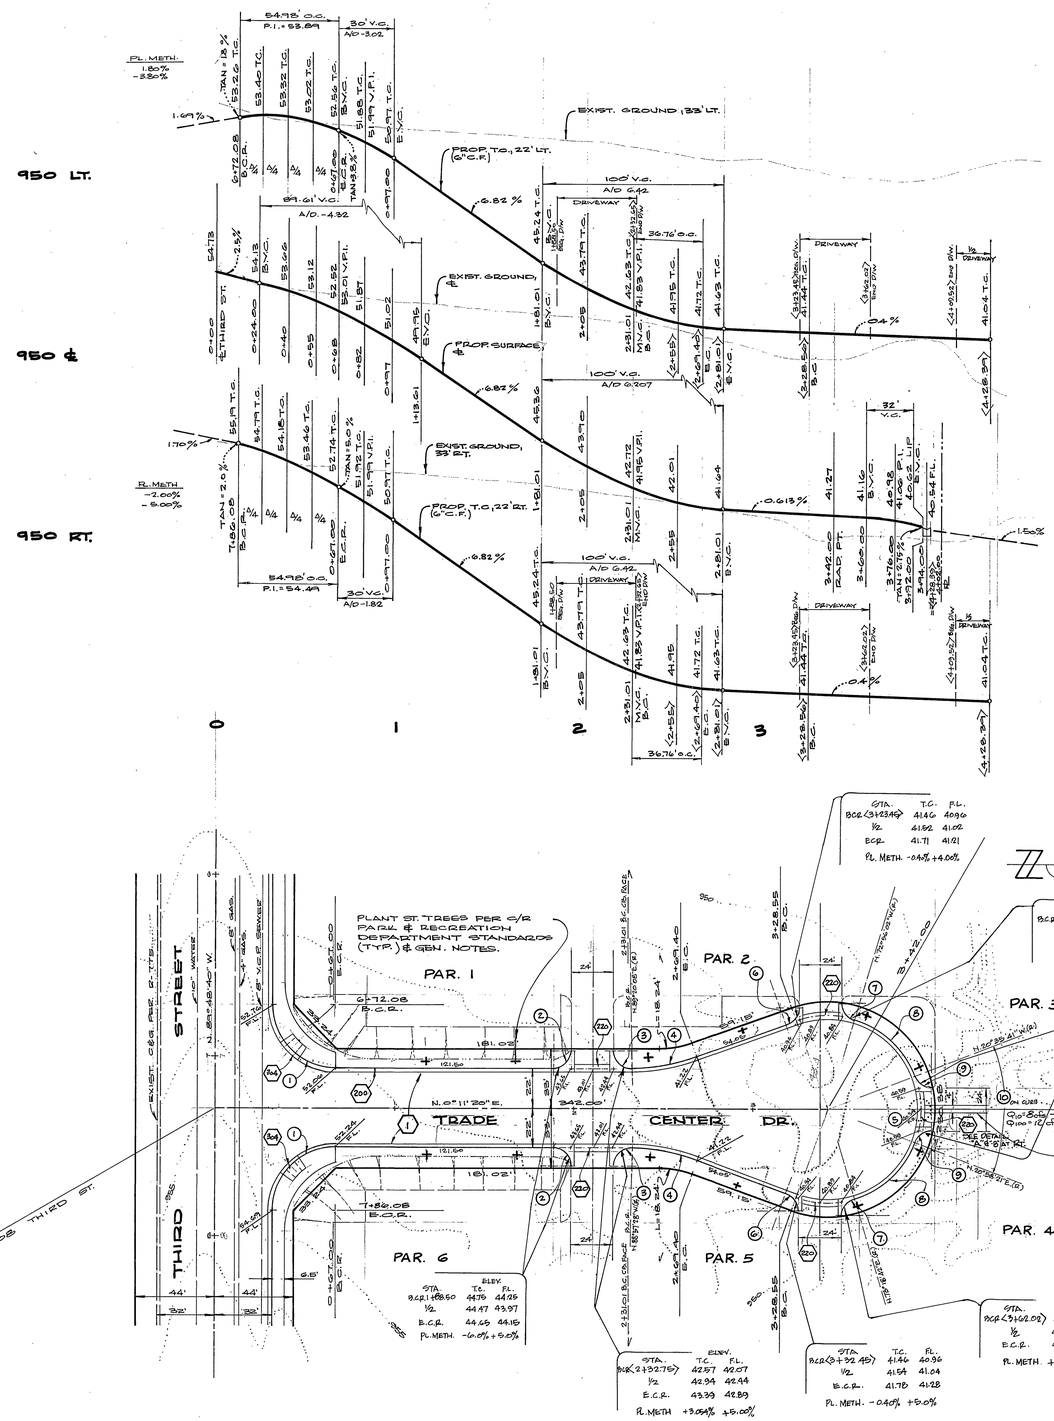

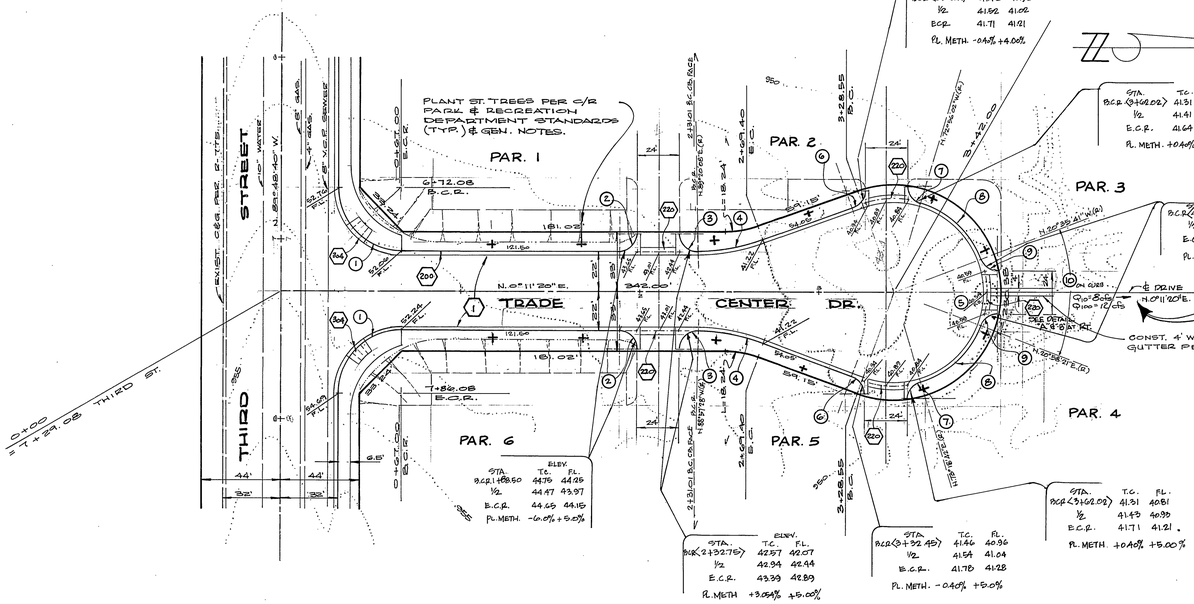

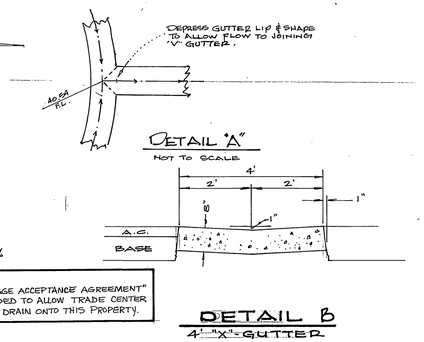

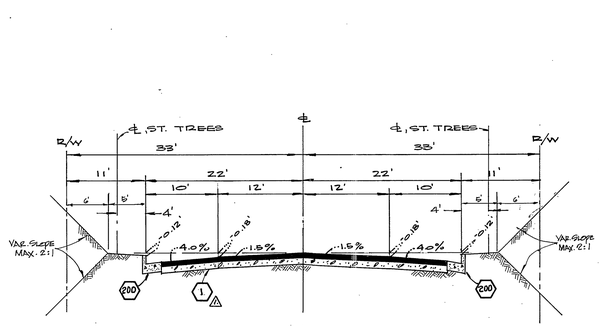

TYPICAL SECTION

TRADE CENTER DRIVE

NOT TO SCALE

T.I.G

NOTE: (1)△ THE SUBDIVIDER SHALL ARRANGE FOR A SOIL TEST TO BE MADE BY A SOILS ENGINEER AFTER THE STREET HAS BEEN PREPARED TO ROUGH GRADE, DEPTH OF BASE MATERIAL AND A.C. PAVING SHALL BE DETERMINED BY THE CITY OF RIVERSIDE DESIGN STANDARDS AND TEST PROCEDURES.

NOTE:
ALL STATIONS INDICATED THUS < > ARE BASED ON CURB LINE CURVES AND TANGENT DISTANCES.

CURVE DATA

№	RAD.	Δ	T	L
1	35.00	90°00'00"	35.00	54.98
2	10.00	90°00'00"	10.00	15.71
3	10.00	90°51'12"	10.15	15.86
4	110.00	19°08'48"	18.55	36.76
5	50.00	225°00'00"	–	196.60
6	10.00	70°00'00"	7.00	12.22
7	10.00	73°01'22"	7.42	12.76
8	52.00	52°20'21"	25.55	47.50
9	10.00	68°12'59"	6.90	12.06
10	52.00	41°34'02"	19.75	37.73

BENCH MARK

FD. BRASS DISK STAMPED (17A) CAPPED AT THE INTERSECTION OF ℄ OF THIRD ST. AND ℄ OF CHICAGO AVE. C.E.F.B. 717/68
ELEV. = 941.005

INDEXED BLD

* AS BUILT 7-29-86 BJET

6/2/81

△ ADDED PAVING SECTION PER SR 1149 (R-VALUE = 75) RJED 11-6-83

98TG

TR-205 | SO. CAL. INVEST & DEV. CO. | 1046 | | D.R.B | R.H. | F.PROCTOR

11/4/81		
11/30/81		
12/9/81		
12-24		
12-29-81		

12/29/81

STREET PLAN & PROFILE

TRADE CENTER DRIVE

FROM THIRD ST. NORTH 400'

P.M. 17,402 | T.C. R-8-790 | 1"=40' HOR'Z. : 1"=4' VERT.

R-2384

2 2

79-205 A