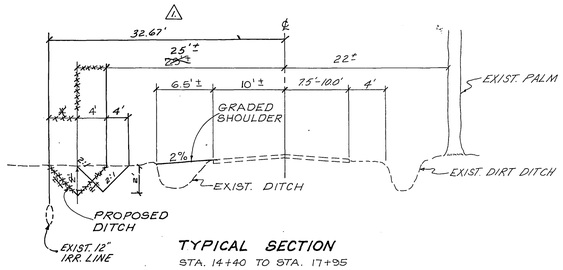

TYPICAL SECTION
STA. 14+40 TO STA. 17+95
NO SCALE

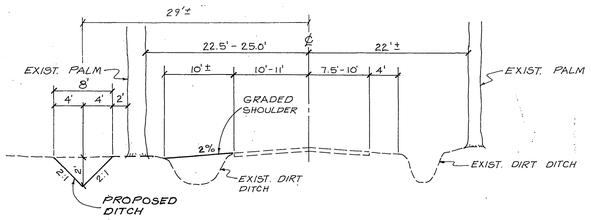

TYPICAL SECTION
STA. 10+40 TO STA. 14+40
NO SCALE

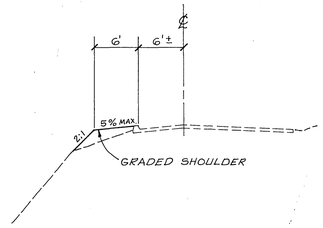

TYPICAL SECTION
ST. LAWRENCE TO 185' W'LY
NO SCALE

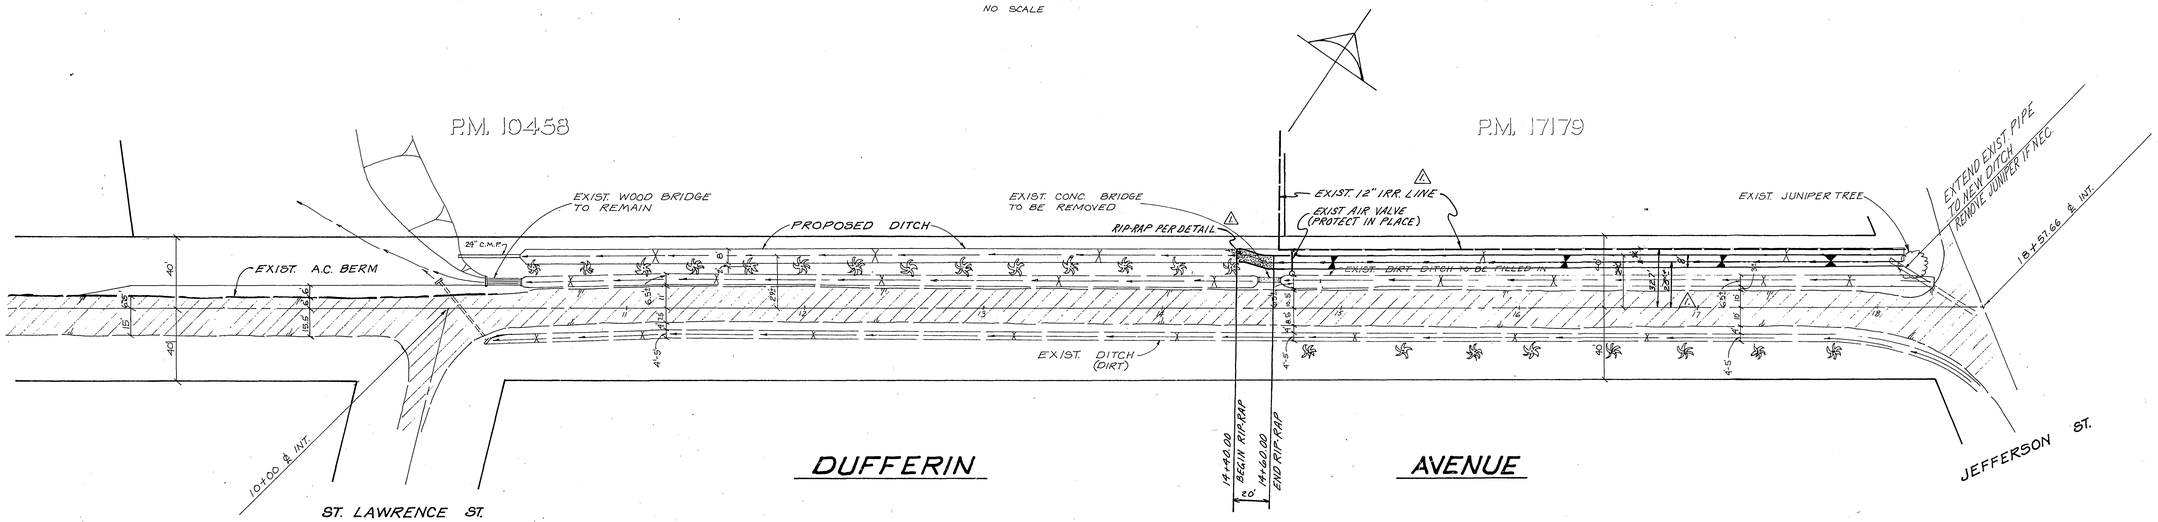

DUFFERIN AVENUE

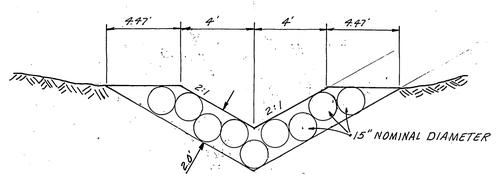

LEGEND

INDICATES EXIST. A.C. PAVEMENT

R-2391-A

INDEXED BLD

NO.	DATE	REVISION
1	9-10-82	REVISED DITCH LOCATION TO AVOID IRRIGATION LINE.

J. F. DAVIDSON ASSOCIATES
CIVIL ENGINEERS • SURVEYORS • PLANNERS
3426 TENTH STREET, RIVERSIDE, CAL.
11200 S. MT. VERNON AVE., COLTON, CAL.

SCALE: HORIZ. : 1" = 40'
BENCH MARK:
DATE FEB. 1981

DUFFERIN AVENUE
ST. LAWRENCE ST. TO JEFFERSON ST.

W.O. 5194 | FOR: WONG, TO CHI ON. | F.B.

1 OF 1 SHEETS
FILE NO. 5583