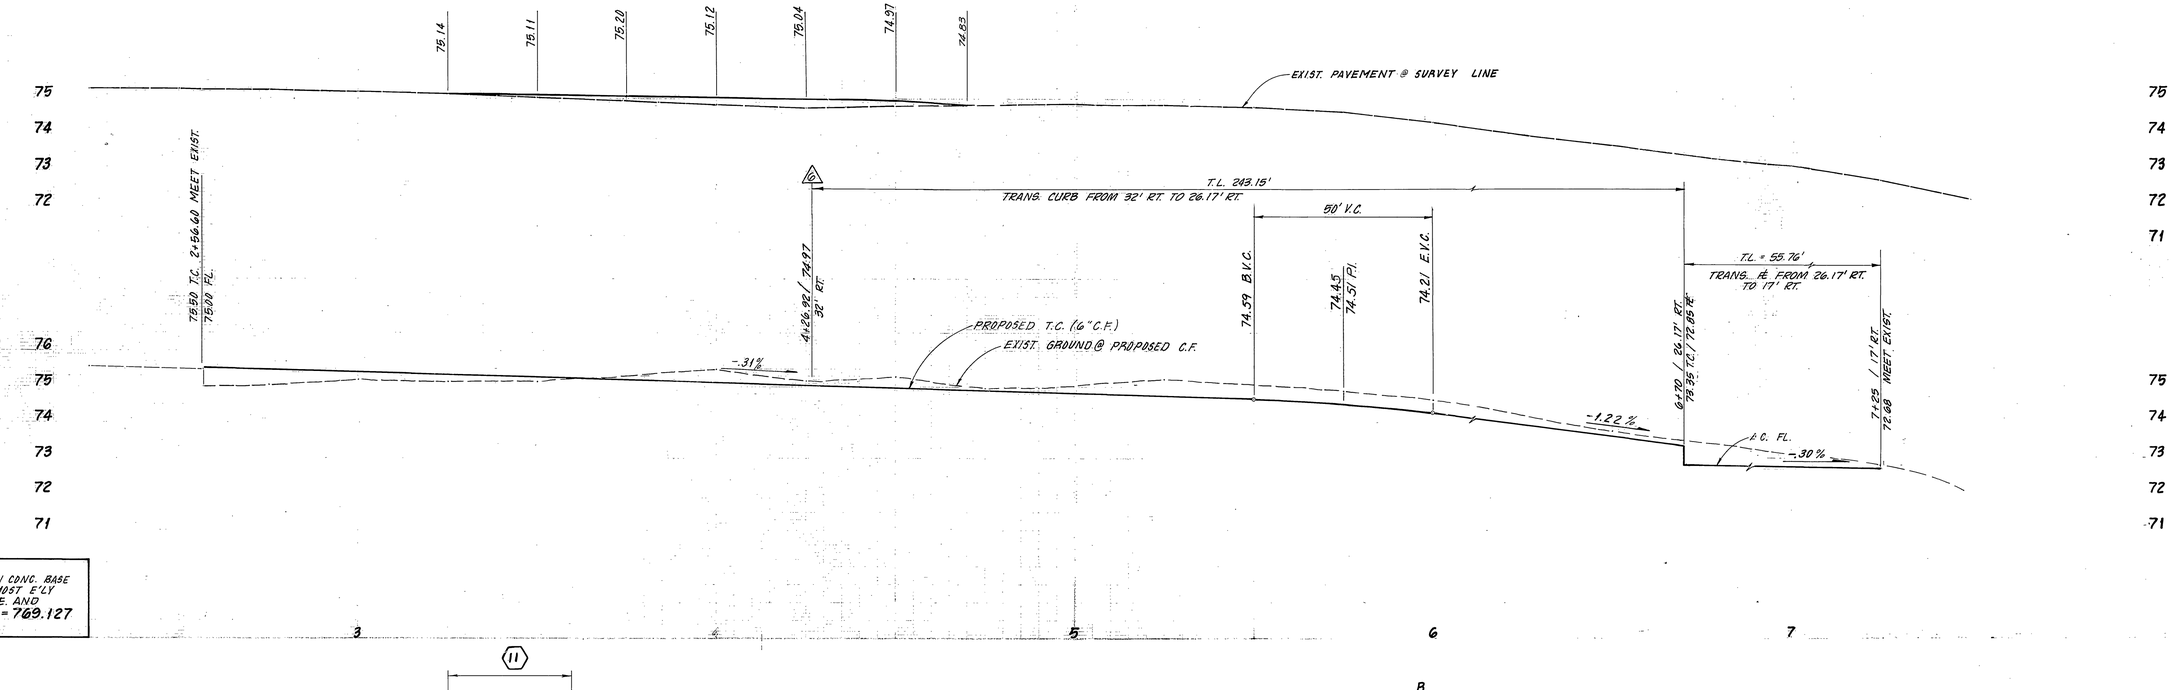

B.M.:
PK. NAIL & CITY TAG IN CONC. BASE OF STREET LIGHT ON WEST E'LY COR. OF MAGNOLIA AVE. AND HARRISON ST. ELEV. = 709.127

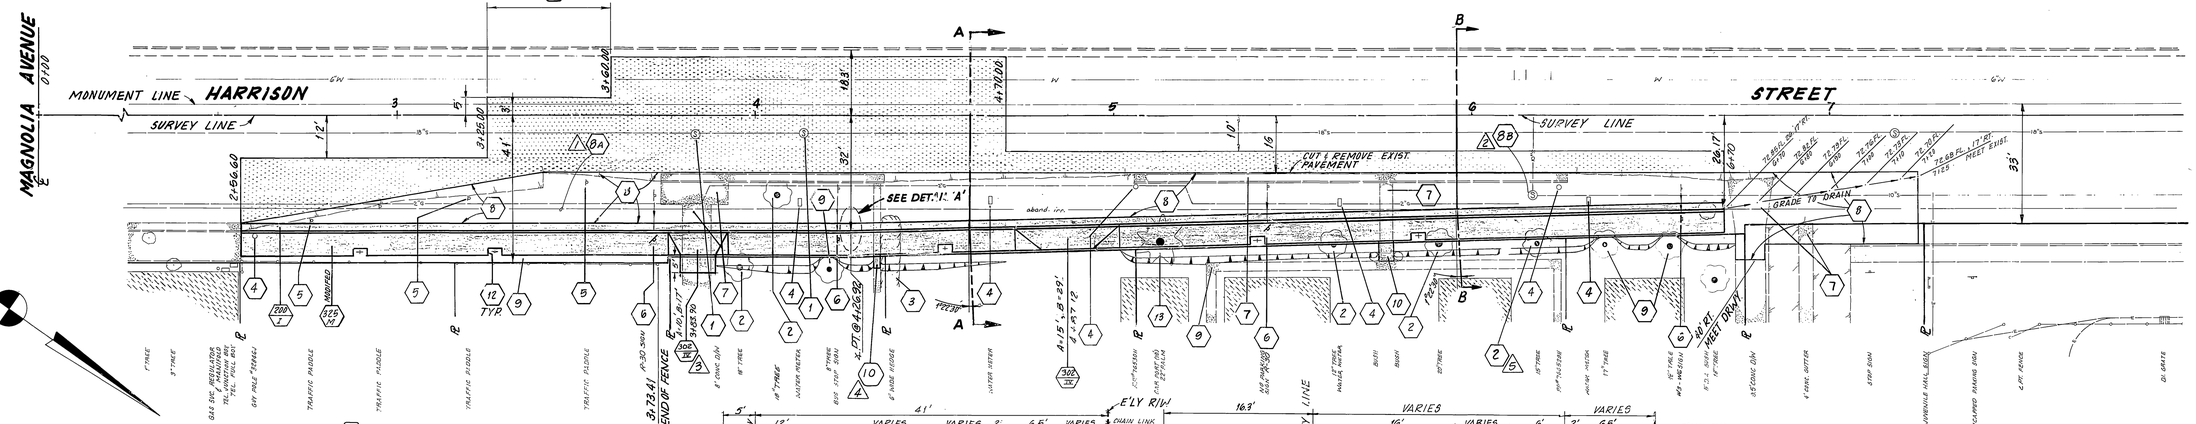

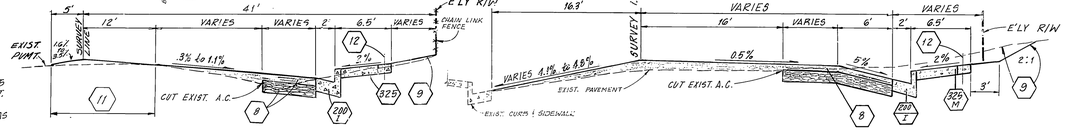

TYPICAL SECTION
STA. 2+56.60 to STA. 3+60.00
NOT TO SCALE

TYPICAL SECTION A-A
STA. 3+60.00 to STA. 4+70.00
NOT TO SCALE

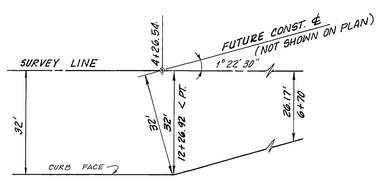

DETAIL 'A'
NOT TO SCALE

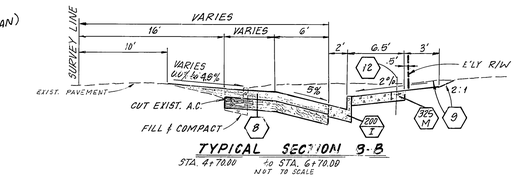

TYPICAL SECTION B-B
STA. 4+70.00 to STA. 6+70.00
NOT TO SCALE

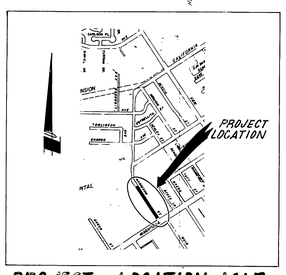

PROJECT LOCATION MAP
NOT TO SCALE

GENERAL NOTES

1. CONST. SHALL BE IN ACCORDANCE WITH THE CITY OF RIVERSIDE, STD. DWGS. AND STD. SPECS. FOR PUBLIC WORKS CONSTRUCTION, 1982, EDITION.

⬢ NUMBERS ABOVE 100 IN HEXAGON ON THE PLAN REFER TO THE RESPECTIVE STANDARD DRAWING AND SHALL BE CONSTRUCTED ACCORDINGLY, UNLESS MODIFICATIONS ARE NOTED ON THE PLAN. ANY NUMBER SHOWN BELOW THE STANDARD DRAWING NUMBER INDICATES THE SPECIFIC ALTERNATE TO BE CONSTRUCTED.

ALL ELEVATIONS SHOWN ON PLAN SHALL BE STAKED IN THE FIELD.

A.C. OVERLAY

ASPHALT PAVING

CONSTRUCTION NOTES

200 I — CONSTRUCT CURB & GUTTER PER STD. DWG. NO. 200 - TYPE I (6" C.F.)

302 IW — CONSTRUCT DRWY. APPROACH PER STD. DWG. NO. 302, TYPE IW

325 M — CONSTRUCT CONC. SIDEWALK PER STD. DWG. NO. 325, FOR MODIFICATION SEE NOTE (9)

1 — ADJUST SEWER OR STORM DRAIN MANHOLE TO GRADE

2 — REMOVE TREE

3 — REMOVE INTERFERING PORTIONS OF HEDGE

4 — TO BE RELOCATED BY OTHERS

5 — REMOVE TRAFFIC PADDLE

6 — SALVAGE & RELOCATE SIGN AS SHOWN IN ACCORDANCE WITH STD. DWG. 666 WITH THE FOLLOWING MODIFICATION: ALL 'NO PARKING' SIGNS SHALL FACE TRAFFIC WITH A 45° ∠.

7 — REMOVE EXISTING CONCRETE IMPROVEMENTS AS SHOWN

8 — CONSTRUCT STRUCTURAL SECTION OF .21' A.C. OVER .45' AGGREGATE BASE.

8A — BETWEEN STA.'S 2+56.60 & 6+70 REMOVE ABANDONED IRRIGATION LINE OF UNKNOWN LENGTH & DIA., AND FILL & COMPACT (90% REL. COMPACTION.)

8B — REMOVE EXIST. CONC. BOX STRUCTURE AND CONST. A NEW M.H. PER STD. DWG. NO. 500.

9 — BETWEEN STA'S 2+56.60 & 3+73.41, FROM BACK OF S/W TO THE CHAIN LINK FENCE, CUT OR FILL AS NECESSARY TO MEET EXIST. GRADE AT THE FENCE, FROM STA. 3+25 TO 9+45 USE VARIABLE SLOPES TO MEET EDGE OF EXIST. 25' CONC. WALK, WITHIN DRIPLINE of TREES, FROM BACK OF SIDEWALK USE VARIABLE SLOPES AS STEEP AS 0.5 : 1 TO MINIMIZE DISTURBANCE TO TREES.

10 — REMOVE AND RECONSTRUCT PORTIONS OF EXIST. CONC. WALK AS SHOWN.

11 — BETWEEN STA'S 3+25.00 AND 3+60.00, FROM FLAGGED SURVEY LINE EL. MEET EXIST. PAVEMENT AT 6' LT. AND PROPOSED G.L. AT 30' RT. IN STRAIGHT GRADES

12 — PLANT 15-GALLON MAGNOLIA GRANDEFLORA (MAJESTIC BEAUTY) IN 2'x4' CUTOUTS PER CITY OF RIVERSIDE PARK DEPT. SPECIFICATIONS.

13 — FILIFERA PALM TO BE RELOCATED TO HARRISON PARK AT LINCOLN AND HARRISON.

PARK DEPARTMENT NOTES

1. All related work shall conform to the City of Riverside, Park and Recreation Department Standards.
2. Contact the Park Projects Inspector a minimum of 48 hours in advance at 787-7223 to schedule inspections. Inspections shall be required: a) when plant locations have been spotted in the field prior to digging plant pits, b) while digging plant pits and planting/relocating trees, c) after planting and all other indicated or specified work has been completed for start of maintenance, and d) at end of maintenance/final acceptance (contractor/developer will be released from maintenance only upon receipt of written notification from the city that the Park and Recreation Department is assuming maintenance responsibilities).
3. The Contractor/Developer shall maintain all plantings for a minimum period of one (1) year.
4. Street Tree planting shall be as follows:

Street Name	Botanical Name/Common Name	Min. Size	Approx. Spacing	No. Req.
Harrison St.	Magnolia granderlora/ Majestic Beauty	15 gal.	As Shown	5

U5. A Public Works Department permit is required prior to commencement of tree relocation and/or removal work. For all trees within the ultimate pavement area, backfill of all holes is to be inspected by the City for proper compaction.

MARK	REVISIONS	APPR.	DATE
1	ADDED Sheet 6-21-85		
2	REVISED Sheet 6-21-85		
3	REVISED LOCATION & DIMENSIONS Sheet 6-21-85		
4	ADDED Sheet 6-21-85		
5	ADDED Sheet 6-21-85		
10	REVISED TO < PT. Sheet 6-21-85		

DESIGNED BY [illegible] DRAWN BY Sheet CHECKED BY [illegible] 6/12/85

CITY OF RIVERSIDE
PUBLIC WORKS DEPARTMENT

APPROVED BY	DATE	BY
PRINCIPAL ENGINEER	3/5/85	
PARK DEPARTMENT	6-11-85	
TRAFFIC DIVISION	6-18-85	
CHIEF P.W. ENGINEER	3-5-85	

APPROVED BY [signature] PUBLIC WORKS DIRECTOR
DATE 3/5/85

HARRISON ST. WIDENING
E'LY SIDE
(AN HCD PROJECT)
FROM 250' TO 700' NORTH OF MAGNOLIA AVE.

HORIZ. SCALE: 1" = 20' VERT. SCALE: 1" = 2'

INDEX NO.

ACCOUNT NO. 16-560-664

R-2515

SHEET 1 OF 1

As Built 12/22/86