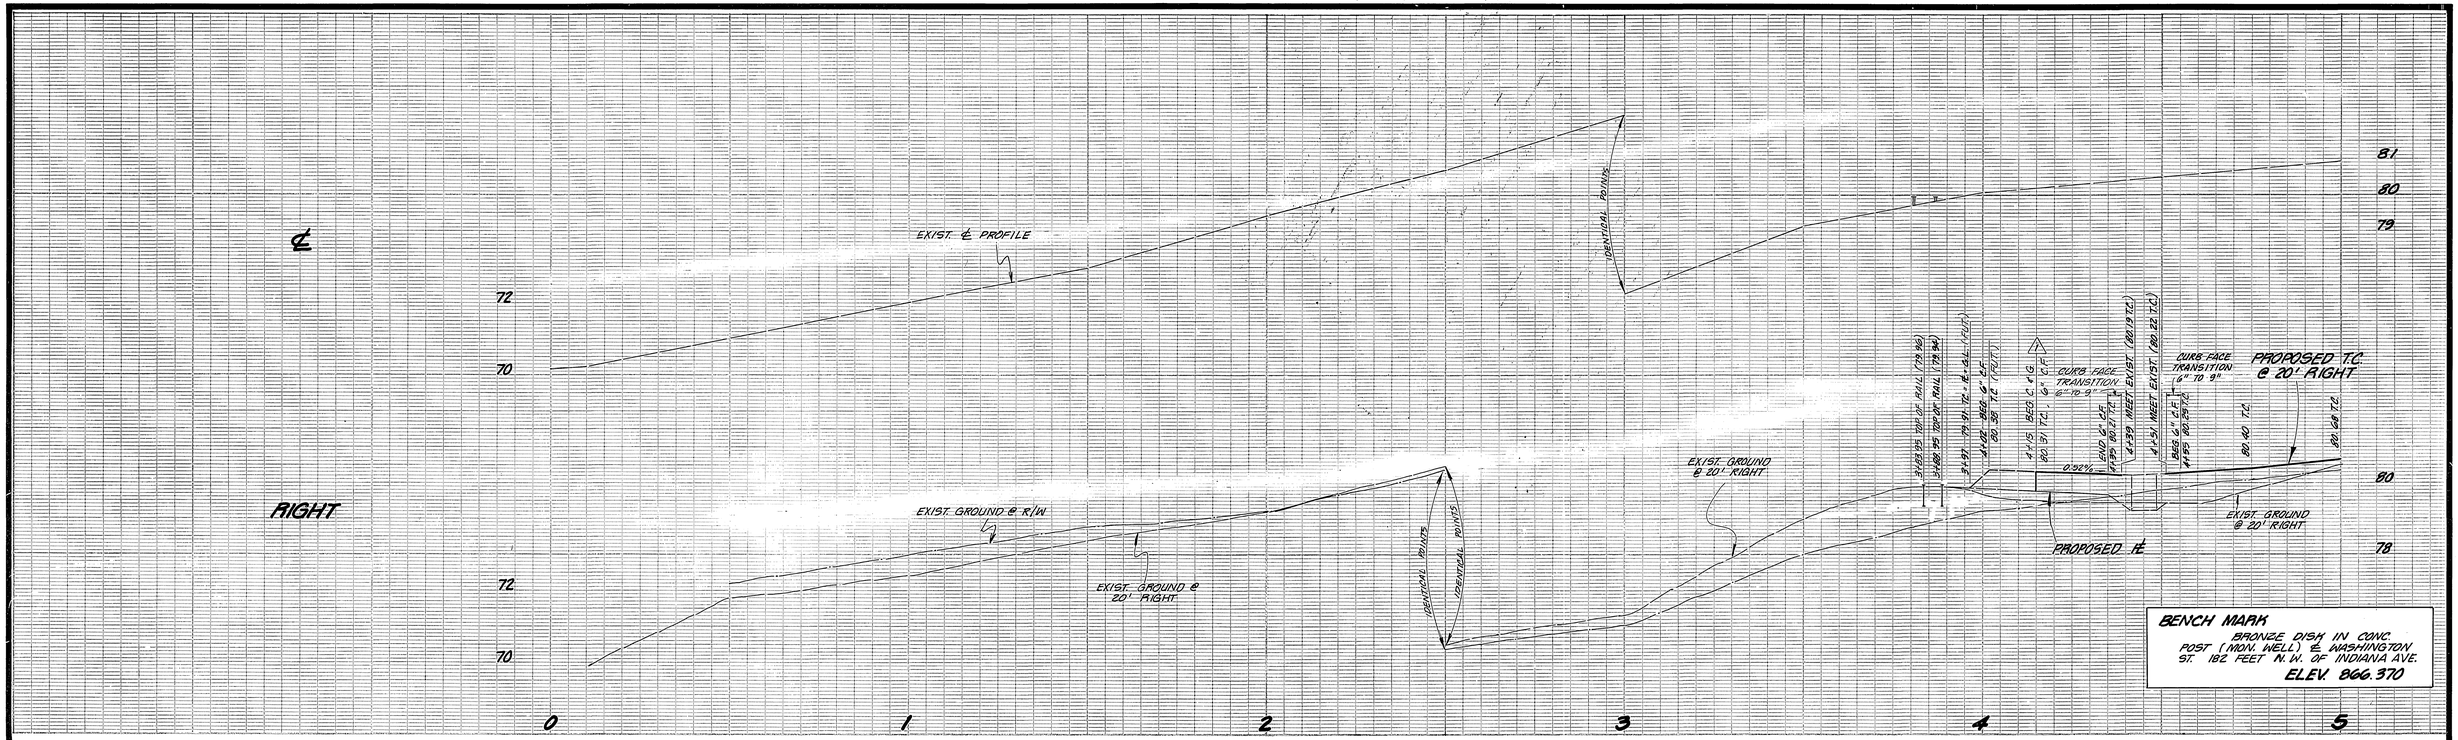

GENERAL NOTES

1. CONST. SHALL BE IN ACCORDANCE WITH THE CITY OF RIVERSIDE, STD. DWGS. & STD. SPECS. FOR PUBLIC WORKS CONSTRUCTION, 1982 EDITION.
2. ⬢ NUMBERS ABOVE 100 IN A HEXAGON ON THE PLAN REFER TO THE RESPECTIVE STD. DWG. AND SHALL BE CONSTRUCTED ACCORDINGLY, UNLESS MODIFICATIONS ARE NOTED ON THE PLAN BELOW. ANY NUMBER SHOWN BELOW THE STD. DWG. NUMBER INDICATES THE SPECIFIC ALTERNATE TO BE CONSTRUCTED.
3. CUT & FILL SLOPES ARE 2:1 OR FLATTER.
4. RIGHTS OF ENTRY HAVE BEEN OBTAINED FOR ALL WORK SHOWN ON PRIVATE PROPERTY.
5. ALL ELEVATIONS SHOWN ON PLAN SHALL BE STAKED IN THE FIELD.

CONSTRUCTION NOTES

1. CONSTRUCT STRUCTURAL SECTION OF 0.21' A.C. OVER 0.50' C.A.B.
2. REMOVE EXIST A.C. & REPLACE WITH 0.21' A.C. OVER 0.50' C.A.B.
3. PLANT STREET TREES PER CITY OF RIVERSIDE PARK & RECREATION DEPT. STD. 501.
4. CONSTRUCT P.C.C. WALL PER DETAIL "A" SHOWN ON PLAN SHEET 2

GENERAL NOTES FOR STREET TREE PLANTING

1. All related work shall conform to the City of Riverside, Park and Recreation Department Standards.
2. Contact the Park Projects Inspector a minimum of 48 hours in advance at 787-7223 to schedule inspections. Inspections shall be required:

   a) When plant locations have been spotted in the field prior to digging plant pits, b) while digging plant pits and planting/relocating trees, c) after planting and all other indicated or specified work has been completed for start of maintenance, and d) at end of maintenance/final acceptance (contractor/developer will be released from maintenance only upon receipt of written notification from the city that the Park and Recreation Department is assuming maintenance responsibilities).
3. ~~The Contractor/Developer shall maintain all plantings for a minimum period of 90 days.~~
4. Street tree planting shall be as follows:

	Street Name	Botanical Name/Common Name	Min. Size	Approx. Spacing	No. Req.
a.	Washington St.	Lager stroemia indica/Crape Myrtle	15 gal.	50'	10

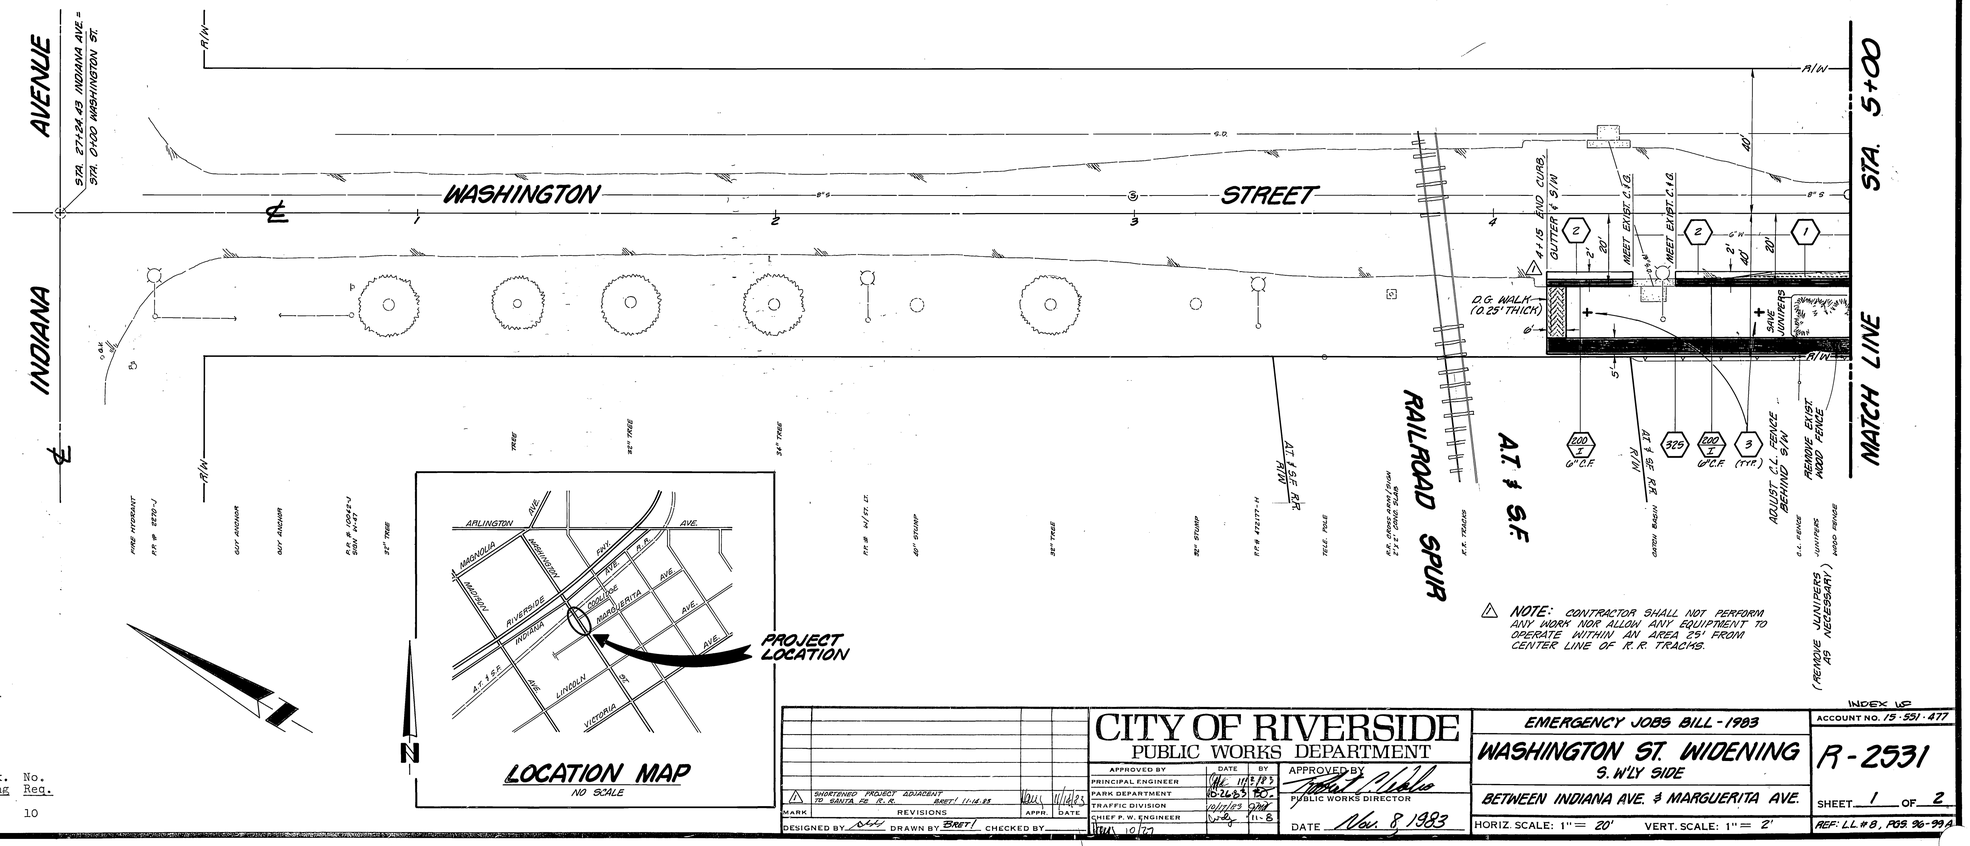

LOCATION MAP
NO SCALE

MARK	REVISIONS	APPR.	DATE
1	SHORTENED PROJECT ADJACENT TO SANTA FE R.R. BRET! 11-14-83	DLL	11/14/83

DESIGNED BY DLL DRAWN BY BRET! CHECKED BY

CITY OF RIVERSIDE
PUBLIC WORKS DEPARTMENT

APPROVED BY	DATE	BY
PRINCIPAL ENGINEER	11/15/83	
PARK DEPARTMENT	10-26-83	RDC
TRAFFIC DIVISION	10/11/83	DMH
CHIEF P. W. ENGINEER	10/11/83	FIL-B

APPROVED BY Robert F. Nichols
PUBLIC WORKS DIRECTOR
DATE Nov. 8 1983

EMERGENCY JOBS BILL - 1983

WASHINGTON ST. WIDENING
S. W'LY SIDE

BETWEEN INDIANA AVE. & MARGUERITA AVE.

HORIZ. SCALE: 1" = 20' VERT. SCALE: 1" = 2'

INDEX NO

ACCOUNT NO. 15-551-477

R-2531

SHEET 1 OF 2

REF: LL #8, PGS 96-99A

PC 1378

51830

OZALID- NO.1

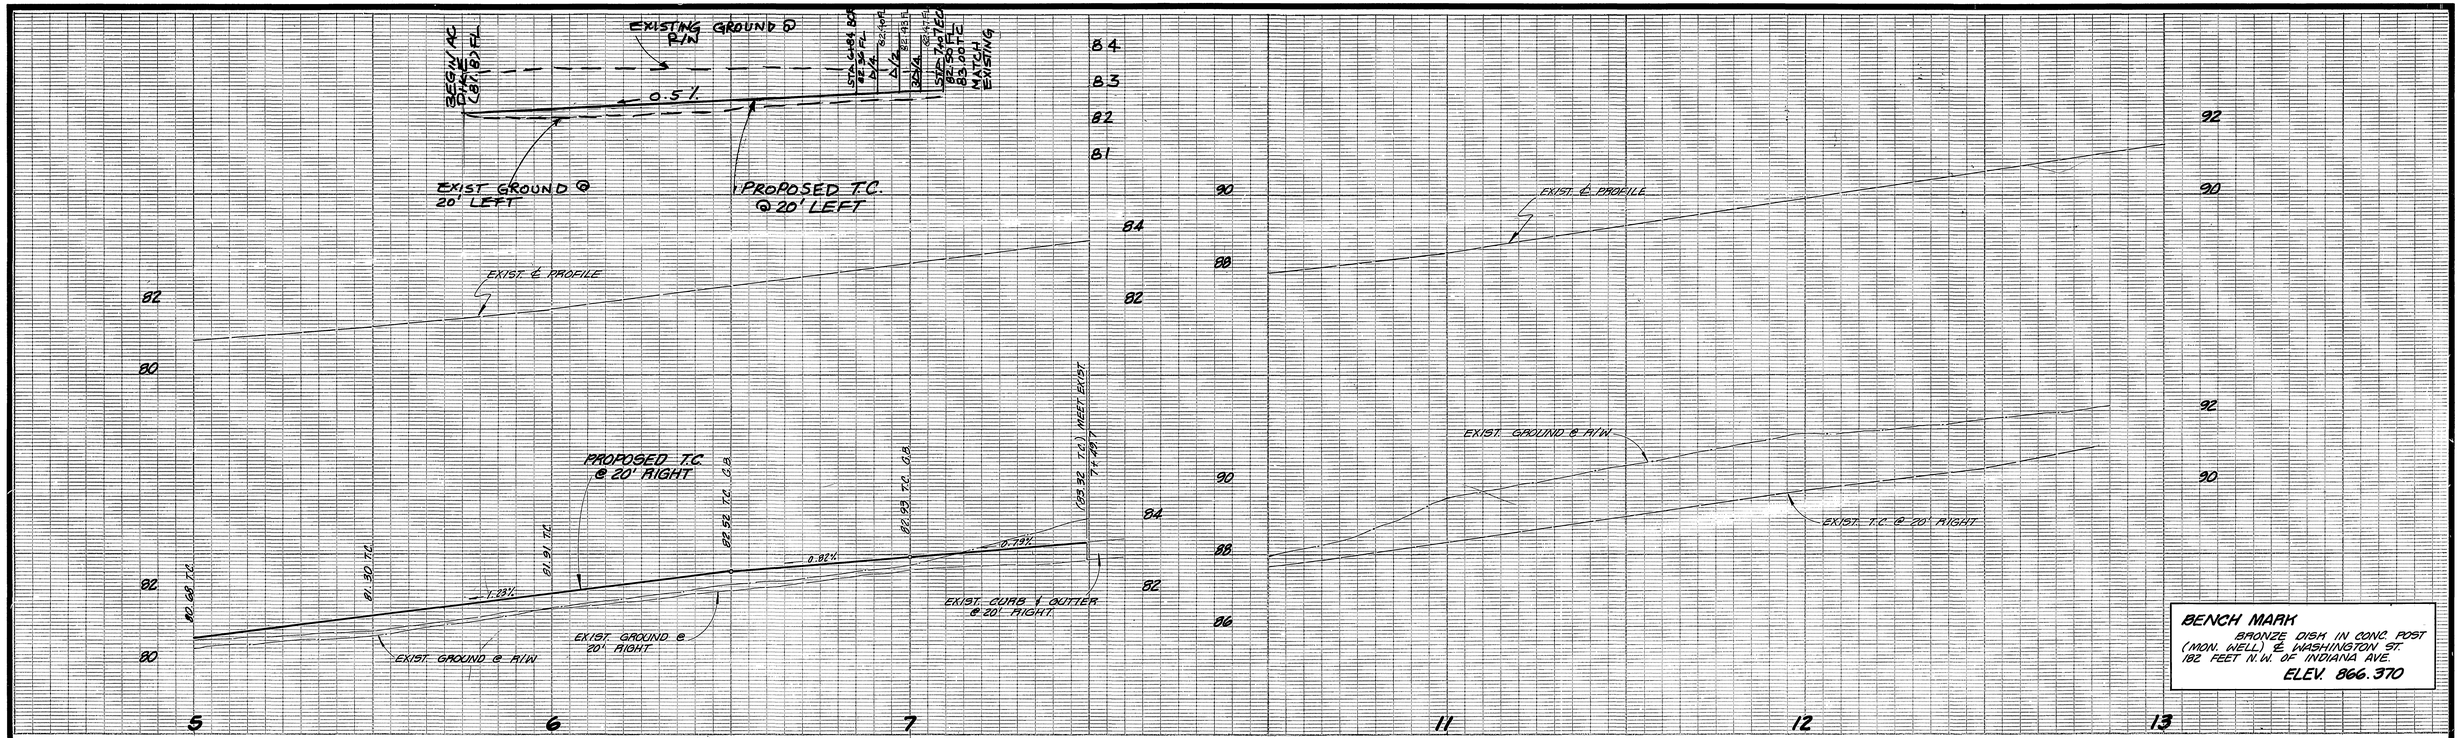

BENCH MARK
BRONZE DISH IN CONC POST
(MON. WELL) @ WASHINGTON ST.
ELEV. 866.370

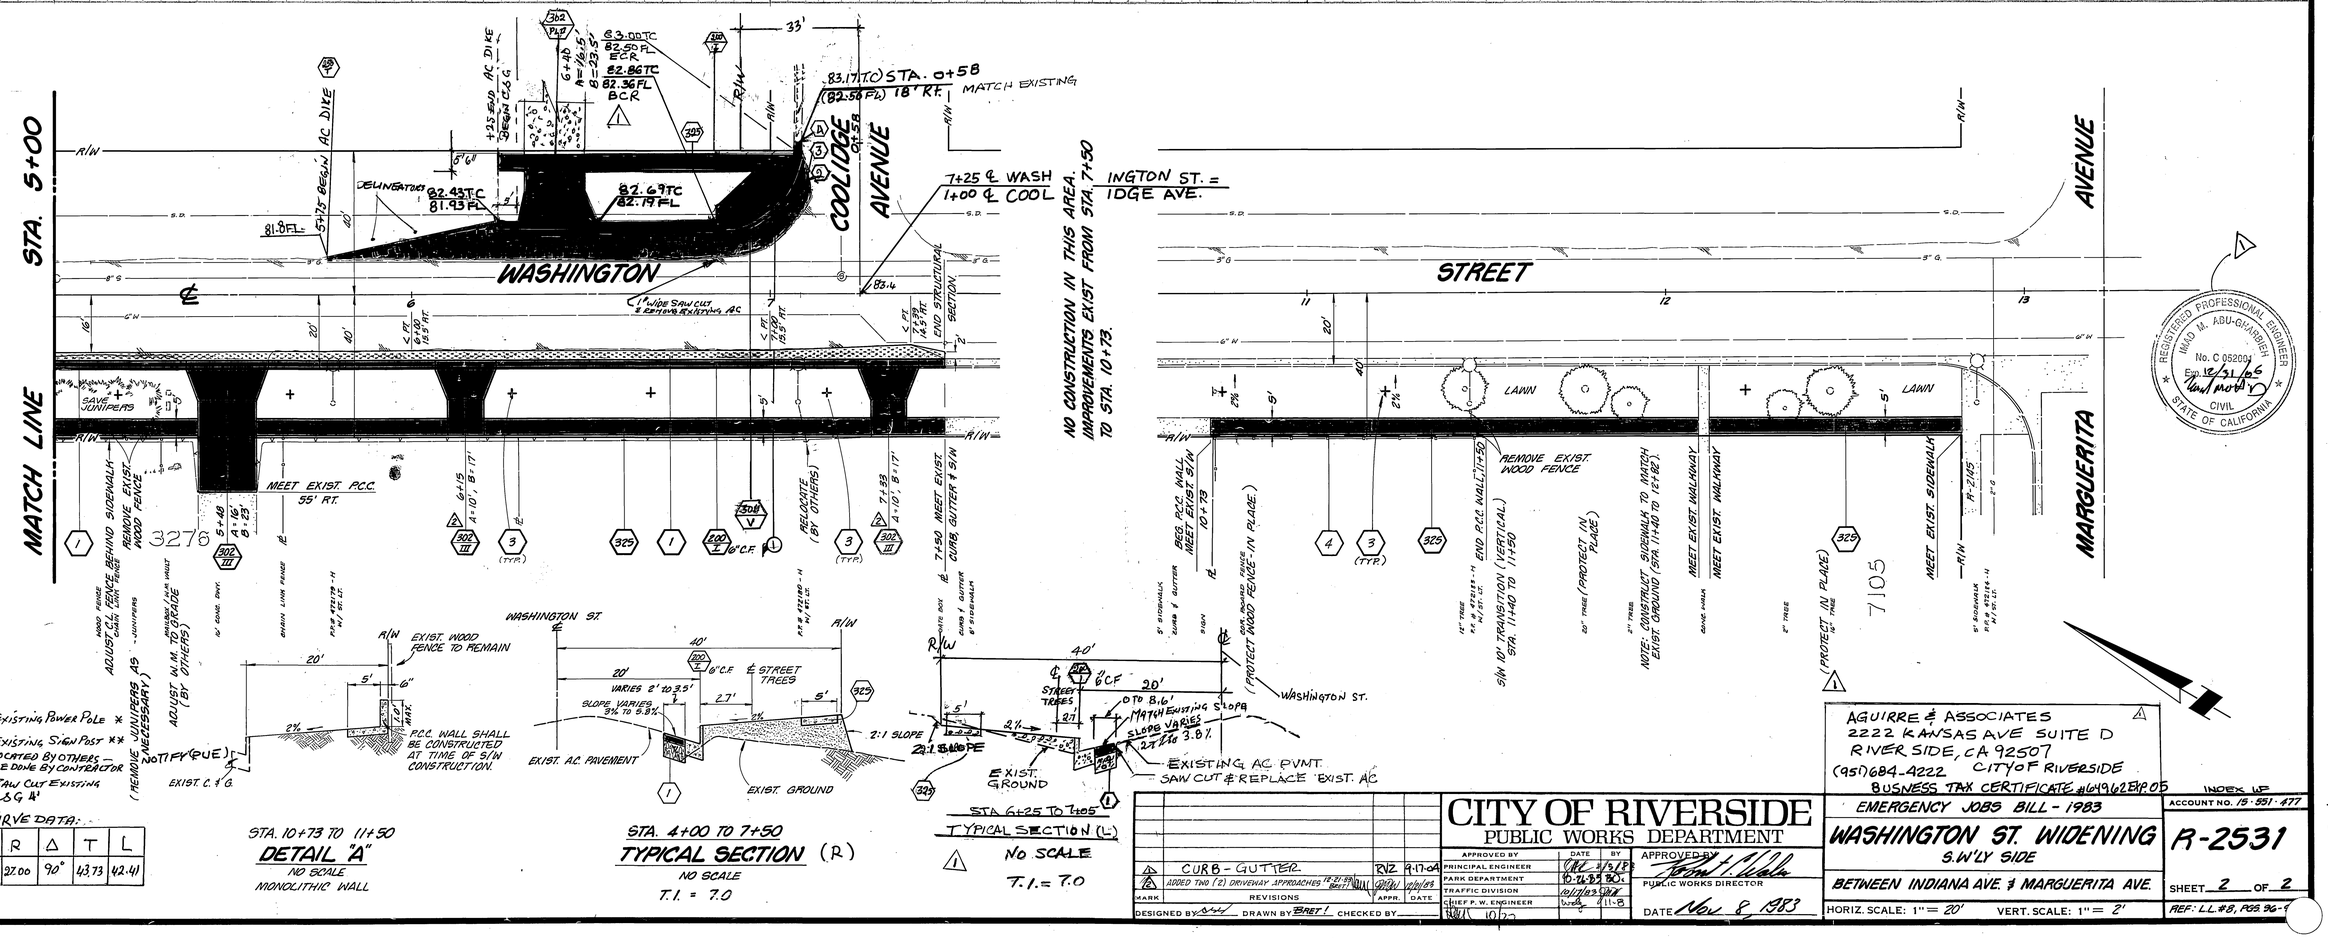

- (9) EXISTING POWER POLE *
- (3) EXISTING SIGN POST **
- * TO BE RELOCATED BY OTHERS —
- ** THIS IS TO BE DONE BY CONTRACTOR
- (4) SAW CUT EXISTING C.S.G 4'

CURVE DATA:

NO	R	Δ	T	L
(1)	27.00	90°	43.73	42.41

STA. 10+73 TO 11+50
DETAIL "A"
NO SCALE
MONOLITHIC WALL

STA. 4+00 TO 7+50
TYPICAL SECTION (R)
NO SCALE
T.I. = 7.0

STA. 6+25 TO 7+05
TYPICAL SECTION (L)
NO SCALE
T.I. = 7.0

AGUIRRE & ASSOCIATES
2222 KANSAS AVE SUITE D
RIVERSIDE, CA 92507
(951) 684-4222 CITY OF RIVERSIDE
BUSINESS TAX CERTIFICATE #649962 EXP 05

INDEX LF

CITY OF RIVERSIDE
PUBLIC WORKS DEPARTMENT

EMERGENCY JOBS BILL - 1983

WASHINGTON ST. WIDENING
S.W'LY SIDE

BETWEEN INDIANA AVE. & MARGUERITA AVE.

ACCOUNT NO. 15-551-477

R-2531

SHEET 2 OF 2

HORIZ. SCALE: 1" = 20' VERT. SCALE: 1" = 2'

REF: LL #8, PGS 96-97

MARK	REVISIONS	APPR.	DATE
1	CURB-GUTTER. RVZ	RVZ	9-17-04
2	ADDED TWO (2) DRIVEWAY APPROACHES (2-21-85 BRET)		4/29/85

DESIGNED BY ____ DRAWN BY BRET CHECKED BY ____

APPROVED BY	DATE	BY
CHIEF P. W. ENGINEER	11-8	

APPROVED BY _____
PUBLIC WORKS DIRECTOR

REGISTERED PROFESSIONAL ENGINEER
HAMID M. ABU-GHARBIEH
No. C 052004
Exp. 12/31/06
CIVIL
STATE OF CALIFORNIA

OZALID- NO.1
81830