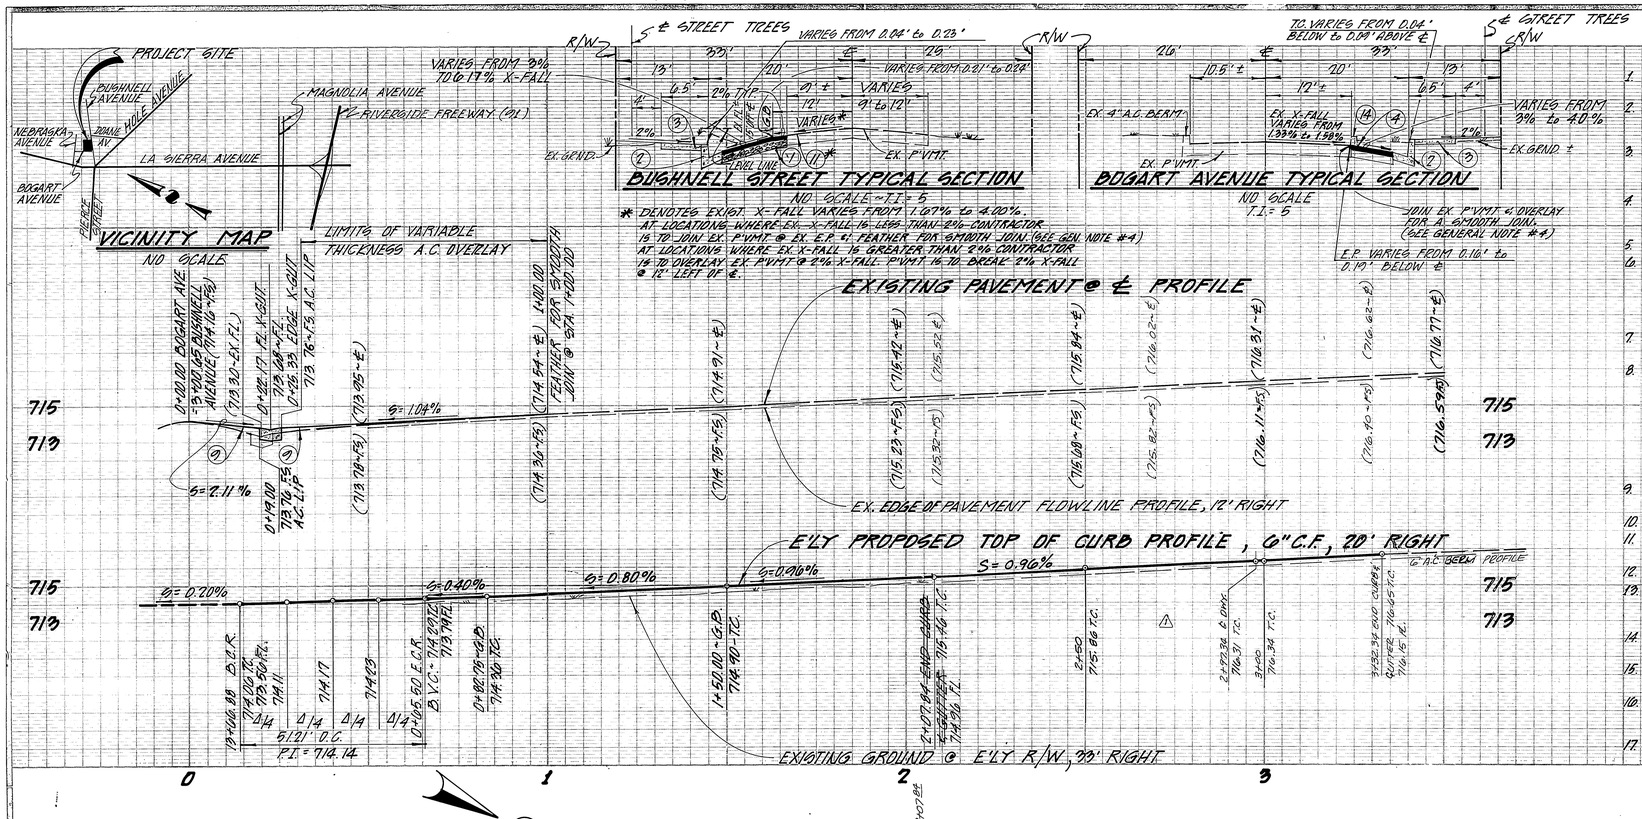

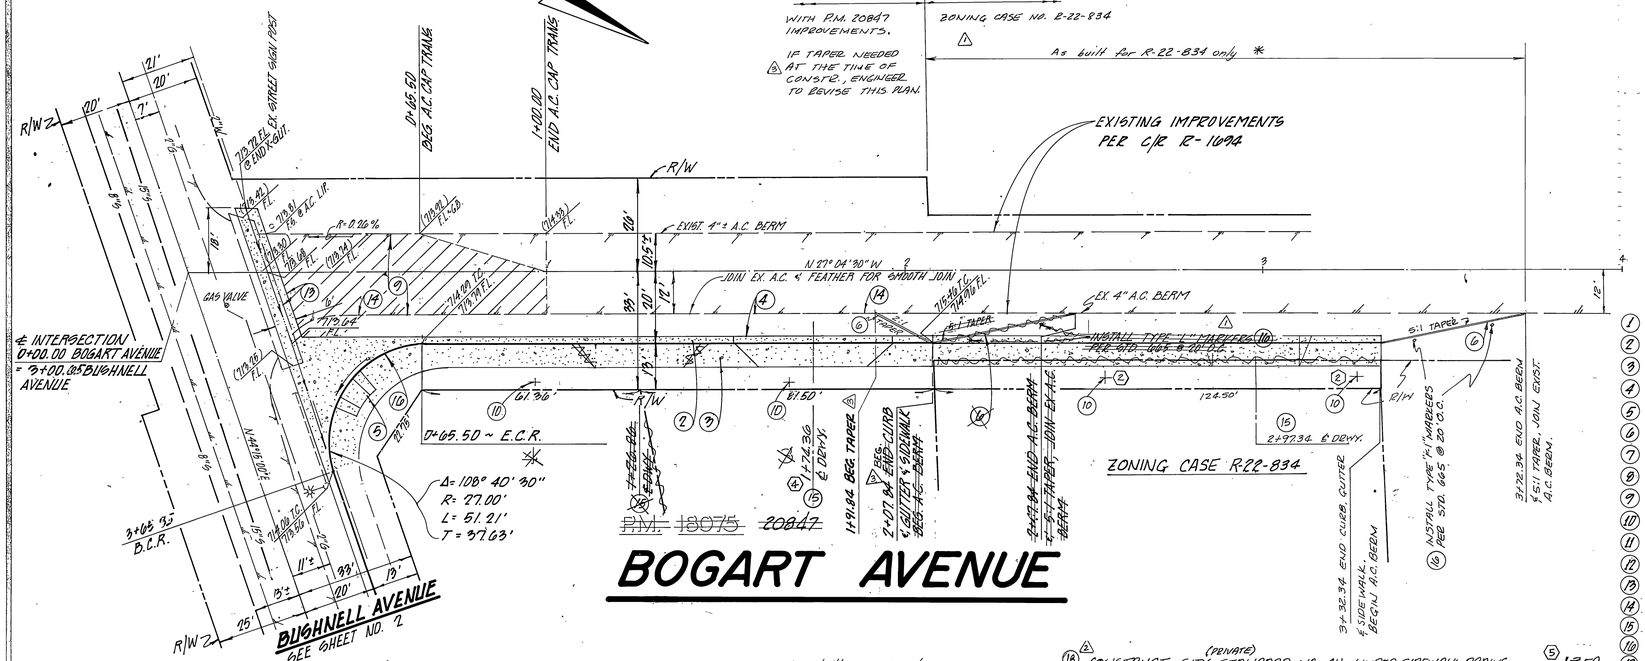
TO BE CONSTRUCTED WITH P.M. 20847 IMPROVEMENTS.
IF TAPER NEEDED AT THE TIME OF CONSTR., ENGINEER TO REVISE THIS PLAN.
TO BE CONSTRUCTED WITH ZONING CASE NO. R-22-834
As built for R-22-834 only *
EXISTING IMPROVEMENTS PER C/R R-16094
D=65.50 BEG. A.C. CAP TRANS.
1+00.00 END A.C. CAP TRANS.
713.78 EX. STREET SIGN POST
713.76 EX. E.C.R. & END K-GUT.
713.78 E.C.R.
R=0.20%
713.88 E.C. LIP
713.64 F.G.
714.54 ± (E) 1+00.00 FEATHER FOR SMOOTH JOIN @ STA. 1+00.00
0+19.00 713.76 E.C.R. AC LIP
0+56.33 713.78 E.C.R. 713.74 F.G.
0+65.50 713.78 E.C.R. 713.74 F.G.
1+50.00 714.40 T.C.
2+50.00 715.86 T.C.
2+56.50 716.02 T.C.
2+97.34 & DRWY. 716.37 T.C.
3+40 716.34 T.C.
3+32.34 END CURB, GUTTER 716.15 T.C.
