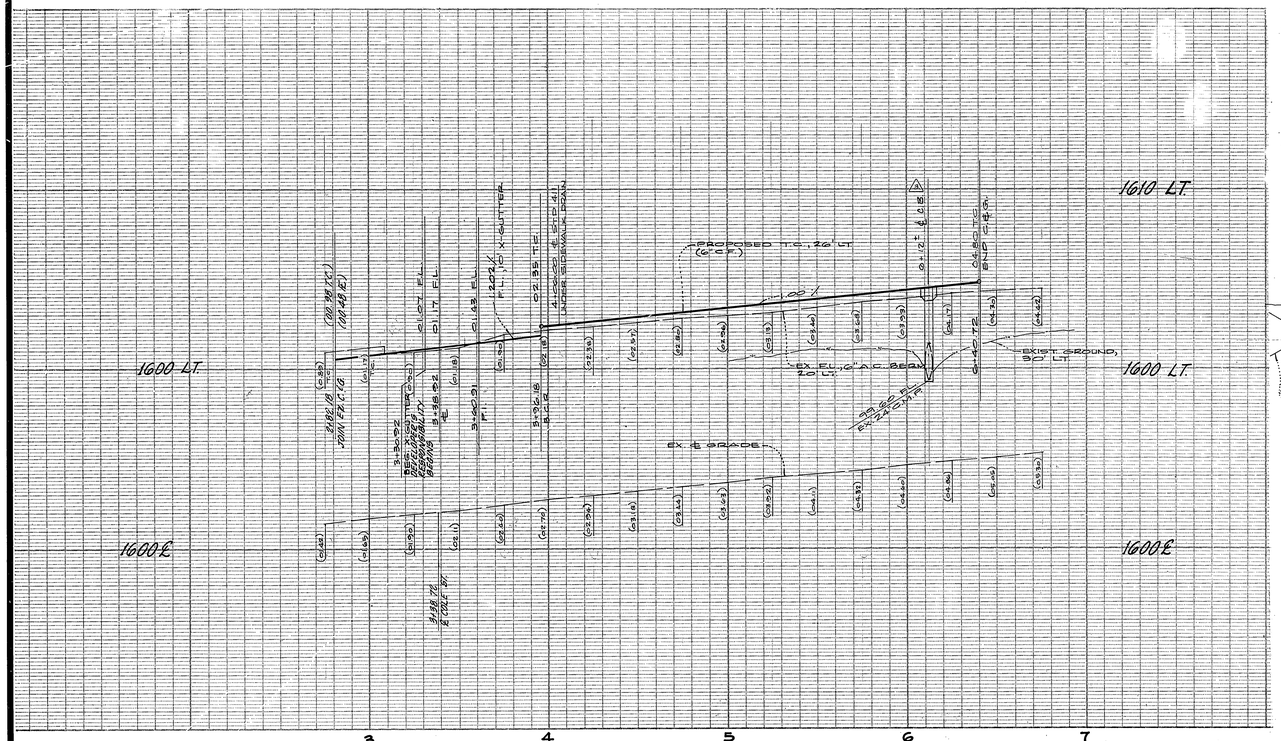
1610 LT.
1600 LT.
1600 E
EX. E GRADE
PROPOSED T.C. 1.20' LT
EX. FL. C.A.C. BEAM 20 LT.
EXIST. GROUND, 9.01 LT
EXIST. 6" C.G.
EXIST. 4" SIDEWALK
EXIST. 6" C.G.

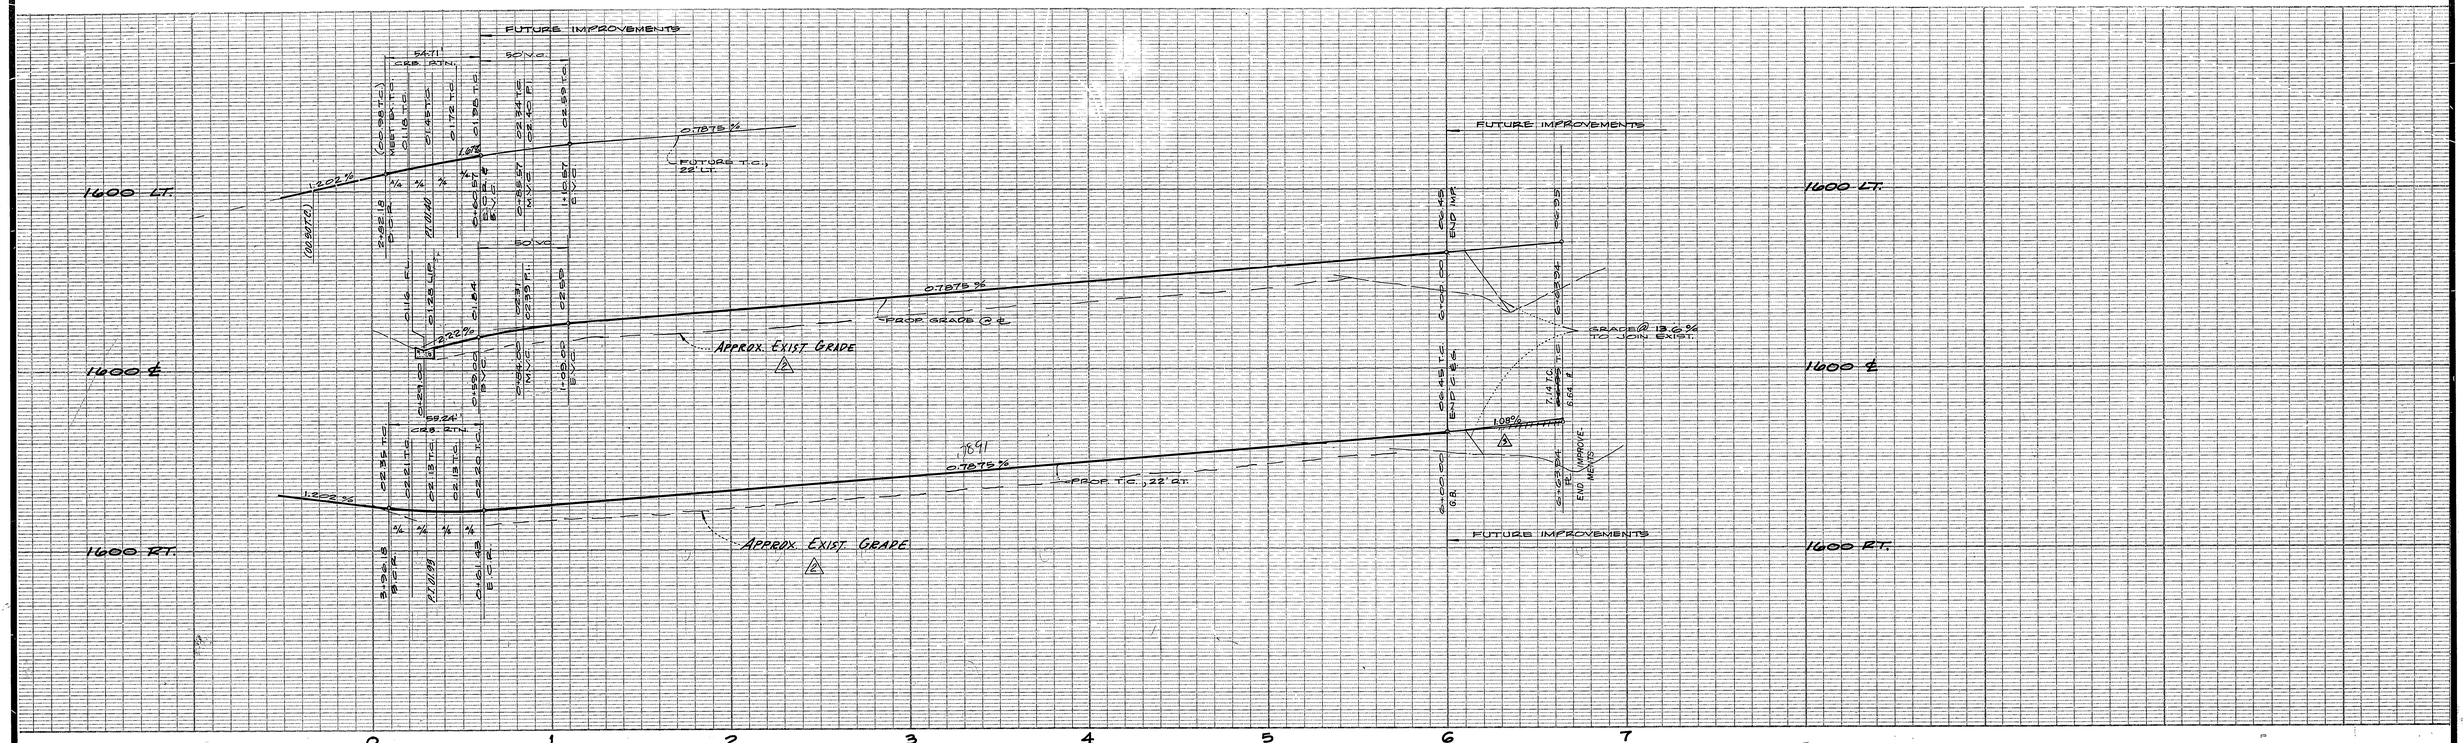

STREET NAME SIGN SCHEDULE

NAME	BLK. Nº
ALESSANDRO BLVD.	300
COLE ST.	2600

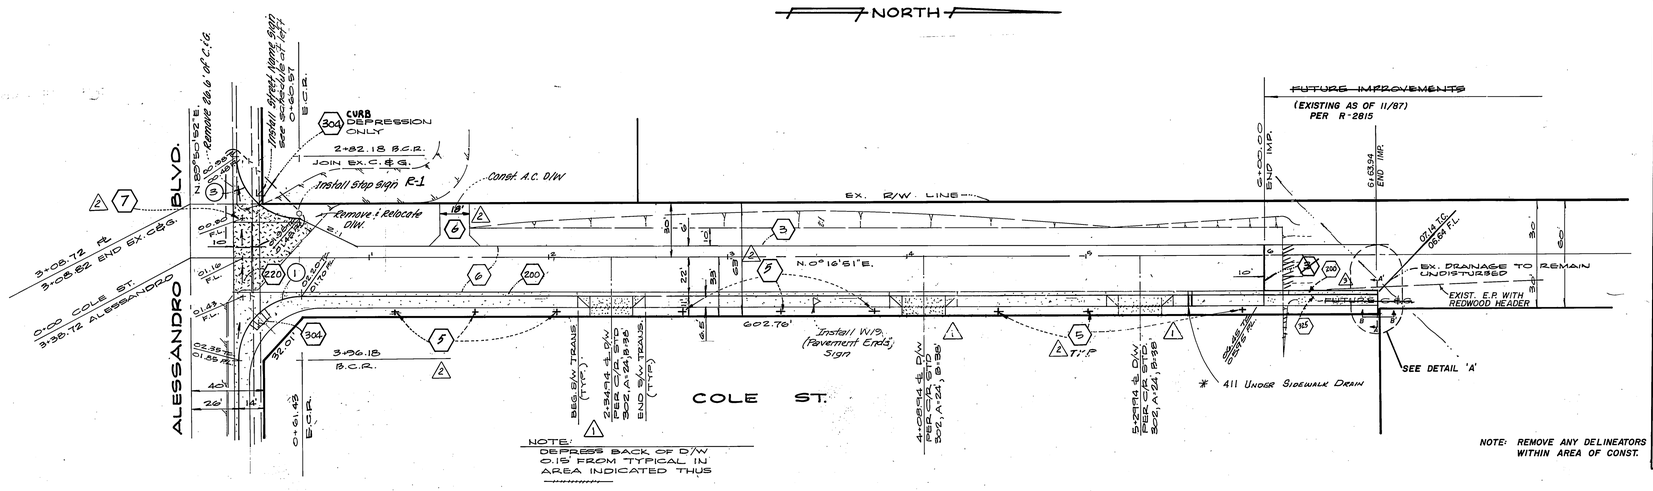

SEE SHT. 1

CURVE DATA

No.	R	Δ	T	L
1	35.00'	90°25'53"	35.27'	55.24'
2	20.00'	90°00'00"	20.00'	31.42'
3	35.00'	89°34'01"	34.74'	54.71'

NOTES

- REMOVE REDWOOD HEADER AT EXISTING EDGE OF PAVEMENT AND PLACE 6" A.C. PAVING OVER NATIVE SOIL.
- GRADE BEHIND SIDEWALK TO GRADUALLY BLEND WITH EXISTING LANDSCAPE.
- JOIN EXISTING SIDEWALK AND CURB AND GUTTER WITH 1/2" THICK EXPANSION JOINT
- CONSTRUCT 1/2" EXPANSION MIDPOINT OF NEW SIDEWALK AND CURB AND GUTTER

BENCH MARK

ELEV. = 1607.695 - FD. PK. NAIL & TAG IN CONC. RETAINING WALL S'ELY OF INTERSECTION OF ALESSANDRO BLVD. AND TRAUTWEIN RD.

REGISTERED PROFESSIONAL ENGINEER DAVID W. HANSEN No. 17984 exp 6-30-89 CIVIL STATE OF CALIFORNIA

W.M.W.D. ⚠

BY: [signature] DATE: 12-21-87

R.C.E. NO. 17984 EXPIRES 6/89

PACIFIC TELEPHONE CO

APPROVED BY [signature] DATE 3/29/88

ALBERT A. WEBB ASSOCIATES
CIVIL ENGINEERS
RIVERSIDE, CALIFORNIA

APPROVED BY [signature] DATE 3/4/88

R.E. No. 11842

W.O. 83-6 FOR: W. M. W. D. F.B. 1016

MARK	REVISIONS	APPR.	DATE
⚠	EXTENDED C&G AND SIDEWALK FOR WMWD	WLK	11/1988
⚠	REVISED BY WMWD	WLK	5-1-88
⚠	REVISED D/W CONST.	WLK	8-3-88

DESIGNED BY JB DRAWN BY JB CHECKED BY L.E.C.

CITY OF RIVERSIDE, CALIFORNIA
PUBLIC WORKS DEPARTMENT

	BY	DATE
APPROVED BY		
PRINCIPAL ENGINEER	[illegible]	5/11/88
PARK DEPARTMENT	[illegible]	5-13-88
TRAFFIC DIVISION	Bmm	5-20-88
CHIEF PUB. WKS. ENGR.	[illegible]	6-3-88
	[illegible]	5-24-88

APPROVED BY [signature]
DIRECTOR OF PUBLIC WORKS
DATE 6/6/88

STREET PLAN & PROFILE

COLE ST.
AT
ALESSANDRO BLVD.
Z.C.O-5-834

SCALE: 1" = 40' HORIZ.; 1" = 4' VERT.

ACCOUNT No.

DRAWING NUMBER
R-2569

SHEET 2 OF 2

83-6 A

INDEX 45

* As built 11/86 TC

PC-1372