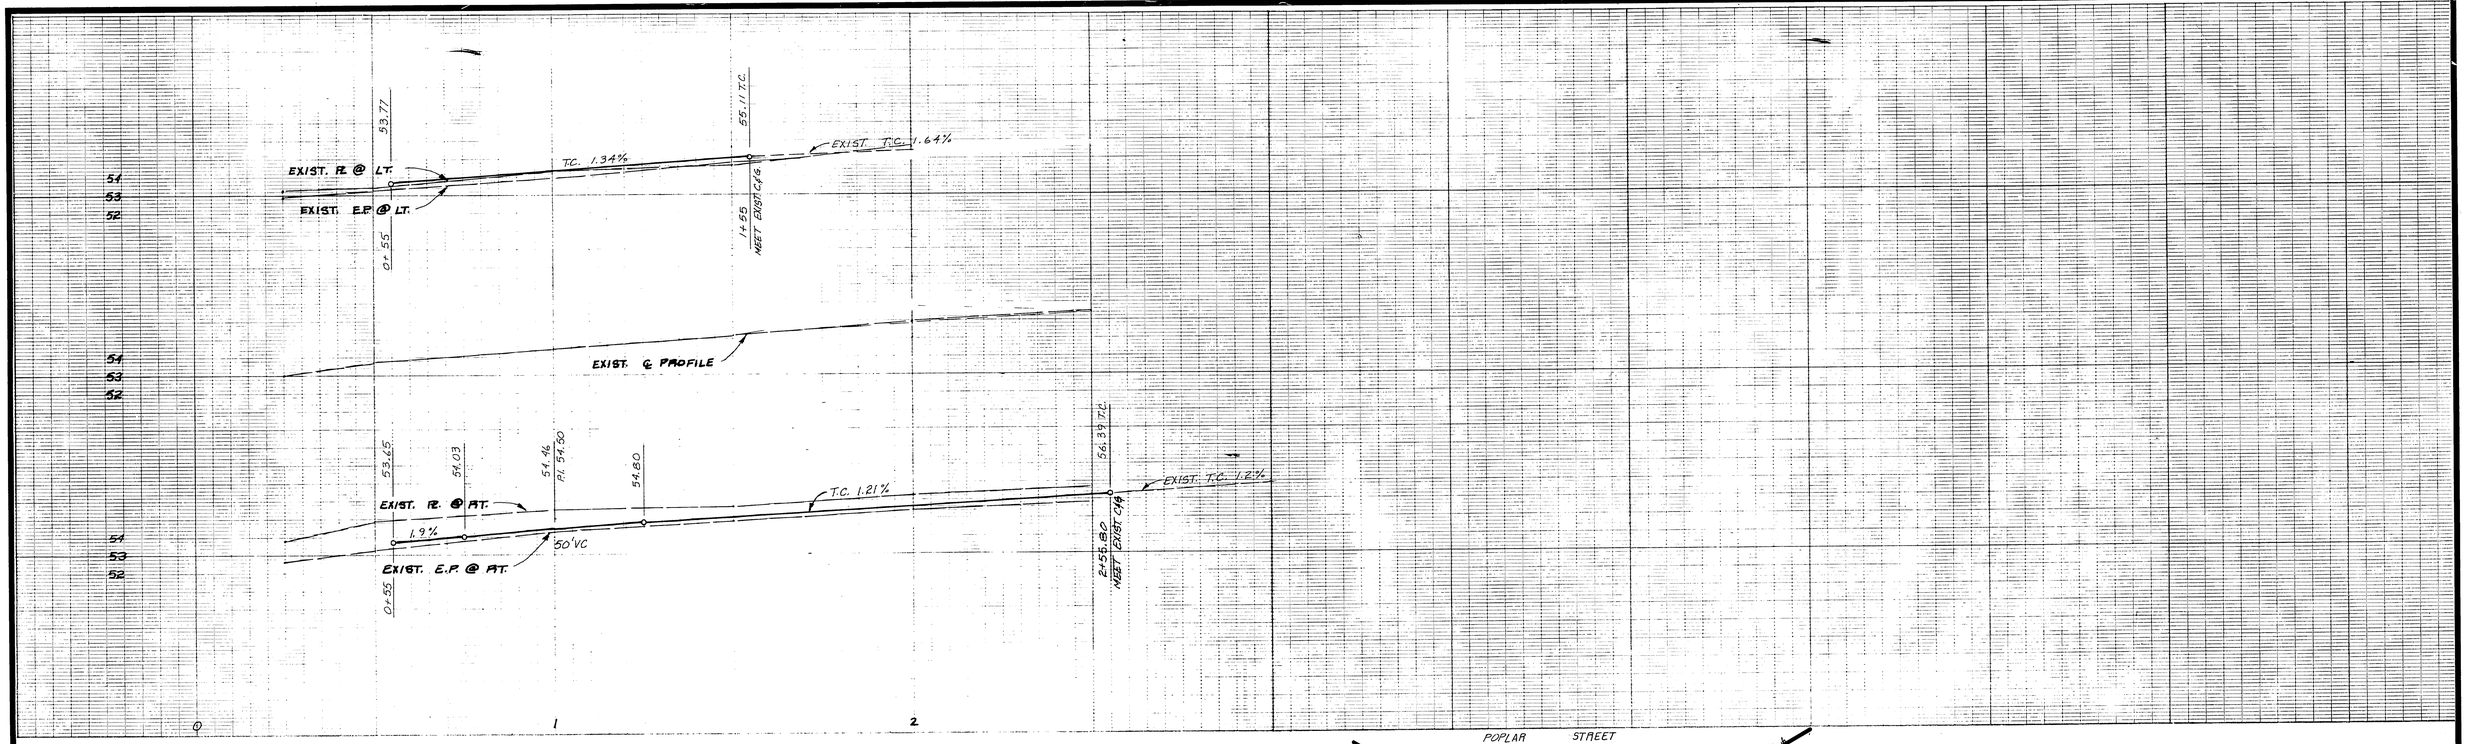

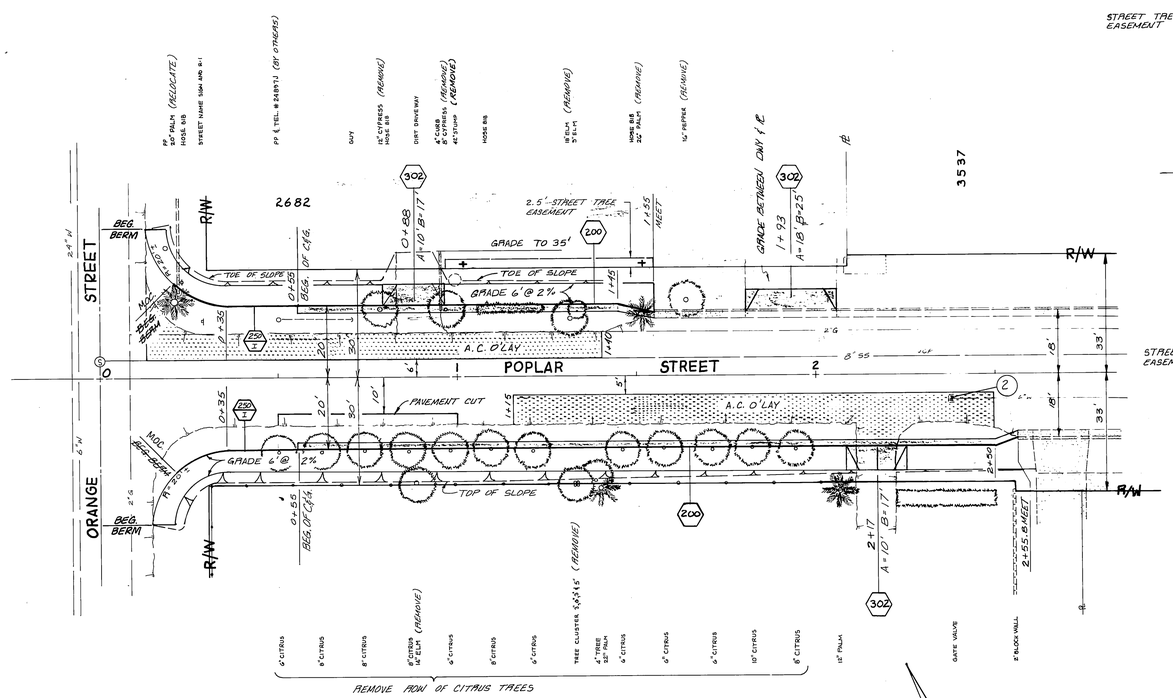

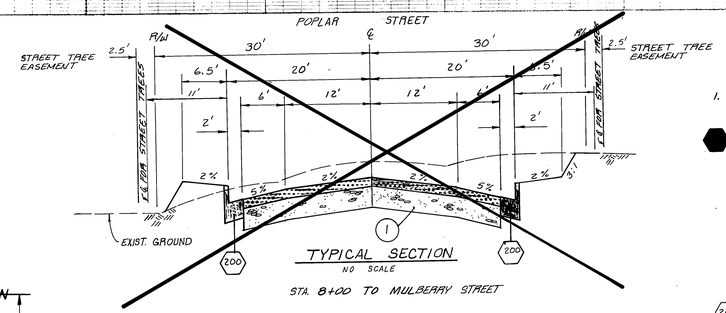

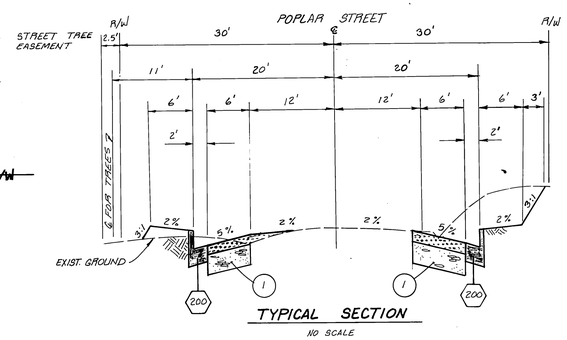

GENERAL NOTES

1. CONSTRUCTION SHALL BE IN ACCORDANCE WITH THE CITY OF RIVERSIDE STD. DWGS. AND STD. SPECS. FOR PUBLIC WORKS CONSTRUCTION, 1985 EDITION.
2. ⬢ NUMBERS ABOVE 100 IN A HEXAGON ON THE PLAN REFER TO THE RESPECTIVE STD. DWG. AND SHALL BE CONSTRUCTED ACCORDINGLY, UNLESS MODIFICATIONS ARE NOTED ON THE PLAN. ANY NUMBER SHOWN BELOW THE STD. DWG. NUMBER INDICATES THE SPECIFIC ALTERNATE TO BE CONSTRUCTED.

CONSTRUCTION NOTES

- (200) CONSTRUCT CONC. CURB & GUTTER PER STD. DWG. NO. 200.
- ~~(220) CONSTRUCT CONC. CROSS GUTTER PER STD. DWG. NO 220.~~
- (250 1) CONSTRUCT ASPHALT CONC. BEARM PER STD. DWG. NO. 250.
- (302) CONSTRUCT DRIVEWAY AS PER STD. DWG. NO. 302, A & B AS NOTED.

LOCATIONS AS SHOWN ON PLAN.

- (1) CONSTRUCT STRUCTURAL SECTION OF PAVING .25' A.C. OVER .65' CAB.
- \+ PROP. LOCATION FOR TREES - 2 REQ'D
- (2) ADJUST GATE VALVE COVER TO GRADE

TREE PLANTING NOTES

1. All related work shall conform to the City of Riverside, Park and Recreation Department Standards.
2. Contact the Park Projects Inspector a minimum of 48 hours in advance at 787-7223 to schedule inspections. Inspections shall be required: a) when plant locations have been spotted in the field prior to digging plant pits, b) while digging plant pits and planting/relocating trees, c) after planting and all other indicated or specified work has been completed for start of maintenance, and d) at end of maintenance/final acceptance (contractor/developer will be released from maintenance only upon receipt of written notification from the city that the Park and Recreation Department is assuming maintenance responsibilities).
3. The Contractor/Developer shall maintain all plantings for a minimum period of one (1) year.
4. Street Tree planting shall be FRAXINUS VELUTIMA "MODESTO" (MODESTO ASH) 15GAL. SIZE, SPACING 45'-50', 2 REQUIRED

* AS BUILT 7-28-86 BMET!

INDEX 45

MARK	REVISIONS	APPR.	DATE

DESIGNED BY [illegible] DRAWN BY TL CHECKED BY

CITY OF RIVERSIDE
PUBLIC WORKS DEPARTMENT

APPROVED BY	DATE	BY
PRINCIPAL ENGINEER	6/27/85	
PARK DEPARTMENT	6-28-86	
TRAFFIC DIVISION	6/27/85	
CHIEF F. W. ENGINEER		

APPROVED BY [signature] PUBLIC WORKS DIRECTOR

DATE JULY 1, 1985

POPLAR STREET WIDENING
ORANGE TO 260' EASTERLY
HUD FUNDED

HORIZ. SCALE: 1" = 20' VERT. SCALE: 1" = 4'

ACCOUNT NO. 15-550-597-1

R-2618-A

SHEET 1 OF 1

PD-1645

ADAPTED FROM PLAN R-2618

81830

OZALID- NO.1