GENERAL NOTES: (2)

1. Proposed pipe grades will be determined after existing void is filled/collapsed and existing pipe is removed or crushed in place.
2. Backfill and compact to 95% relative compaction the existing void to a level 1-foot above the proposed pipe. Then dig trench for pipe installation.
3. Backfill and compact existing void above the proposed pipe up to surface to 90% relative compaction.
4. Reconstruct wall and tubular steel fence to match existing. Compact soil to a level of 2 feet below the wall footing and to 3 feet each side of the wall shall be compacted to 95% relative compaction.
5. All slope areas disturbed by the construction shall be hydroseeded with a natural grass mixture to be approved by the City.

CATCH BASIN DETAIL (2)

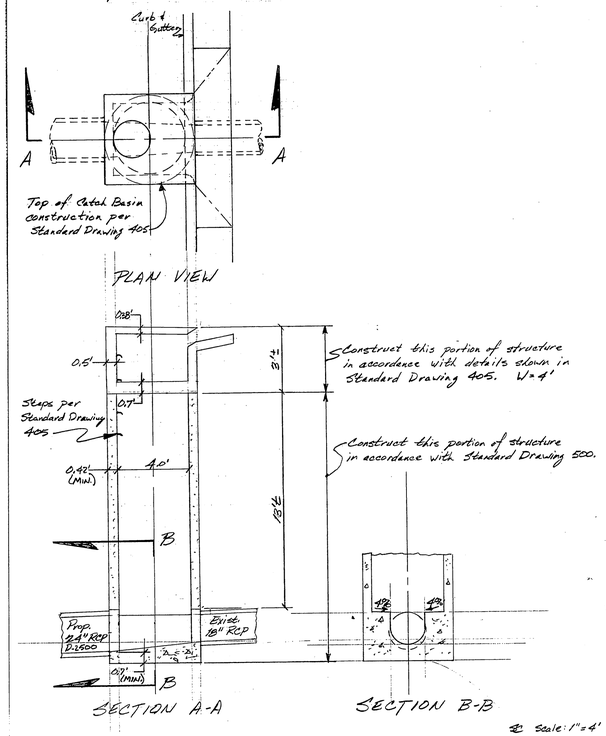

(2) Scale: 1"=4'

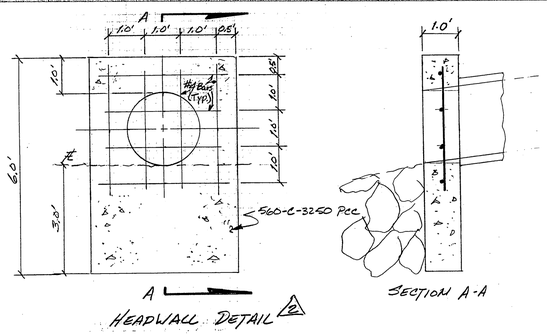

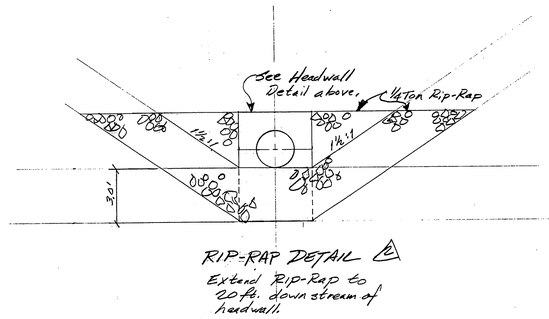

RIP-RAP DETAIL (2)

Extend Rip-Rap to 20 ft. down stream of headwall.

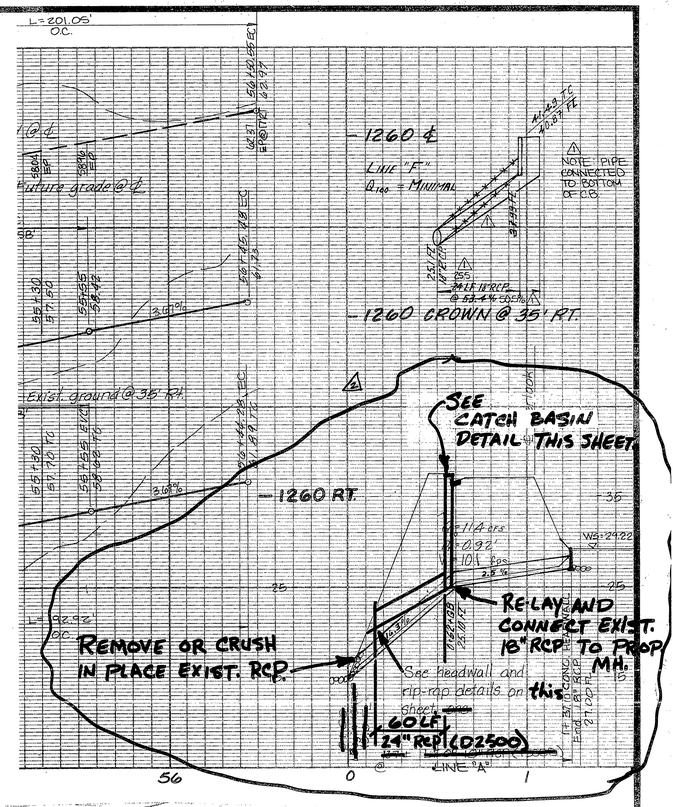

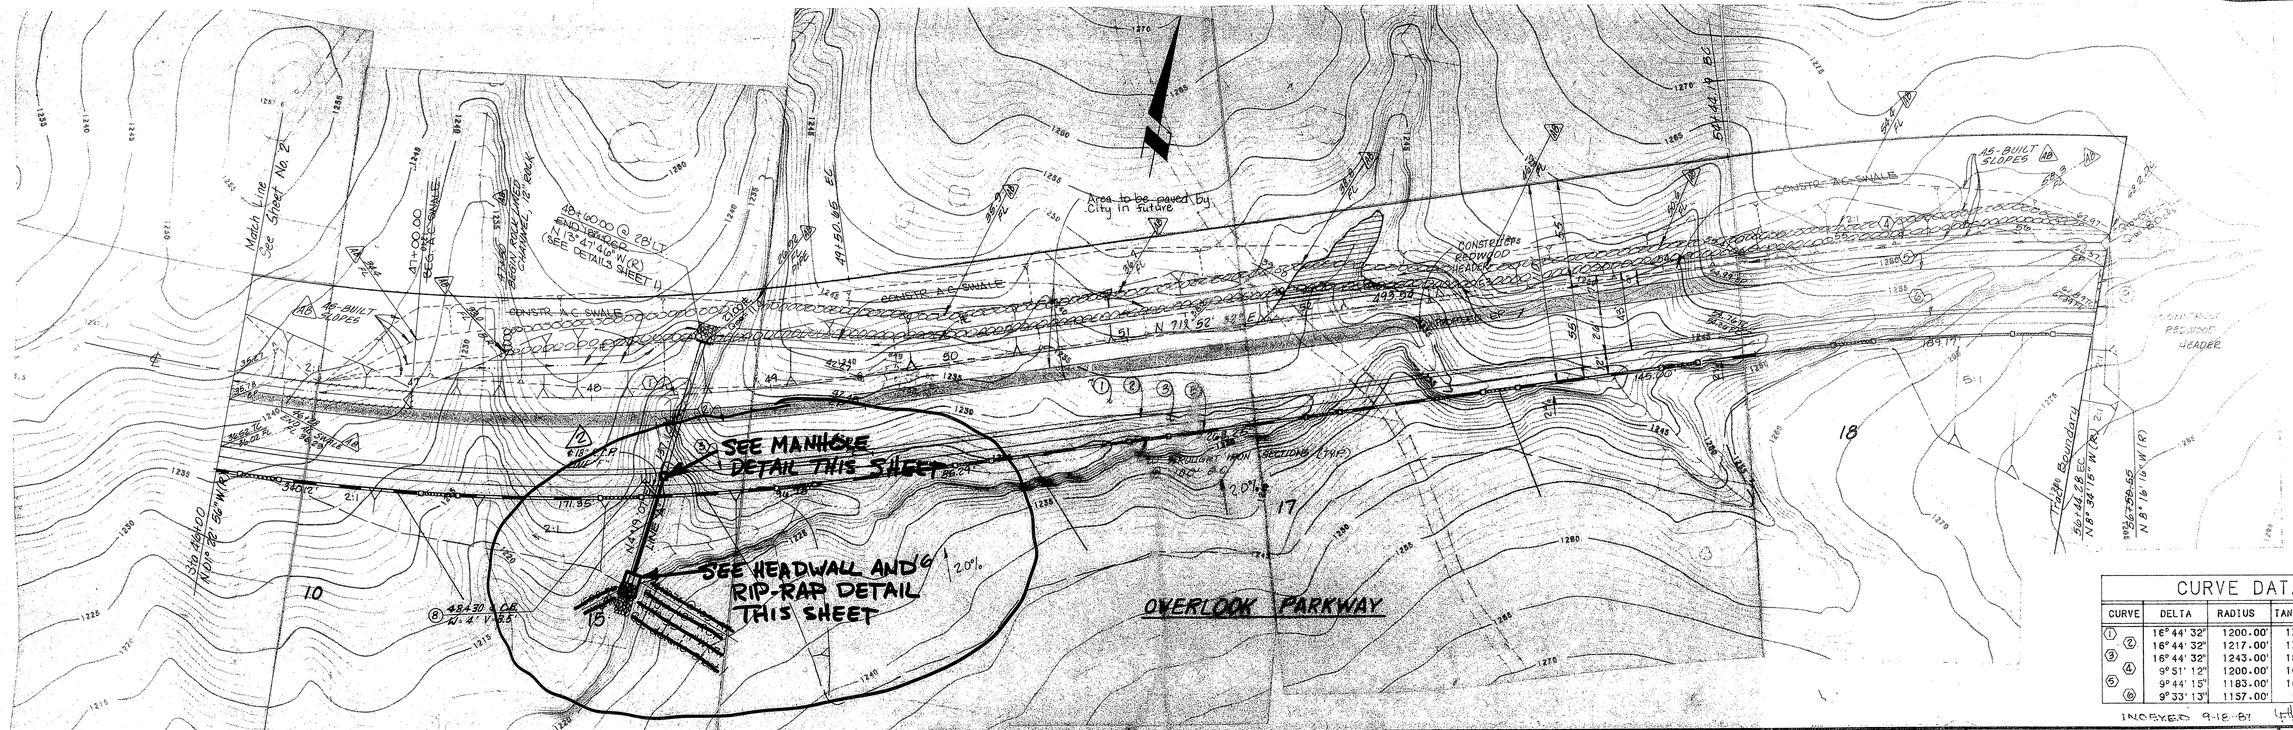

CURVE DATA				
CURVE	DELTA	RADIUS	TANGENT	LENGTH
① ②	16° 44' 32"	1200.00'	176.58'	350.65'
③ ②	16° 44' 32"	1217.00'	179.08'	355.61'
③ ④	16° 44' 32"	1243.00'	182.91'	363.21'
⑤ ④	9° 51' 12"	1200.00'	103.44'	206.36'
⑤ ⑥	9° 44' 15"	1183.00'	100.77'	201.05'
⑥	9° 33' 13"	1157.00'	96.68'	192.92'

INDEXED 9-18-87 GH

OMBEL, ODOR & BECKLUND
Riverside, Calif. 92501
Telephone (714) 788-8892

APPROVED BY:
Date 8-5-86

BENCH MARK: B&T Found P.K. and City Eng. Tag in M.O.C. at S.E. Curb Return @ Mayfield and Laurie Dr.
ELEV.: 1110.84

MARK	REVISIONS	APPR.	DATE
2	Revised for Pipe Repair	RE	11/5/86
1	As-Built North Side Channel Aug. '88 WPG Line Adj.	WWC	11/5/86
1	Revised Slope & Connection on Line "F"	WWC	11/5/86

DESIGNED BY JLE DRAWN BY SLM CHECKED BY RE

CITY OF RIVERSIDE, CALIFORNIA PUBLIC WORKS DEPARTMENT		
APPROVED BY	BY	DATE
PRINCIPAL ENGINEER	RE	7-12-87
PARK DEPARTMENT	[illegible]	7-13-87
TRAFFIC DIVISION	[illegible]	7-13-87
PUB. WKS. ENGR.	WWC	8/7/86
PLANNING	[illegible]	8-27-87

APPROVED BY [signature]
DIRECTOR OF PUBLIC WORKS
DATE 7/31/87

STREET IMPROVEMENTS PLAN & PROFILE TRACT 19176 OVERLOOK PARKWAY STA 46+00 TO 56+50.55

SCALE: HORIZ.: 1"=40' - VERT.: 1"=8'

ACCOUNT No.
DRAWING NUMBER R-2652A
SHEET 31 OF 31

INDEXED 9-25-02 GH