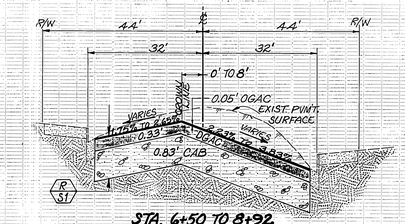

STA. 6+50 TO 8+92

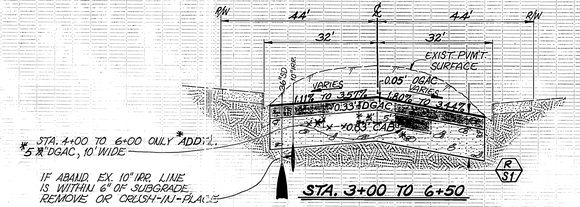


IF ABAND. EX. 10" IRR. LINE IS WITHIN 6" OF SUBGRADE REMOVE OR CRUSH-IN-PLACE

STA. 3+00 TO 6+50

TYPICAL SECTIONS

SCALE: HOR. 1"=20'
VERT. 1"=2'

PAVEMENT SECTIONS BASED ON A T.I. OF 8

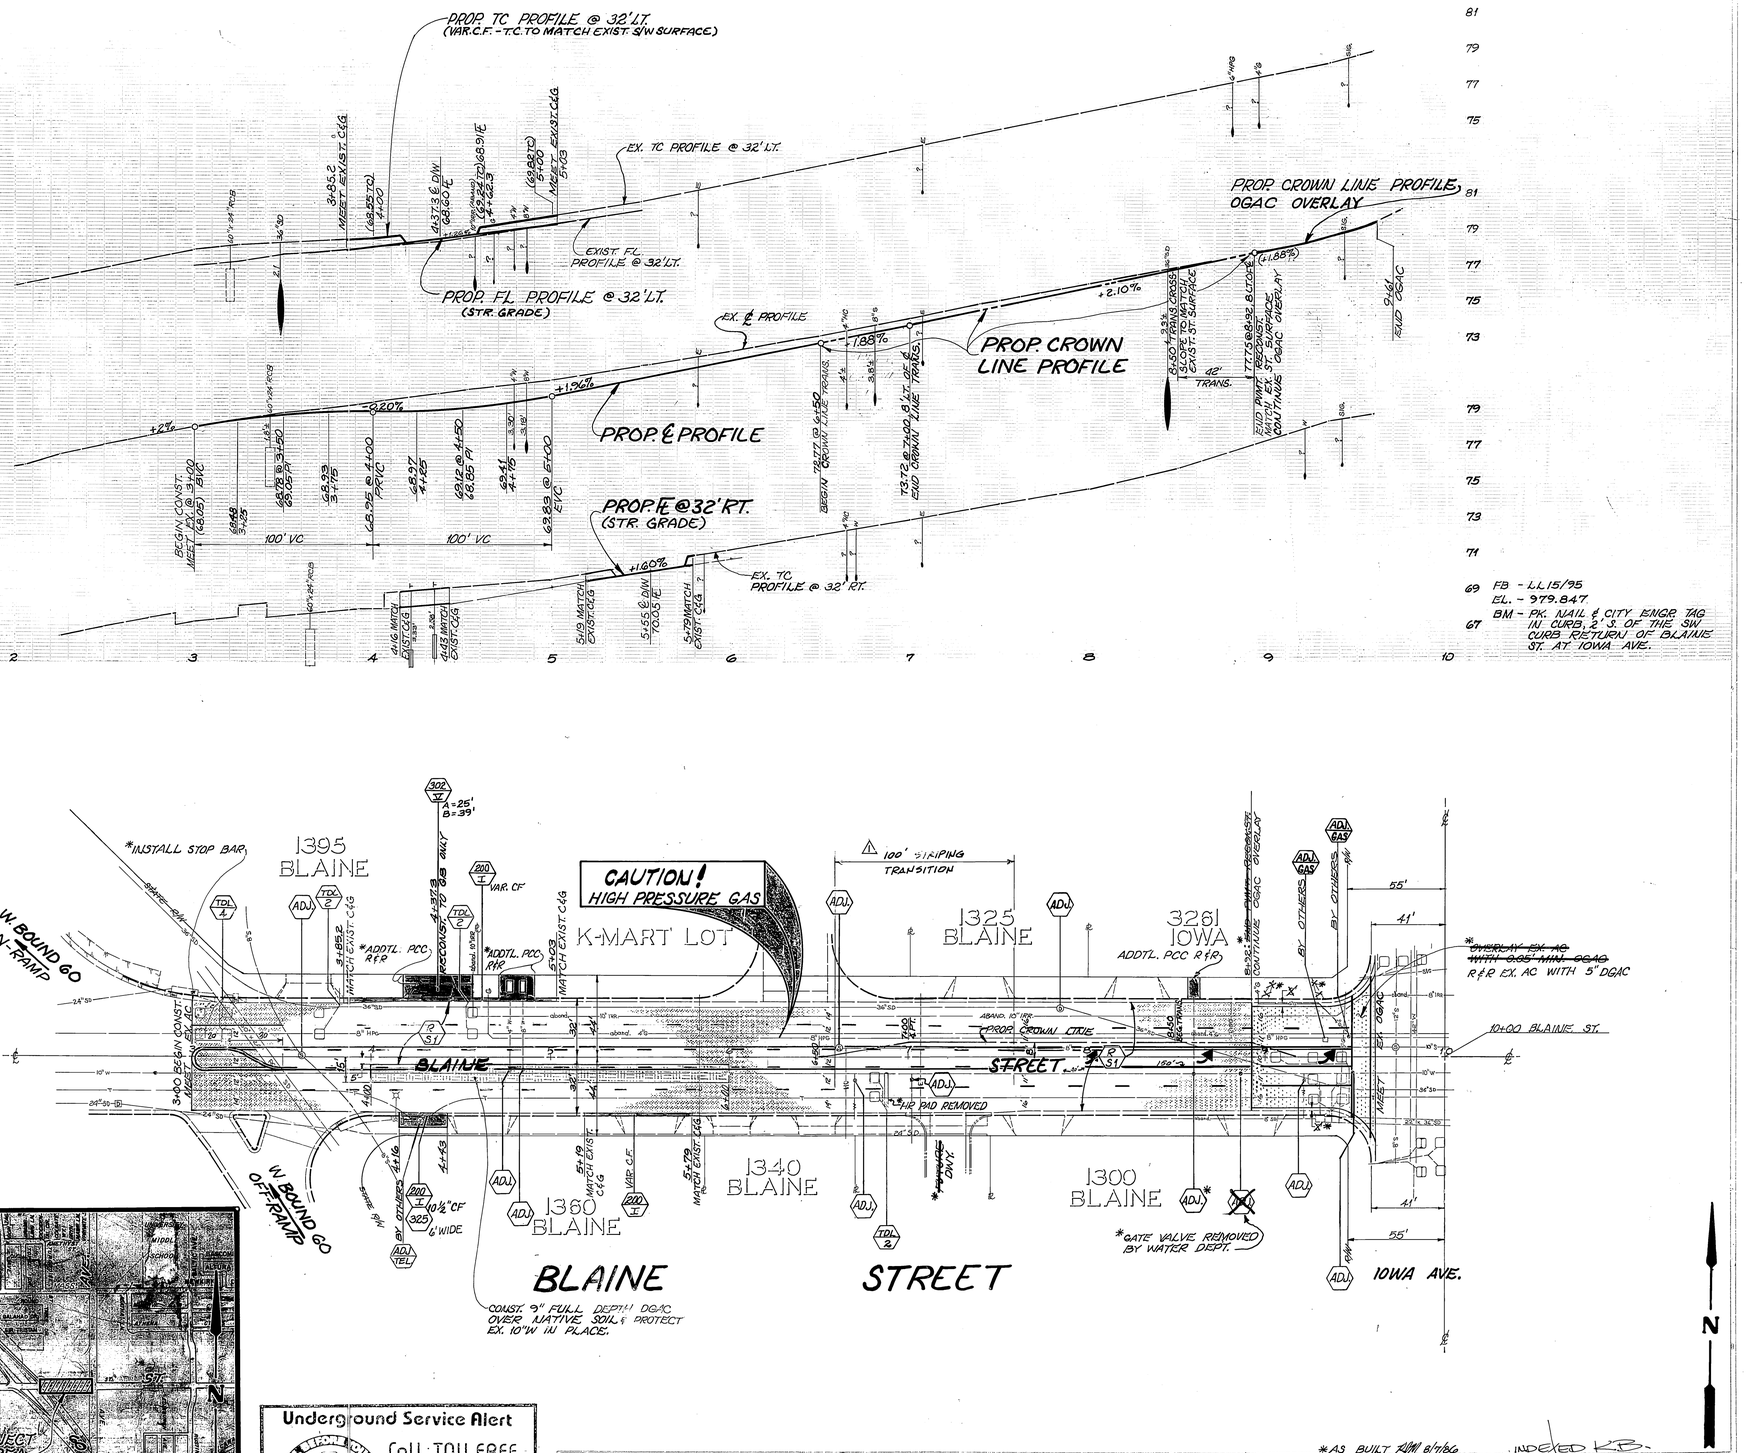

FB - LL15/95
EL. - 979.847
BM - PK NAIL & CITY ENGR TAG IN CURB 2' S OF THE SW CURB RETURN OF BLAINE ST. AT IOWA AVE.

CONSTRUCTION LEGEND

CENTER LINE	℄	TOP OF SLOPE	
RIGHT-OF-WAY LINE	R/W	TOE OF SLOPE	
SUBDIVISION LOT LINE	R	DIRECTION OF FLOW	

ADJ. — ADJUST SEWER, SD, ELECTRICAL, WATER MH'S. & GATE VALVES TO GRADE. ADJUSTMENT TO GRADE OR RELOCATION OF GAS CO. & TEL. CO. FACILITIES WILL BE DONE BY OTHERS.

R S1 — REMOVE & REPLACE EX. AC WITH 0.05' MIN. OPEN GRADED AC OVER 0.33' DENSE GRADED AC OVER 0.83' CAB.

TDL NO — REPLACE DAMAGED TRAFFIC DETECTOR LOOP (NO OF LOOPS TO BE REPLACED)

OVERLAY EX. AC WITH 0.05' MIN. OGAC

SPECIFIC CONSTRUCTION NOTES

⬢ NUMBERS ABOVE 100 IN A HEXAGON ON THE PLAN REFER TO THE RESPECTIVE STANDARD DRAWING AND SHALL BE CONSTRUCTED ACCORDINGLY, UNLESS MODIFICATIONS ARE NOTED ON THE PLAN.
ANY NUMBER SHOWN BELOW THE STANDARD DRAWING NUMBER INDICATES THE SPECIFIC ALTERNATE TO BE CONSTRUCTED.

GENERAL CONSTRUCTION NOTES

1. ALL ELEVATIONS SHOWN ON THE PLAN SHALL BE STAKED IN THE FIELD.
2. EXISTING UTILITIES SHOWN ON THIS PLAN ARE PLOTTED FROM UTILITY RECORDS. THE CONTRACTOR IS REQUIRED TO TAKE DUE PRECAUTIONARY MEASURES TO LOCATE AND PROTECT ALL UTILITIES WHETHER OR NOT SHOWN ON THIS PLAN (i.e. GAS SERVICES). THE COVER OF A UTILITY IS SHOWN IN THE PROFILE. UTILITIES SHOWN IN THE PROFILE AS "A" INDICATES THAT COVER IS UNKNOWN; HOWEVER, THE UTILITY IS NOT EXPECTED TO CONFLICT WITH THE PROPOSED IMPROVEMENTS.
3. PULL BOXES FOR SPLICING TRAFFIC LOOP DETECTOR CONDUCTORS & LEAD-IN CABLE ARE ADJACENT TO DETECTORS.

BLAINE STREET

CONST. 9" FULL DEPTH DGAC OVER NATIVE SOIL & PROTECT EX. 10"W IN PLACE.

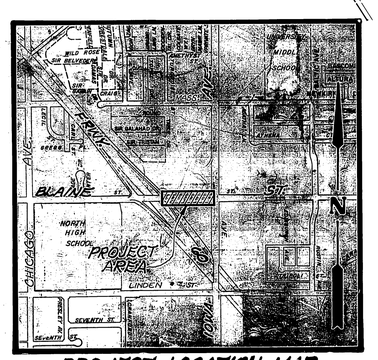

PROJECT LOCATION MAP
SCALE: 1"=1000'

Underground Service Alert
Call: TOLL FREE
1-800 422-4133
TWO WORKING DAYS BEFORE YOU DIG.

MARK	REVISIONS	APPR.	DATE
⚠	REVISED STRIPING DETAILS	D.R.	4/10/86

DESIGNED BY RM DRAWN BY RM CHECKED BY PCM

CITY OF RIVERSIDE
PUBLIC WORKS DEPARTMENT

	APPROVED BY	DATE	BY
	PRINCIPAL ENGINEER		
	PARK DEPARTMENT		
	TRAFFIC DIVISION	2/26/86	D.R.
	CHIEF INSPECTOR (PW)	3/3/86	DEH
	SURVEYOR	2/10/86	LPH

APPROVED BY William D. Gardner
PUBLIC WORKS DIRECTOR
DATE 2-14-86

*AS BUILT 7/1/86 INDEXED K.B.

BLAINE STREET RECONSTRUCTION
US HWY. 60 TO IOWA AVE.

HORIZ. SCALE: 1"=40' VERT. SCALE: 1"=4'

ACCOUNT NO. 30-575-327-07

R-2717

SHEET 1 OF 1